






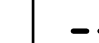
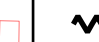

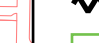









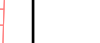
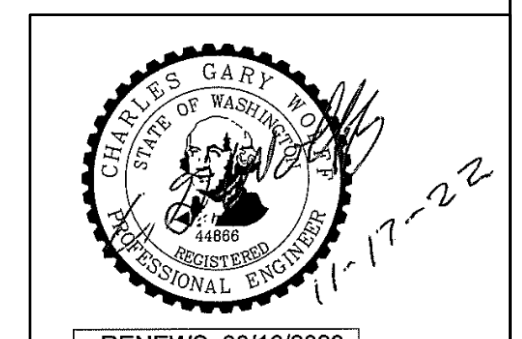
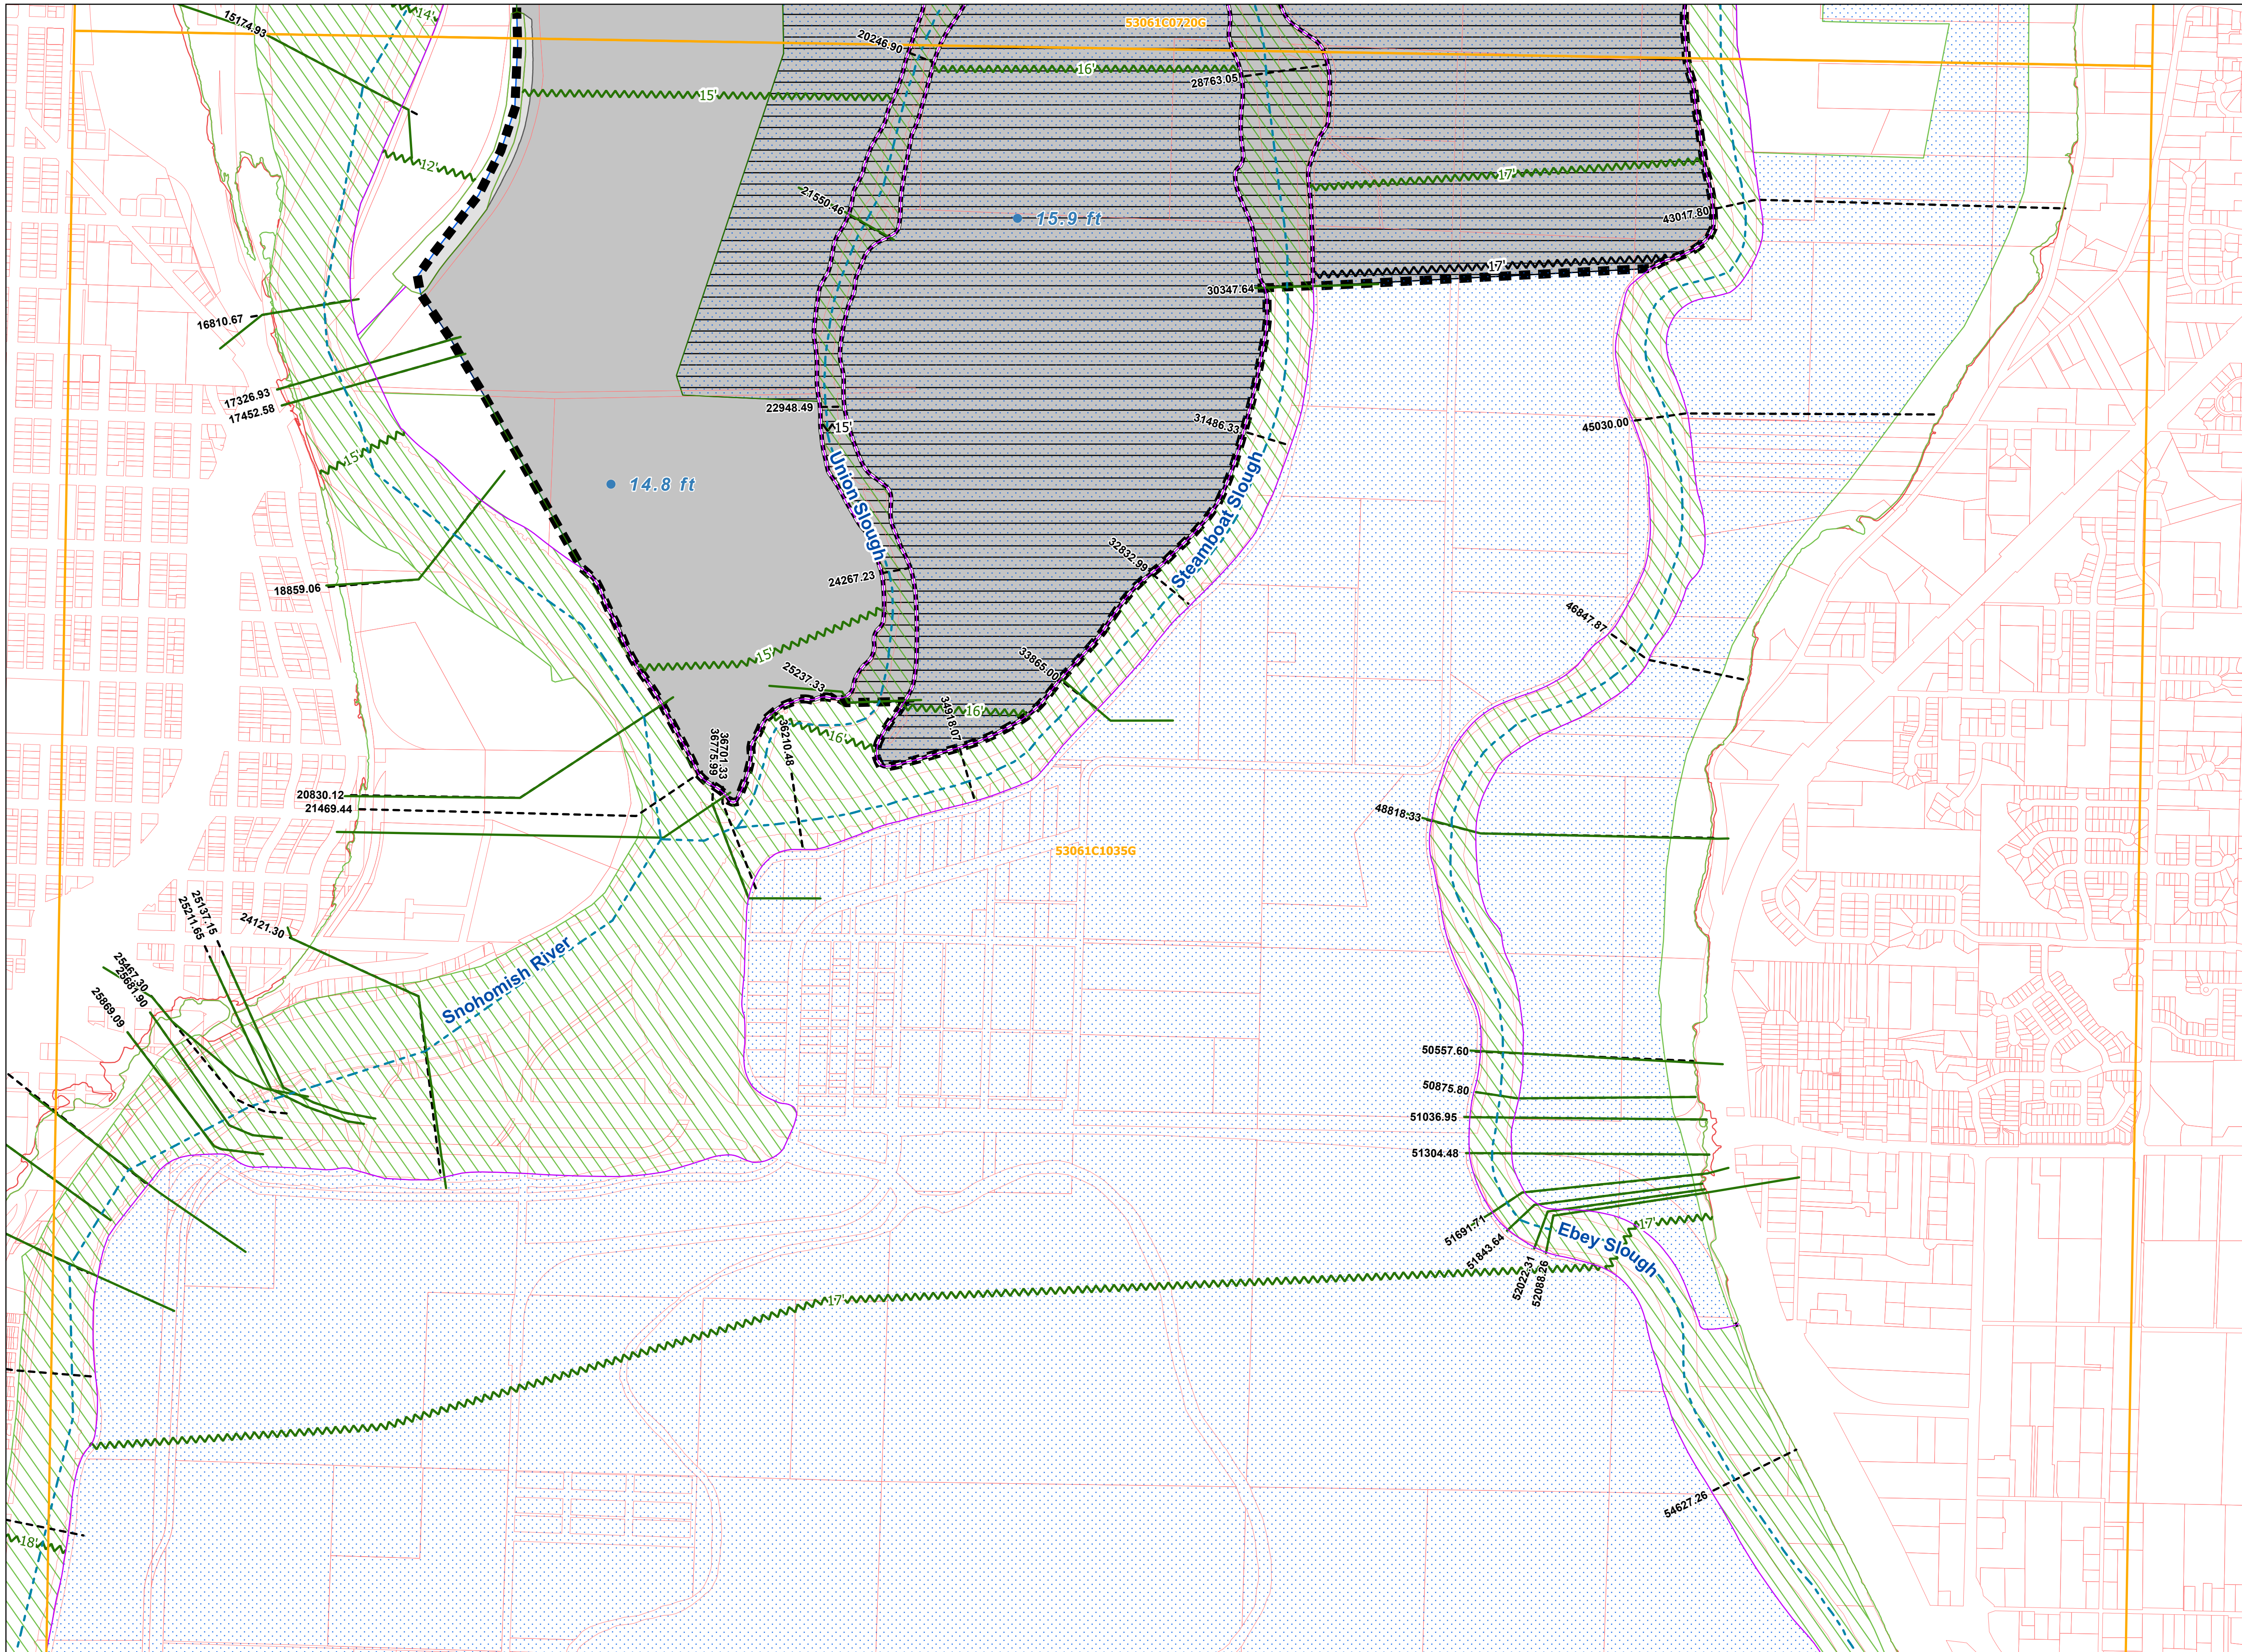


SMITH ISLAND FLOODPLAIN MAP REVISION
MAP 6 - AS-BUILT CONDITIONS

LEGEND

-  FIRM Boundaries
-  Taxlots
-  Base Flood Elevation (As-Built)
-  Rivers & Streams
-  Density Fringe Area (As-Built)
-  1% Annual Chance Floodplain (As-Built)
-  0.2% Annual Chance Floodplain (As-Built)
-  Levee (As-Built)
-  Cross Sections (As-Built)
-  Base Flood Elevation (As-Built)
-  Revision Boundaries (As-Built)
-  Base Flood Elevation (As-Built)
-  1% Annual Chance Floodplain (Effective FIS)
-  0.2% Annual Chance Floodplain (Effective FIS)
-  Floodway (Effective FIS)
-  Density Fringe Area (Effective FIS)
-  Coastal Floodplain (Effective FIS)
-  Combined Riverine and Coastal Flooding (Effective FIS)
-  Levee (Effective)
-  Cross Section (Effective)
-  Base Flood Elevation (Effective)



RENEWS 08/16/2023

Note:
 Vertical Datum is NAVD88
 Horizontal Datum is NAD83 (2011) Washington
 State Plane North (Intl ft)

