

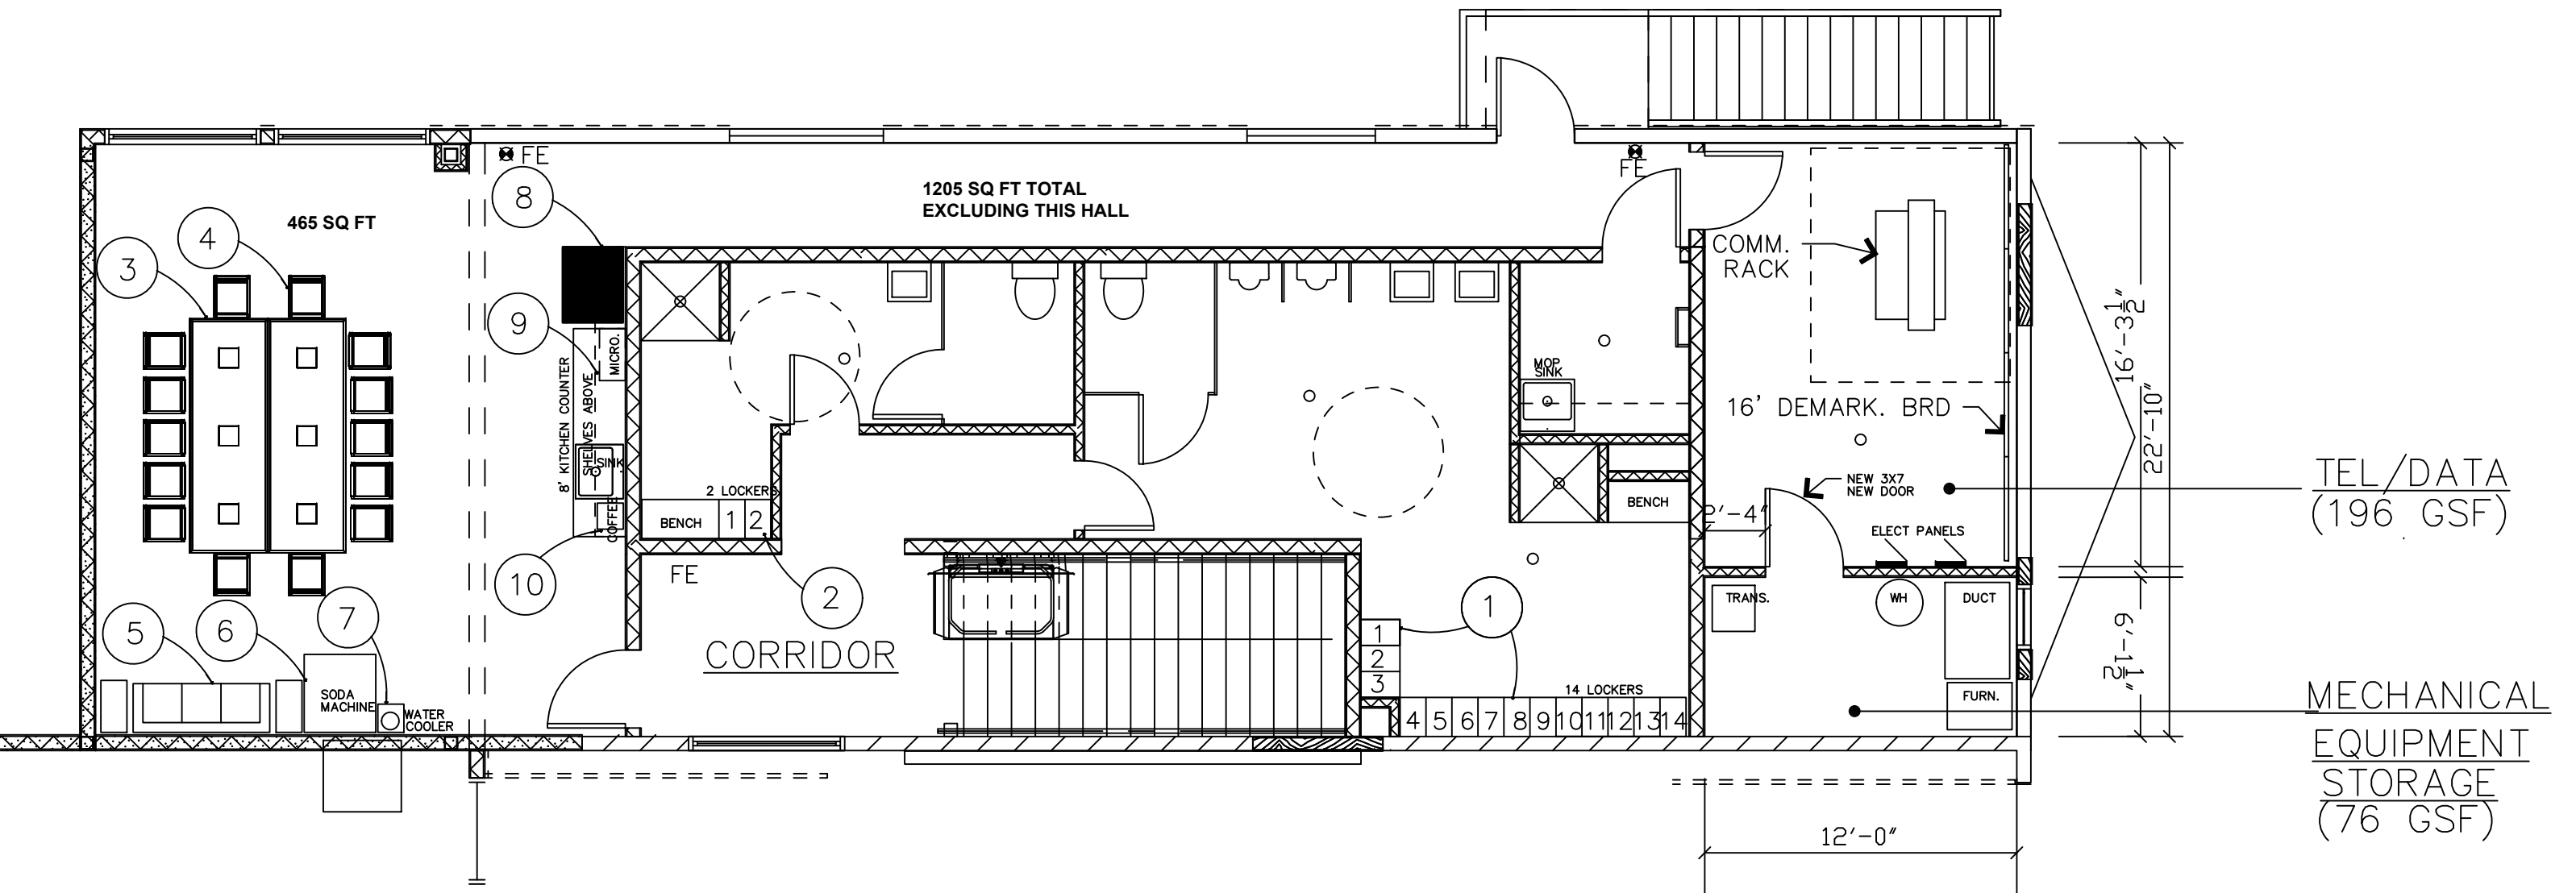



ARLINGTON FLEET MEZZANINE FLOOR PLAN 2026

SCALE: 1/8"=1'-0"

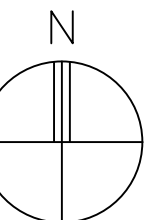


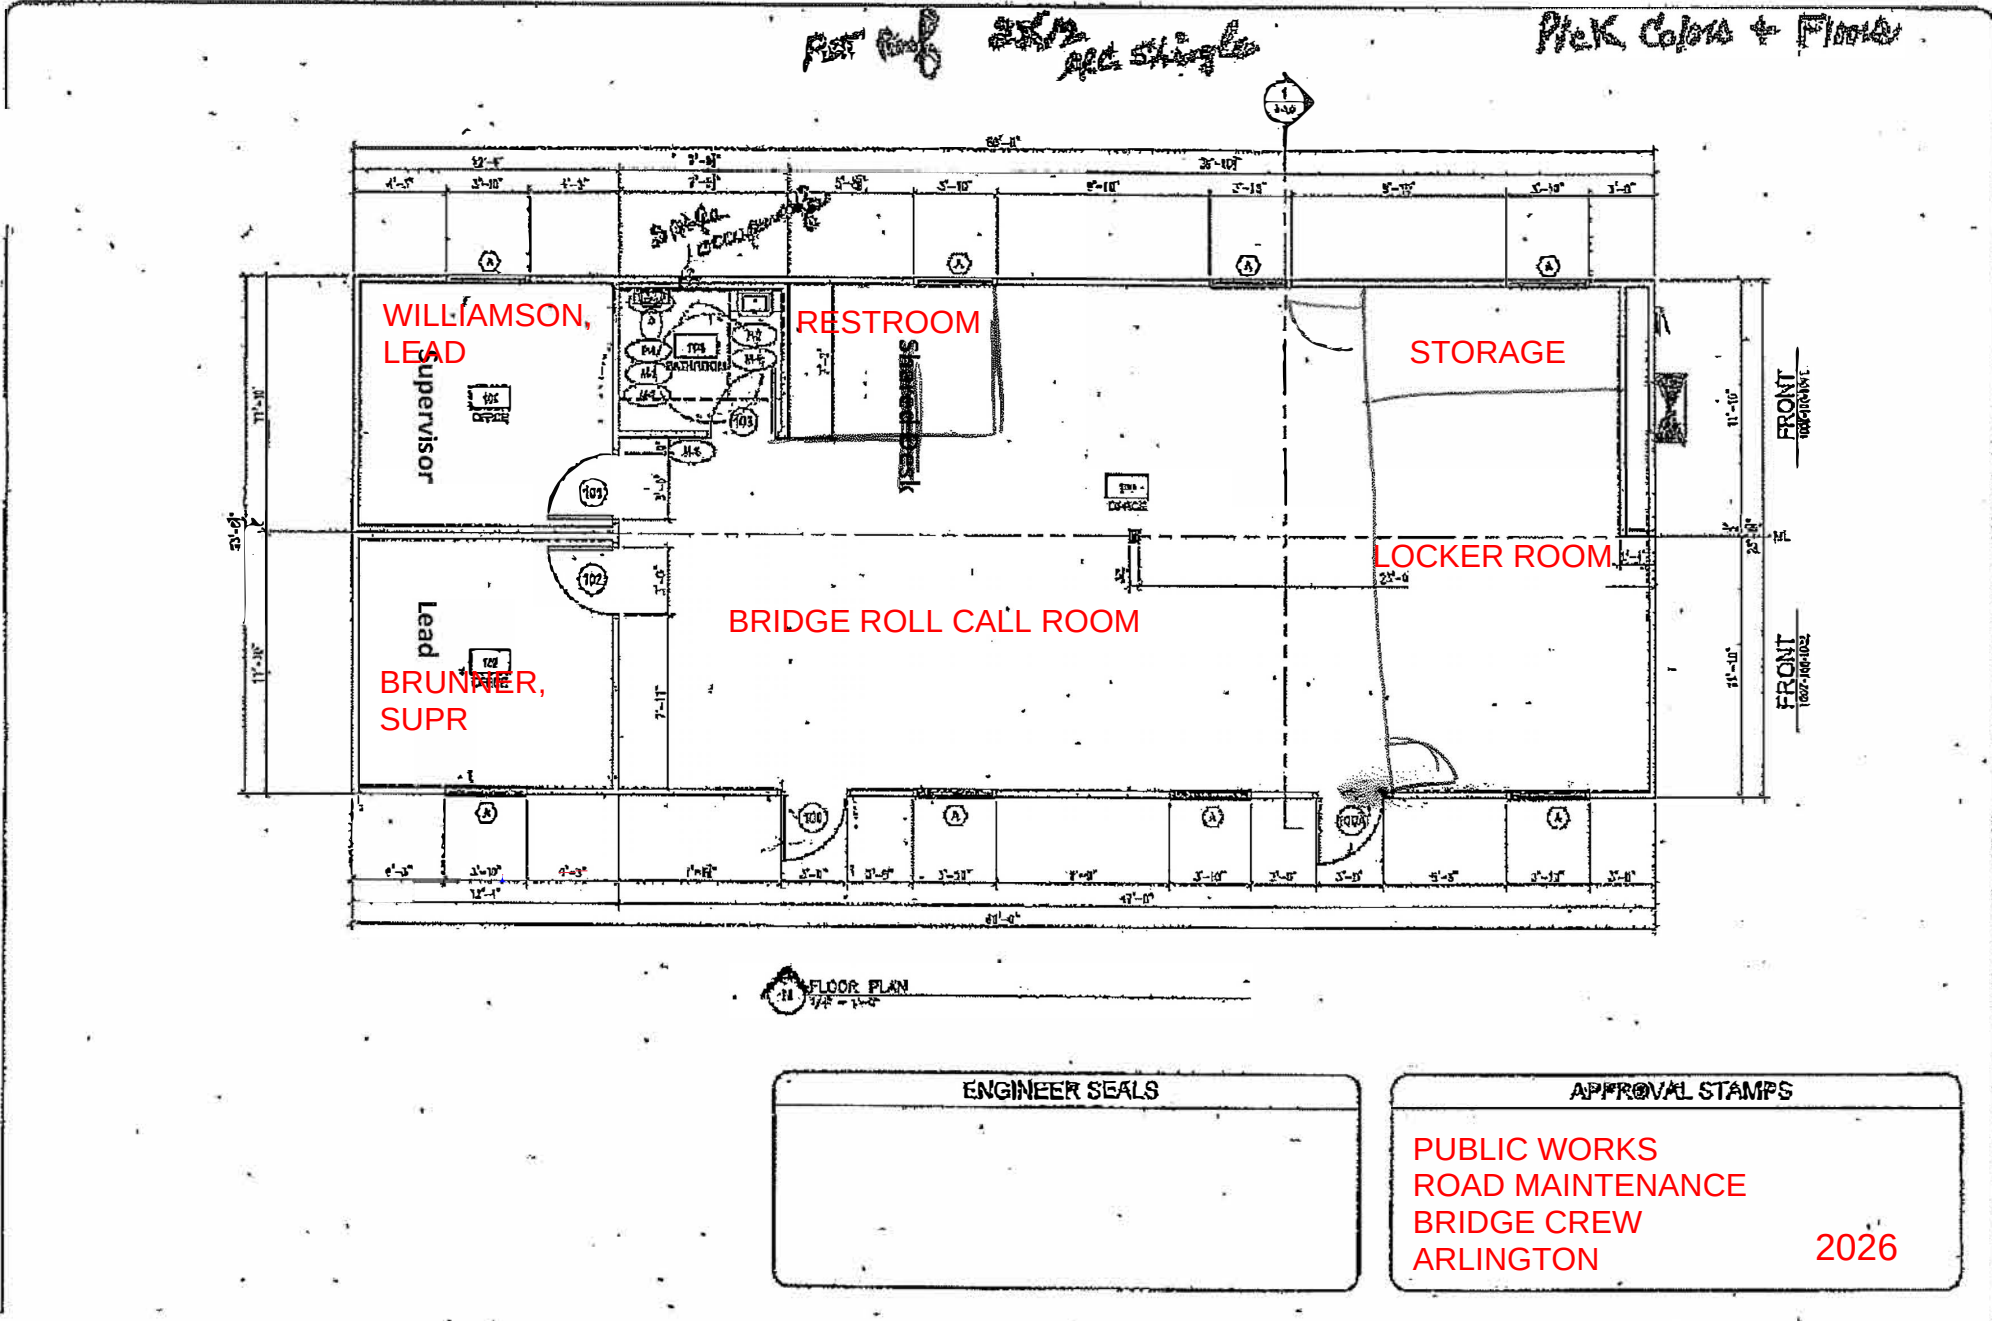



OUTBACK TRAILER:
Turner, Operations Mgr
Parker, Sr Enviro Coord
Mtg Rm

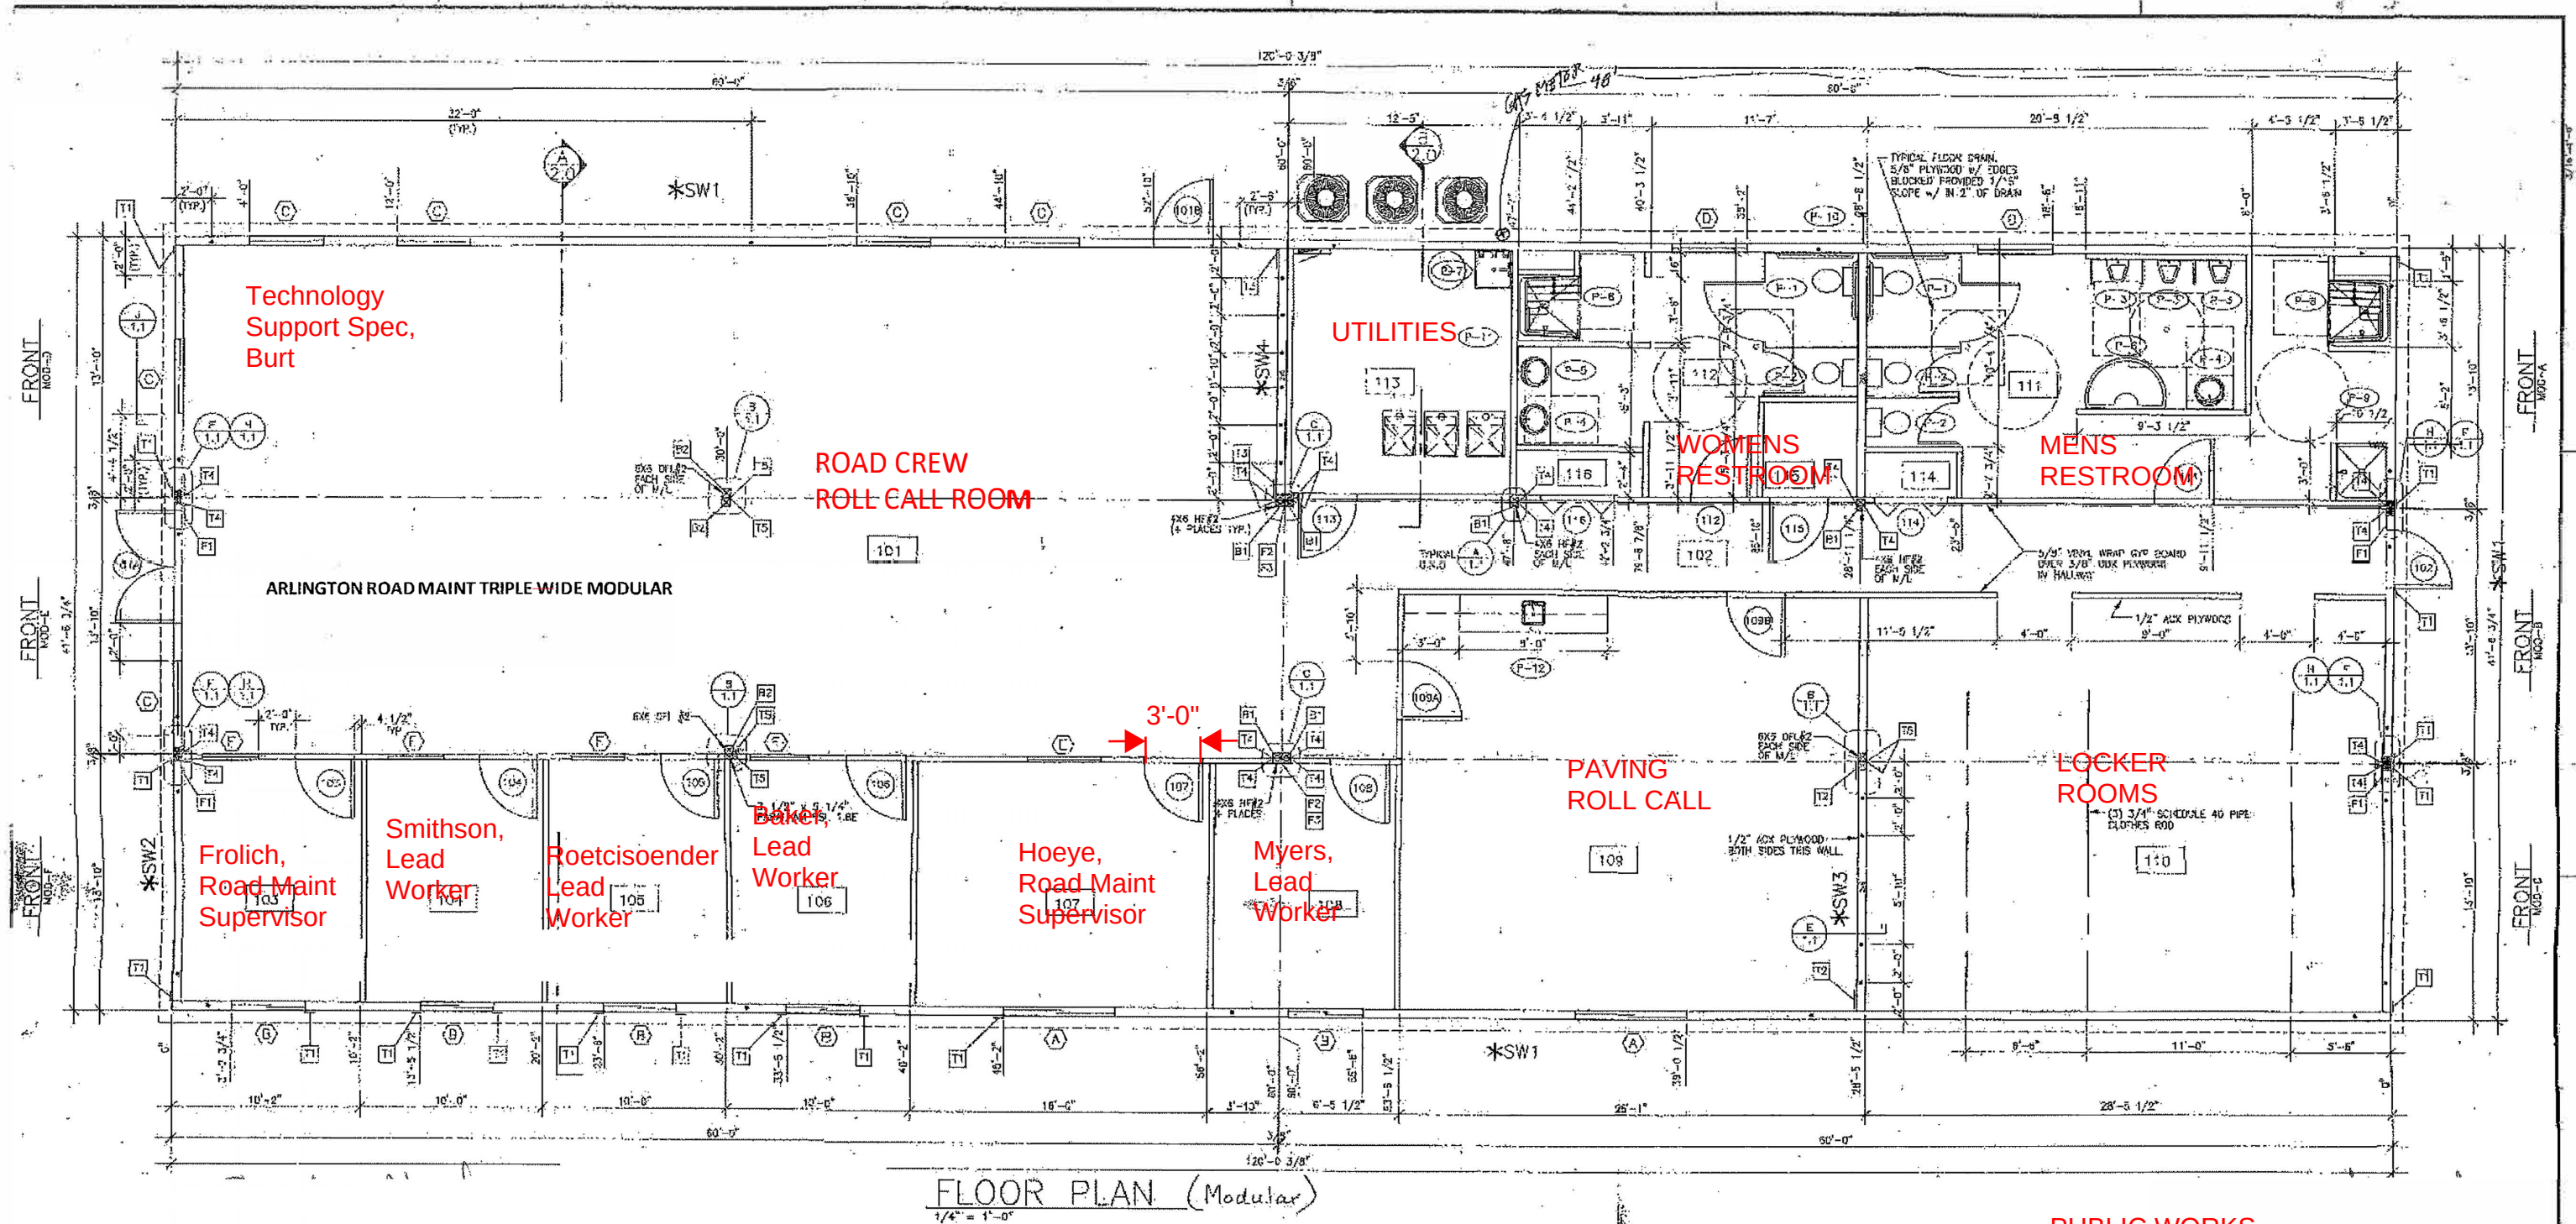


PUBLIC WORKS
ROAD MAINTENANCE
TRIPLEWIDE
ARLINGTON
2026

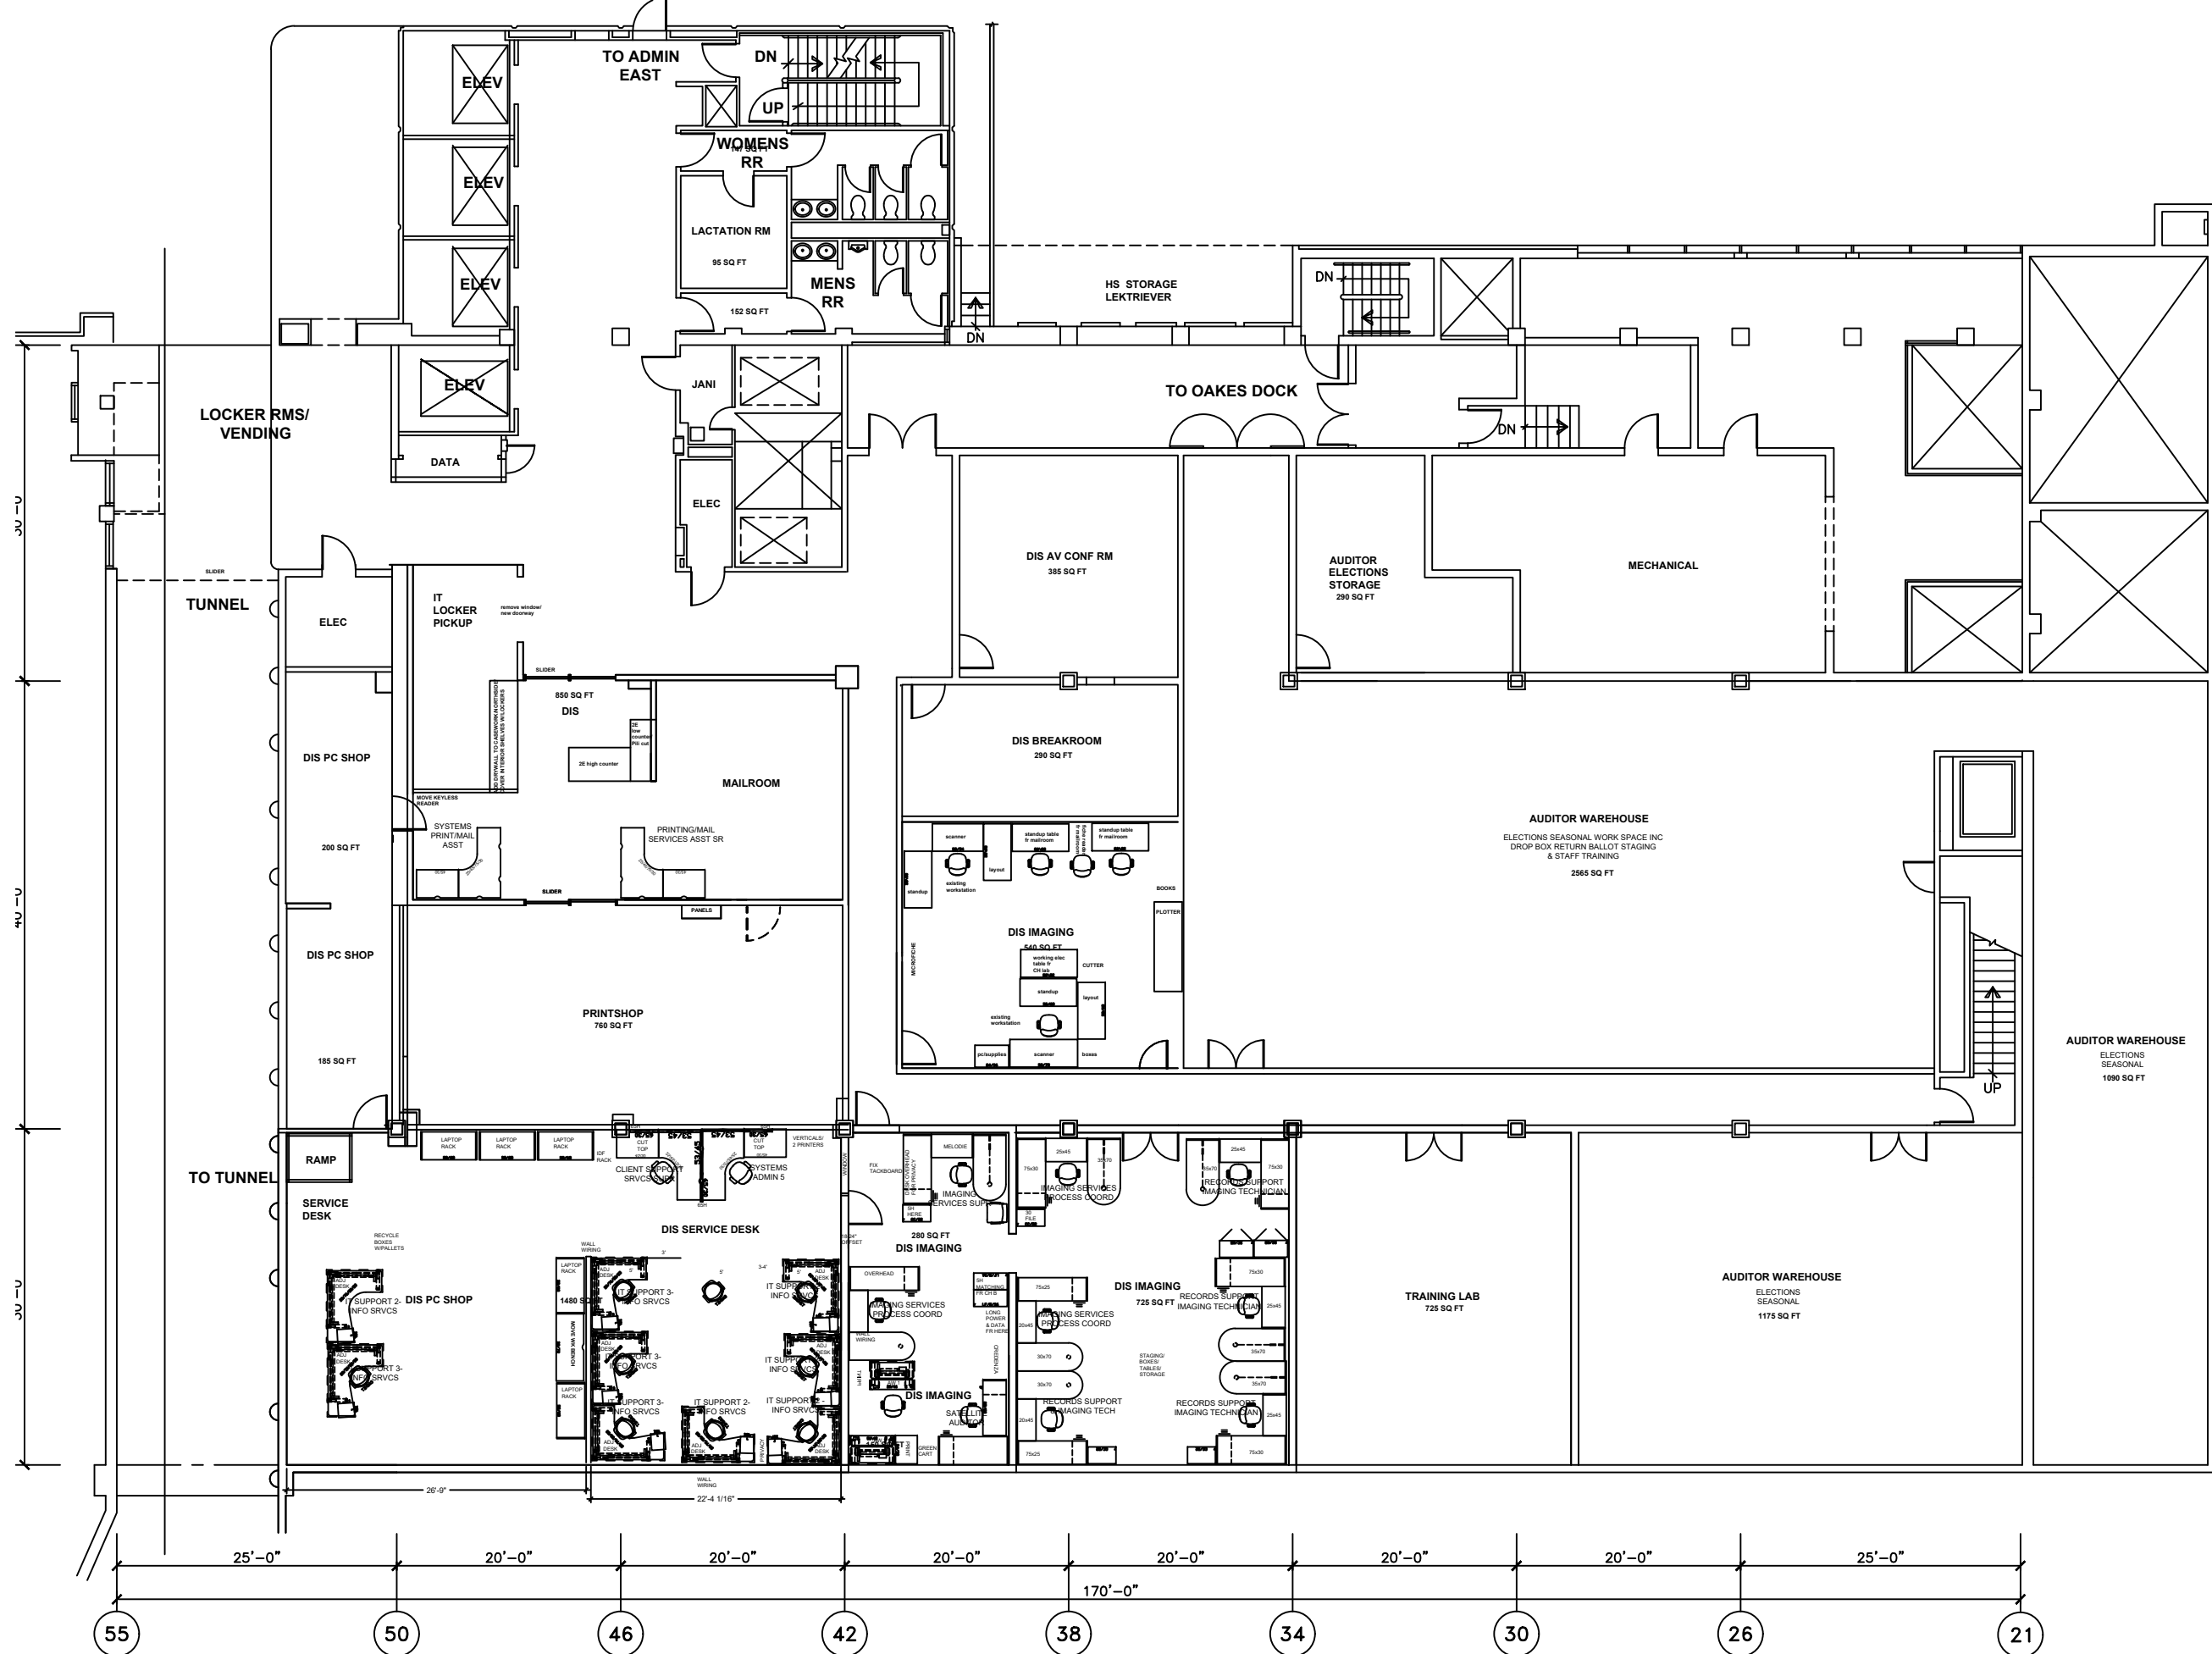


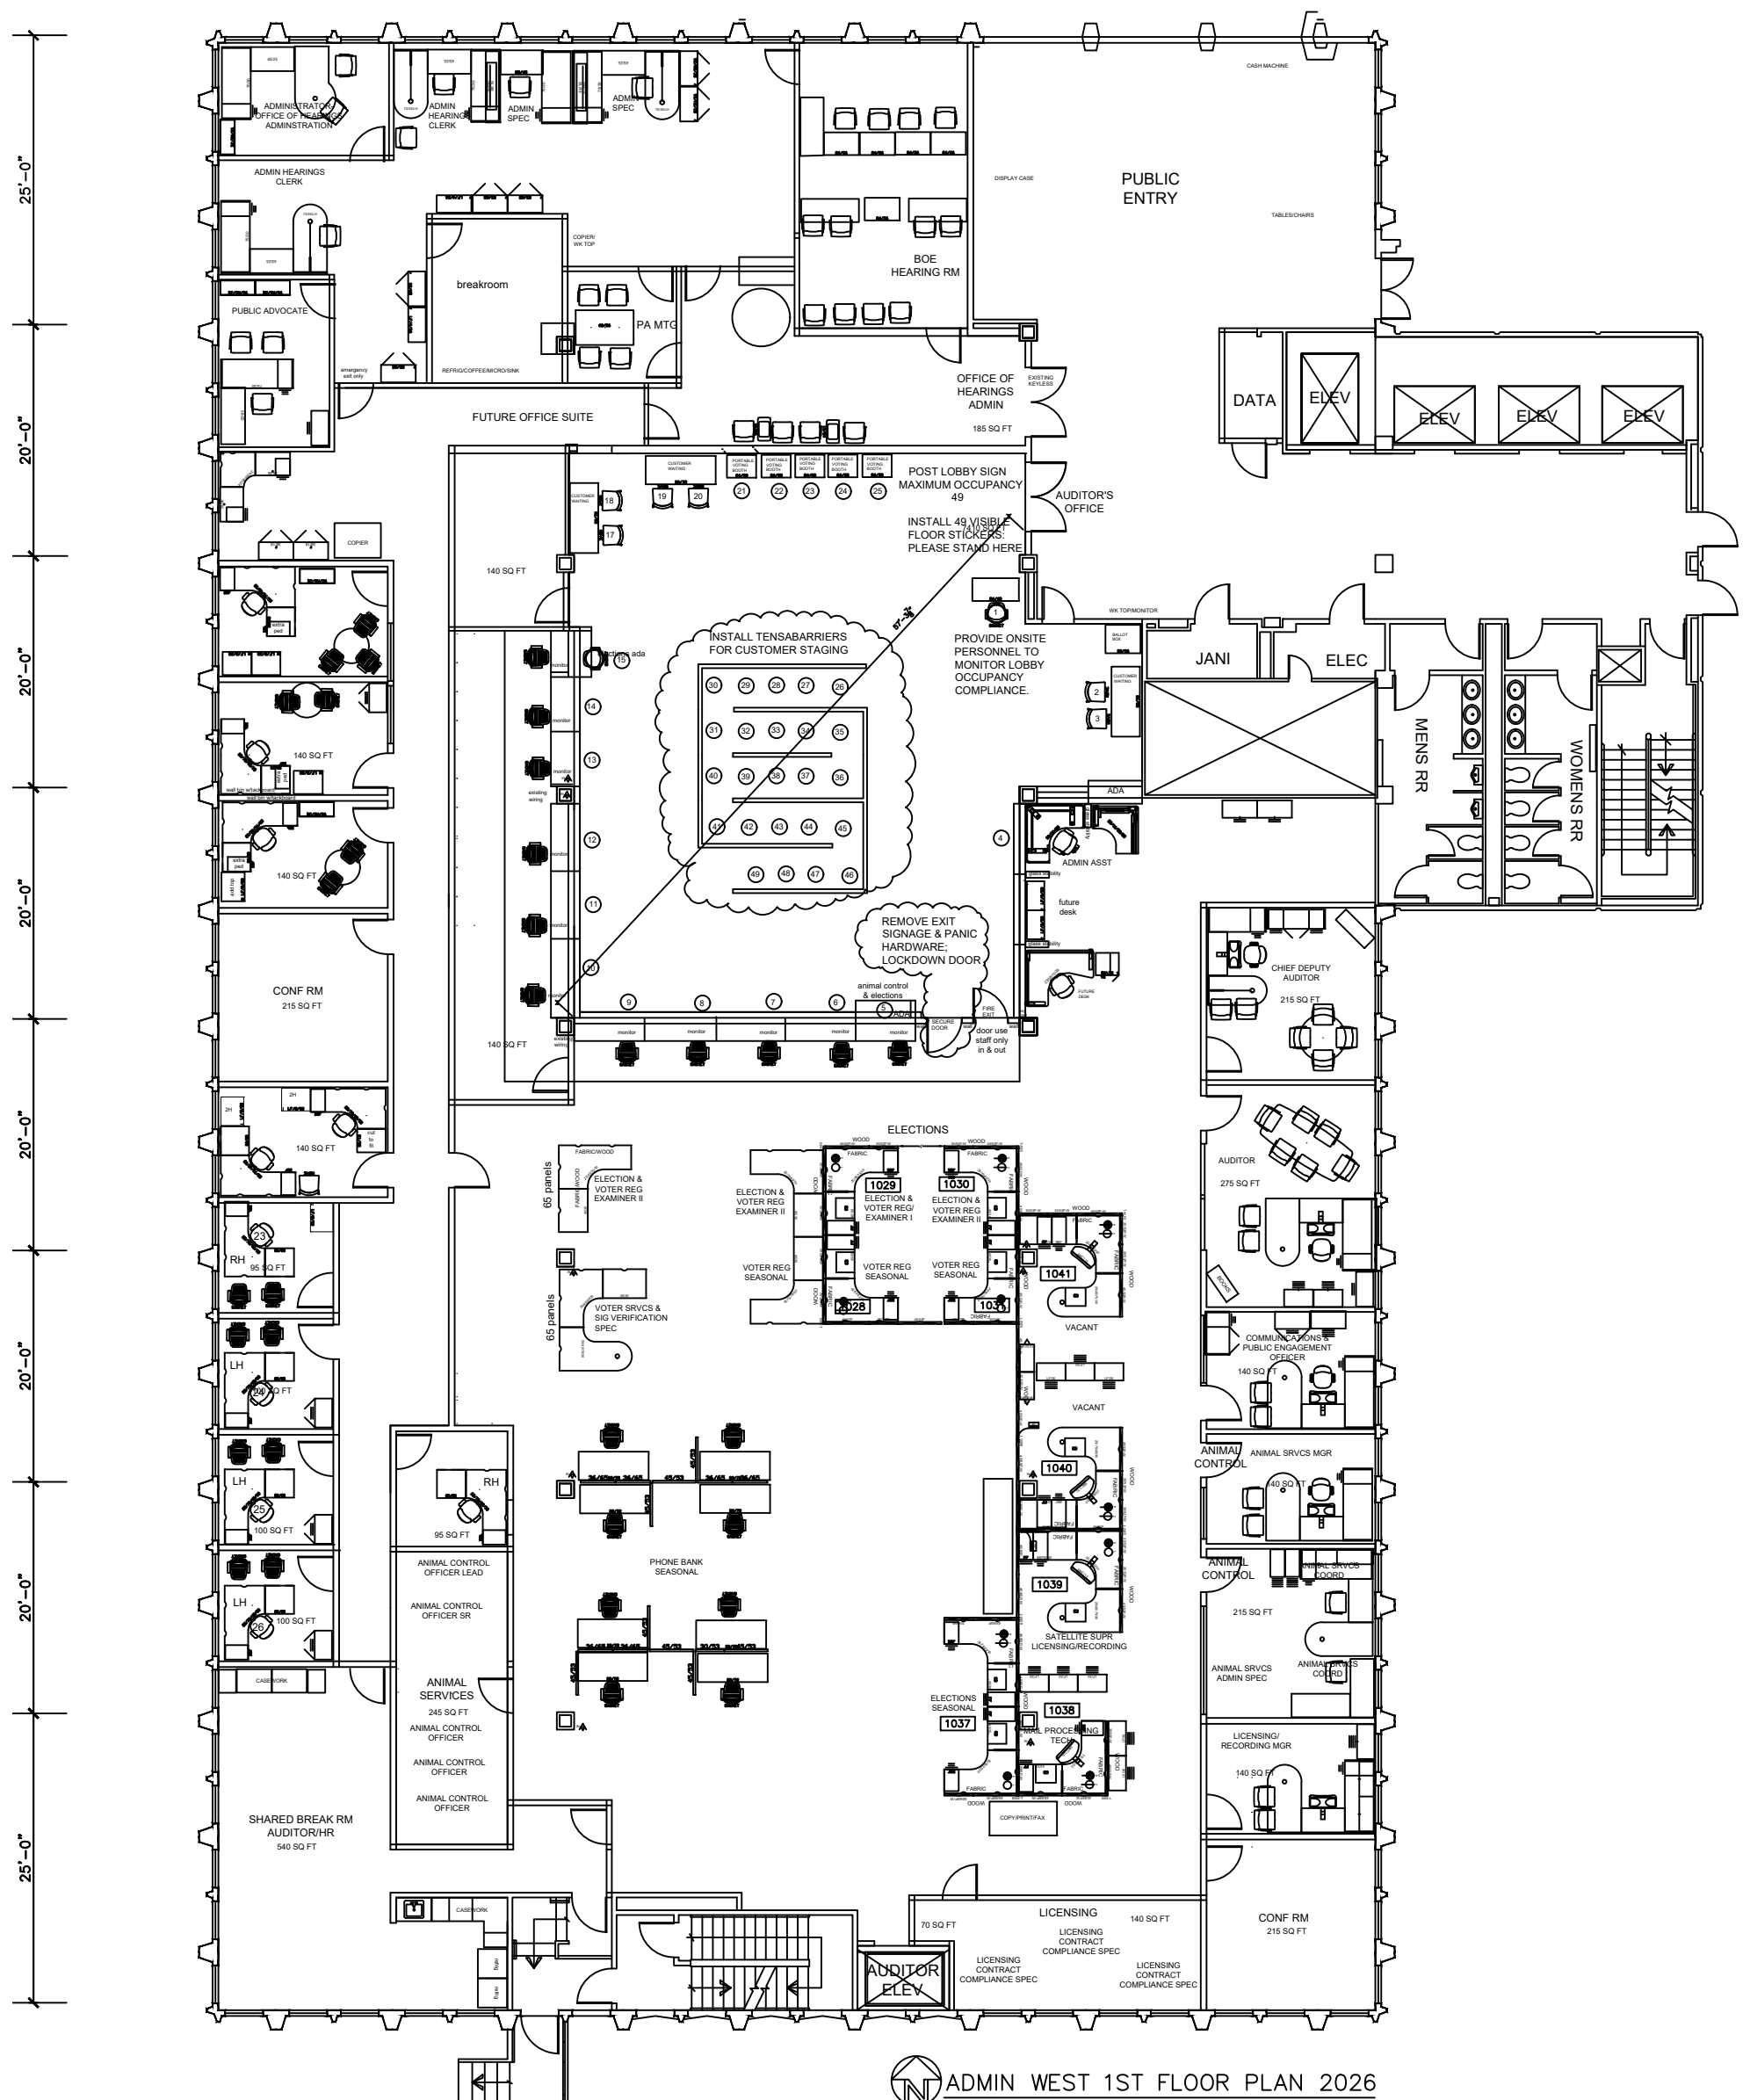

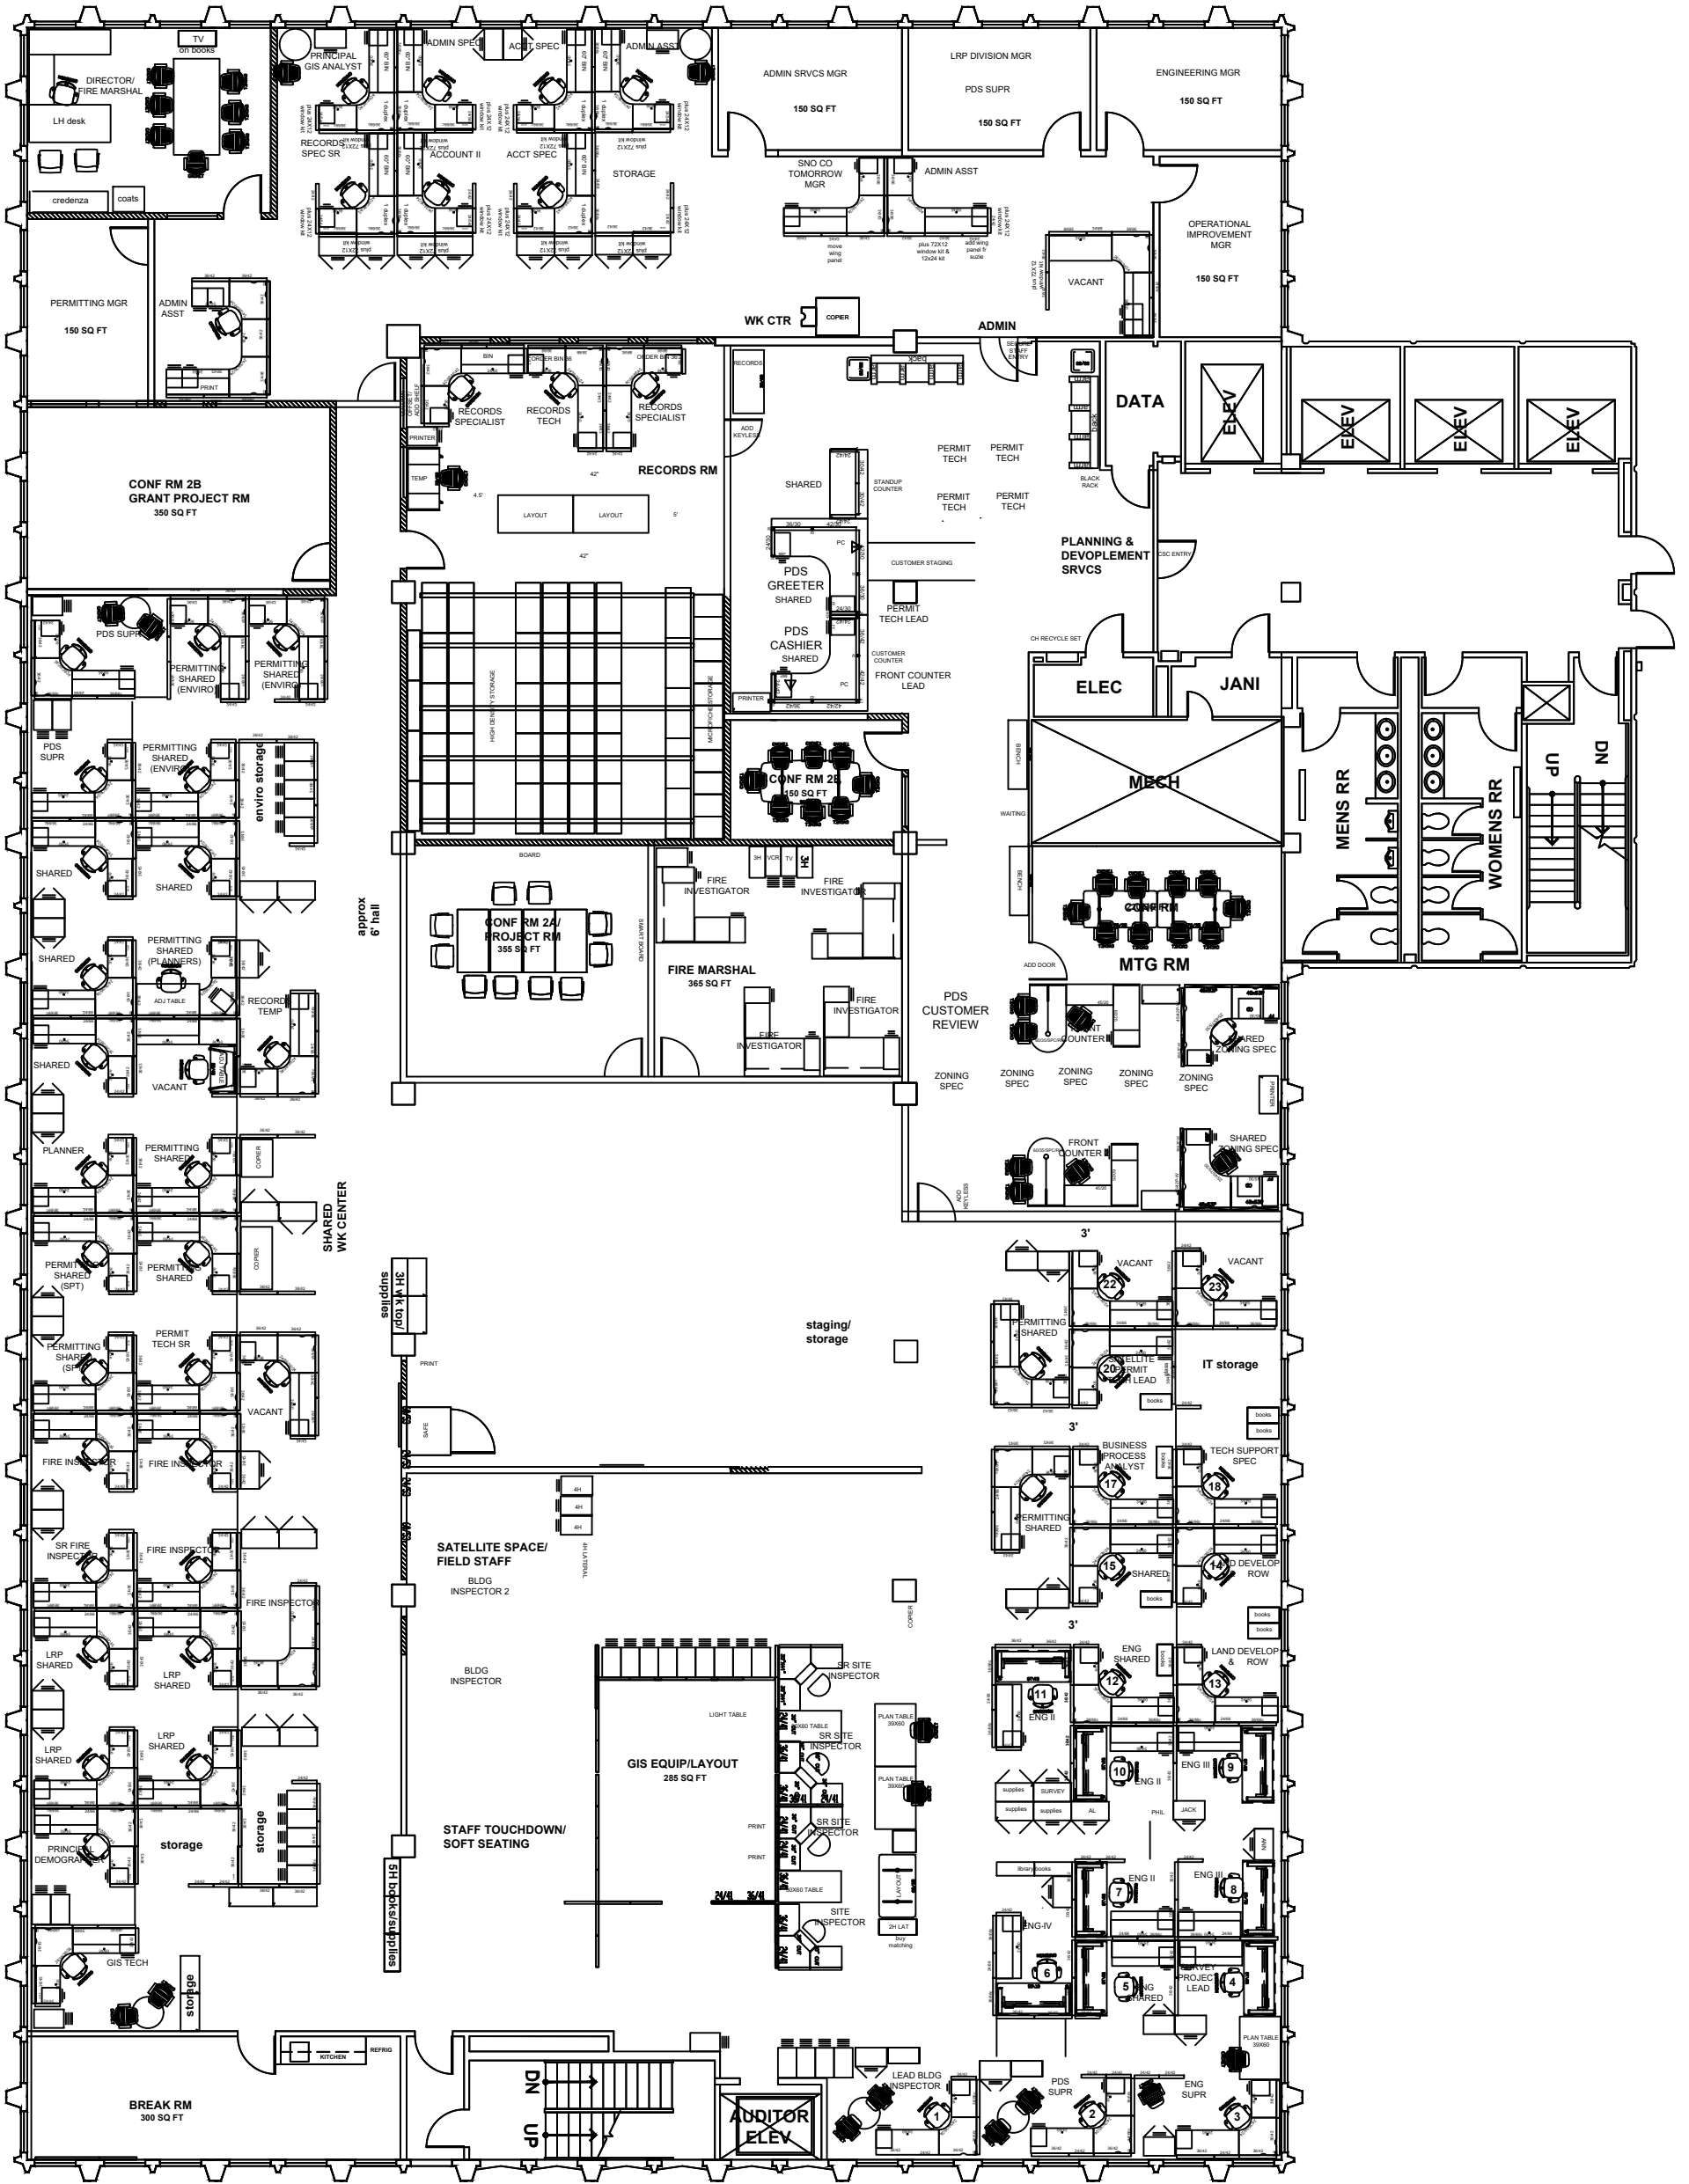

 ADMIN WEST 2ND FLOOR PLAN 2026

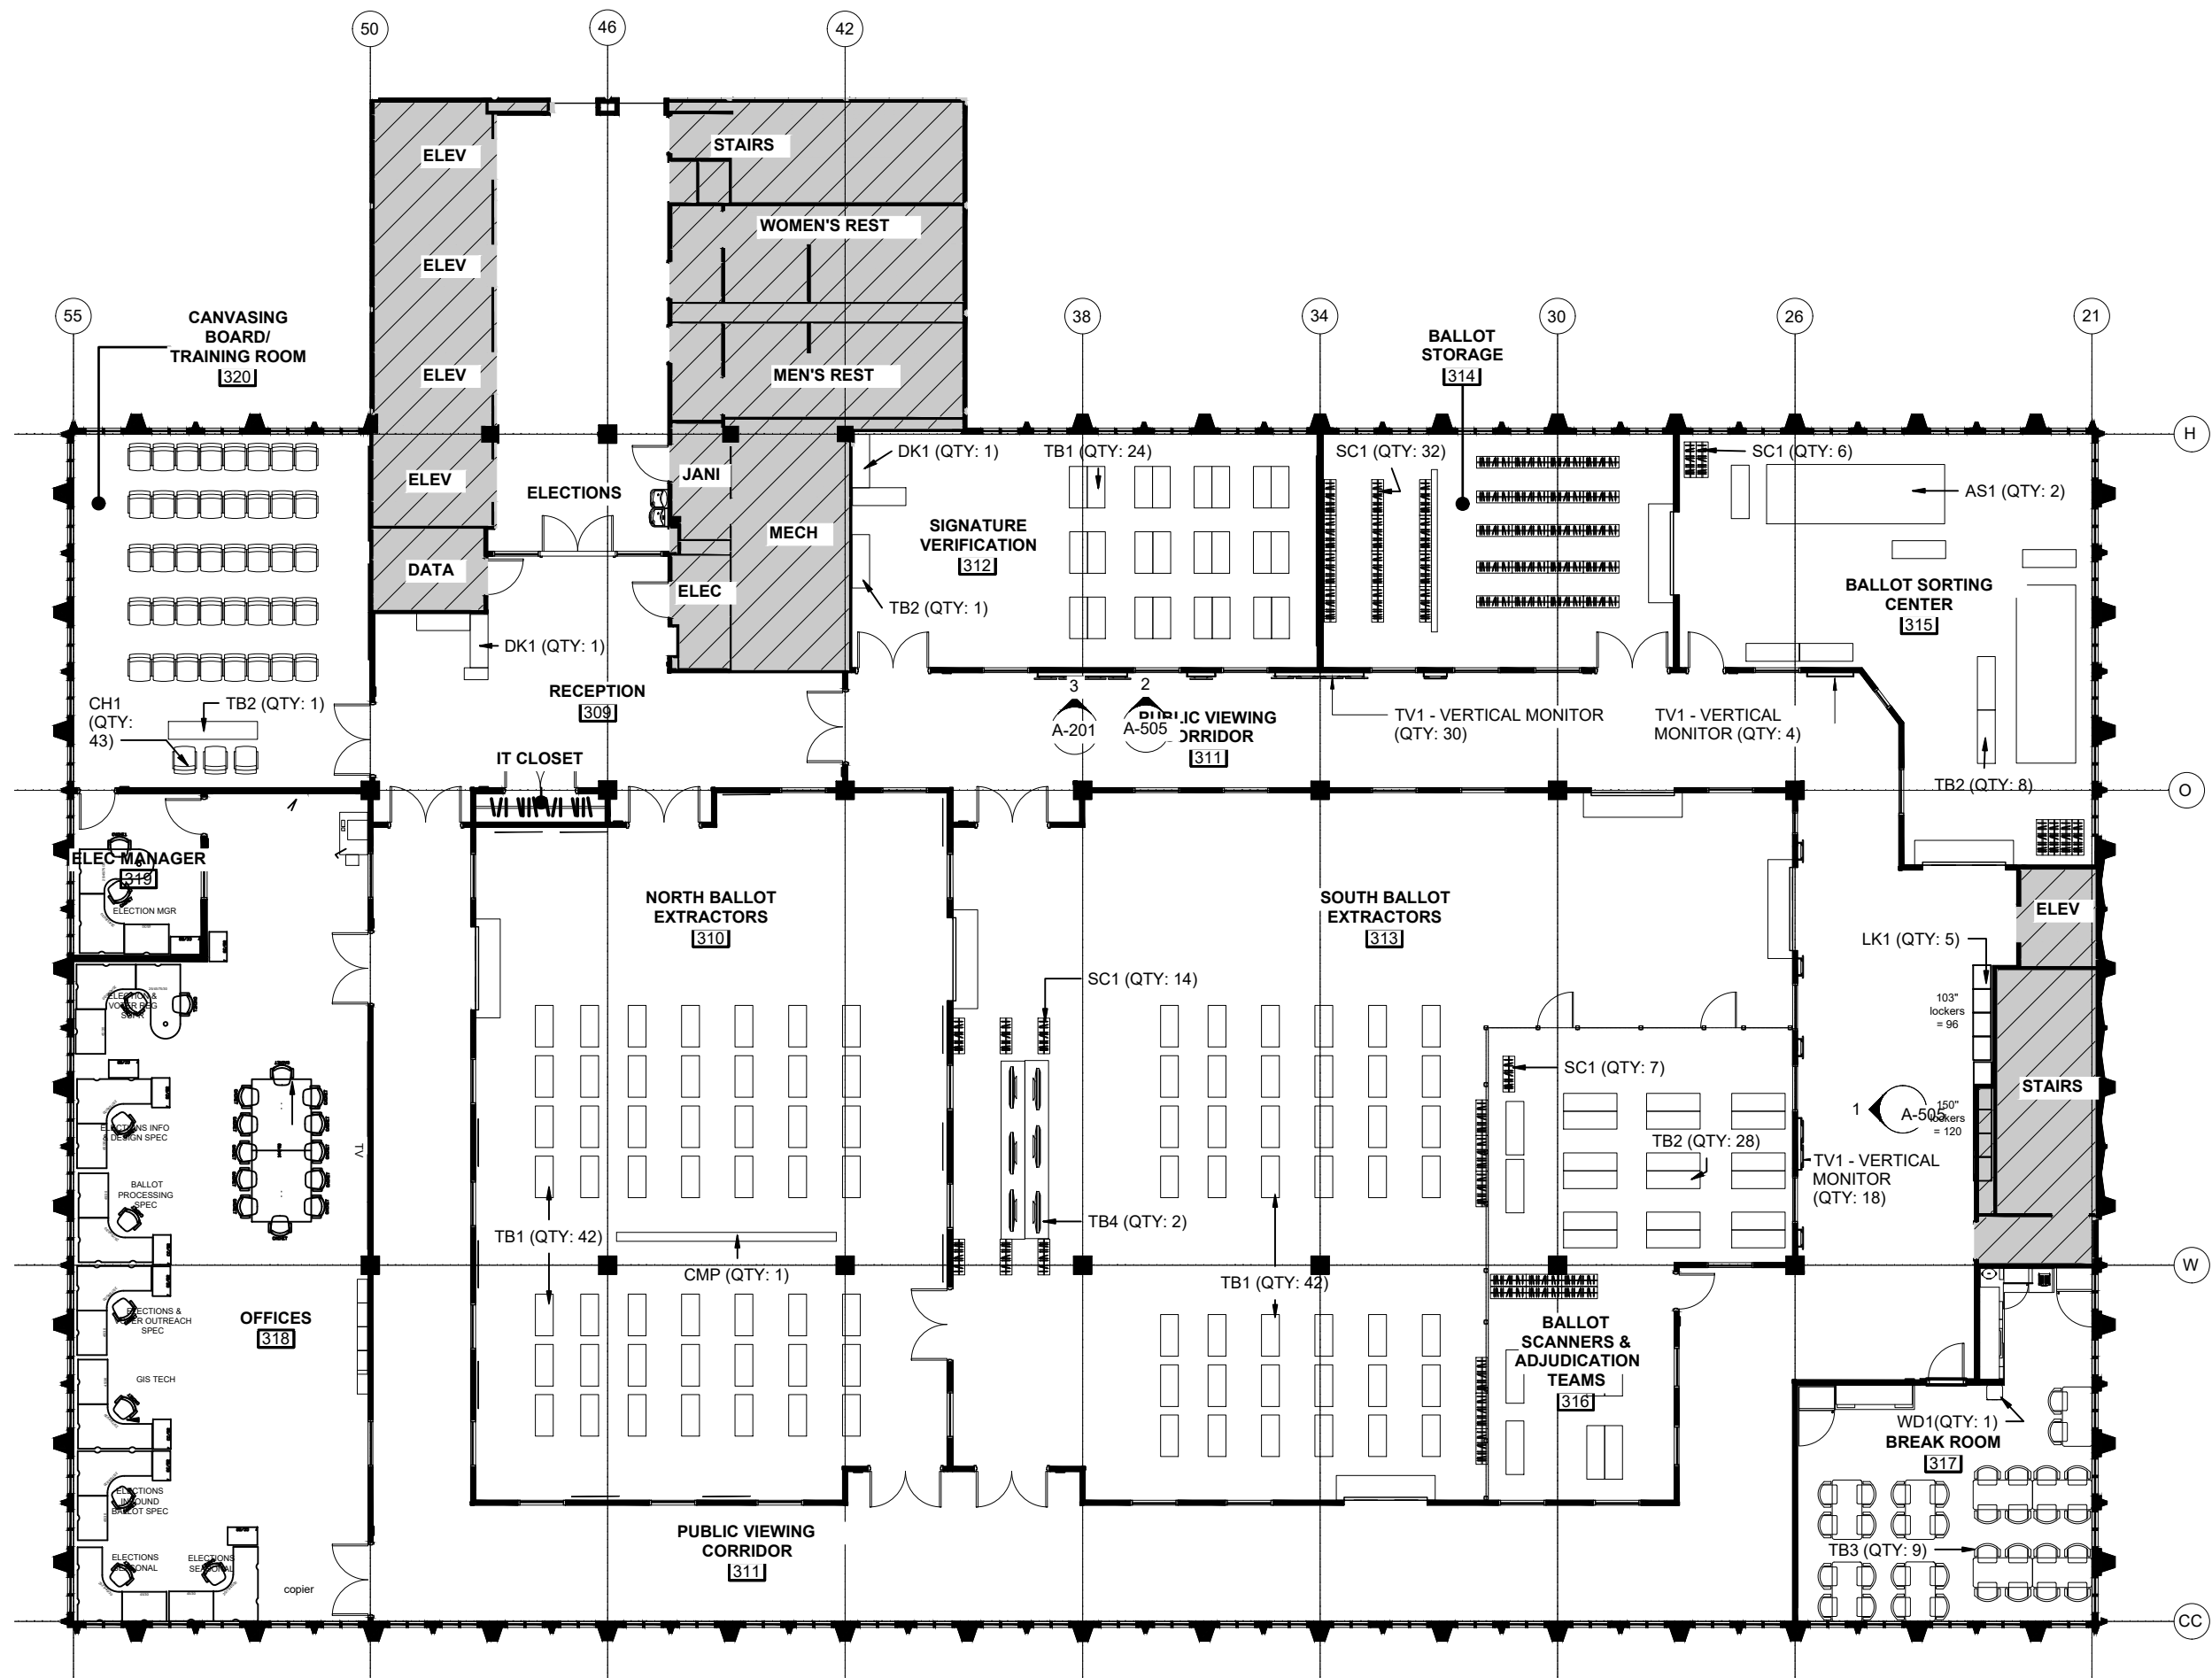


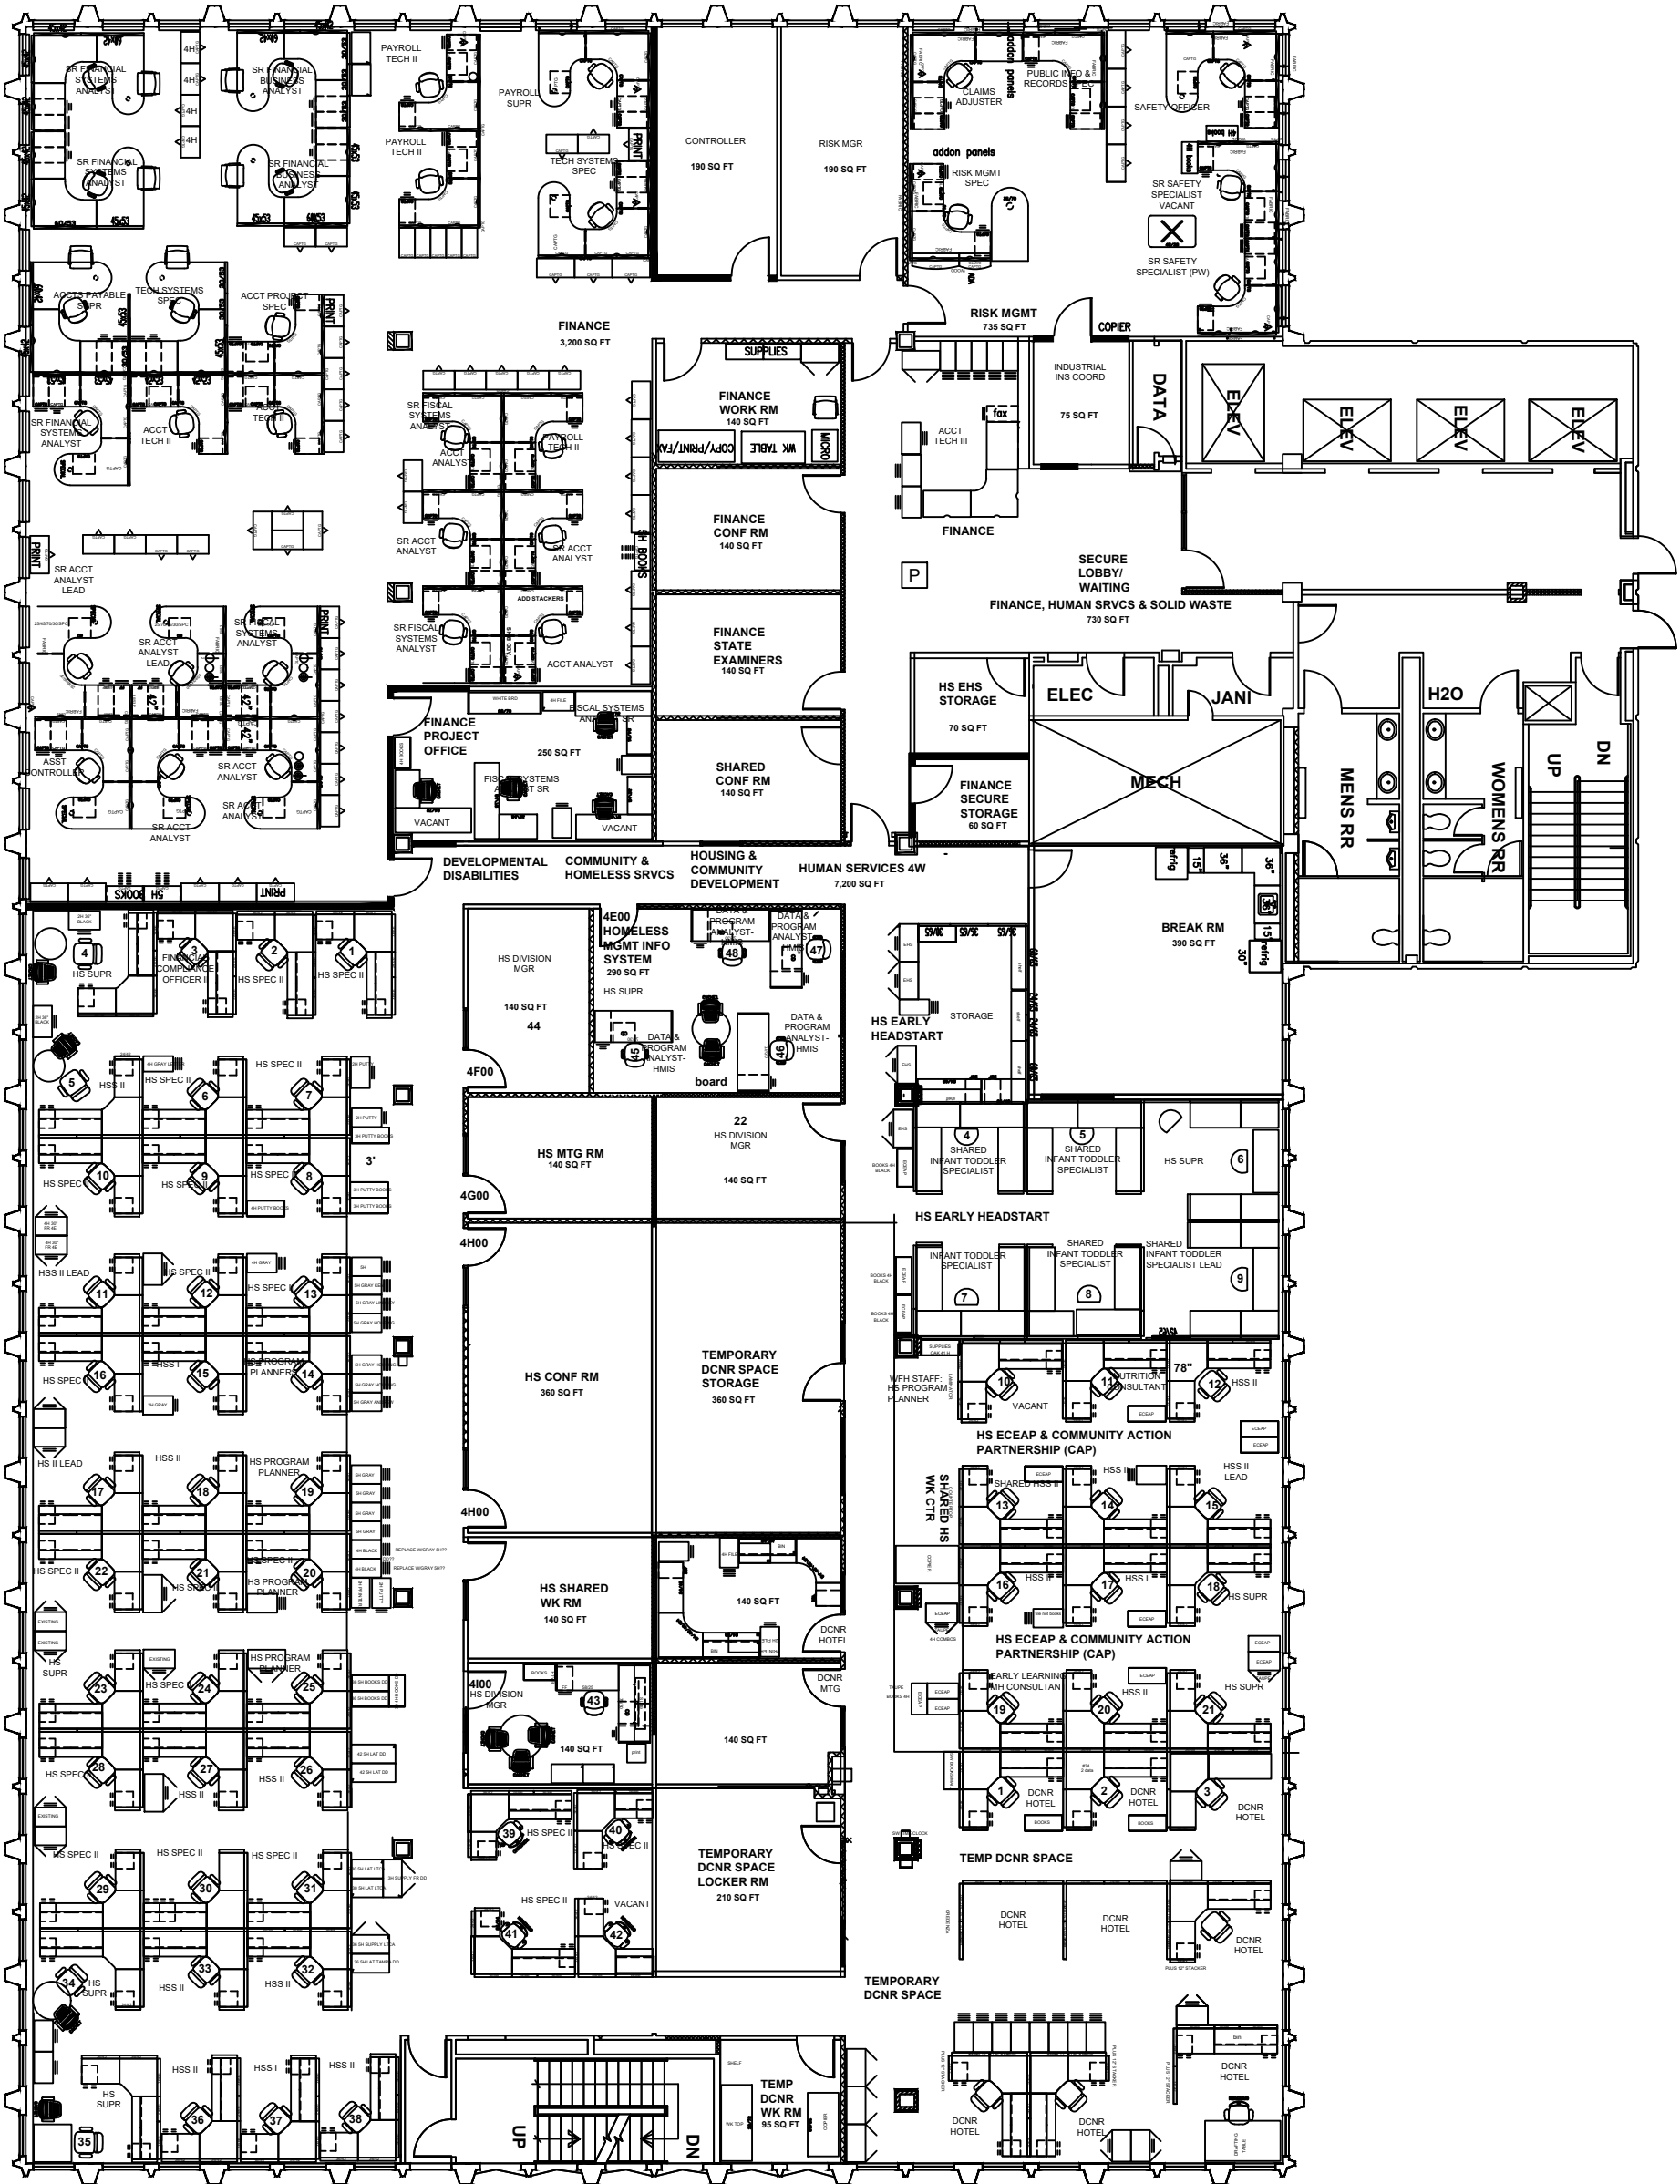

ADMIN WEST 4TH FLOOR PLAN 2026



ADMIN WEST 5TH FLOOR PLAN 2026

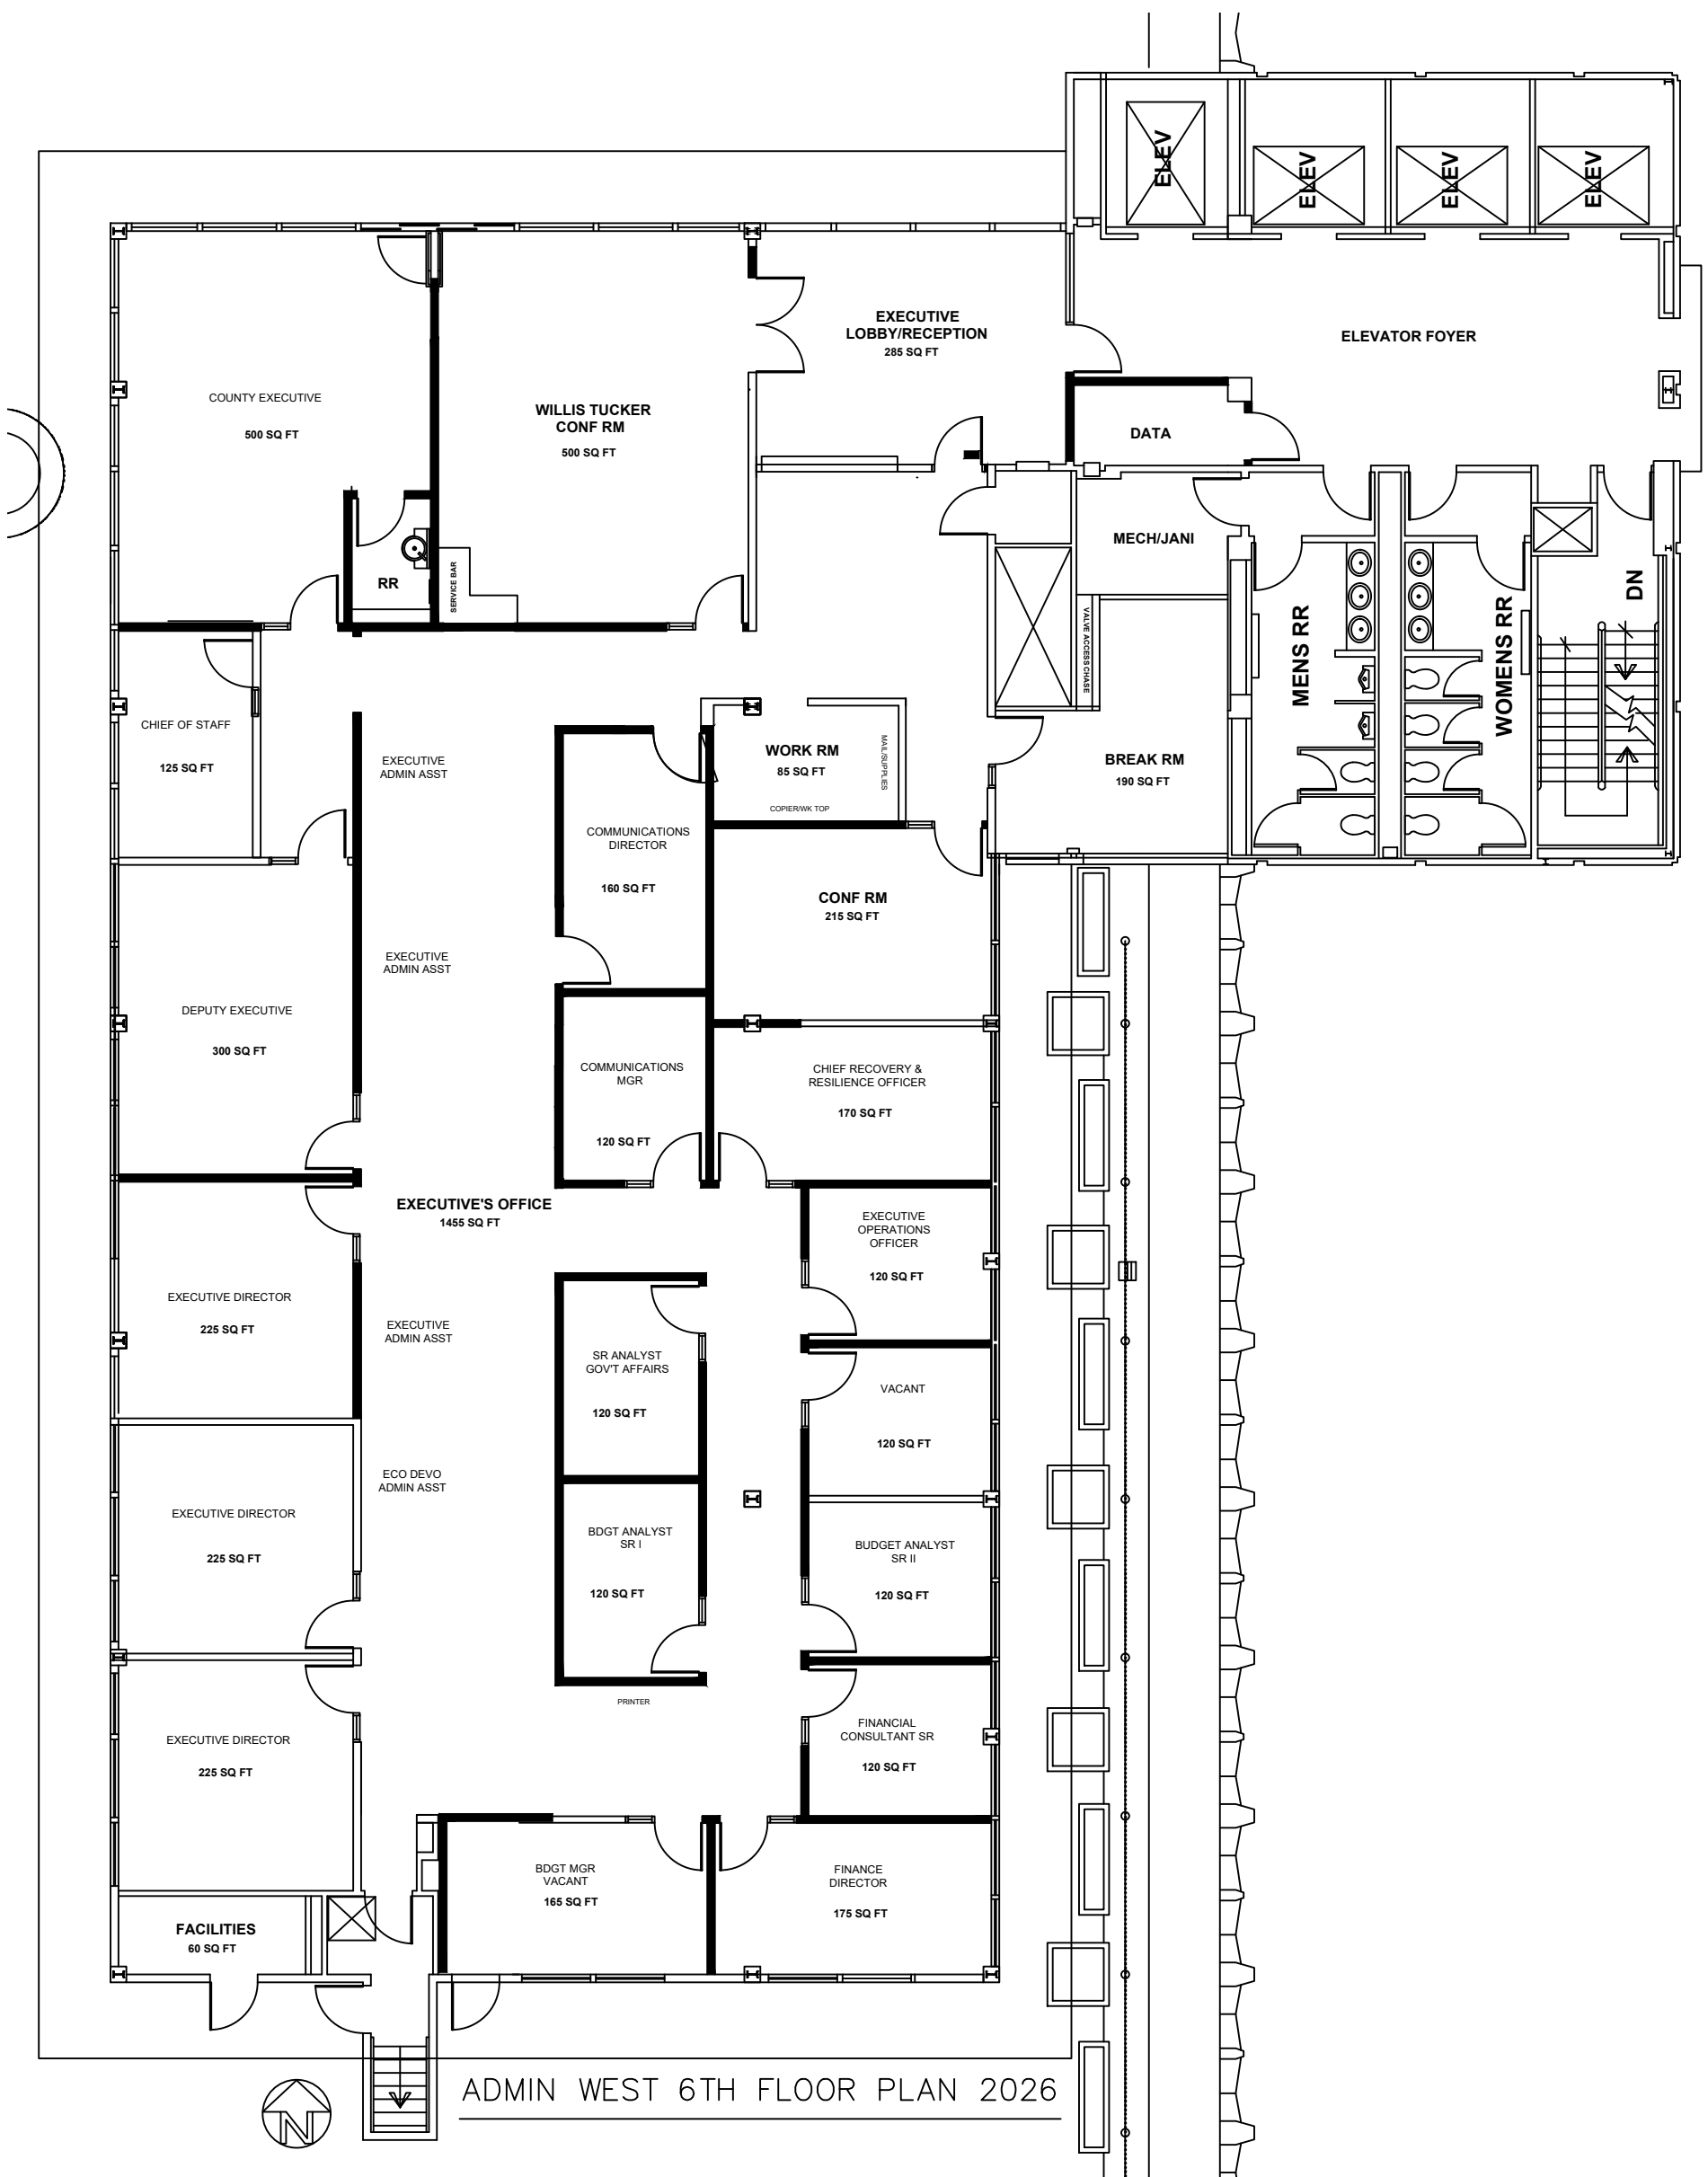

	B	C
1	SWM Staff as of 10/21/25	
2	JOB TITLE	Work Station
3	PROJECT SPECIALIST IV	
4	GIS ANALYST PRINCIPAL	
5	GRANTS ANALYST	
6	HABITAT SPECIALIST, SR	
7	PROJECT SPECIALIST IV	
8	ENGINEER II	40
9	ENGINEERING MANAGER	Manager Office
10	PLANNER SR II - SWM	
11	PLANNER-PWK	
12	PROJECT SPECIALIST IV	
13	ENG. TECH. V-DR	
14	WQ SPEC. III	
15	PUBLIC WORKS SUPV III	
16	PLANNER, SR-PW	68
17	Administrative Coordinator	5
18	CONSTRUCTION REP SR	
19	FISCAL RES ANALYST	
20	PUBLIC WORKS SUPV III	
21	PLANNER SR	
22	PLANNER-PWK	
23	PLANNER, SR-PW	
24	WATERSHED STEWARD	
25	PLANNER, SR II-SWM	
26	GIS Analyst	
27	SWTR UTILITY DIR	Manager Office
28	PUBLIC WORKS SUPV III	
29	HABITAT SPEC., SR	
30	ENG.TECH. SR- LEAD	
31	ENGINEER II	
32	ENGINEER IV	36
33	PLANNER, SR II - SWM	
34	GIS TECHNICIAN	
35	OA I	
36	BUS. TECHNOLOGY ANALYST	
37	PROJECT SPECIALIST IV	
38	PLANNER-PWK	
39	PROJECT SPECIALIST IV	35
40	OFFICE ASST II	7
41	ENGINEER IV	41
42	FUNDING COORDINATOR	
43	REAL PROPERTY COORD	59

	B	C
44	PROJECT SPECIALIST IV	50
45	ENG. TECH. V-DR	
46	WATERSHED STEWARD PRINCIPAL	
47	ENG. TECH. SR	56
48	PLANNER-PWK	
49	ENG. TECH. V-DR	
50	BIOLOGIST	65
51	ENGINEER II	44
52	PUBLIC WORKS SUPV IV	37
53	CONSTRUCTION REP SR	
54	PUBLIC WORKS SUPV III	42
55	ENV. PROG. COMP. SPEC.	
56	PROJECT SPECIALIST IV	
57	WQ ANALYST	
58	ENG. TECH. SR	
59	PUBLIC WORKS SUPV III	
60	ENGINEER III	39
61	ENGINEER I - DESIGN	
62	ENG. TECH. V	46
63	PUBLIC WORKS SUPV II-(Shared Services)	
64	ENG TECH SR - CONST	57
65	GIS ANALYST, SR	
66	ENG. TECH. IV-DR	
67	PROJECT SPECIALIST IV	
68	ENG. TECH. V-DR	
69	ENG. TECH. V-DR	
70	COMM. SPEC. II-(Shared Services)	
71	WQ SPECIALIST II	
72	NOXIOUS WEED ASST	
73	ENG. TECH. V-DR	
74	ENGINEER II	
75	WATERSHED STEWARD	
76	HABITAT SPECIALIST, SR	
77	PLANNER, SR II - SWM	
78	CONTRACTS SPEC (Shared Services)	
79	PUBLIC WORKS SUPV III	60
80	ENG. TECH. IV-DR	
81	HR SPECIALIST-(Shared Services)	
82	ENGINEER I	
83	ADMIN SUPPORT SUPV	31
84	PLANNER SR	
85	ENGINEER II	
86	ENG. TECH. V-DR	

	B	C
87	PLANNER, SR-PW	
88	TECH SUPPORT SPECIALIST	3
89	ENGINEER II	
90	PROJECT SPECIALIST IV	38
91	ENG. TECH. IV-DR	
92	ENG. TECH. V - DR	
93	GIS ANALYST, SR	
94	PLANNER-PWK	
95	FINANCIAL SYSTEMS COORDINATOR	
96	WQ ANALYST	
97	REAL PROPERTY SPEC II	61
98	ENGINEER IV	
99	SWM PLANNING MGR	Manager Office
100	ENGINEER III	67
101	GIS ANALYST, SR	
102	ENG. TECH. IV	
103	WQ SPECIALIST II	
104	ENG. TECH. IV-DR	47
105	ENG TECH SR- CONST	
106	CONTRACT ADMINISTRATOR	
107	ACCOUNTING TECH II	51
108	PLANNER-PWK	
109	ENGINEER III	
110	ACCOUNTANT I	4

Program:



Case Management, Long Term Care & Aging

Staff Primarily Working Fr Home:

- CM (55)
- CM Lead (3)
- HSS II (6)
- HSS II Lead (2)
- RN (2)

- MA, CM
- VA, CM
- AA, CM
- DA, CM
- MB, CM
- BB, CM
- MB, HSS II Lead
- DC, CM Lead
- CC, CM
- KC, RN
- AC, HSS II
- IC, CM
- WD, HSS II
- MD, CM
- SD, CM
- GD, CM
- ME, CM
- MF, CM
- SF, CM
- JG, CM
- OG, CM
- MG, CM
- SH, CM
- MH, HSS II
- JH, CM
- HH, CM
- AK, CM
- HK, CM
- LK, CM
- DK, CM
- CK, CM
- SK, CM
- AK, CM
- JL, CM


- EL, CM
- LL, CM
- SL, CM
- RL, CM
- ML, CM
- EL, CM
- AL, CM
- JM, CM
- OM, CM
- AM, CM
- AM, CM
- TN, CM
- AN, CM
- RO, CM Lead
- JO, CM
- SP, CM
- WP, CM
- LP, CM
- PP, CM
- JR, CM
- DR, CM
- LR, CM
- SS, RN
- MS, CM
- SS, HSS II
- ES, CM
- KT, HSS II Lead
- AU, HSS II
- RV, CM Lead
- LV, CM
- LV, HSS II
- WW, CM
- HW, CM
- LY, CM

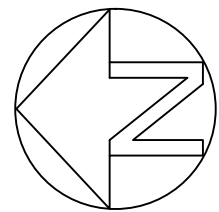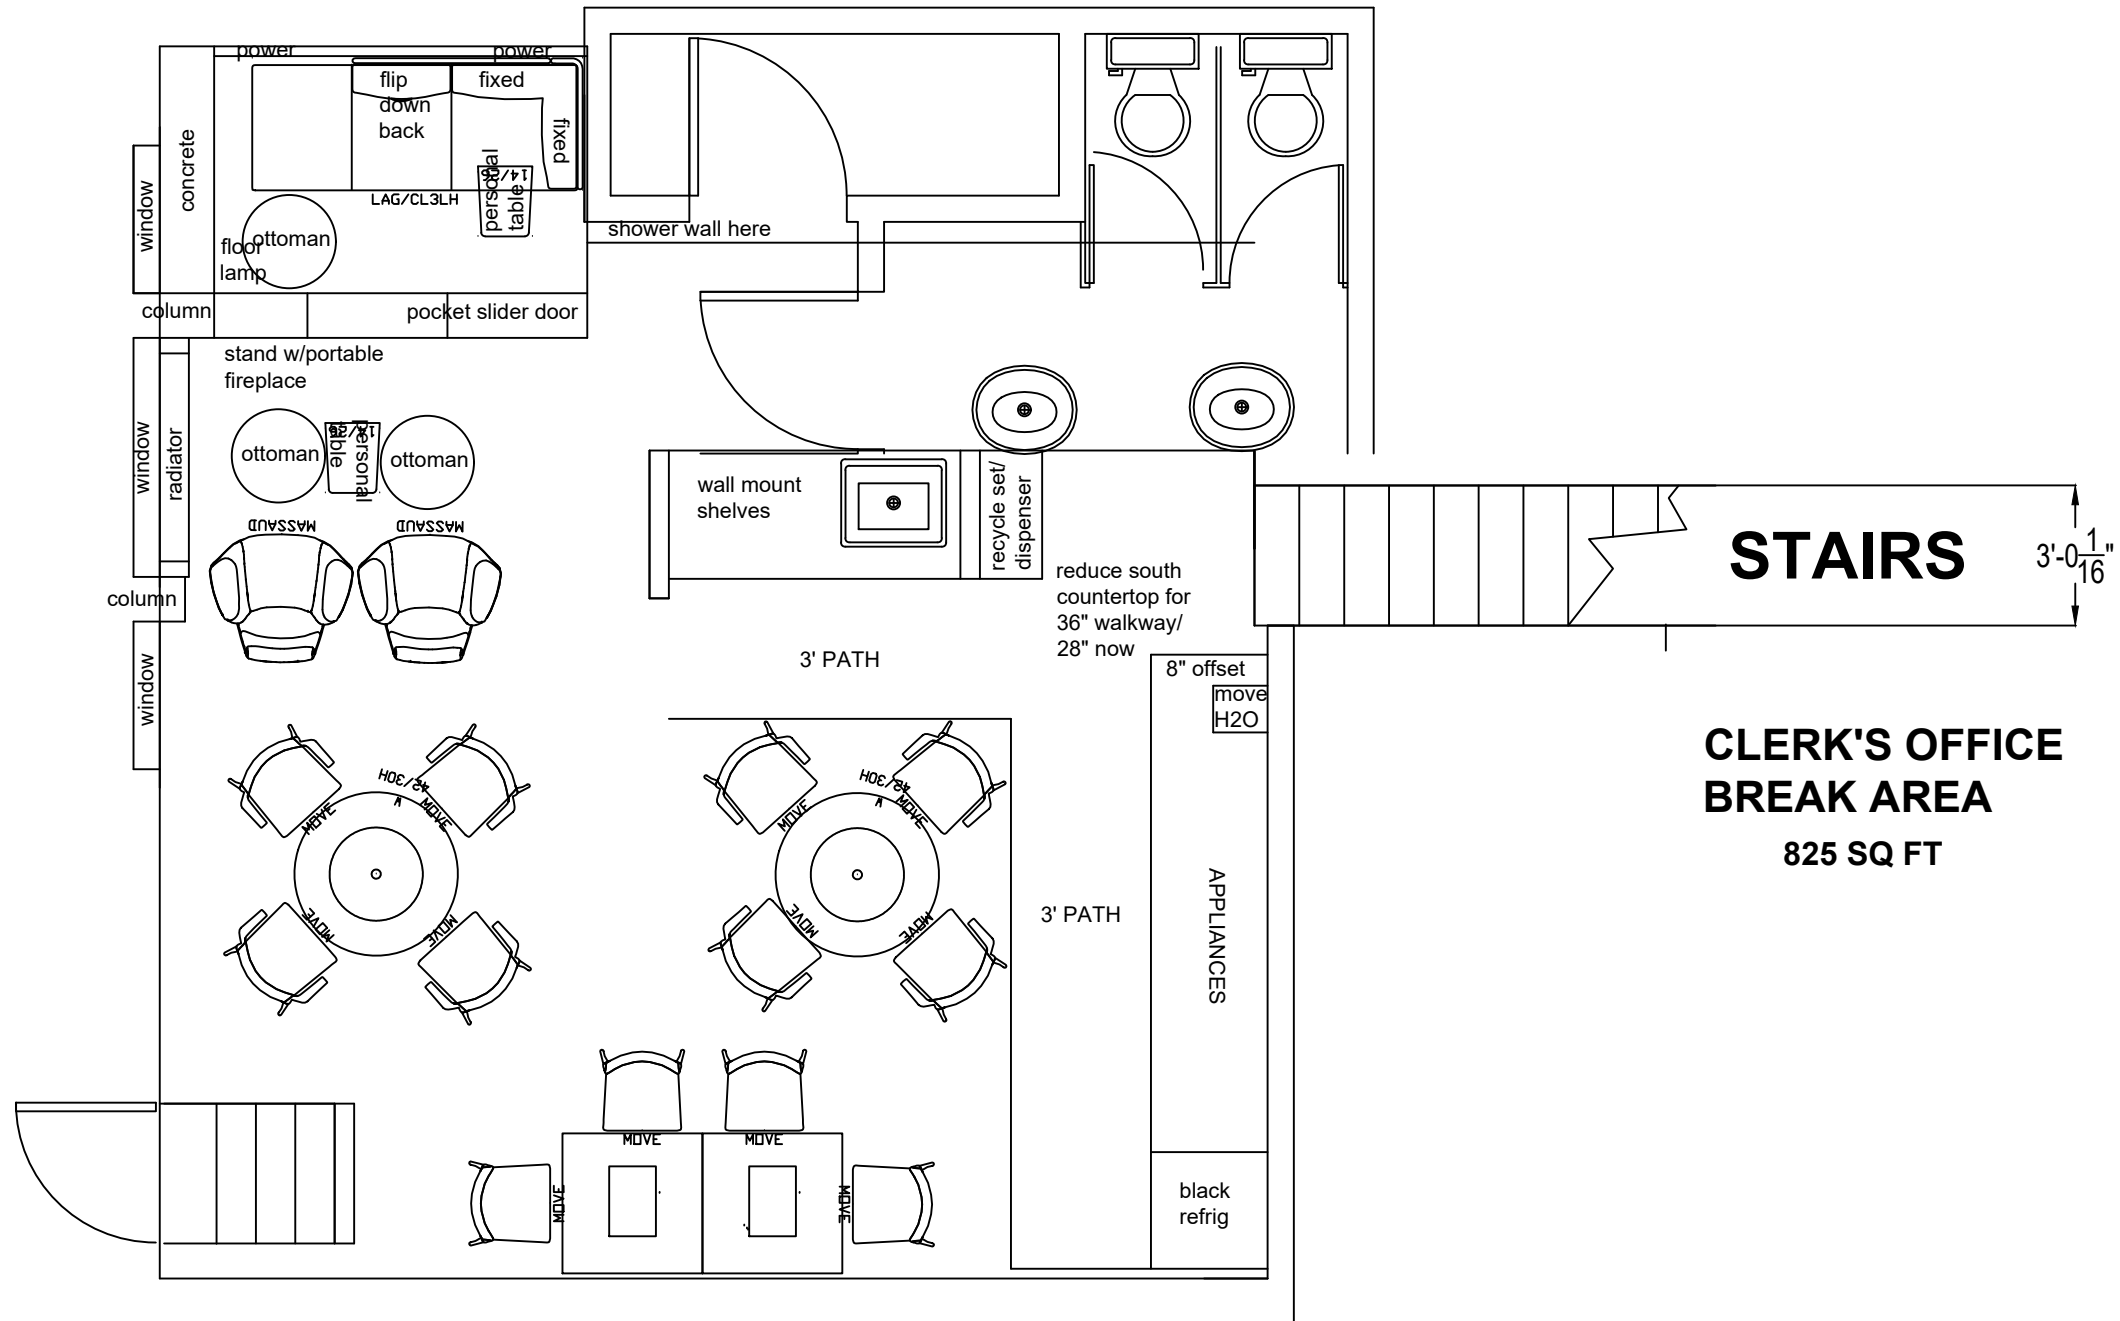


MISSION MEZZANINE FLOOR PLAN 2026


1/8"=1'-0"


FIELD VERIFY EVERYTHING; BACKGROUND WRONG.

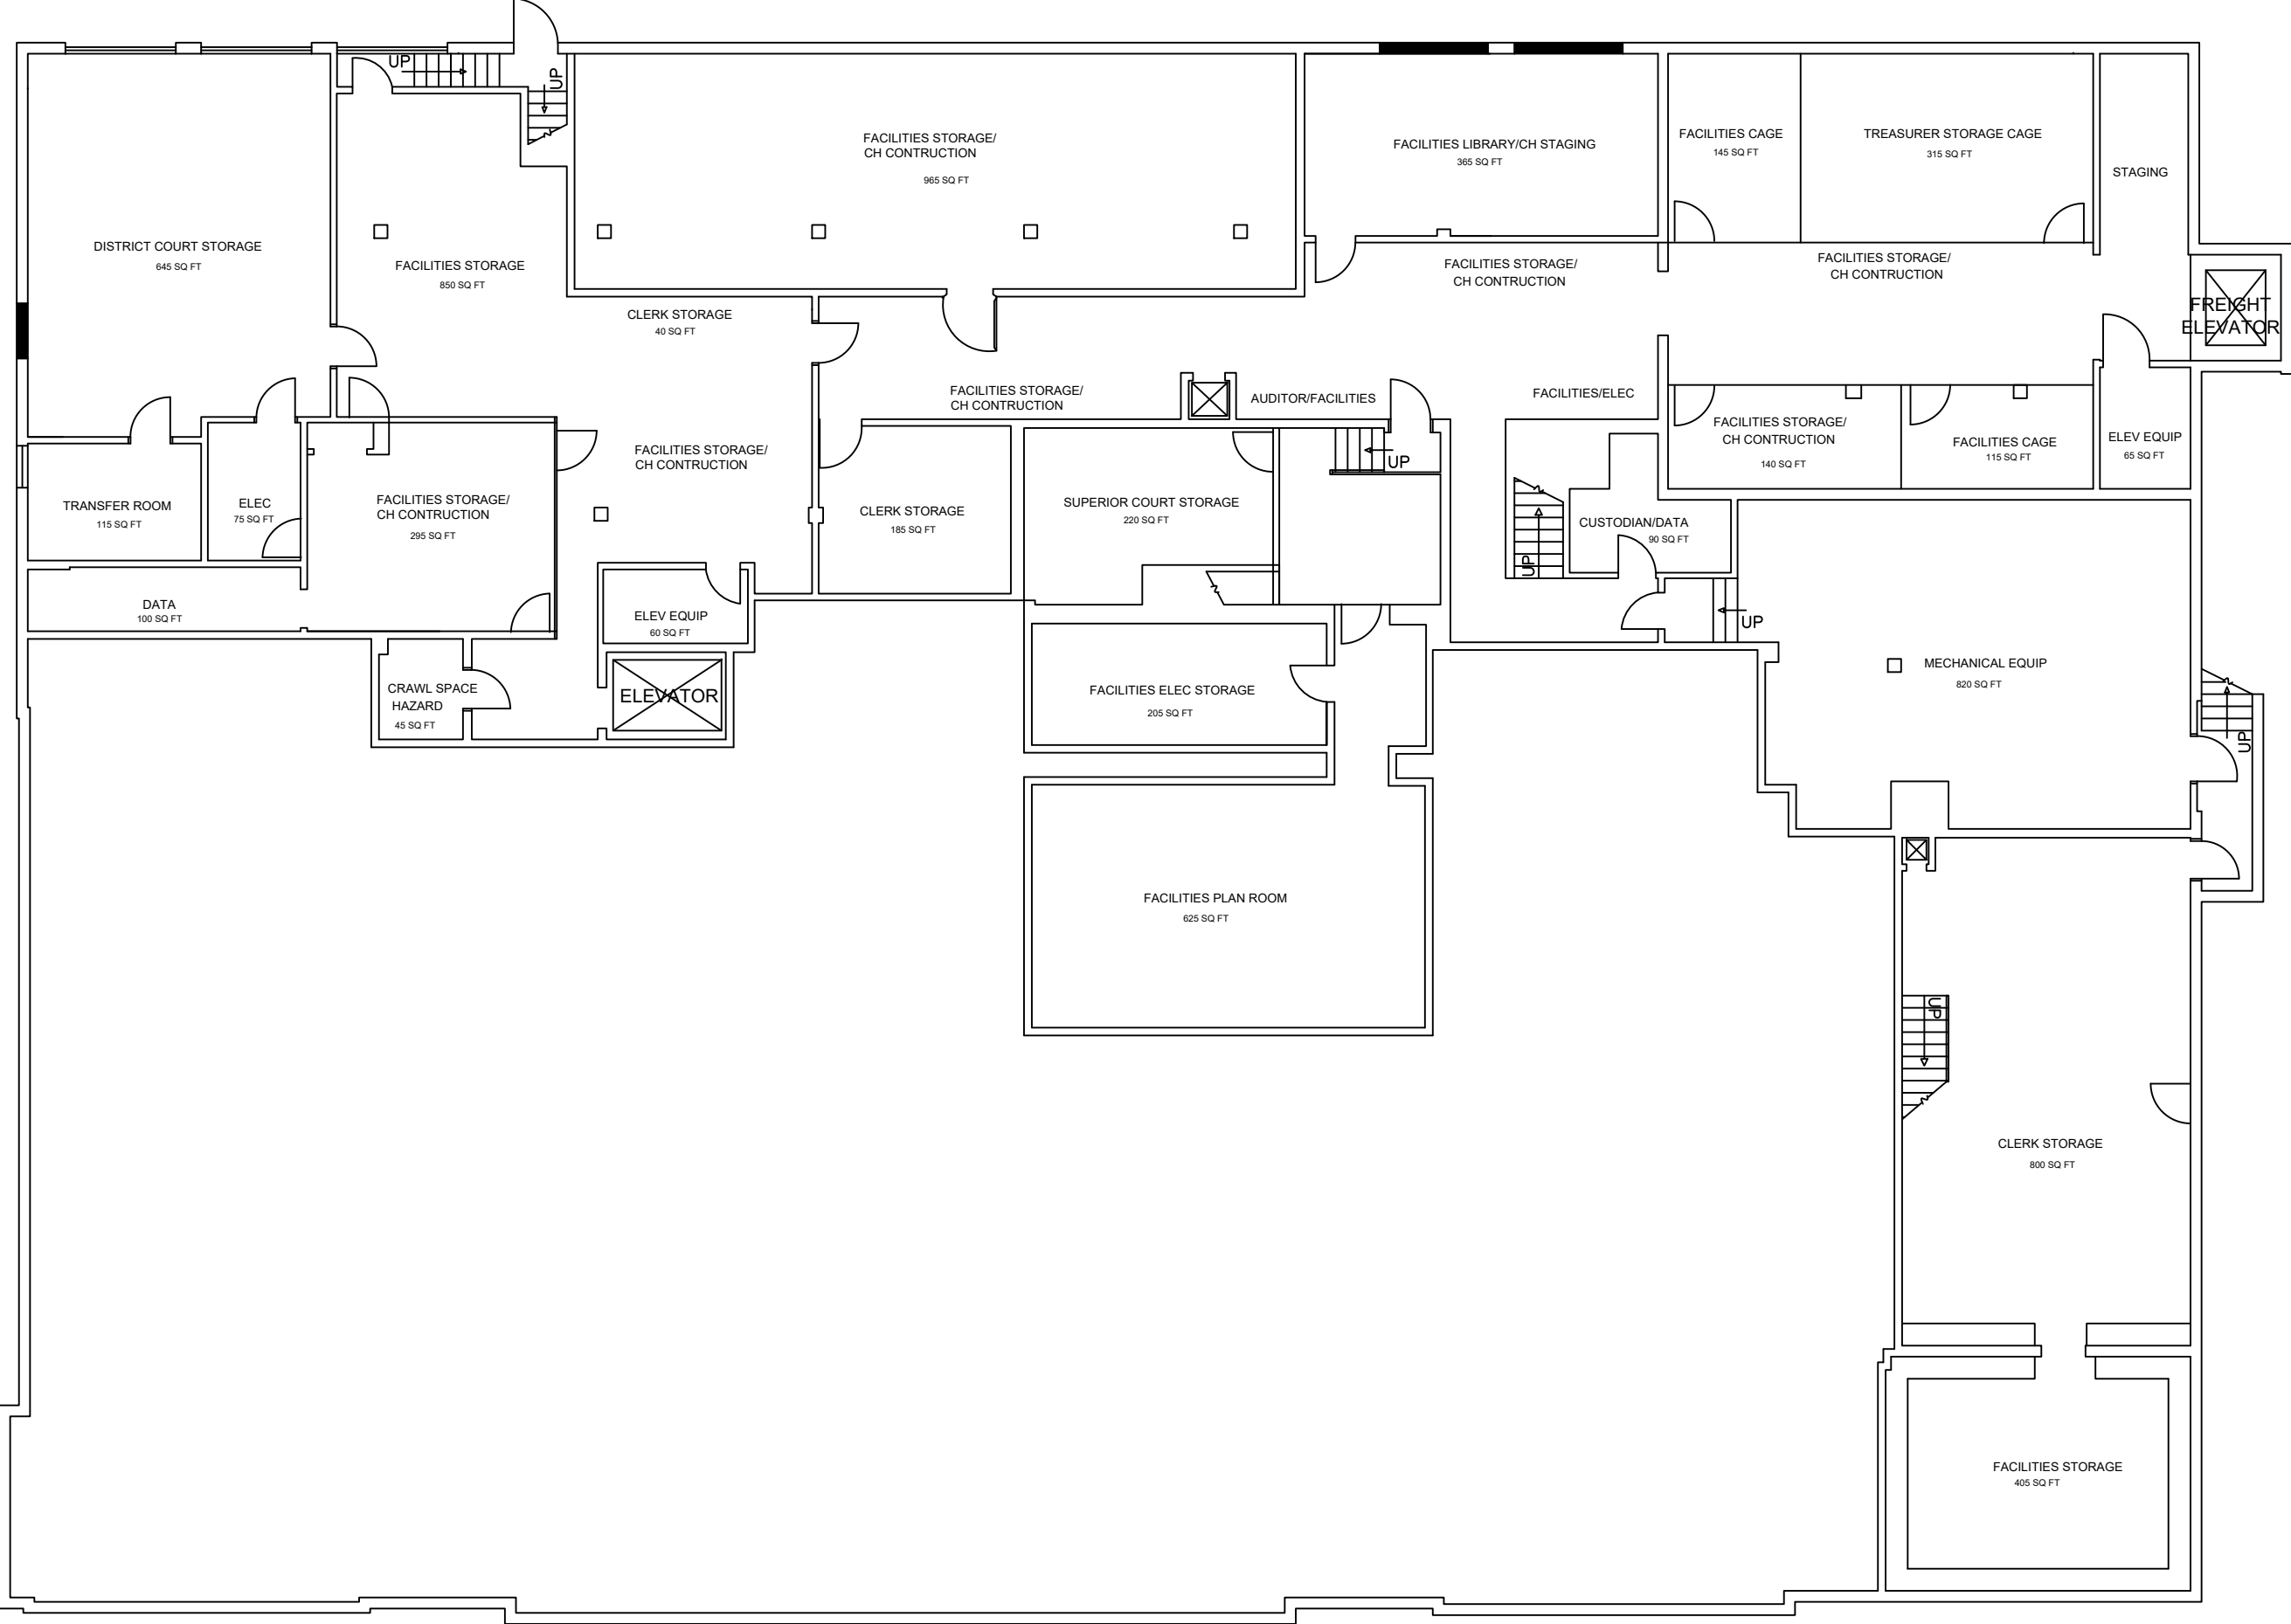

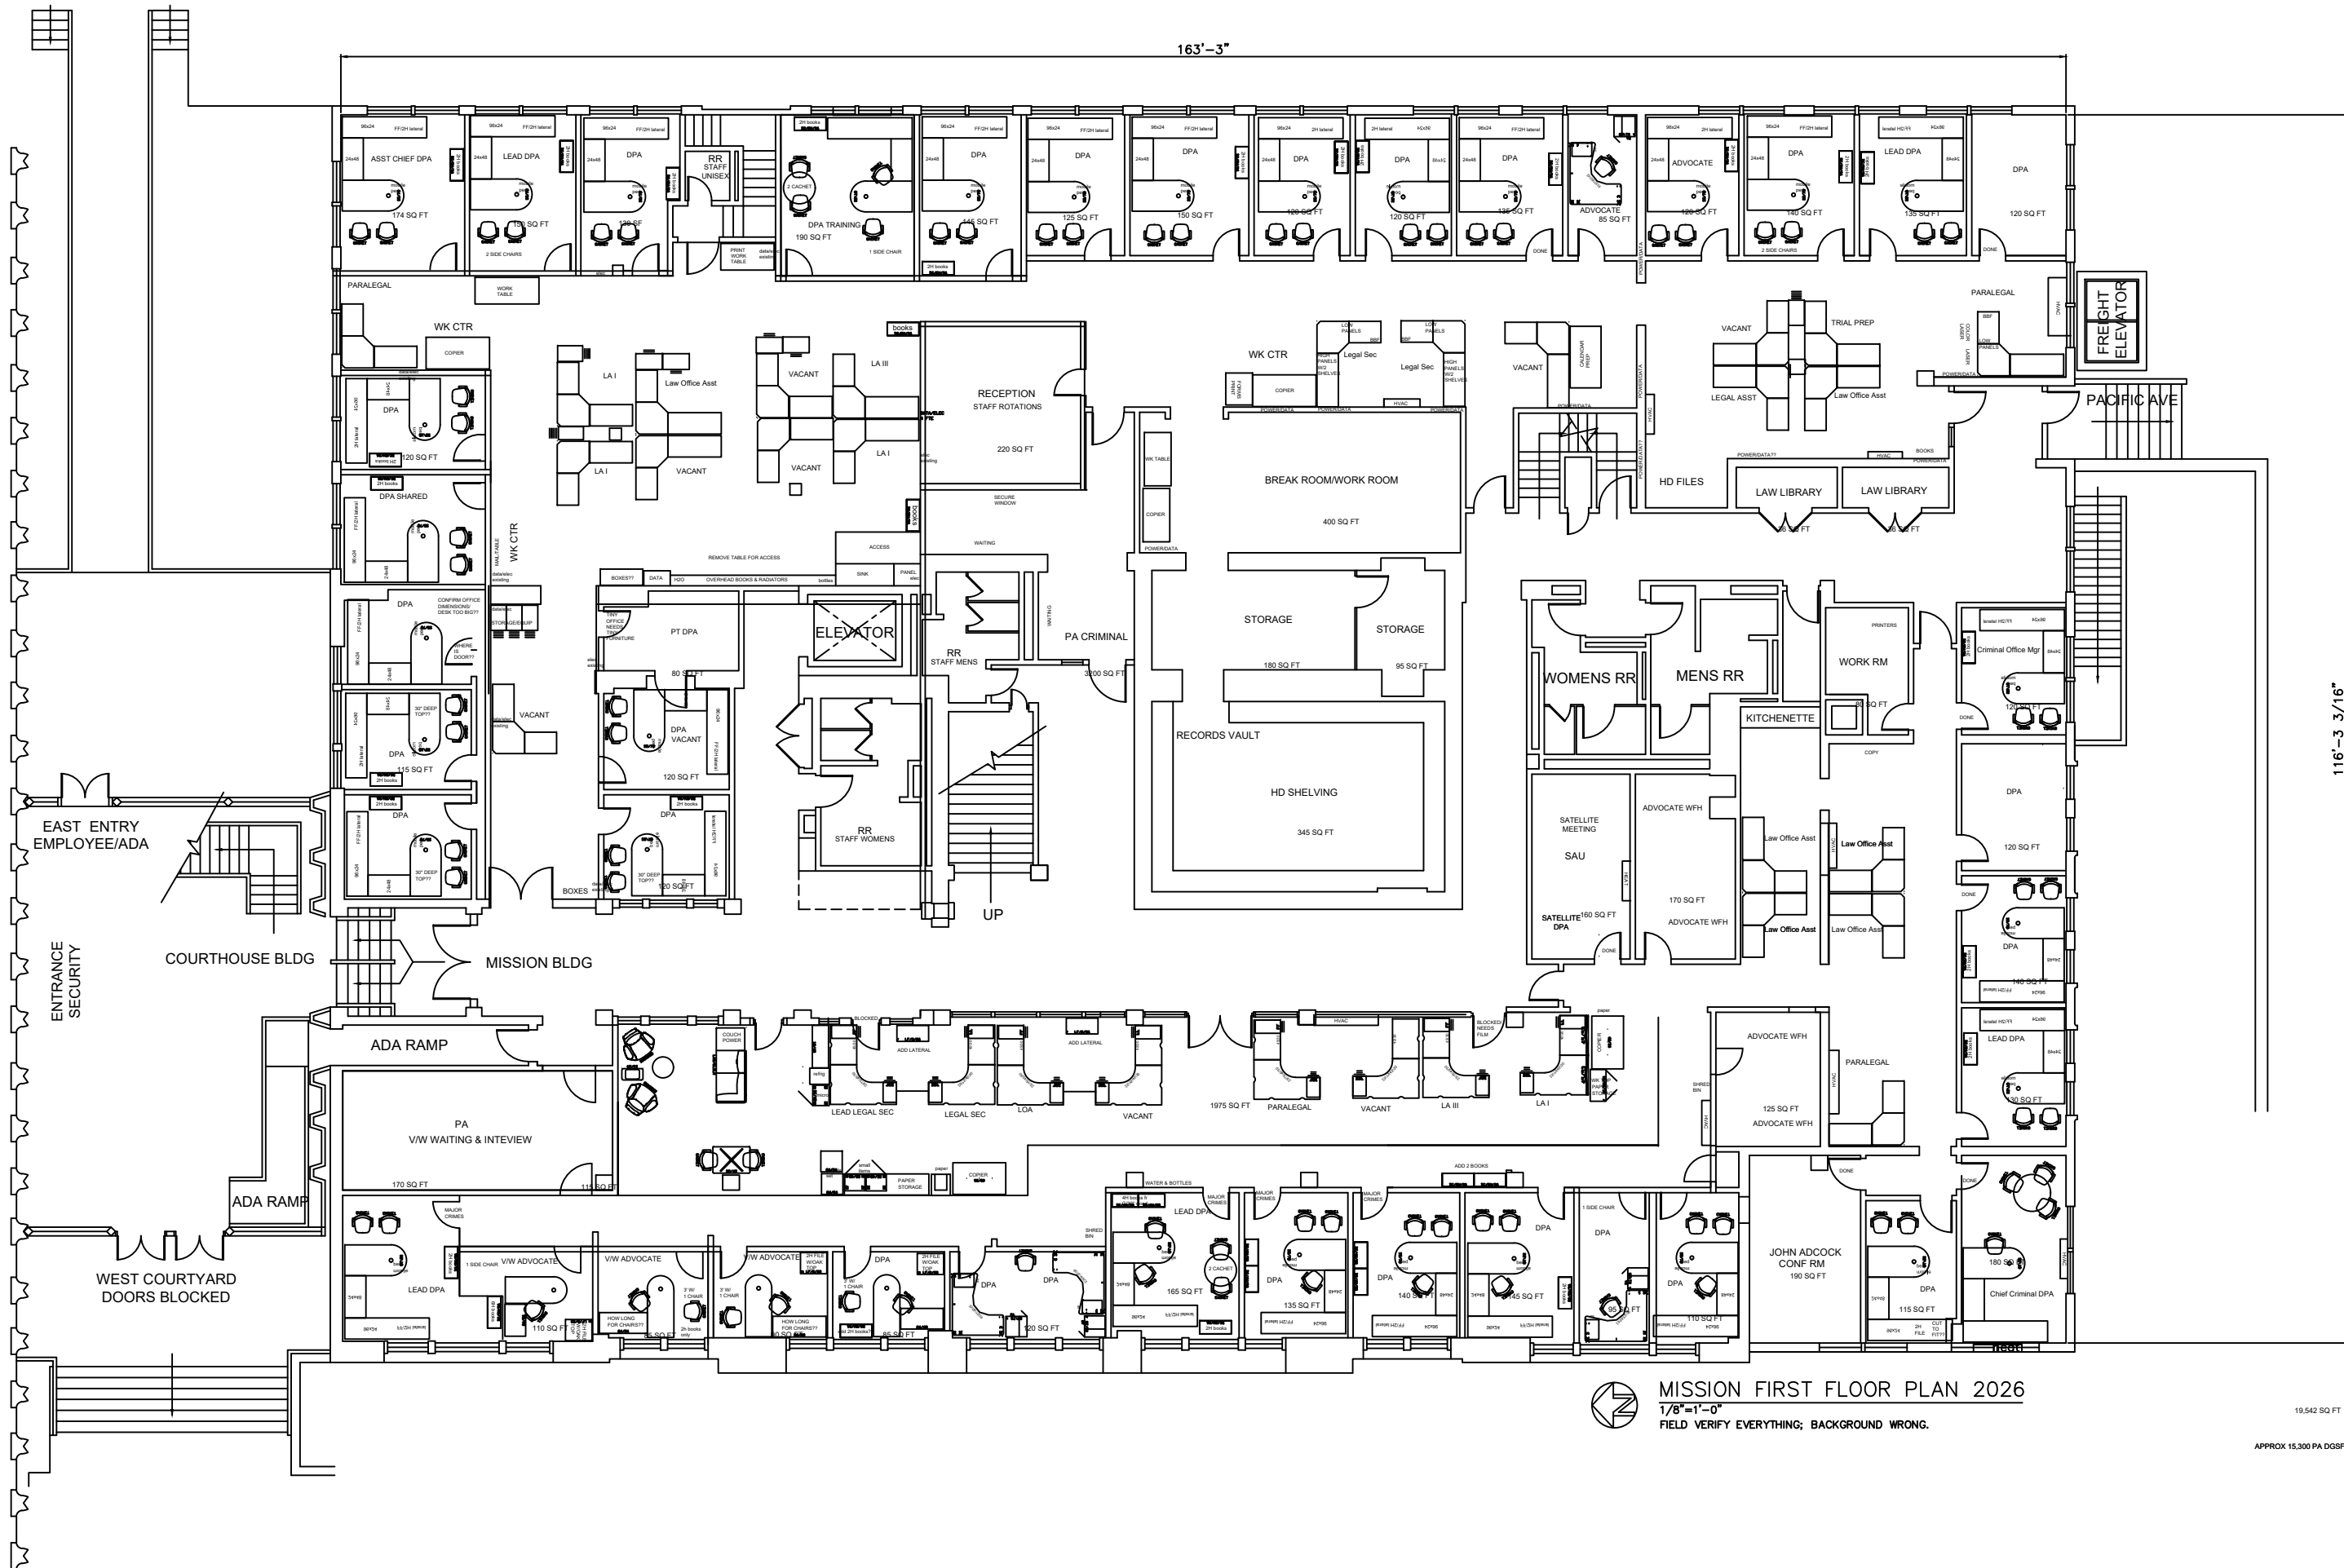


MISSION FIRST FLOOR PLAN 2026
1/8"=1'-0"
FIELD VERIFY EVERYTHING; BACKGROUND WRONG.

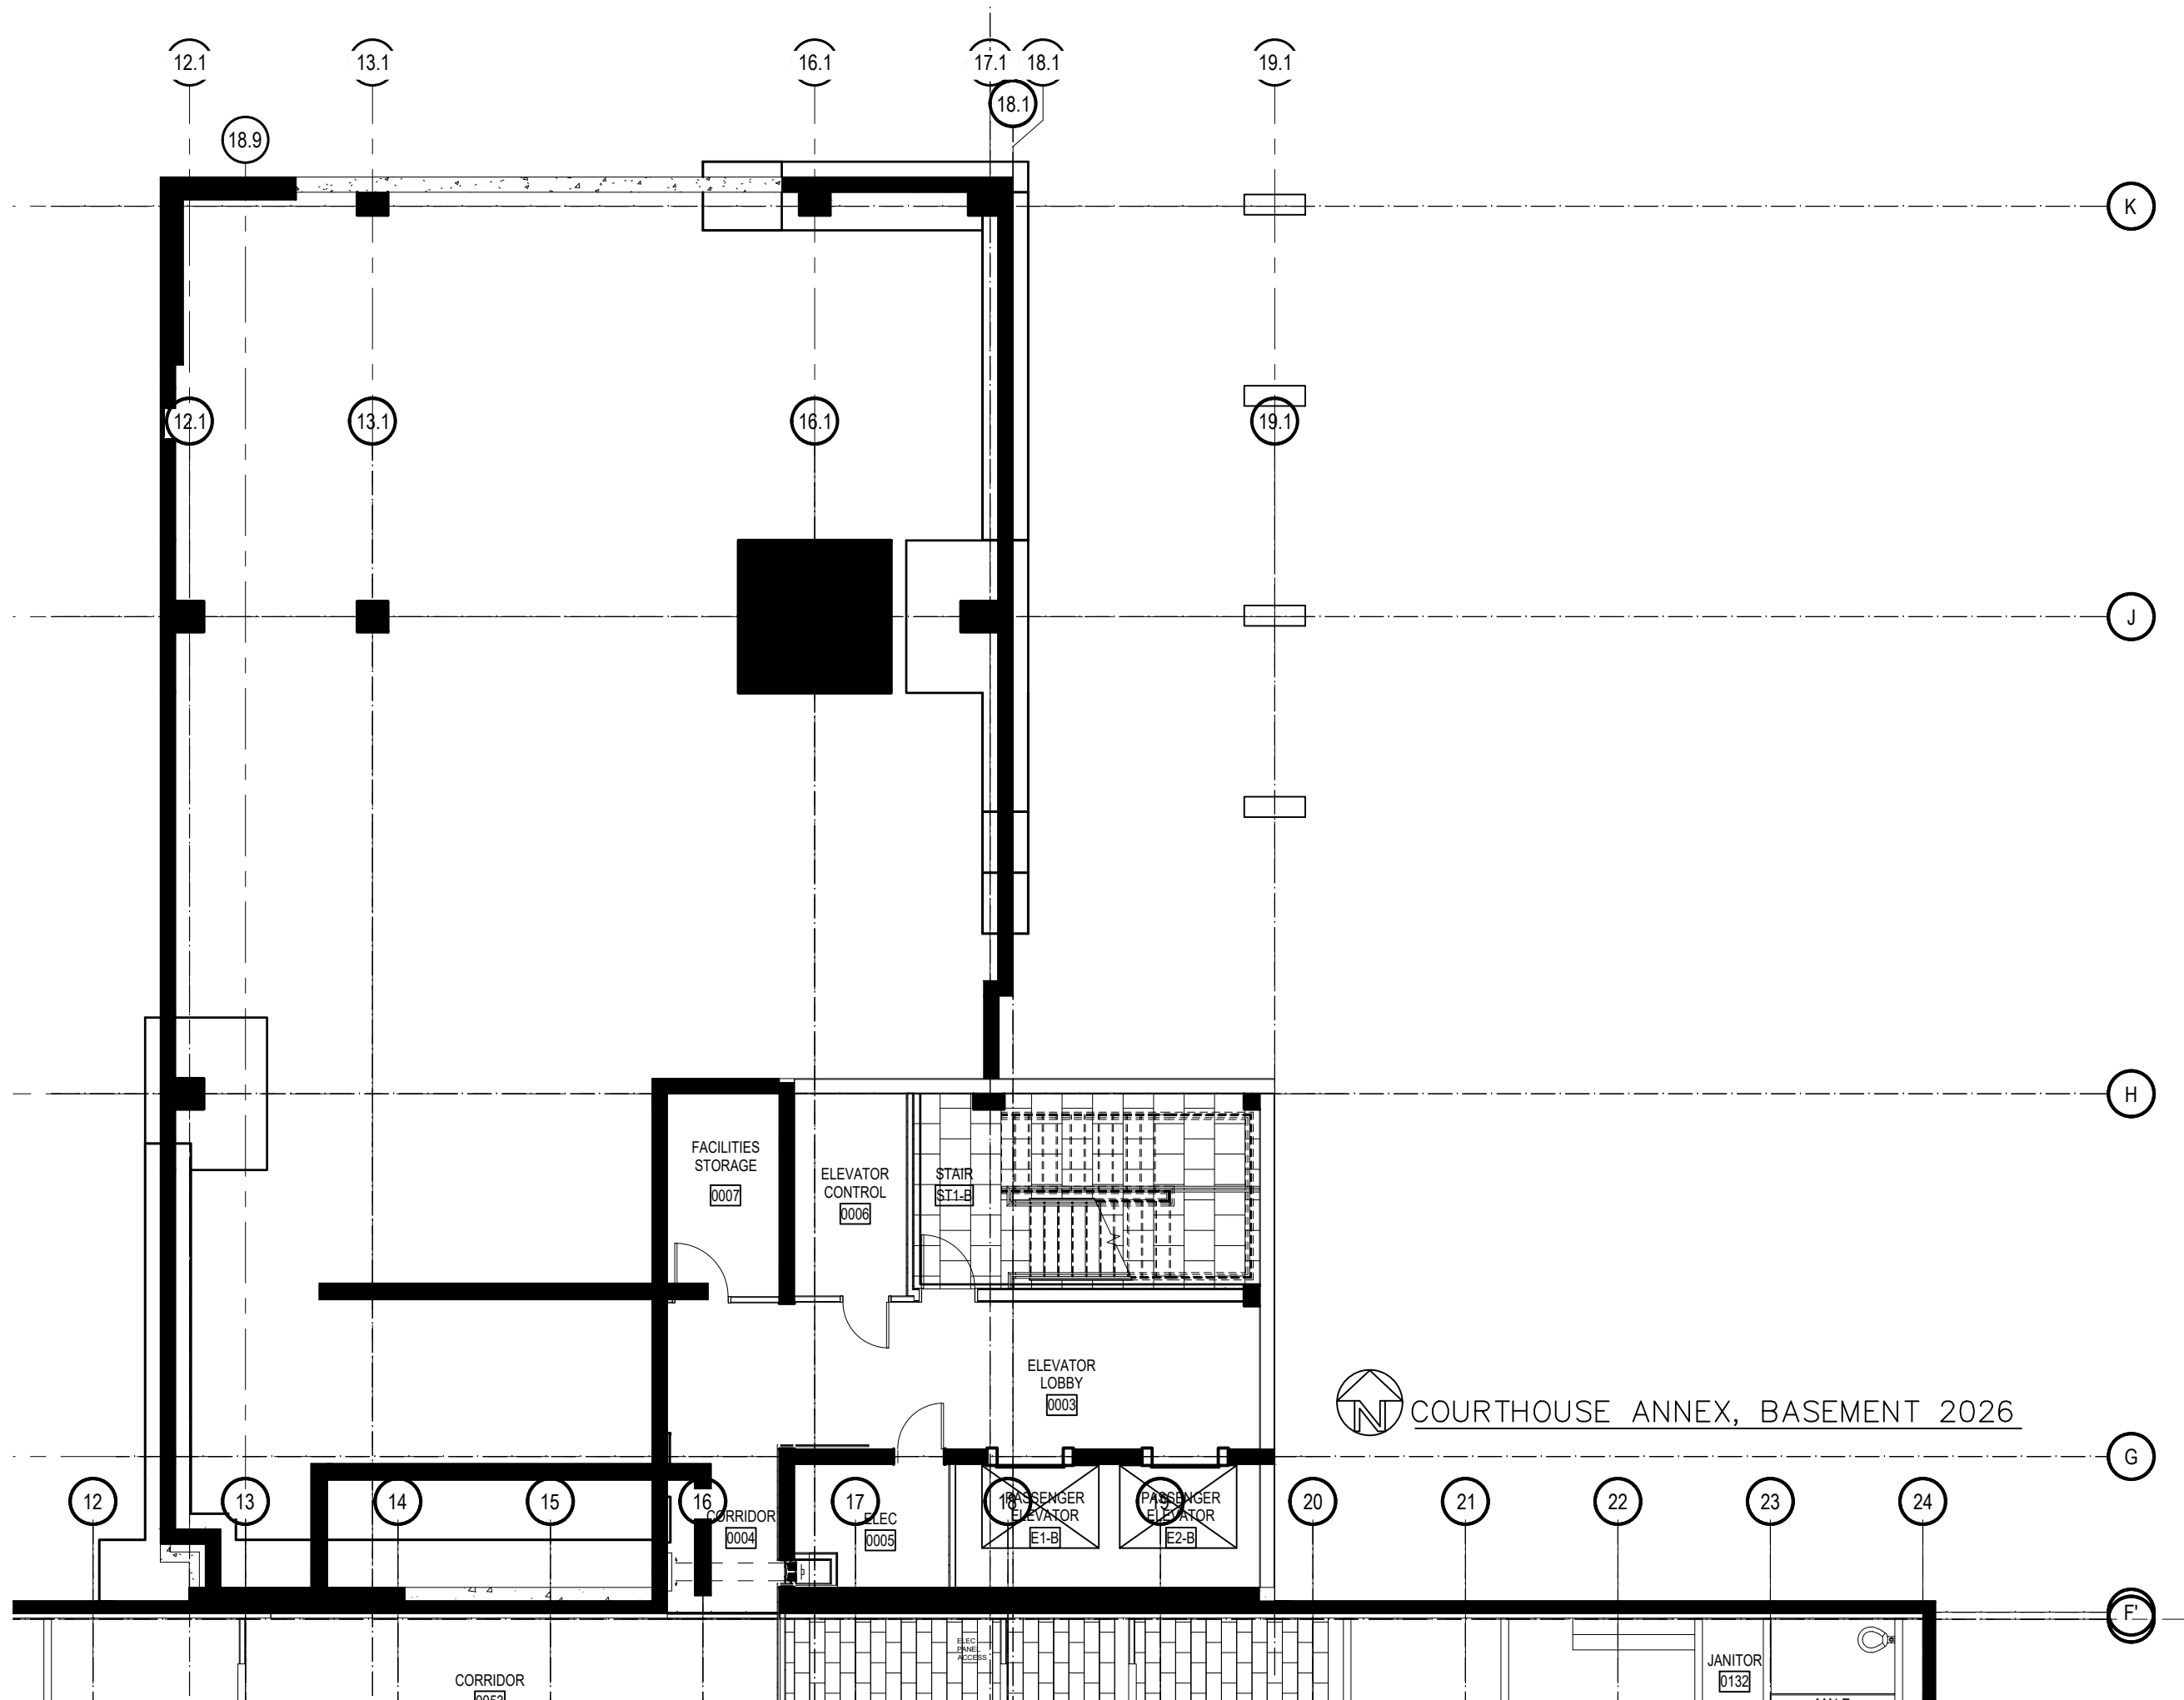


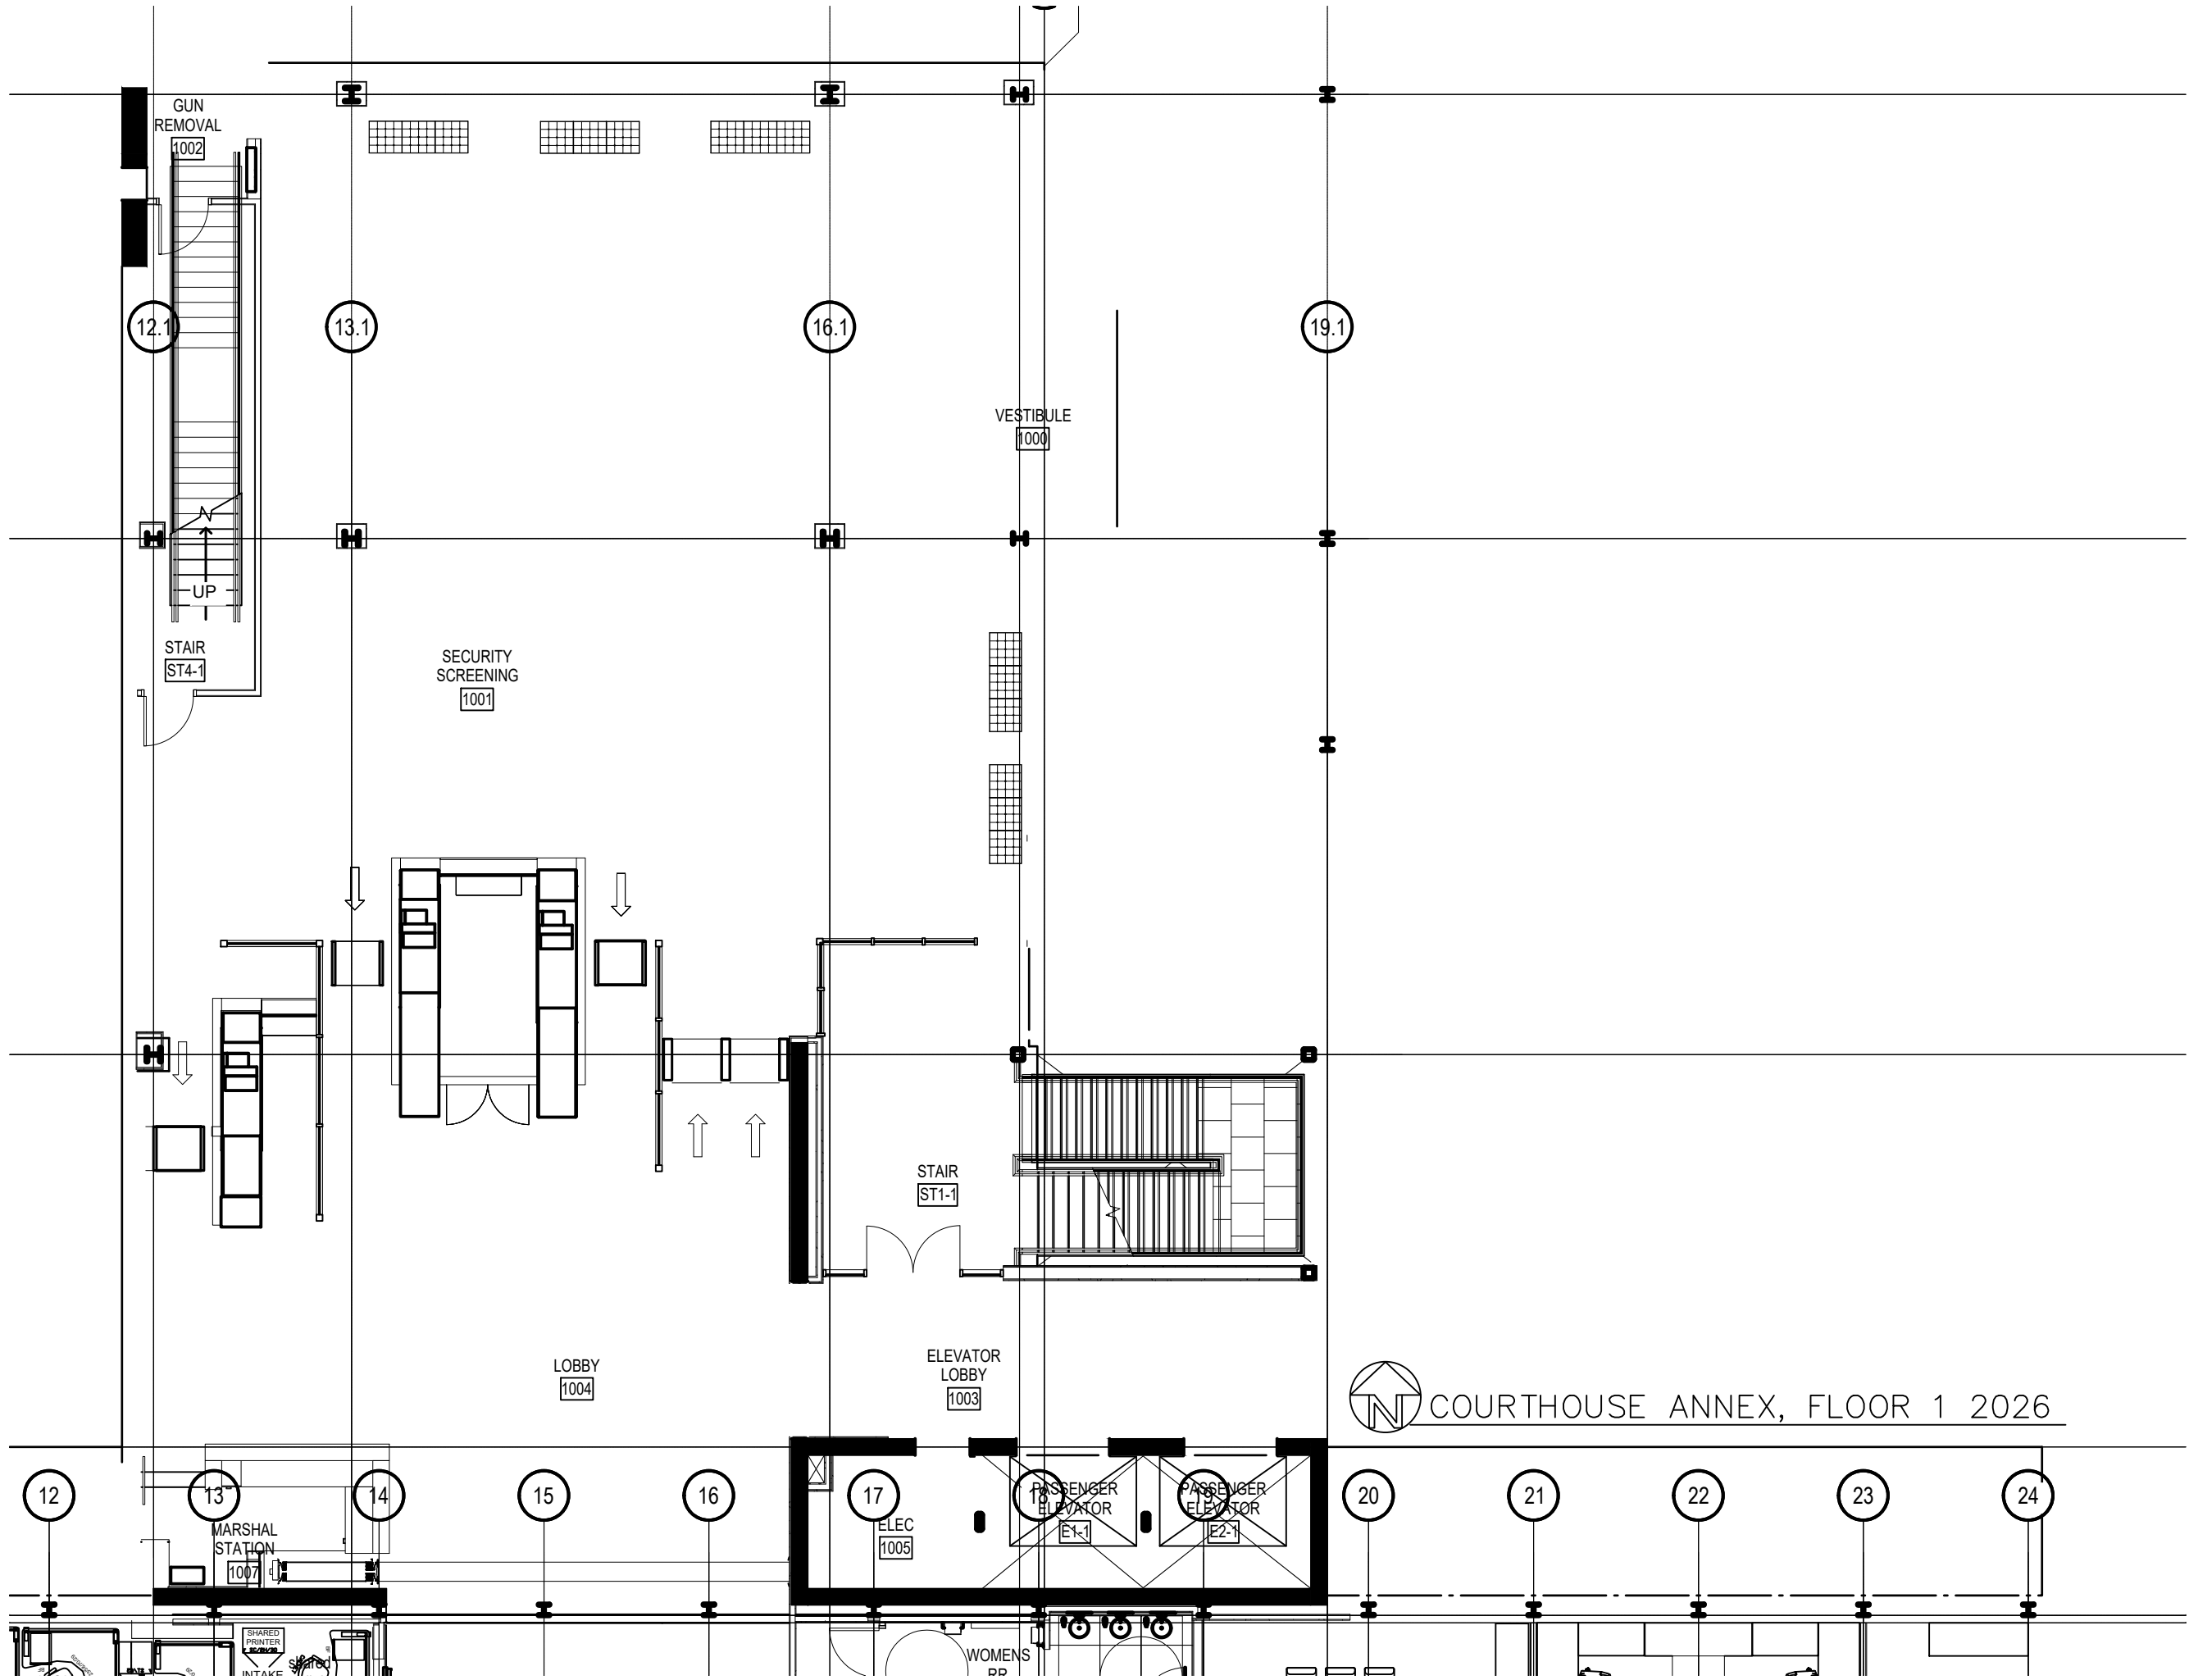


 COURTHOUSE ANNEX, FLOOR 1 2026

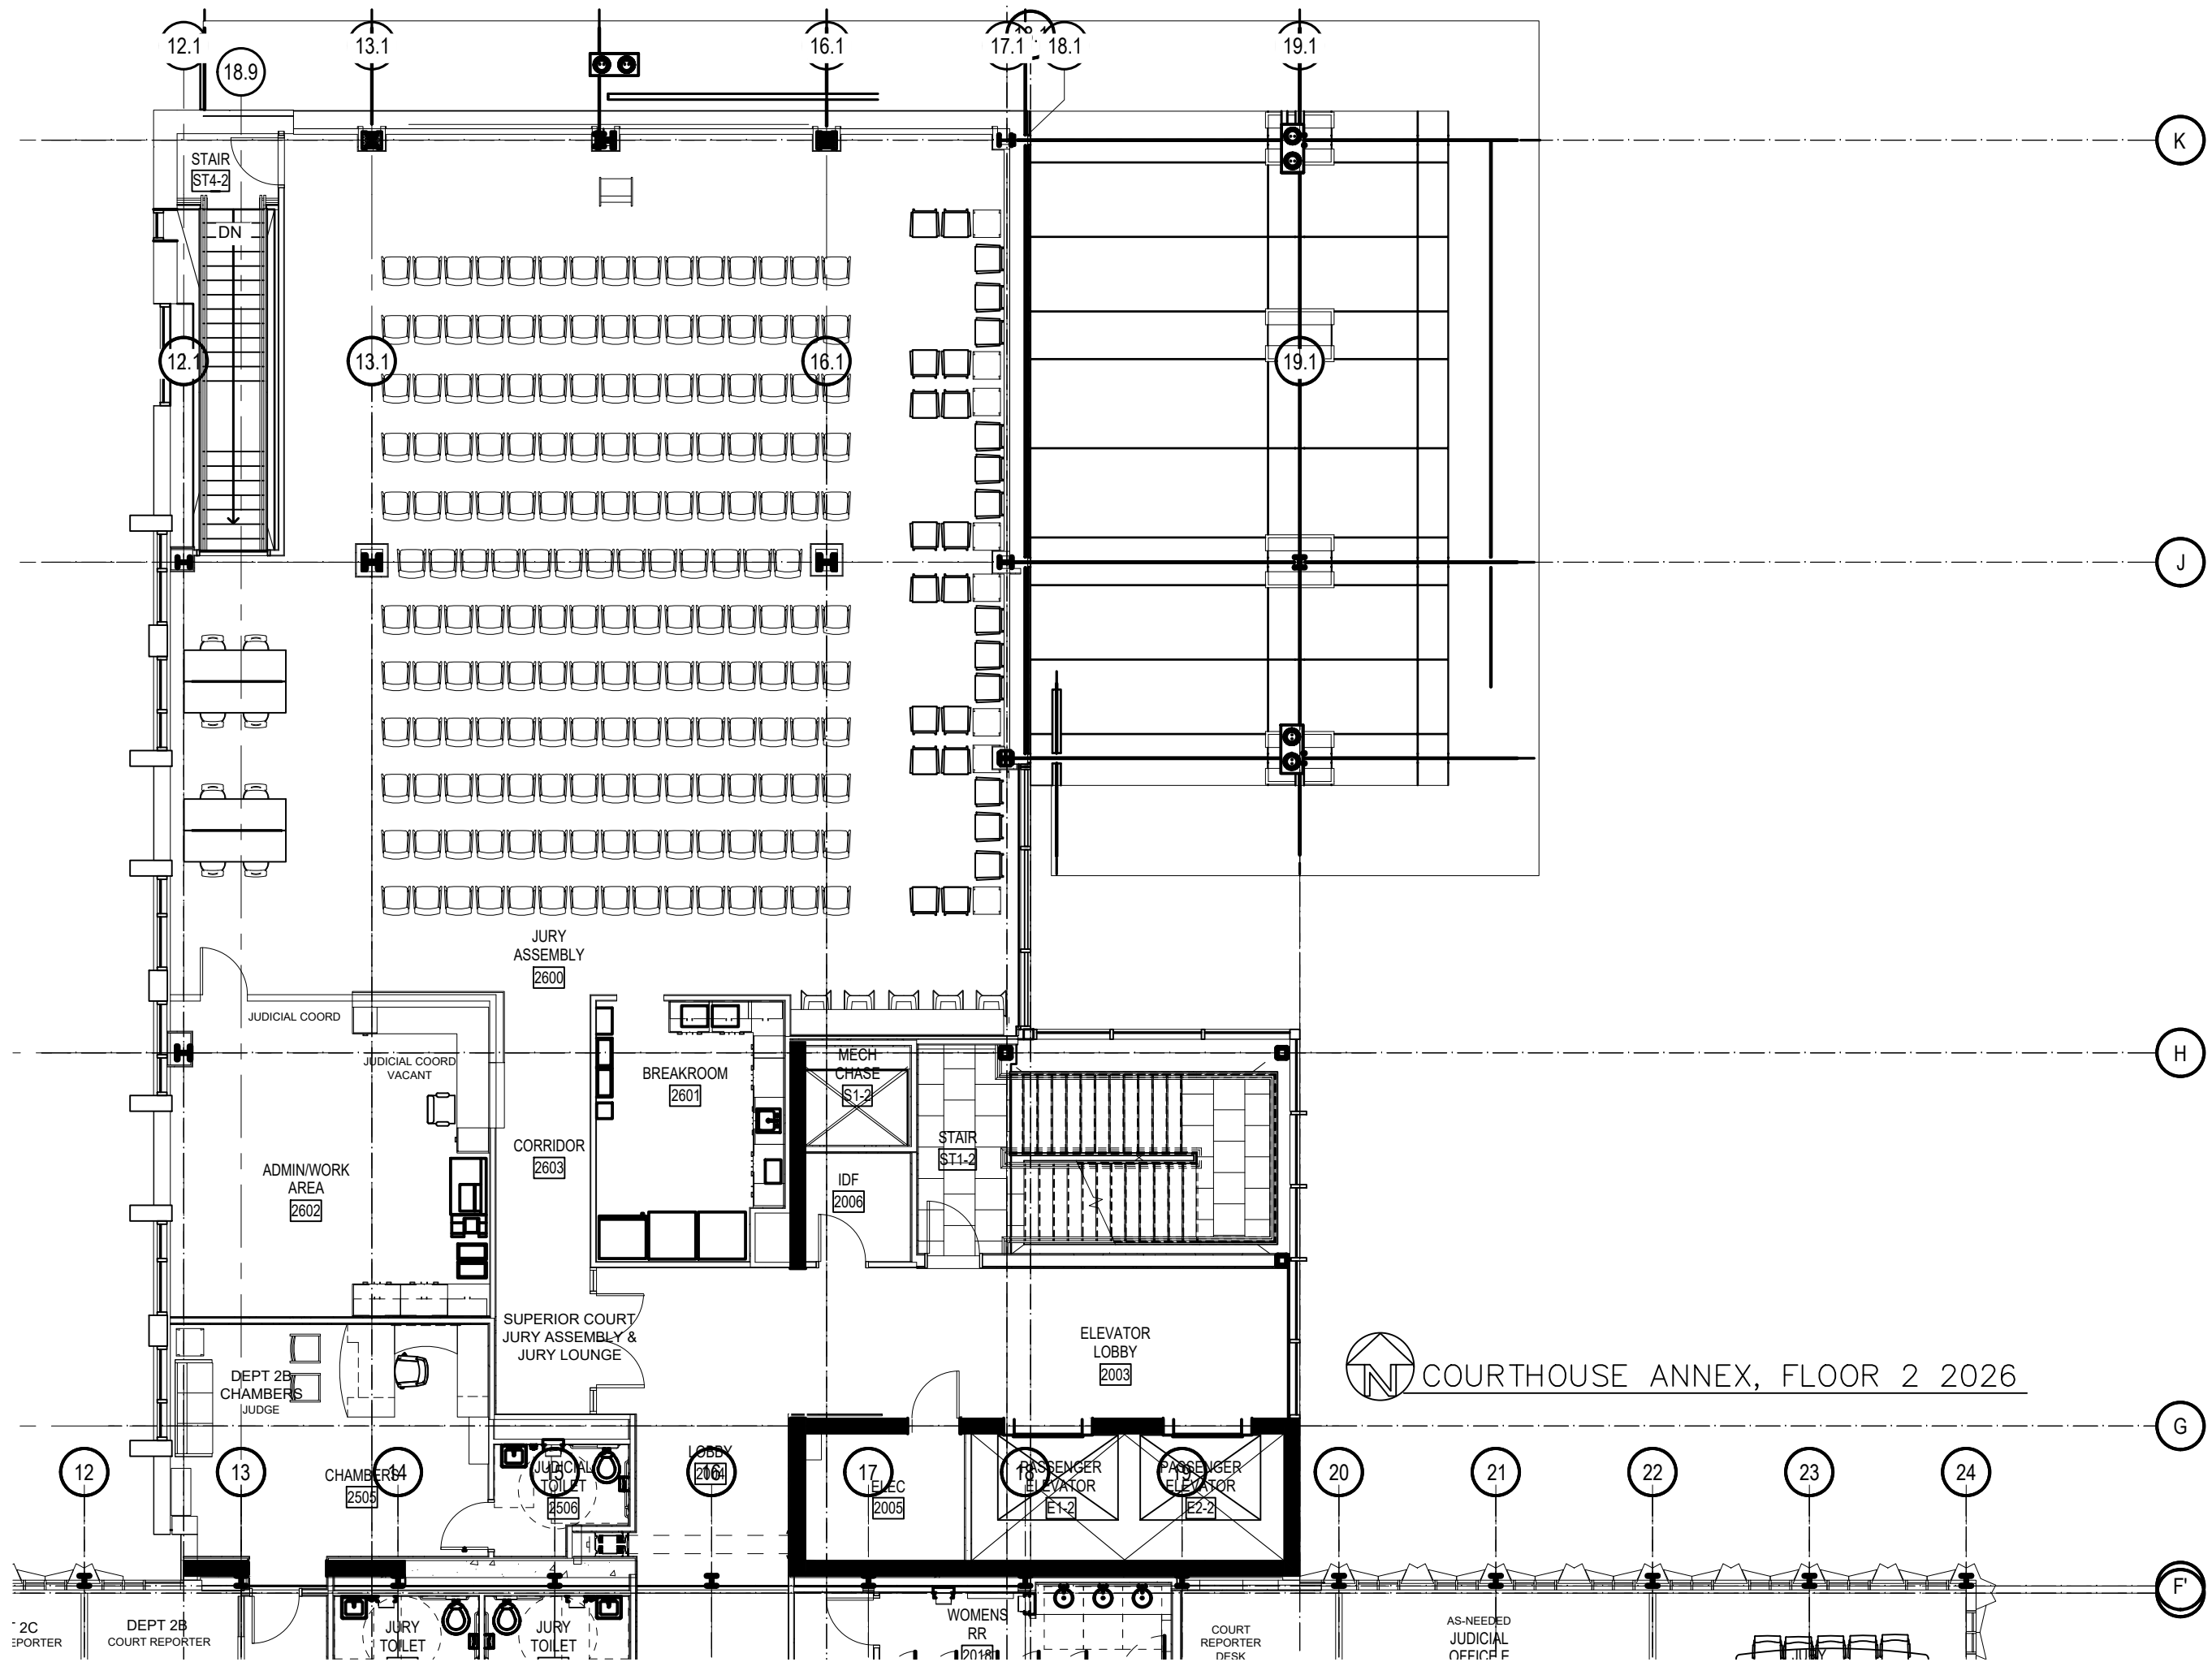





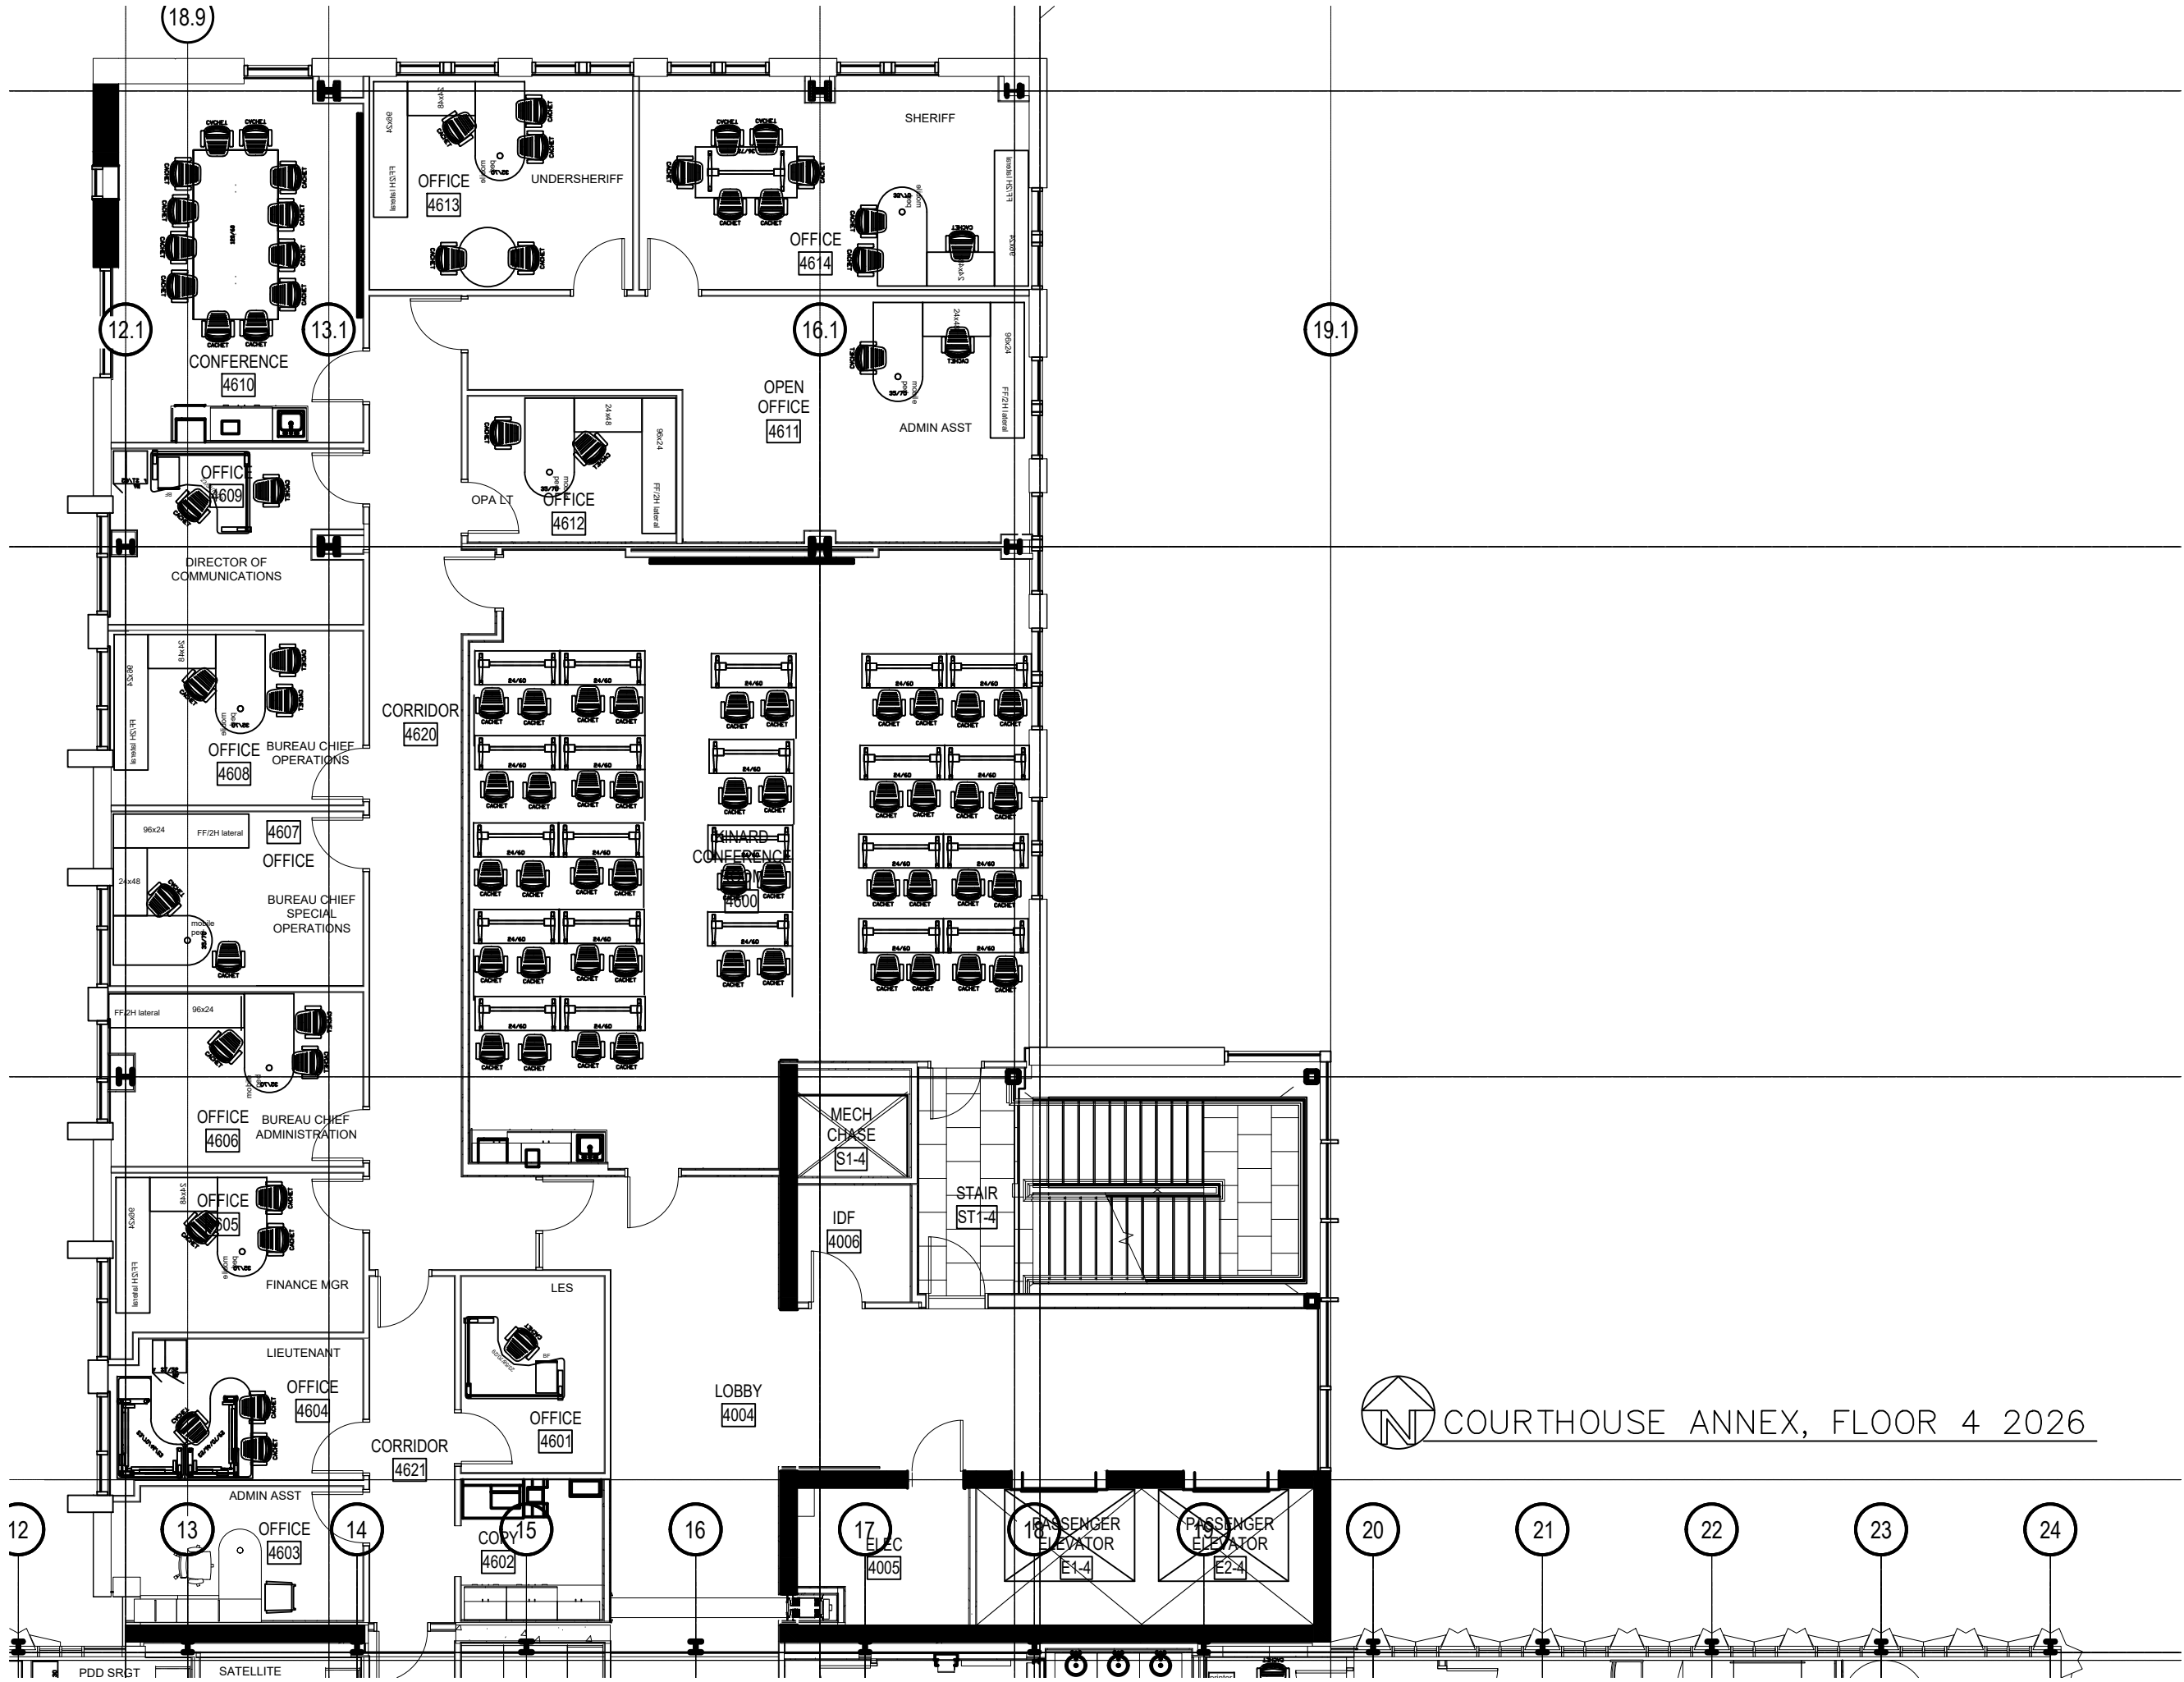



 COURTHOUSE ANNEX, FLOOR 4 2026

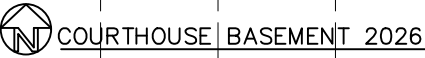


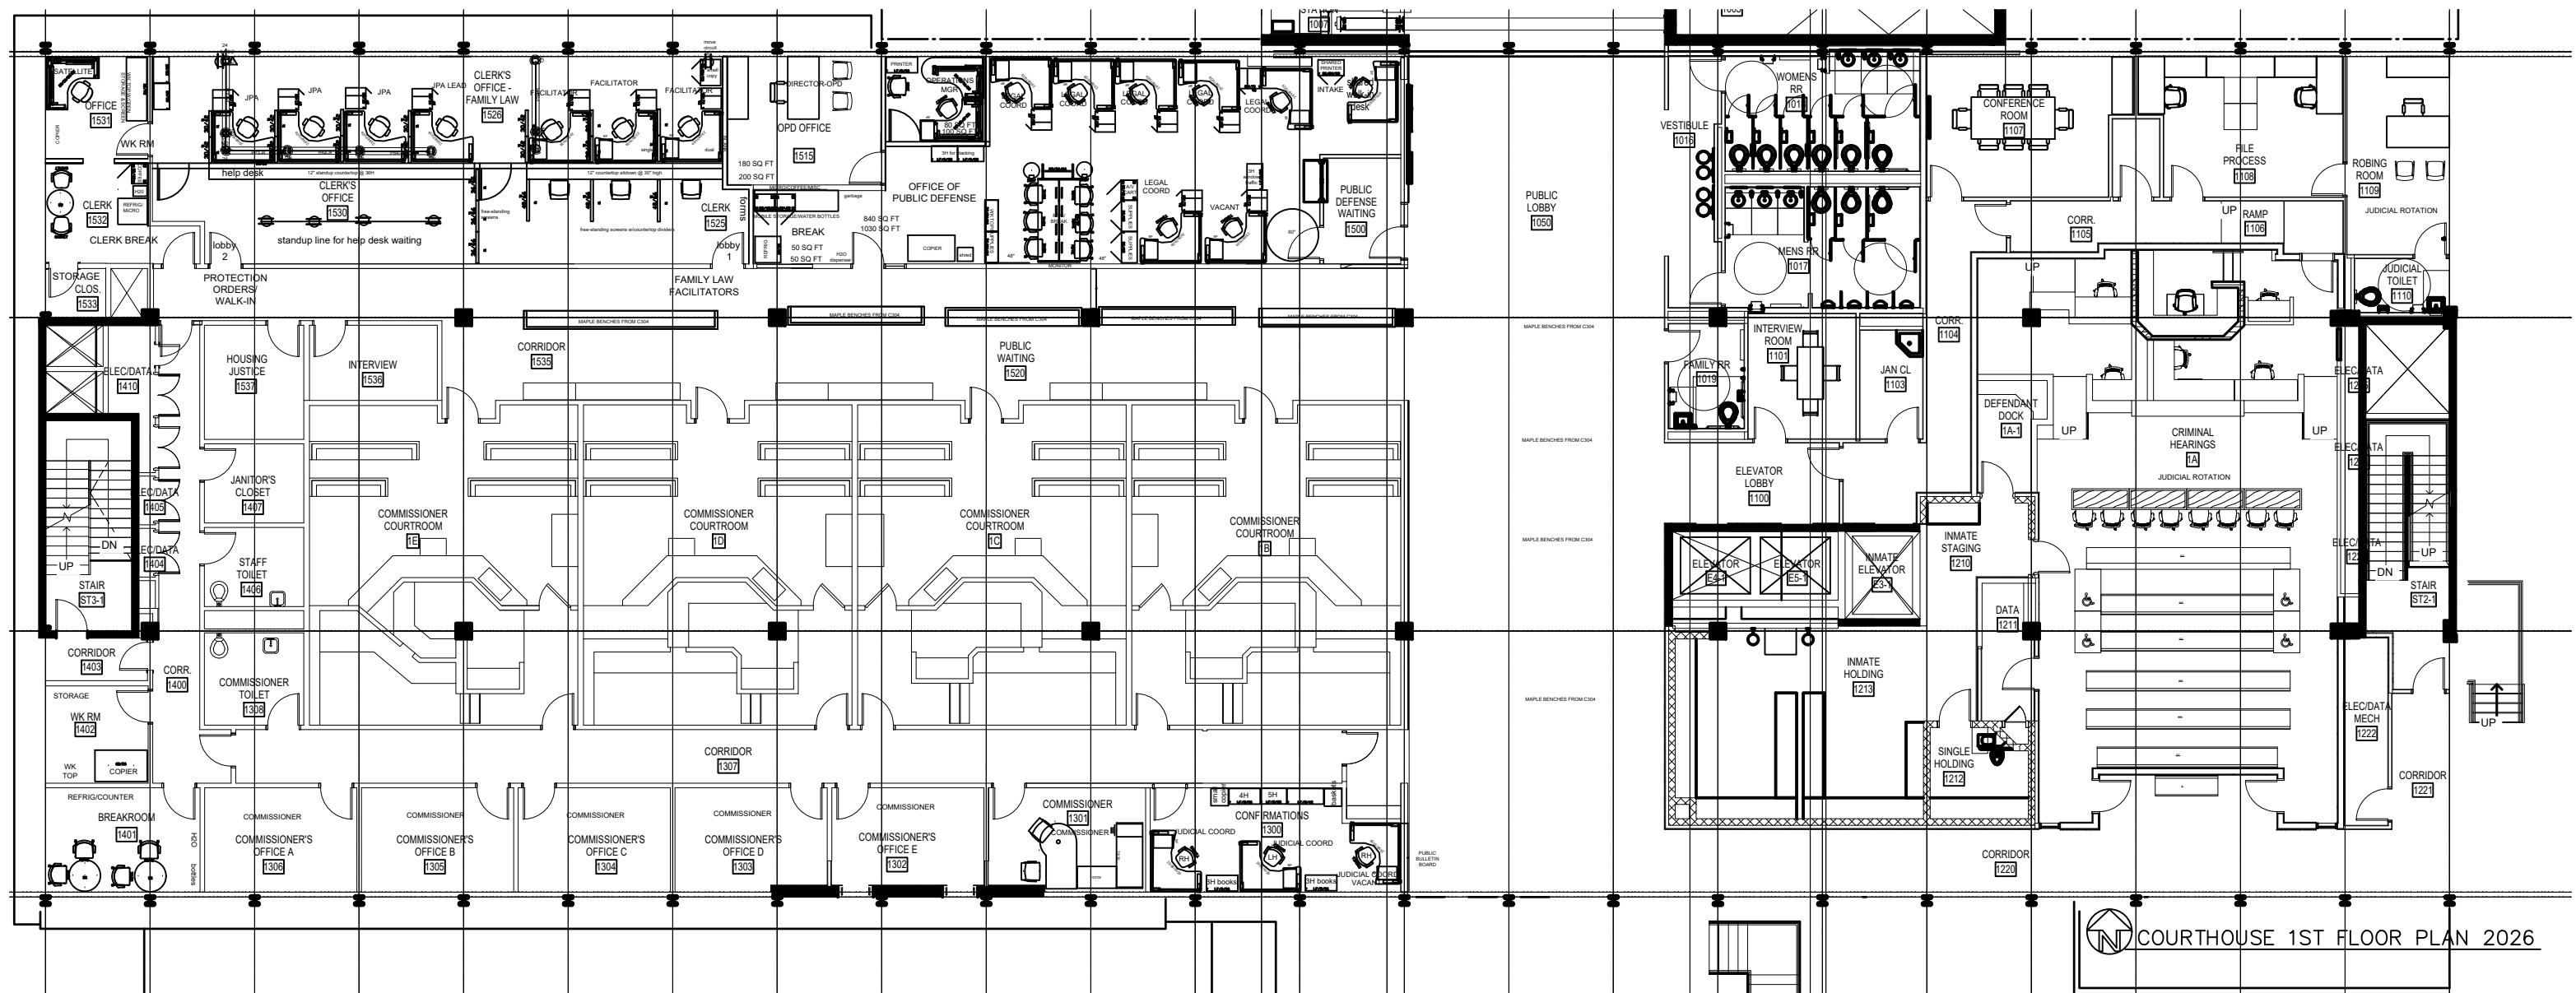

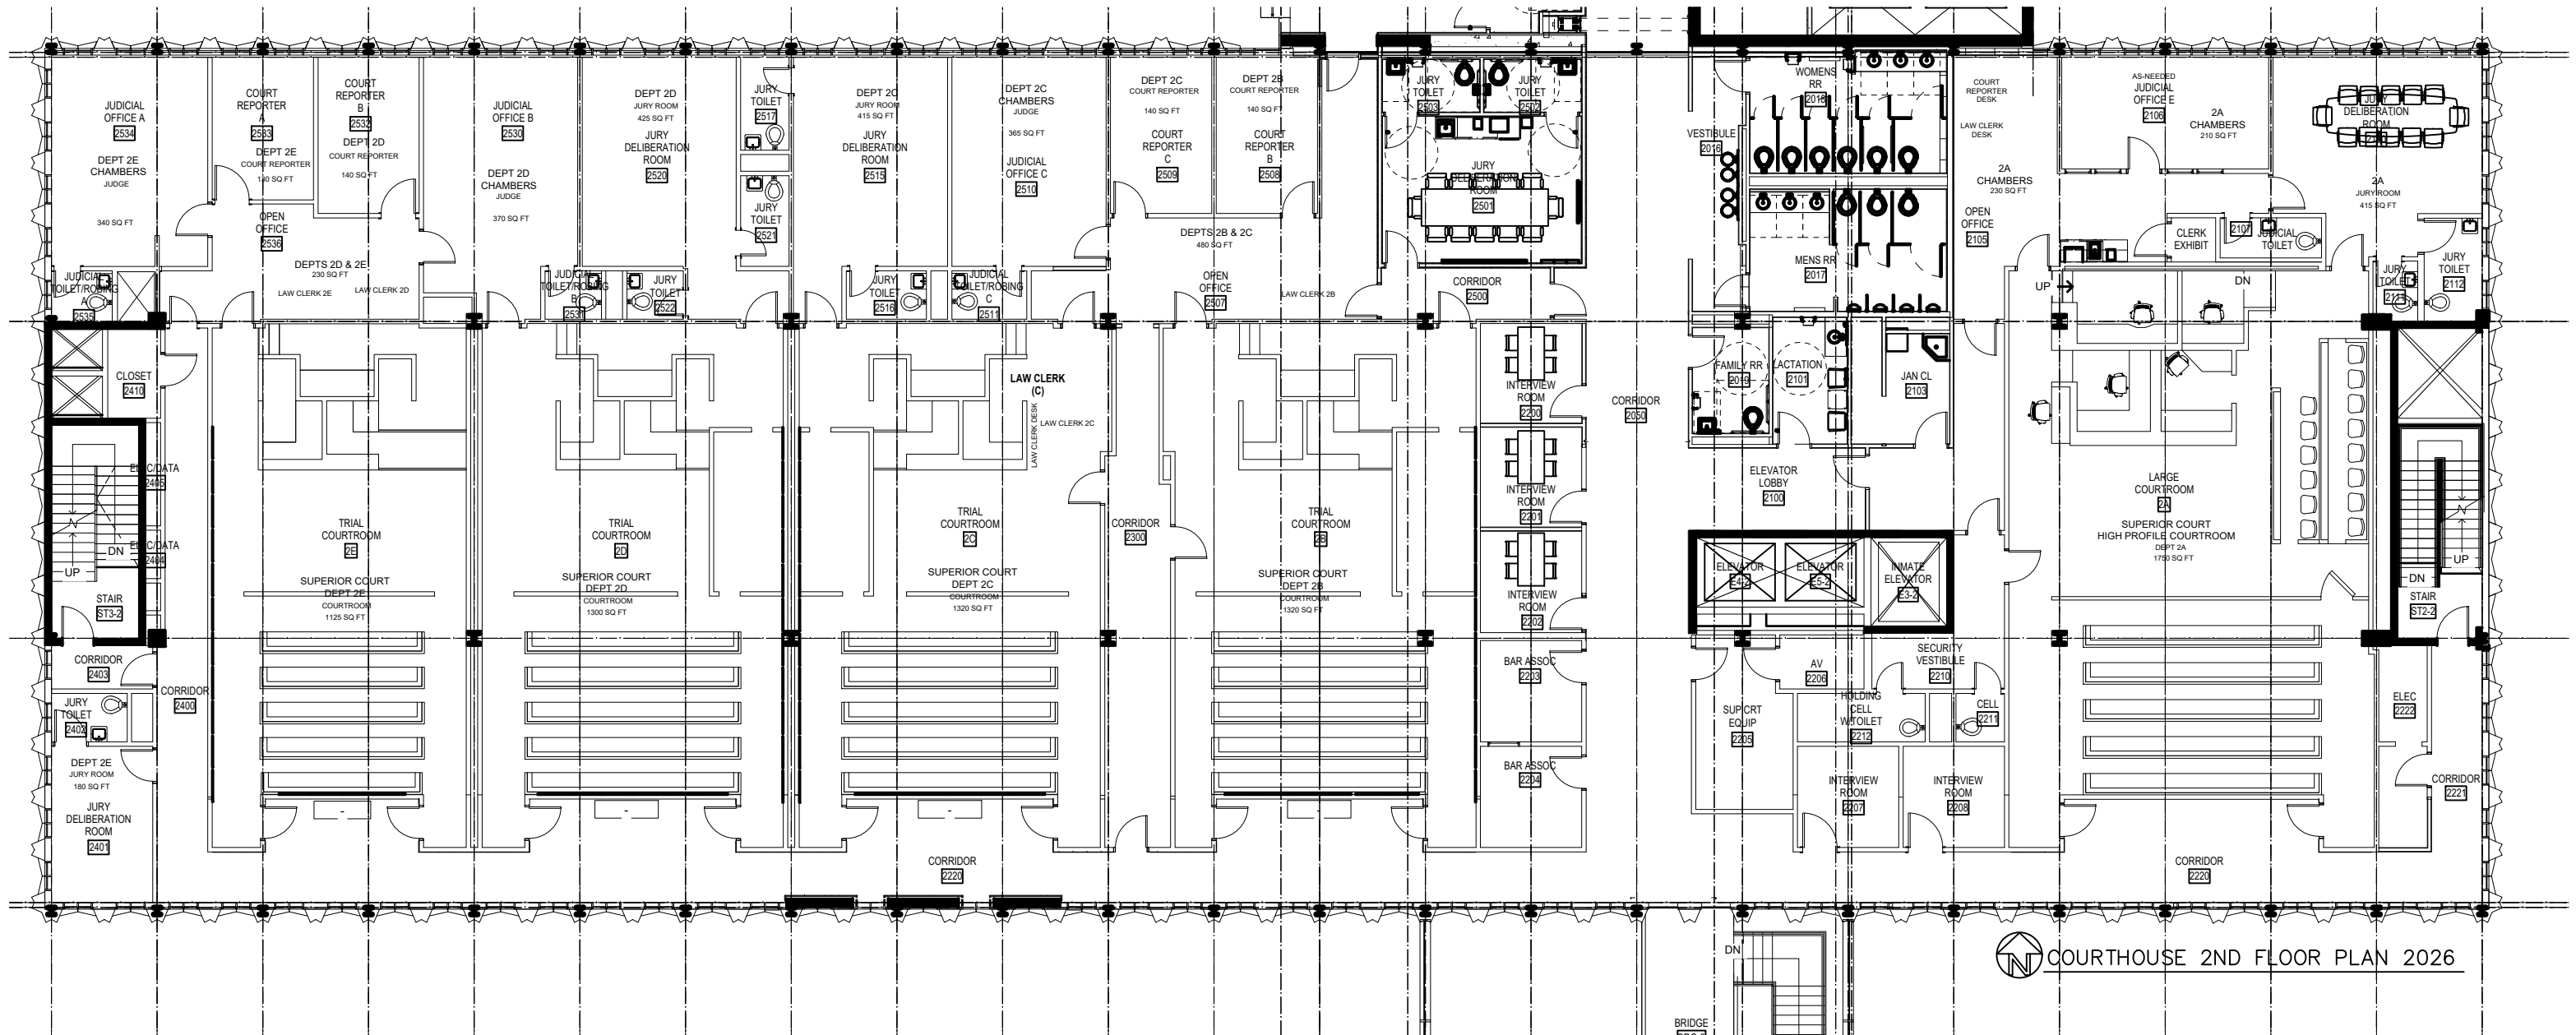

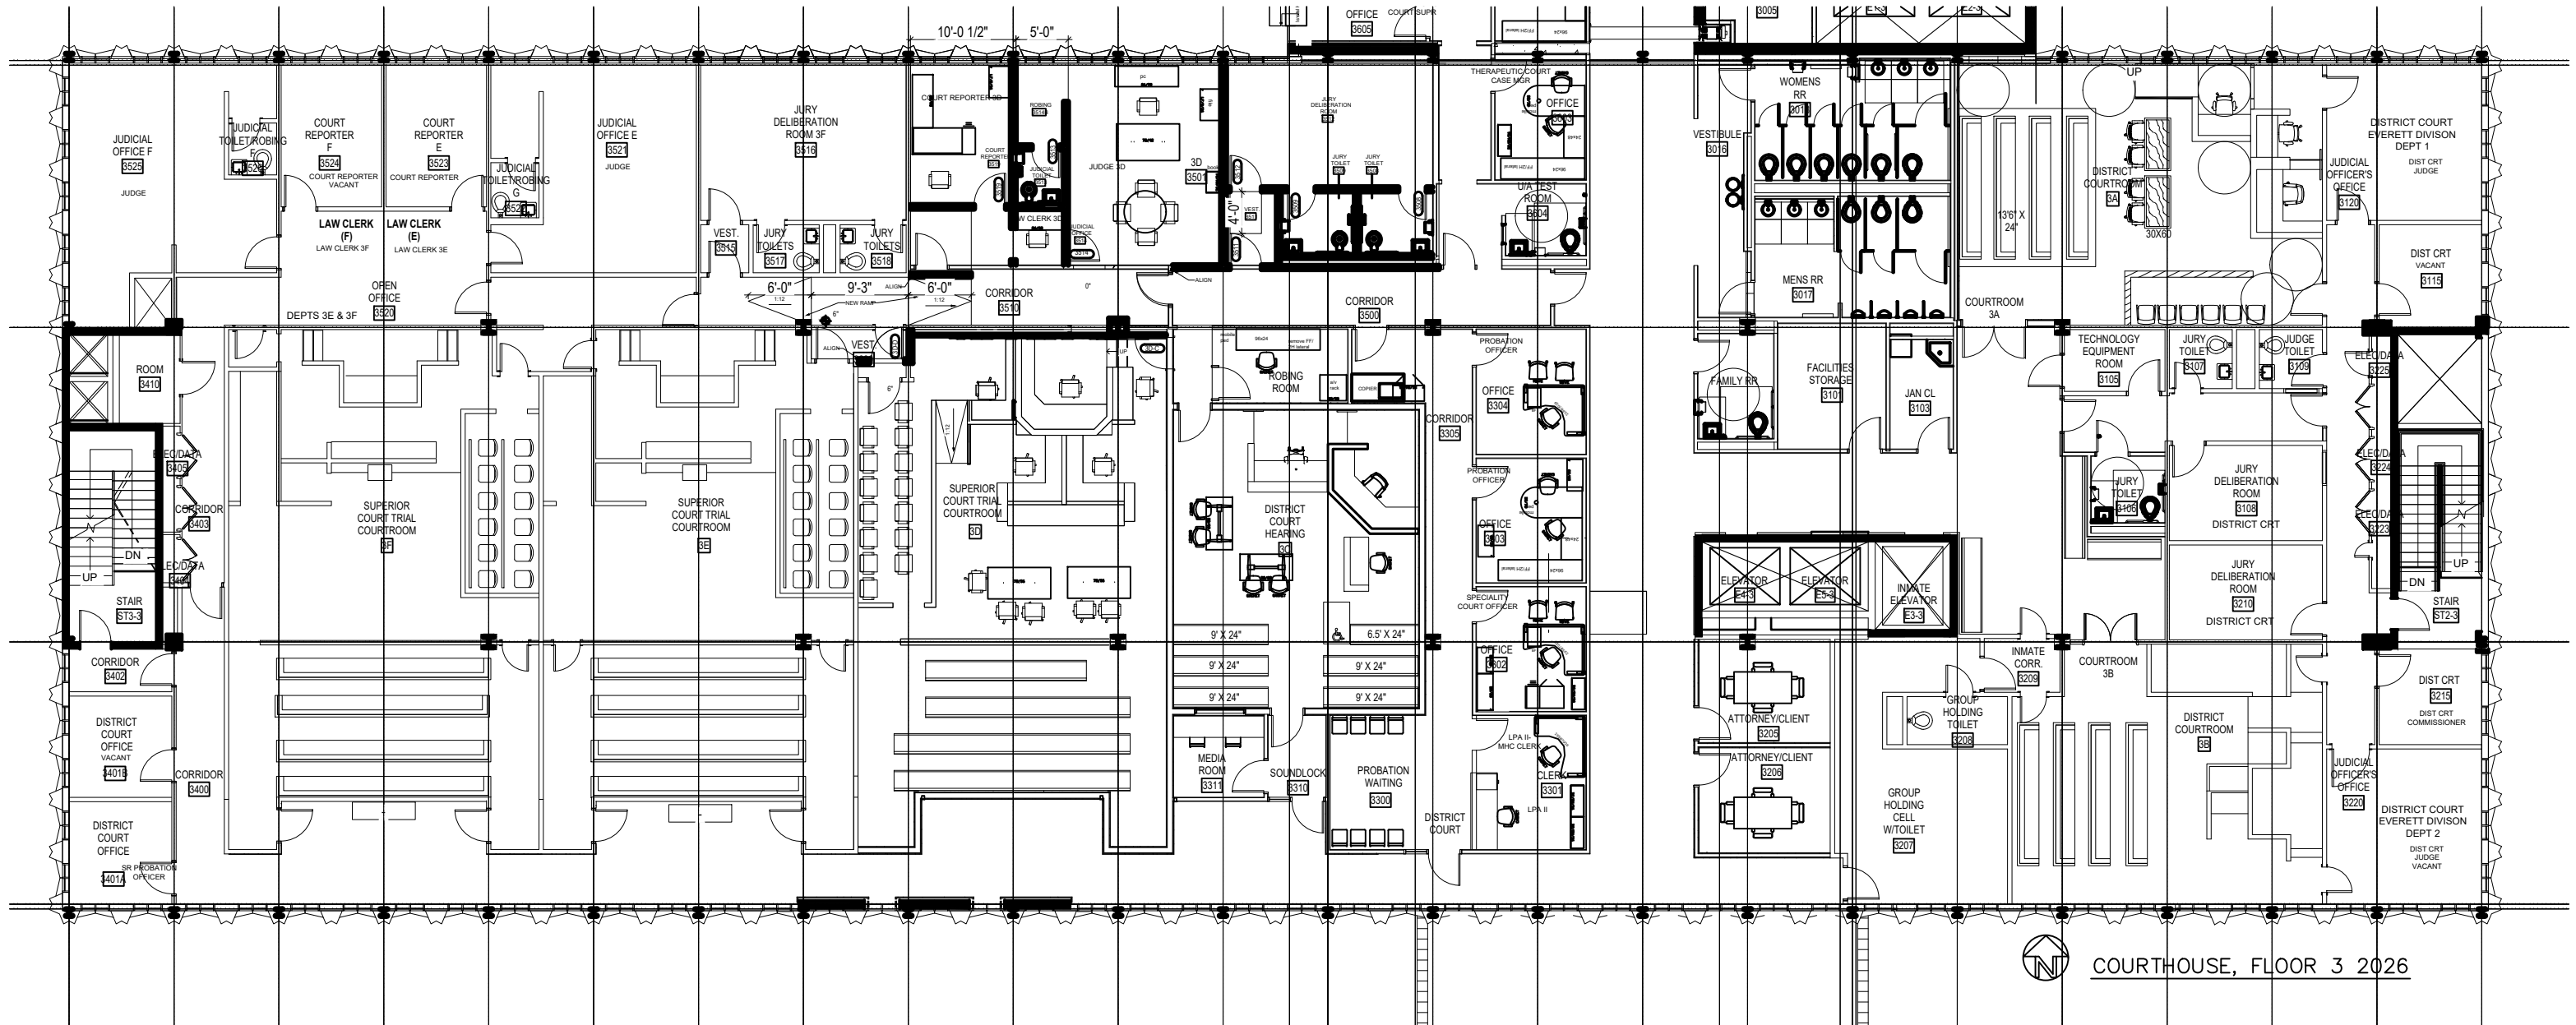

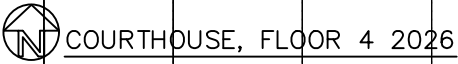

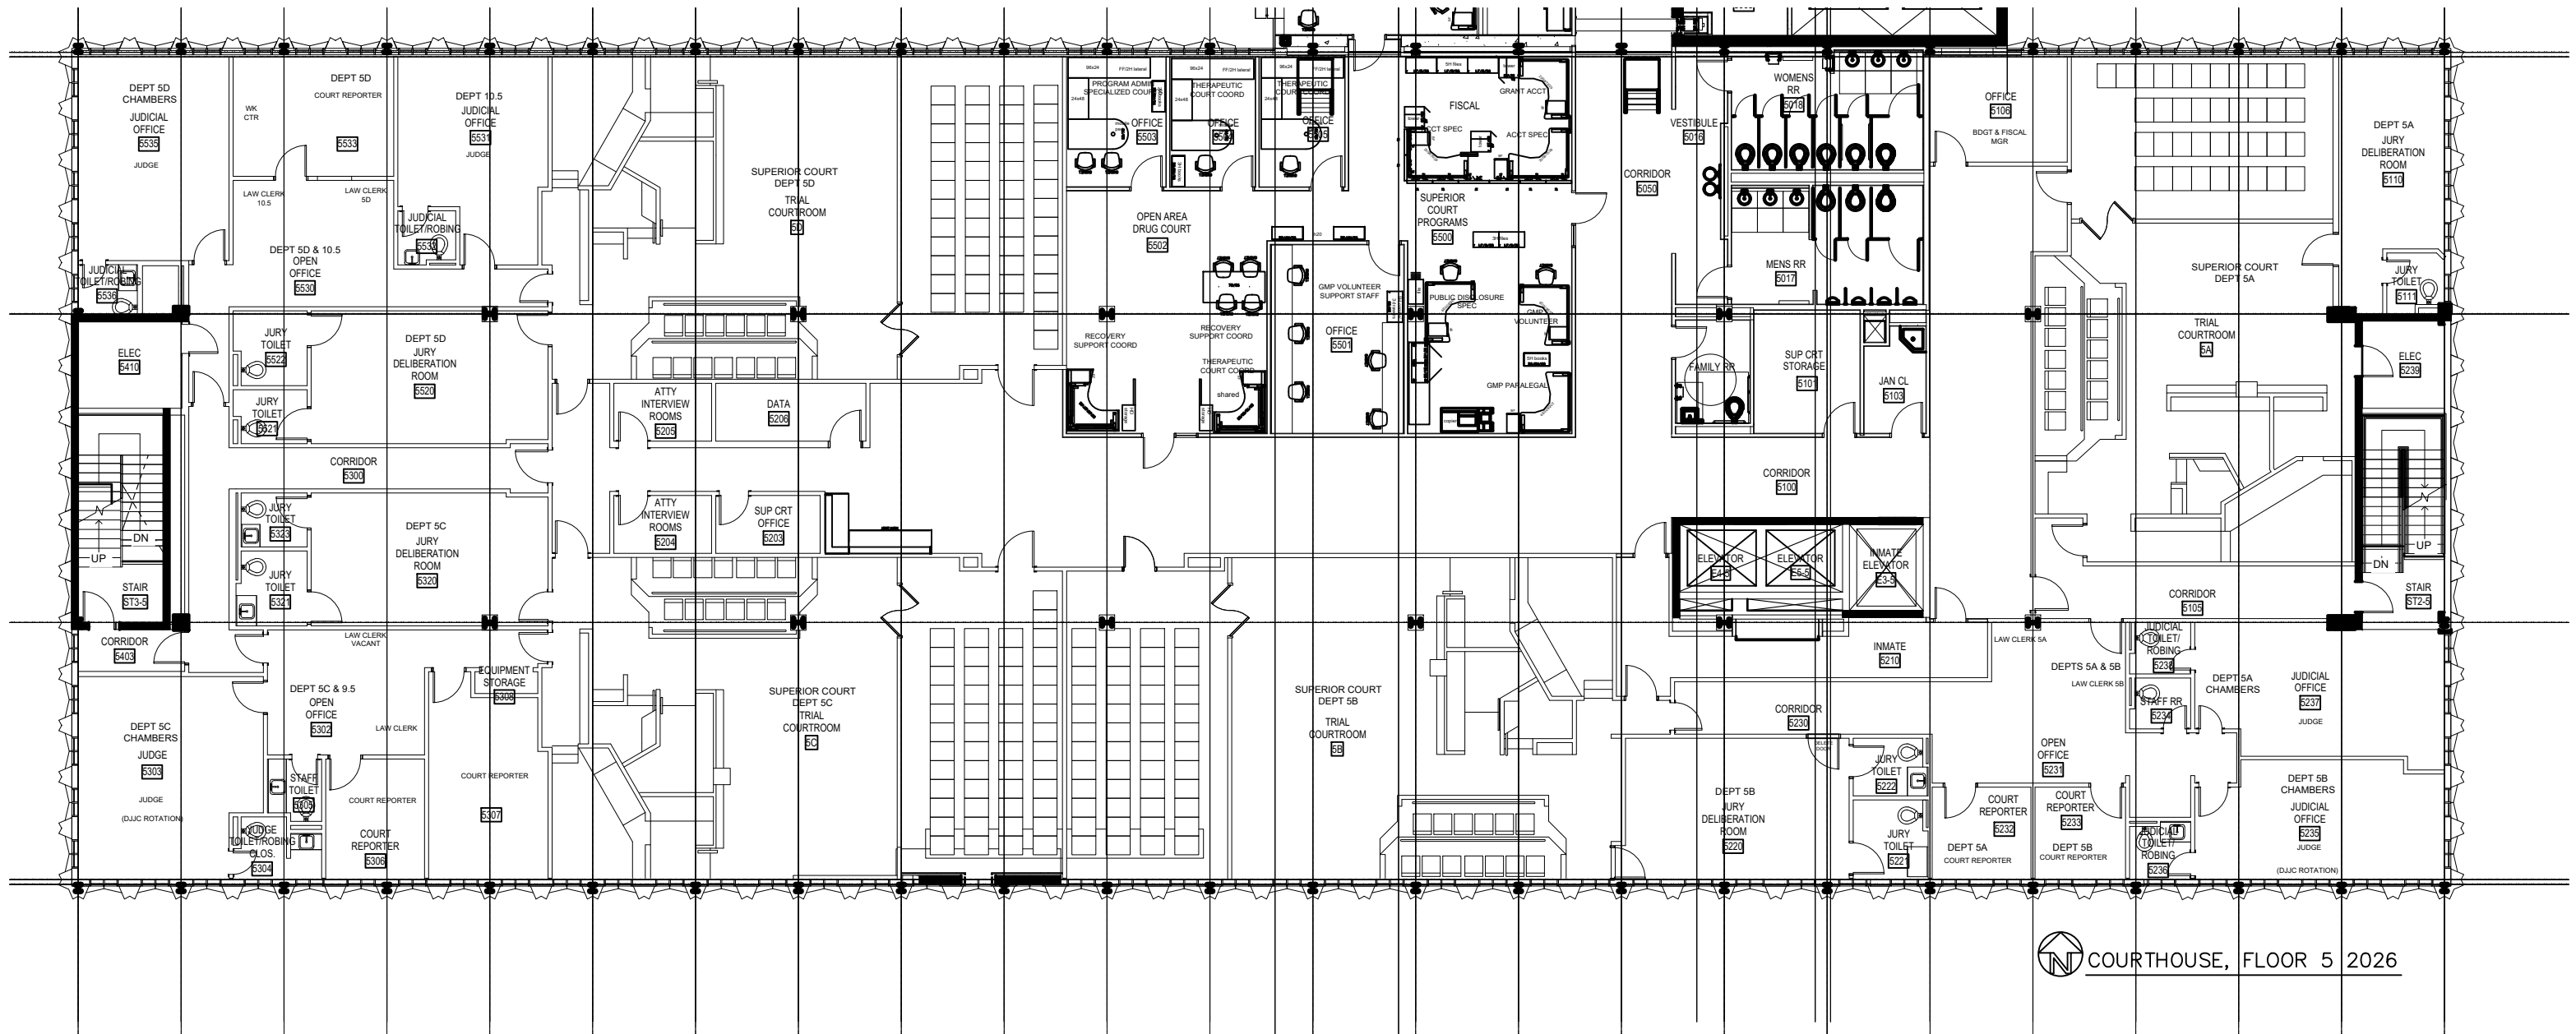


	A	D	E
1	Dept	Title	Remote or Assigned
2	PDS-ADMIN	OPERATIONAL IMPROVEMENT PROGRAM MANAGER	Assigned Office
3	PDS-ADMIN	DIVISION MANAGER	Assigned Office
4	PDS-ADMIN	ADMINISTRATIVE ASSISTANT-PDS	Assigned Cubicle
5	PDS-ADMIN	PLANNING AND DEVELOPMENT SERVICES DIRECTOR	Assigned Office
6	PDS-ADMIN	ACCOUNTANT II	Remote/Assigned Cubicle
7	PDS-PERMIT	ACCOUNTING SPECIALIST	Assigned Cubicle
8	PDS-ADMIN	ADMINISTRATIVE ASSISTANT-PDS DIVISION MANAGER	Assigned Cubicle
9	PDS-ADMIN	FISCAL RESOURCES ANALYST	Remote/Assigned Cubicle
10	PDS-FIRE-INVEST	FIRE INVESTIGATOR	Assigned Desk in FMO
11	PDS-FIRE-INVEST	FIRE INVESTIGATOR	Assigned Desk in FMO
12	PDS-FIRE-INVEST	FIRE INVESTIGATOR	Assigned Desk in FMO
13	PDS-LG-RG-PLNG	GIS ANALYST, SENIOR	Remote/Shared Cubicle
14	PDS-LG-RG-PLNG	PLANNER PRINCIPAL-PDS	Remote/Shared Cubicle
15	PDS-LG-RG-PLNG	COMMUNICATION SPECIALIST II	Remote/Shared Cubicle
16	PDS-LG-RG-PLNG	ADMINISTRATIVE ASSISTANT-PDS DIVISION MANAGER	Remote/Assigned Cubicle
17	PDS-LG-RG-PLNG	PLANNER SENIOR	Remote/Shared Cubicle
18	PDS-LG-RG-PLNG	GIS ANALYST, PRINCIPAL	Remote/Assigned Cubicle
19	PDS-LG-RG-PLNG	PLANNER SENIOR	Remote/Shared Cubicle
20	PDS-LG-RG-PLNG	PLANNER SENIOR	Remote/Shared Cubicle
21	PDS-LG-RG-PLNG	PLANNER-PDS	Remote/Shared Cubicle
22	PDS-LG-RG-PLNG	PLANNER PRINCIPAL-PDS	Remote/Shared Cubicle
23	PDS-LG-RG-PLNG	DEMOGRAPHER PRINCIPAL	Remote/Shared Cubicle
24	PDS-LG-RG-PLNG	PLANNER-PDS	Remote/Shared Cubicle
25	PDS-LG-RG-PLNG	PLANNER SENIOR	Remote/Shared Cubicle
26	PDS-LG-RG-PLNG	PLANNER SENIOR	Remote/Shared Cubicle
27	PDS-LG-RG-PLNG	PLANNER-PDS	Remote/Shared Cubicle
28	PDS-LG-RG-PLNG	DIVISION MANAGER	Remote/Assigned Office
29	PDS-LG-RG-PLNG	PLANNER-PDS	Remote/Shared Cubicle
30	PDS-LG-RG-PLNG	PLANNER SENIOR	Remote/Shared Cubicle
31	PDS-NDCE	CODE ENFORCEMENT OFFICER	Remote (Field Staff)
32	PDS-NDCE	CODE ENFORCEMENT OFFICER	Remote (Field Staff)
33	PDS-NDCE	CODE ENFORCEMENT OFFICER	Remote (Field Staff)
34	PDS-NDCE	CODE ENFORCEMENT OFFICER SENIOR	Remote (Field Staff)
35	PDS-NDCE	PLANNING AND DEVELOPMENT SERVICES SUPERVISOR	Remote/Assigned Cubicle
36	PDS-NDCE	CODE ENFORCEMENT OFFICER	Remote (Field Staff)
37	PDS-NDCE	CODE ENFORCEMENT COORDINATOR	Remote
38	PDS-SCT	SNOHOMISH COUNTY TOMORROW (SCT) MANAGER	Remote/Assigned Cubicle
39	PDS-PAT	BUSINESS PROCESS ANALYST	Remote/Shared Cubicle
40	PDS-PAT	RECORDS SPECIALIST, SENIOR-PDS	Remote/Assigned Cubicle
41	PDS-PAT	GIS ANALYST, SENIOR	Remote/Shared Cubicle
42	PDS-PAT	GIS TECHNICIAN	Remote/Assigned Cubicle
43	PDS-PAT	ADMINISTRATIVE SPECIALIST	Assigned Cubicle
44	PDS-PAT	BUSINESS APPLICATION PROGRAMMER ANALYST	Remote/Shared Cubicle
45	PDS-PAT	BUSINESS PROCESS ANALYST	Remote/Shared Cubicle
46	PDS-PAT	SYSTEMS ADMINISTRATOR-PDS	Remote/Shared Cubicle

	A	D	E
47	PDS-PAT	TECHNOLOGY SUPPORT SPECIALIST	Assigned Cubicle
48	PDS-PERMIT	PLANNER SENIOR ENVIRONMENT	Remote/Shared Cubicle
49	PDS-PERMIT	PLANNER PRINCIPAL-PDS	Remote/Shared Cubicle
50	PDS-PERMIT	PLANNER SENIOR	Remote/Shared Cubicle
51	PDS-PERMIT	PLANNER-PDS	Remote/Shared Cubicle
52	PDS-PERMIT	PLANNER SENIOR ENVIRONMENT	Remote/Shared Cubicle
53	PDS-PERMIT	PERMIT TECHNICIAN, SENIOR	Remote/Shared Cubicle
54	PDS-PERMIT	ENGINEER III	Remote/Assigned Cubicle
55	PDS-PERMIT	SITE INSPECTOR, SENIOR	Remote/Assigned Cubicle
56	PDS-PERMIT	PLANNING AND DEVELOPMENT SERVICES SUPERVISOR	Remote/Assigned Cubicle
57	PDS-PERMIT	PLANS EXAMINER COMMERCIAL	Remote/Shared Cubicle
58	PDS-PERMIT	ZONING SPECIALIST	Remote/Shared Cubicle
59	PDS-PERMIT	ENGINEER II - PDS	Remote/Shared Cubicle
60	PDS-PERMIT	PERMIT TECHNICIAN, LEAD	Remote/Assigned Cubicle
61	PDS-PERMIT	PLANNING AND DEVELOPMENT SERVICES SUPERVISOR	Remote/Assigned Office
62	PDS-PERMIT	ENGINEER II - PDS	Remote/Shared Cubicle
63	PDS-PERMIT	PERMIT TECHNICIAN, LEAD SR.	Remote/Shared Cubicle
64	PDS-PERMIT	ZONING SPECIALIST	Remote/Shared Cubicle
65	PDS-PERMIT	ENGINEER III	Remote/Assigned Cubicle
66	PDS-PERMIT	RECORDS SPECIALIST-PDS	Assigned Cubicle
67	PDS-PERMIT	PLANNING AND DEVELOPMENT SERVICES SUPERVISOR	Remote/Assigned Cubicle
68	PDS-PERMIT	PERMIT TECHNICIAN, SENIOR	Remote/Shared Cubicle
69	PDS-PERMIT	PLANNER SENIOR ENVIRONMENT	Remote/Shared Cubicle
70	PDS-PERMIT	PLANNER SENIOR ENVIRONMENT	Remote/Shared Cubicle
71	PDS-PERMIT	PLANS EXAMINER SENIOR	Remote/Shared Cubicle
72	PDS-PERMIT	ZONING SPECIALIST	Remote/Shared Cubicle
73	PDS-PERMIT	PERMIT TECHNICIAN, SENIOR	Remote/Assigned Cubicle
74	PDS-PERMIT	LAND DEVELOPMENT & ROW COORDINATOR	Assigned Cubicle
75	PDS-PERMIT	SURVEY PROJECT LEAD	Remote/Assigned Cubicle
76	PDS-PERMIT	SITE INSPECTOR	Remote (Field Staff)
77	PDS-PERMIT	PERMIT TECHNICIAN	Assigned Cubicle
78	PDS-PERMIT	PERMIT TECHNICIAN	Remote/Assigned Cubicle
79	PDS-PERMIT	PERMIT TECHNICIAN, SENIOR	Remote/Shared Cubicle
80	PDS-PERMIT	RECORDS SPECIALIST-PDS	Assigned Cubicle
81	PDS-PERMIT	PERMIT TECHNICIAN, SENIOR	Remote/Shared Cubicle
82	PDS-PERMIT	PLANNER SENIOR	Remote/Shared Cubicle
83	PDS-PERMIT	PLANNER SENIOR	Remote/Shared Cubicle
84	PDS-PERMIT	DIVISION MANAGER	Assigned Office
85	PDS-PERMIT	LAND DEVELOPMENT SPECIALIST	Remote/Shared Cubicle
86	PDS-PERMIT	PLANNER PRINCIPAL-PDS	Remote/Shared Cubicle
87	PDS-PERMIT	PLANNER SENIOR	Remote/Shared Cubicle
88	PDS-PERMIT	DIVISION MANAGER	Assigned Office
89	PDS-PERMIT	FRONT COUNTER LEAD	Remote/Shared Cubicle
90	PDS-PERMIT	SITE INSPECTOR, SENIOR	Remote (Field Staff)
91	PDS-PERMIT	ZONING SPECIALIST	Remote/Shared Cubicle
92	PDS-PERMIT	RECORDS SPECIALIST-PDS	Assigned Cubicle

	A	D	E
93	PDS-PERMIT	LAND DEVELOPMENT SPECIALIST	Remote/Shared Cubicle
94	PDS-PERMIT	PERMIT TECHNICIAN	Remote/Shared Cubicle
95	PDS-PERMIT	PLANNER-PDS	Remote/Shared Cubicle
96	PDS-PERMIT	PLANNER SENIOR	Remote/Shared Cubicle
97	PDS-PERMIT	PERMIT TECHNICIAN	Remote/Shared Cubicle
98	PDS-PERMIT	PERMIT TECHNICIAN	Assigned Cubicle
99	PDS-PERMIT	PLANS EXAMINER	Remote/Shared Cubicle
100	PDS-PERMIT	PLANNING AND DEVELOPMENT SERVICES SUPERVISOR	Remote/Shared Cubicle
101	PDS-PERMIT	PDS ENGINEERING SUPERVISOR	Remote/Assigned Cubicle
102	PDS-PERMIT	PLANNER SENIOR ENVIRONMENT	Remote/Shared Cubicle
103	PDS-PERMIT	ENGINEER II - PDS	Remote/Assigned Cubicle
104	PDS-PERMIT	PERMIT TECHNICIAN, SENIOR	Remote/Shared Cubicle
105	PDS-PERMIT	LAND DEVELOPMENT & ROW COORDINATOR	Assigned Cubicle
106	PDS-PERMIT	PLANS EXAMINER COMMERCIAL	Remote
107	PDS-PERMIT	PLANS EXAMINER	Remote/Assigned Cubicle
108	PDS-PERMIT	BIOLOGIST	Remote/Assigned Cubicle
109	PDS-PERMIT	BUILDING INSPECTOR, LEAD	Remote/Assigned Cubicle
110	PDS-PERMIT	PLANS EXAMINER COMMERCIAL	Remote/Shared Cubicle
111	PDS-PERMIT	ENGINEER IV	Remote/Assigned Cubicle
112	PDS-PERMIT	ZONING SPECIALIST	Remote/Shared Cubicle
113	PDS-PERMIT	PLANNER-PDS	Remote/Shared Cubicle
114	PDS-PERMIT	ENGINEER II - PDS	Remote/Shared Cubicle
115	PDS-PERMIT	PLANNER SENIOR	Remote/Shared Cubicle
116	PDS-PERMIT	PERMIT TECHNICIAN	Remote/Shared Cubicle
117	PDS-PERMIT	ENGINEER III	Remote/Assigned Cubicle
118	PDS-PERMIT	SITE INSPECTOR	Remote (Field Staff)
119	PDS-PERMIT	SITE INSPECTOR, SENIOR	Remote (Field Staff)
120	PDS-PERMIT	ZONING SPECIALIST	Remote/Shared Cubicle
121	PDS-PERMIT	ENGINEER III	Remote/Shared Cubicle
122	PDS-PERMIT	ZONING SPECIALIST	Remote/Shared Cubicle
123	PDS-PERMIT	ENGINEER II - PDS	Remote/Shared Cubicle
124	PDS-PERMIT	PLANNER-PDS	Assigned Cubicle
125	PDS-PERMIT	PLANS EXAMINER	Remote/Shared Cubicle
126	PDS-PERMIT	BIOLOGIST	Remote/Shared Cubicle
127	PDS-PERMIT	SITE INSPECTOR	Remote (Field Staff)
128	PDS-PERMIT (BLDG IN	BUILDING INSPECTOR	Remote (Field Staff)
129	PDS-PERMIT (BLDG IN	BUILDING INSPECTOR 2 COMMERICAL RESIDENTIAL	Remote (Field Staff)
130	PDS-PERMIT (BLDG IN	BUILDING INSPECTOR	Remote (Field Staff)
131	PDS-PERMIT (BLDG IN	BUILDING INSPECTOR	Remote (Field Staff)
132	PDS-PERMIT (BLDG IN	BUILDING INSPECTOR	Remote (Field Staff)
133	PDS-PERMIT (BLDG IN	BUILDING INSPECTOR 2 COMMERICAL RESIDENTIAL	Remote (Field Staff)
134	PDS-PERMIT (BLDG IN	BUILDING INSPECTOR 2 COMMERICAL RESIDENTIAL	Remote (Field Staff)
135	PDS-PERMIT (BLDG IN	BUILDING INSPECTOR 2 COMMERICAL RESIDENTIAL	Remote (Field Staff)
136	PDS-PERMIT (BLDG IN	BUILDING INSPECTOR 2 COMMERICAL RESIDENTIAL	Remote (Field Staff)
137	PDS-PERMIT (BLDG IN	BUILDING INSPECTOR	Remote (Field Staff)
138	PDS-PERMIT (FIRE IN	FIRE INSPECTOR SENIOR	Assigned Desk in FMO

	A	D	E
139	PDS-PERMIT (FIRE INSPECTION)	FIRE MARSHAL, ASSISTANT	Assigned Desk in FMO
140	PDS-PERMIT (FIRE INSPECTION)	FIRE INSPECTOR SENIOR	Remote/Assigned Cubicle
141	PDS-PERMIT (FIRE INSPECTION)	FIRE INSPECTOR SENIOR	Remote/Assigned Cubicle
142	PDS-PERMIT (FIRE INSPECTION)	PERMIT TECHNICIAN, SENIOR	Assigned Cubicle
143	PDS-PERMIT (FIRE INSPECTION)	FIRE INSPECTOR SENIOR	Assigned Cubicle
144	PDS-PERMIT (FIRE INSPECTION)	FIRE INSPECTOR SENIOR	Remote/Assigned Cubicle

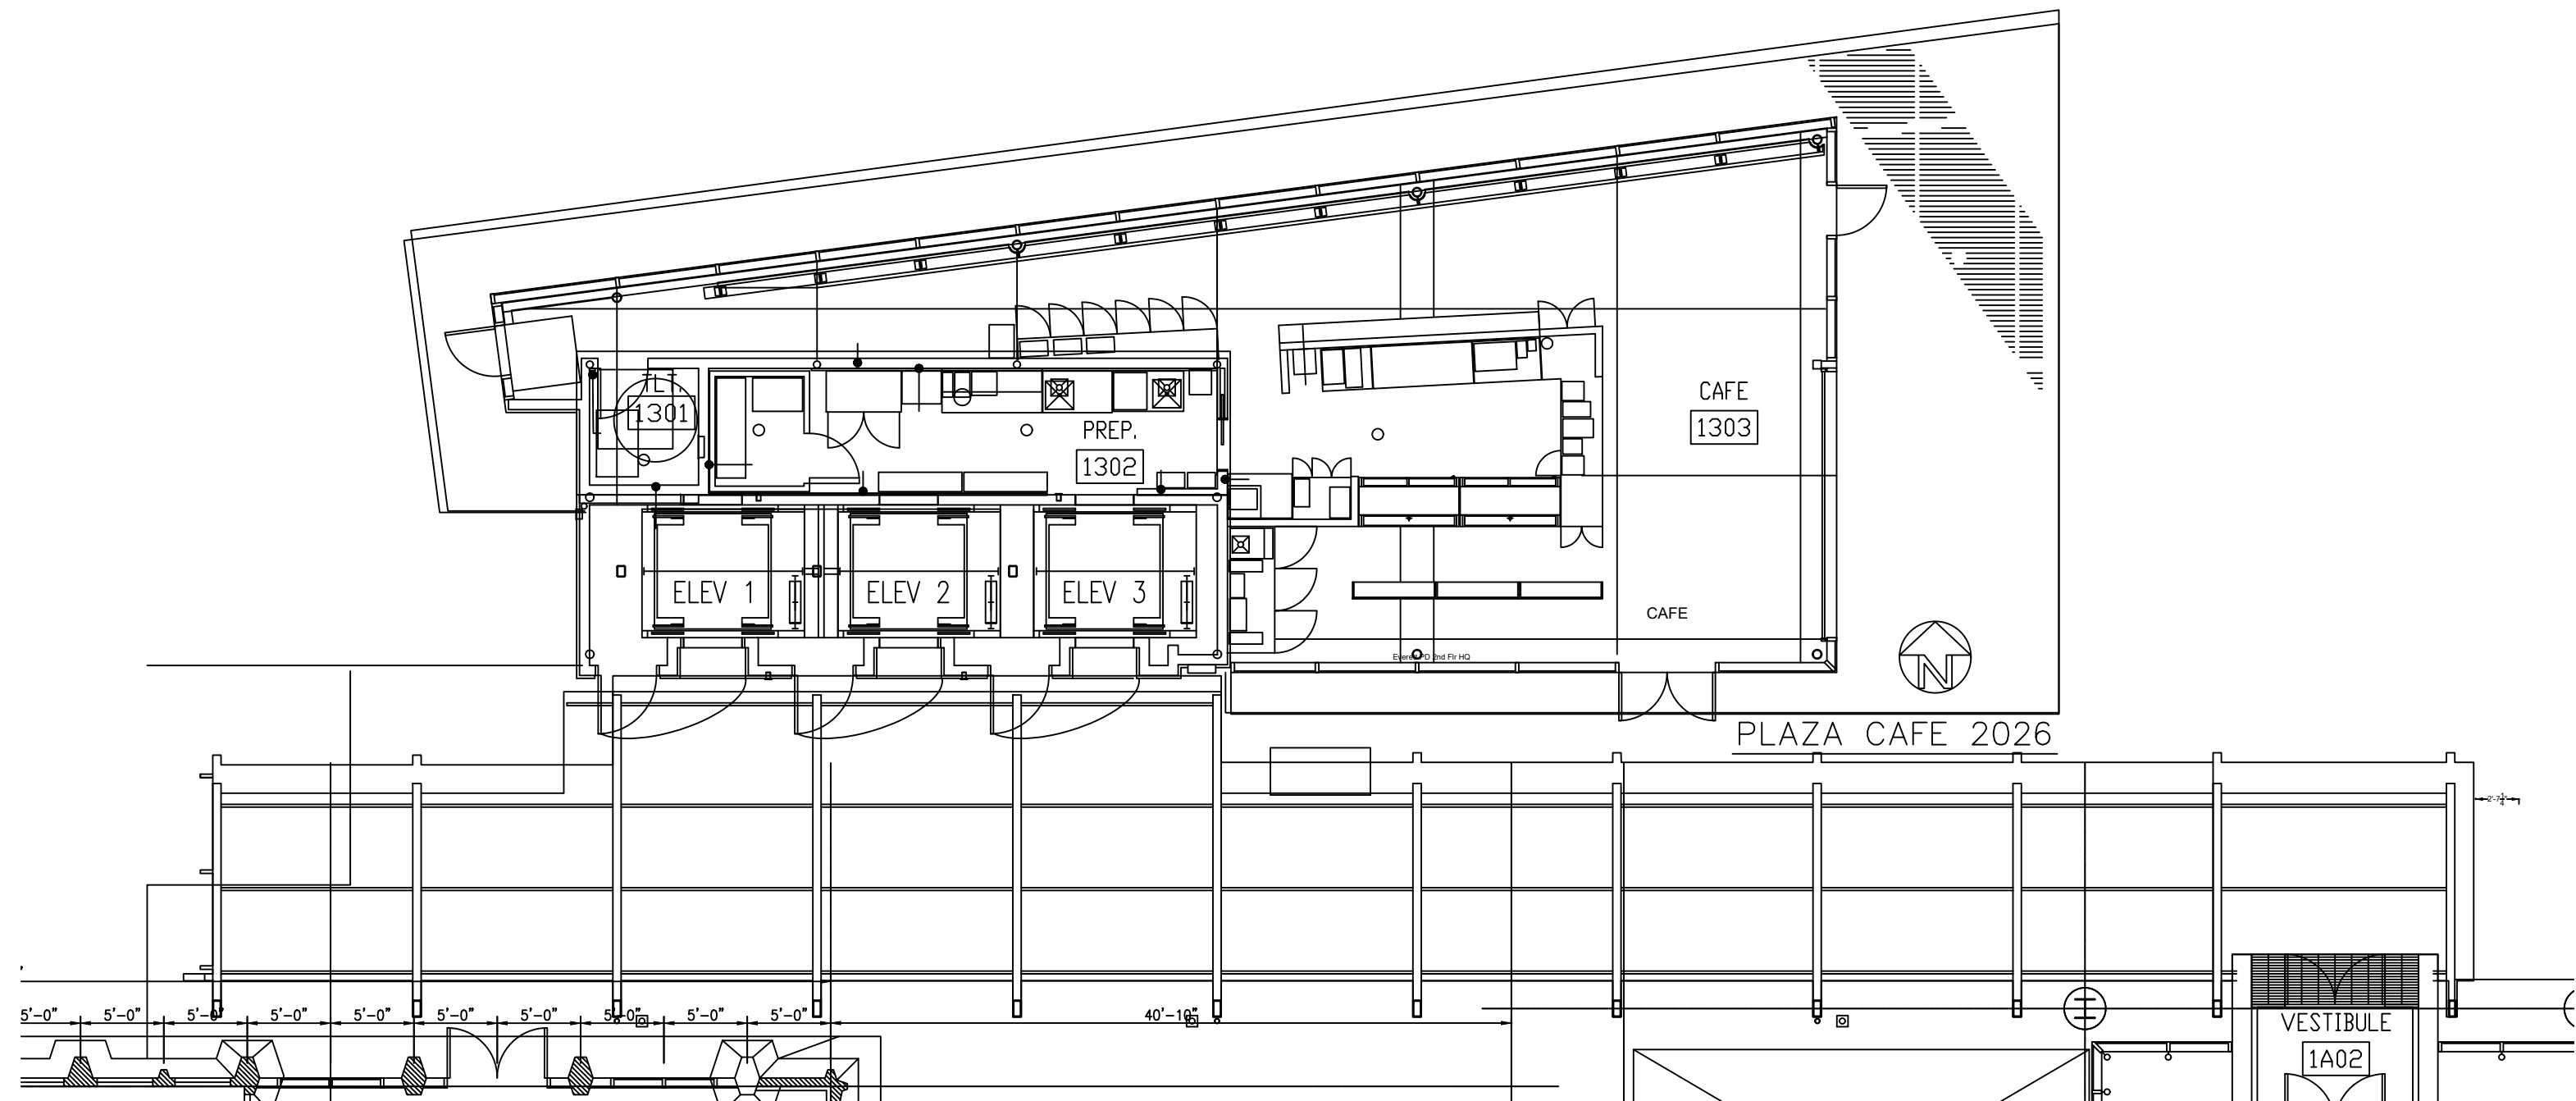

5th Floor Admin West Floorplan Assignments - Public Works

Green = Designated Workspace


DIVISION	JOB_CODE	POSITION_CODE
PWK-ADMIN-OPS	RECRUITCOD	PWK8422R
PWK-ADMIN-OPS	ADMINOPSMGR-PWKS	PWK6317R
PWK-ADMIN-OPS	SPECPROJMGR	PWK6107R
PWK-ADMIN-OPS	PLNRSR-PWK	PWK1645R
PWK-ADMIN-OPS	HRSPEC	PWK8231R
PWK-ADMIN-OPS	RCRDSPEC	PWK4243R
PWK-ADMIN-OPS	SPECPROJCOORD	PWK8558R
PWK-ADMIN-OPS	RCRDSPEC-SR	PWK8512R
PWK-ADMIN-OPS	PWKSUPV3	PWK8564R
PWK-ADMIN-OPS	FUNDCMPLSPECCLD	PWK8941R
PWK-ADMIN-OPS	TECHSUPPSPEC-PWK	PWK9375R
PWK-ADMIN-OPS	ADMINASST-PWDIVD	PWK8719R
PWK-ADMIN-OPS	CNTRCTSPECSR-PW	PWK8352R
PWK-ADMIN-OPS	BUSTECHANLYST	PWK4086R
PWK-ADMIN-OPS	CNTRCTSPEC-PWK	PWK8715R
PWK-ADMIN-OPS	OA2	PWK8452R
PWK-ADMIN-OPS	PWCNTRCTADMIN	PWK8765R
PWK-ADMIN-OPS	PWKSUPV3	PWK8726R
PWK-ADMIN-OPS	PWKSUPV1	PWK8578R
PWK-ADMIN-OPS	PLNRSR-PWK	PWK8577R
PWK-ADMIN-OPS	ACCTTECH3	PWK8073R
PWK-ADMIN-OPS	BUSPROCANLYST	PWK4189R
PWK-ADMIN-OPS	PWKDEPDIR	PWK8302R
PWK-ADMIN-OPS	ACCTTECH3	PWK8508R
PWK-ADMIN-OPS	CNTRCTSPEC-PWK	PWK4051R
PWK-ADMIN-OPS	DEPTECHMNGR	PWK8710R
PWK-ADMIN-OPS	ENG3SPECPROJ	PWK8467R
PWK-ADMIN-OPS	RCRDSPEC	PWK8193R
PWK-ADMIN-OPS	RECRUITCOD	PWK8413R
PWK-ADMIN-OPS	PWKDIR	PWK8301R
PWK-ADMIN-OPS	ACCTTECH3	PWK8657R
PWK-ADMIN-OPS	HRSPEC	PWK8382R
PWK-ADMIN-OPS	ACTNT2	PWK8522R
PWK-ADMIN-OPS	SPECPROJCOORD	PWK4197R
PWK-TES-ADMIN	ACCTTECH2	PWK8799R
PWK-TES-ADMIN	ENGDIVDIR	PWK4200R
PWK-TES-ADMIN	ADMINSUPPSUPV	PWK7750R
PWK-TES-COM	COMMSPEC2	PWK8402R
PWK-TES-COM	COMMSPEC2	PWK8344R
PWK-TES-COM	GRPHSPEC2	PWK8594R
PWK-TES-COM	COMMSPEC2	PWK8623R
PWK-TES-COM	GRPHSPEC2	PWK8342R
PWK-TES-COM	COMMSPEC1	PWK4202R
PWK-TES-COM	COMMSUPV	PWK8234R
PWK-TES-ENV	PWKSUPV3	PWK9438R
PWK-TES-ENV	BIO	PWK8914R
PWK-TES-ENV	GISANLYSTSR	PWK8383R
PWK-TES-ENV	PLNRSR-PWK	PWK4198R
PWK-TES-ENV	PLNRSR2	PWK8345R

5th Floor Admin West Floorplan Assignments - Public Works


Green = Designated Workspace

DIVISION	JOB_CODE	POSITION_CODE
PWK-TES-ENV	PLNRSRENVIRON	PWK4237R
PWK-TES-ENV	BIO	PWK4188R
PWK-TES-ENV	PLNRSRENVIRON	PWK8426R
PWK-TES-ENV	PLNR-PWK	PWK8355R
PWK-TES-PRG-PLNG	TRANSPPLNGTECH	PWK4187R
PWK-TES-PRG-PLNG	TRANSPSPEC	PWK8358R
PWK-TES-PRG-PLNG	ENG1	PWK8629R
PWK-TES-PRG-PLNG	TRANSPSPEC	PWK8617R
PWK-TES-PRG-PLNG	PLNRSR2	PWK9610R
PWK-TES-PRG-PLNG	TRANSPSPECASSOC	PWK4291R
PWK-TES-PRG-PLNG	PWKSUPV3	PWK4183R
PWK-TES-PRG-PLNG	FNDCOORD	PWK8557R
PWK-TES-PRG-PLNG	PLNRSR-PWK	PWK4107R
PWK-TES-PRG-PLNG	TRANSPSPEC	PWK7710R
PWK-TES-PRG-PLNG	ENGMGR	PWK8607R
PWK-TES-PRG-PLNG	FNDCOORD	PWK8387R
PWK-TES-PRG-PLNG	ENG2	PWK4201R
PWK-TES-PRG-PLNG	ENG1	PWK8533R
PWK-TES-PRG-PLNG	PWKSUPV3	PWK8513R
PWK-TES-PRG-PLNG	ENG2	PWK8565R
PWK-TES-PRG-PLNG	PLNRSR-PWK	PWK8379R
PWK-TES-TRAF-OPS	PWKSUPV2	PWK8556R
PWK-TES-TRAF-OPS	TRANSPSPEC	PWK7712R
PWK-TES-TRAF-OPS	ENG3	PWK8384R
PWK-TES-TRAF-OPS	ENG2	PWK8770R
PWK-TES-TRAF-OPS	ROWINVEST2	PWK8599R
PWK-TES-TRAF-OPS	ENGTECH3-TRAF	PWK8620R
PWK-TES-TRAF-OPS	TRAFINVEST	PWK8347R
PWK-TES-TRAF-OPS	TRAFINVEST	PWK8538R
PWK-TES-TRAF-OPS	ROWINVEST3	PWK8356R
PWK-TES-TRAF-OPS	ENG1	PWK8163R
PWK-TES-TRAF-OPS	ENG4	PWK4054R
PWK-TES-TRAF-OPS	TRAFINVEST	PWK4125R
PWK-TES-TRAF-OPS	ROWINVEST3	PWK8349R
PWK-TES-TRAF-OPS	PWKSUPV3	PWK8622R
PWK-TES-TRAF-OPS	TRAFSIGTECHELEC2	PWK2592R
PWK-TES-TRAF-OPS	ENGTECH3-TRAF	PWK8534R
PWK-TES-TRAF-OPS	ENGTECH3-TRAF	PWK8597R
PWK-TES-TRAF-OPS	BUSTECHANLYST	PWK8343R
PWK-TES-TRAF-OPS	LNDDEVANLYSTASOC	PWK8774R
PWK-TES-TRAF-OPS	ENGMGR	PWK8720R
PWK-TES-TRAF-OPS	PWKSUPV2	PWK8555R
PWK-TES-TRAF-OPS	ENGTECHSRLD	PWK8618R
PWK-TES-TRAF-OPS	ENGTECH4	PWK8408R



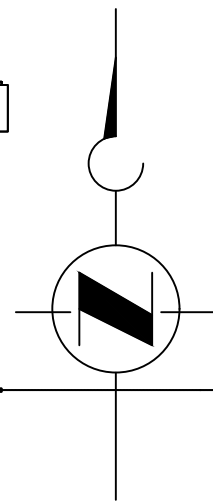


30' 0"


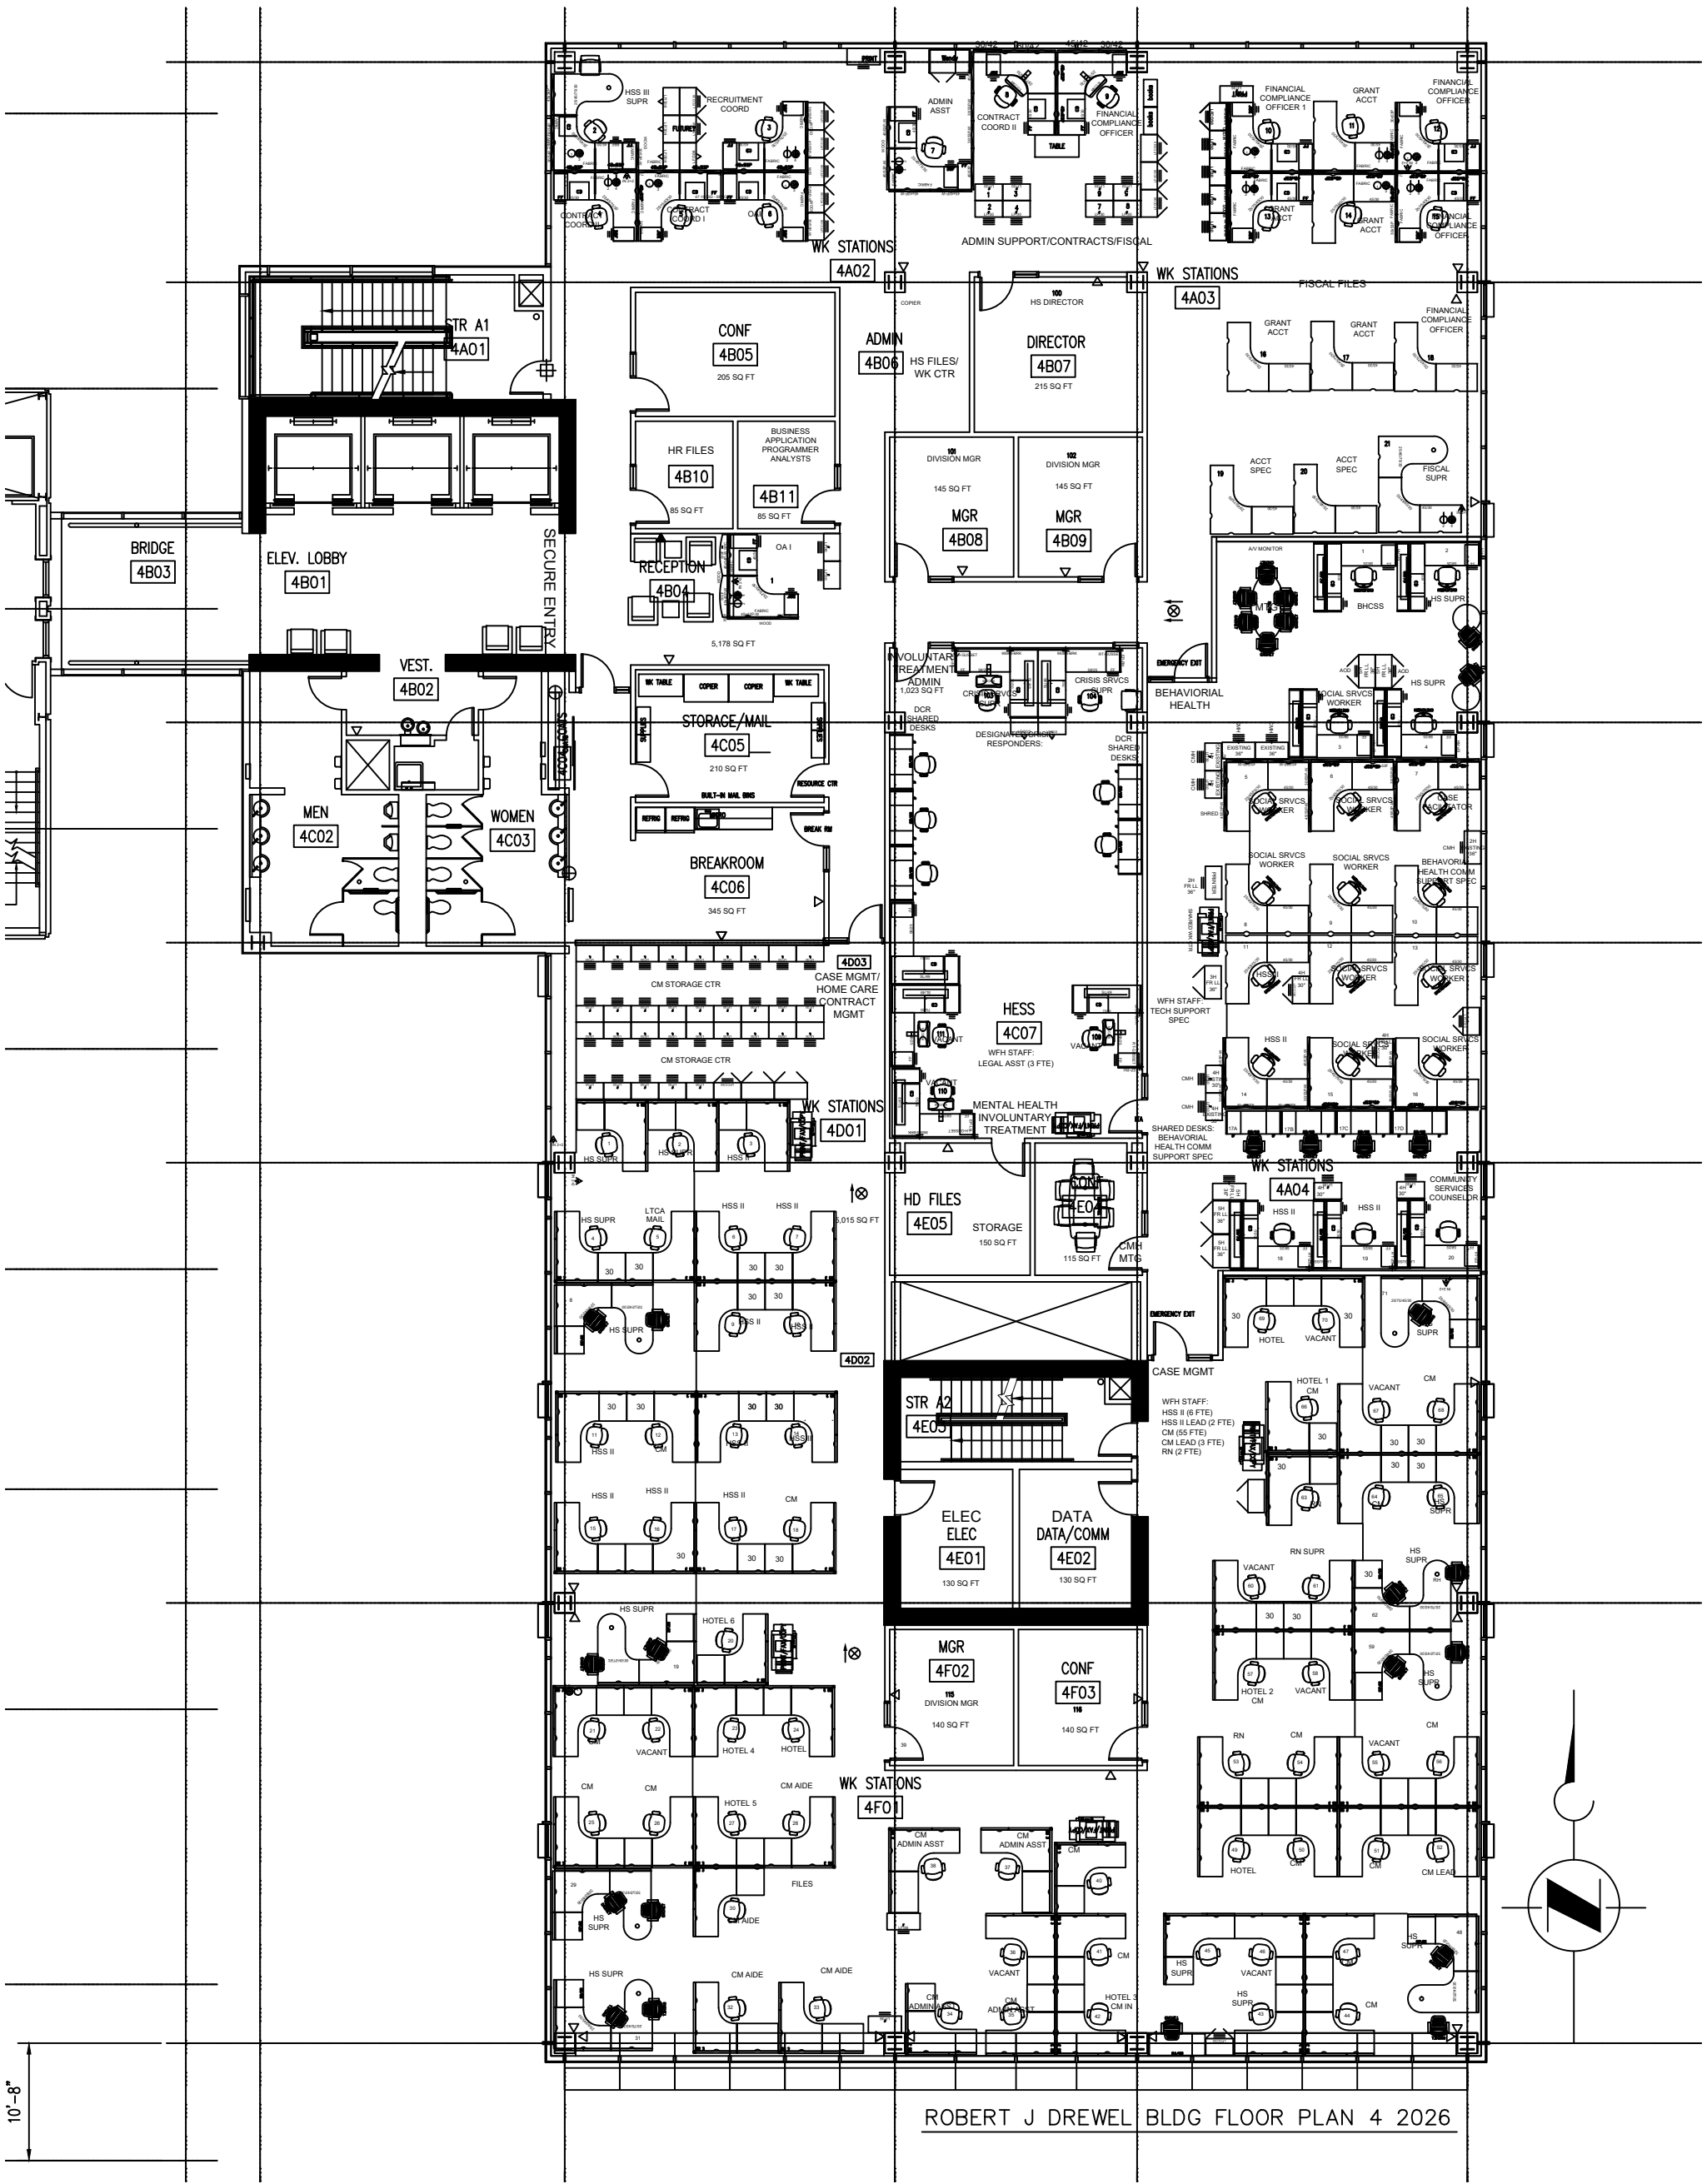


ROBERT J DREWEL BLDG FLOOR PLAN 4 2026




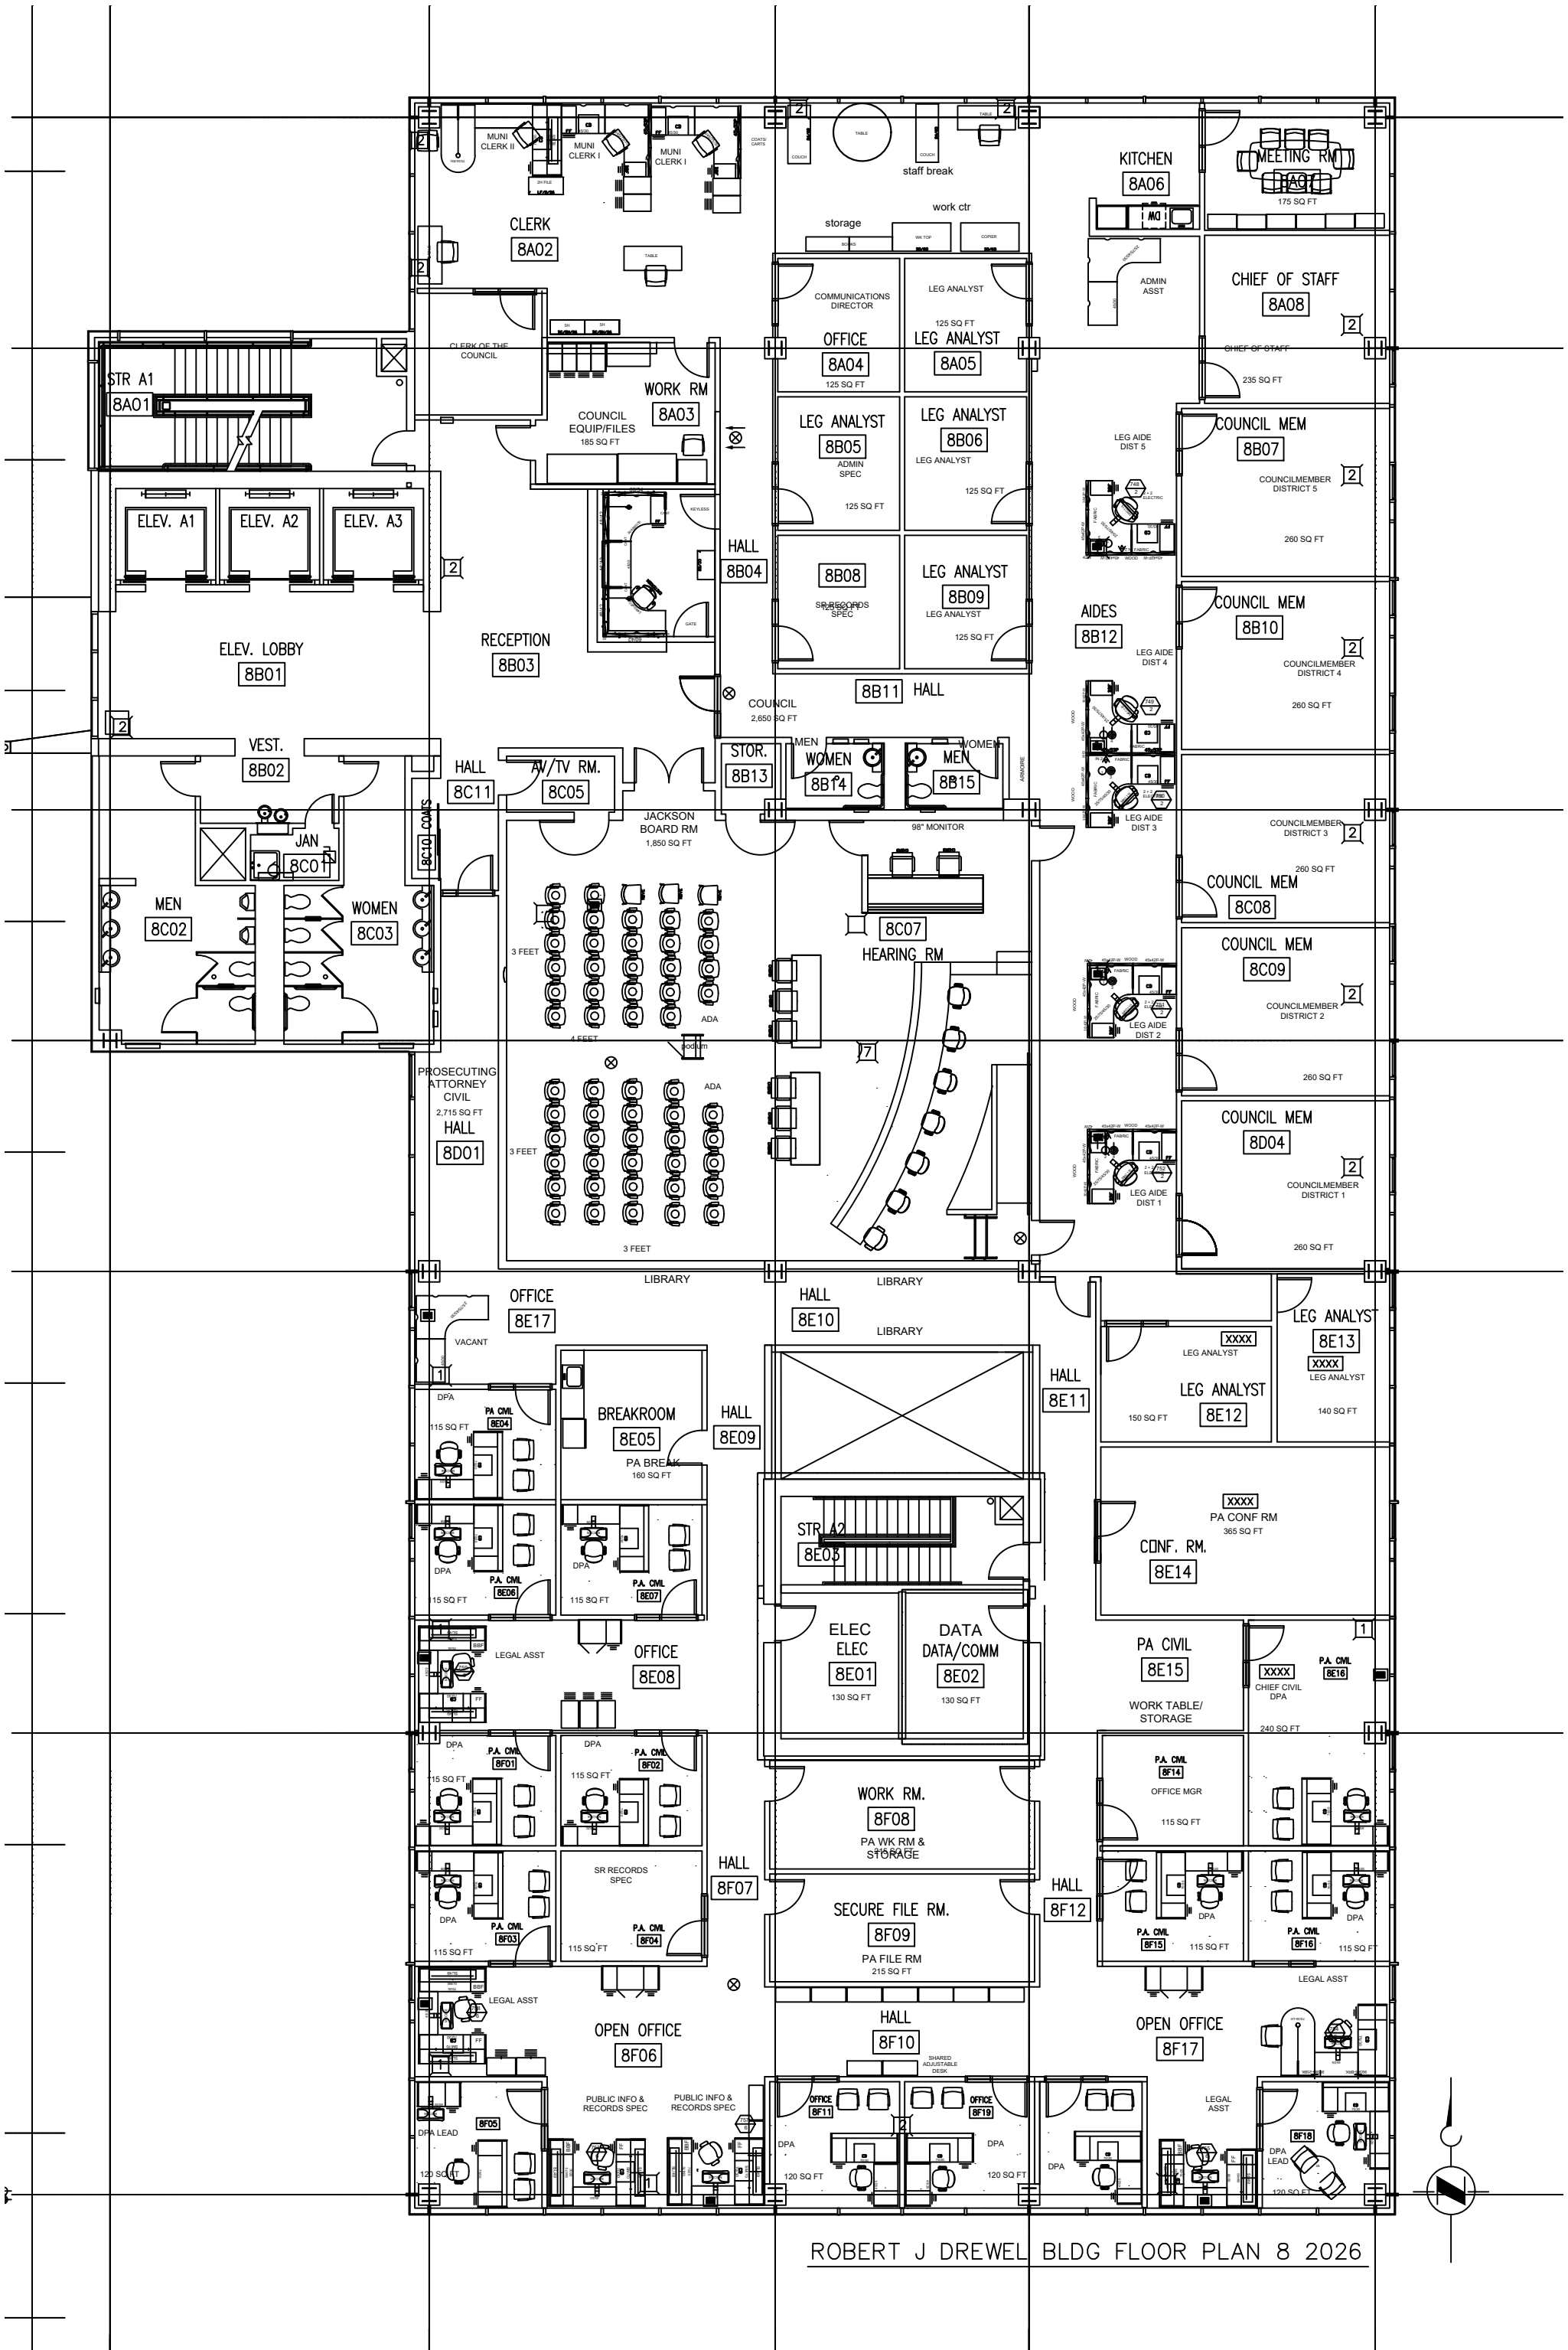


ROBERT J DREWEL BLDG FLOOR PLAN 8 2026

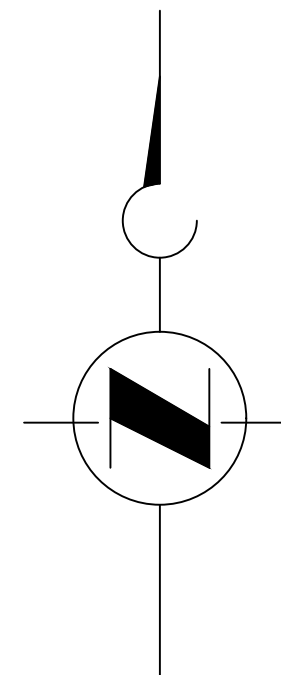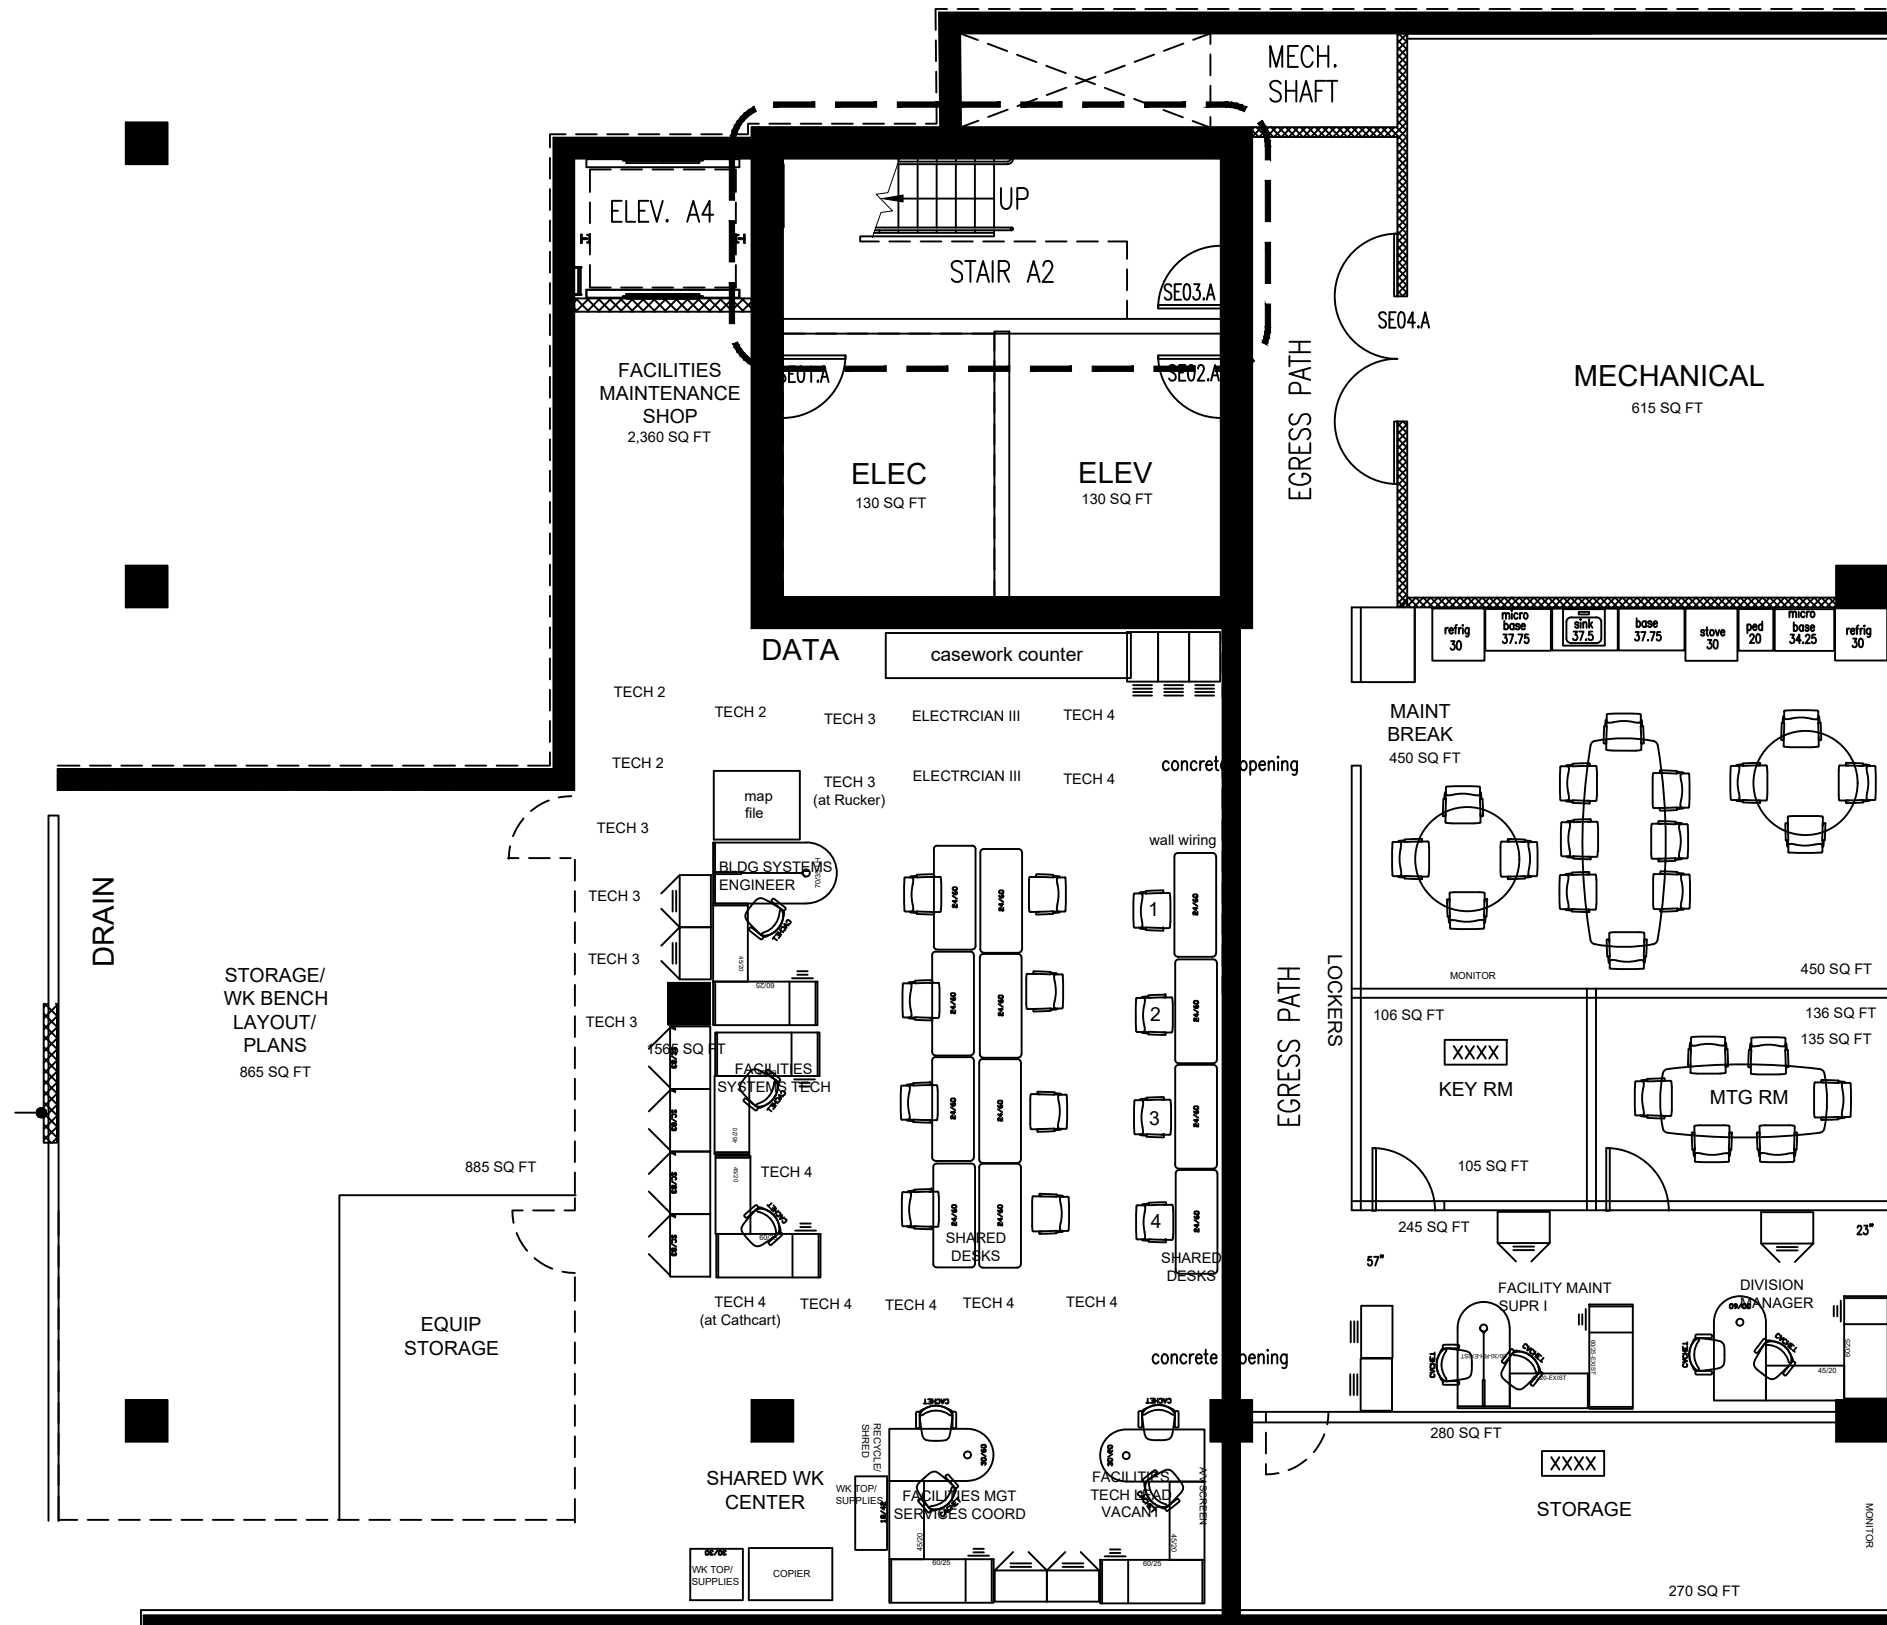


ROBERT J DREWEL BLDG FLOOR PLAN B2 2026

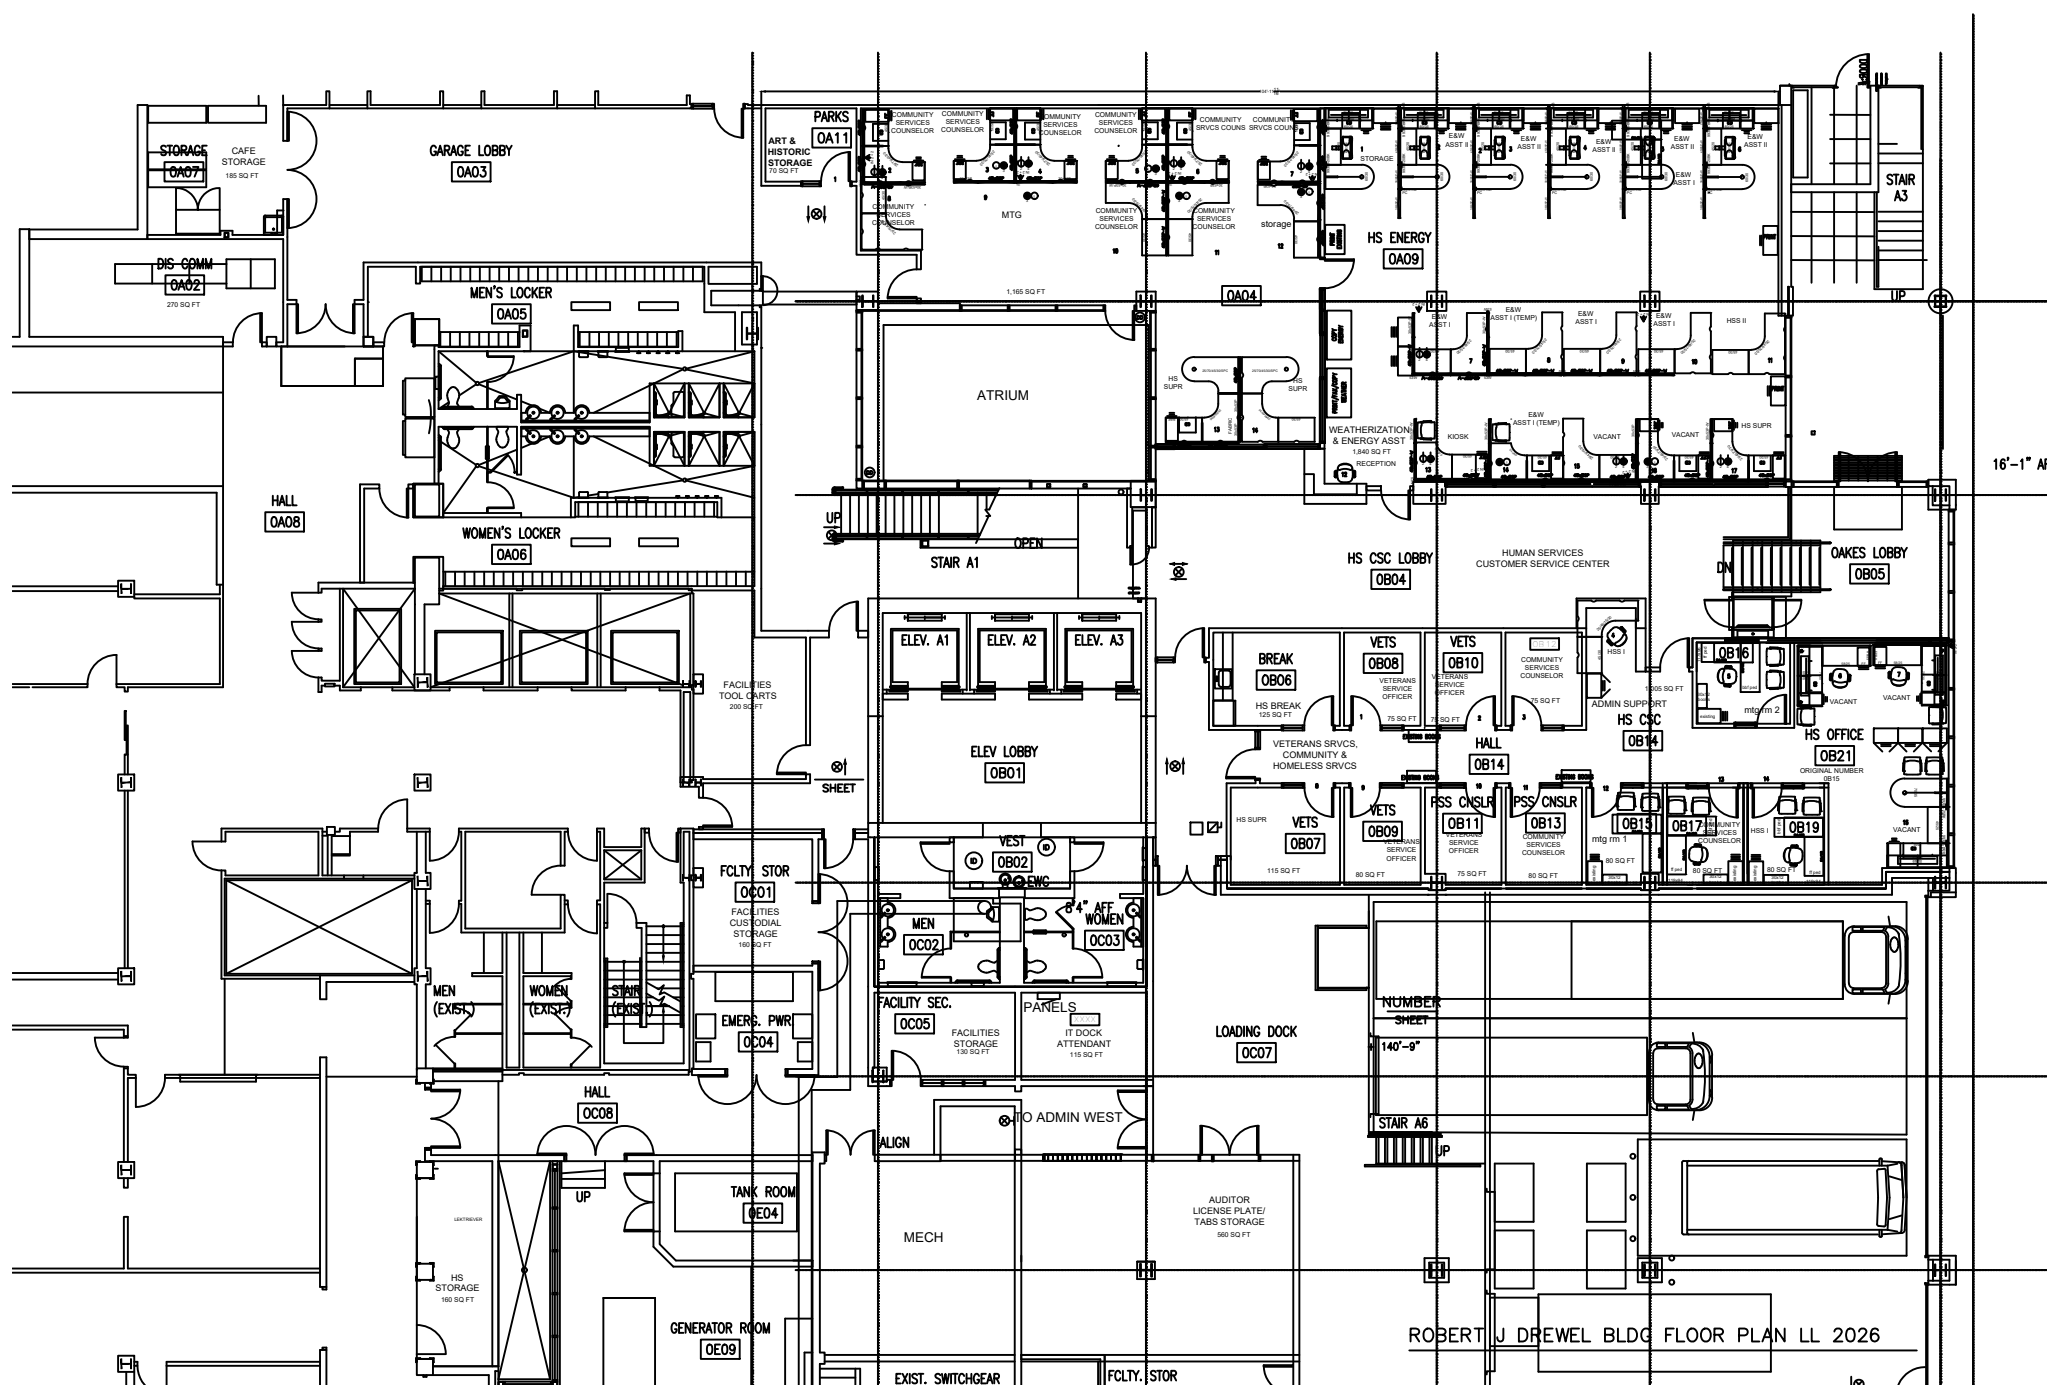

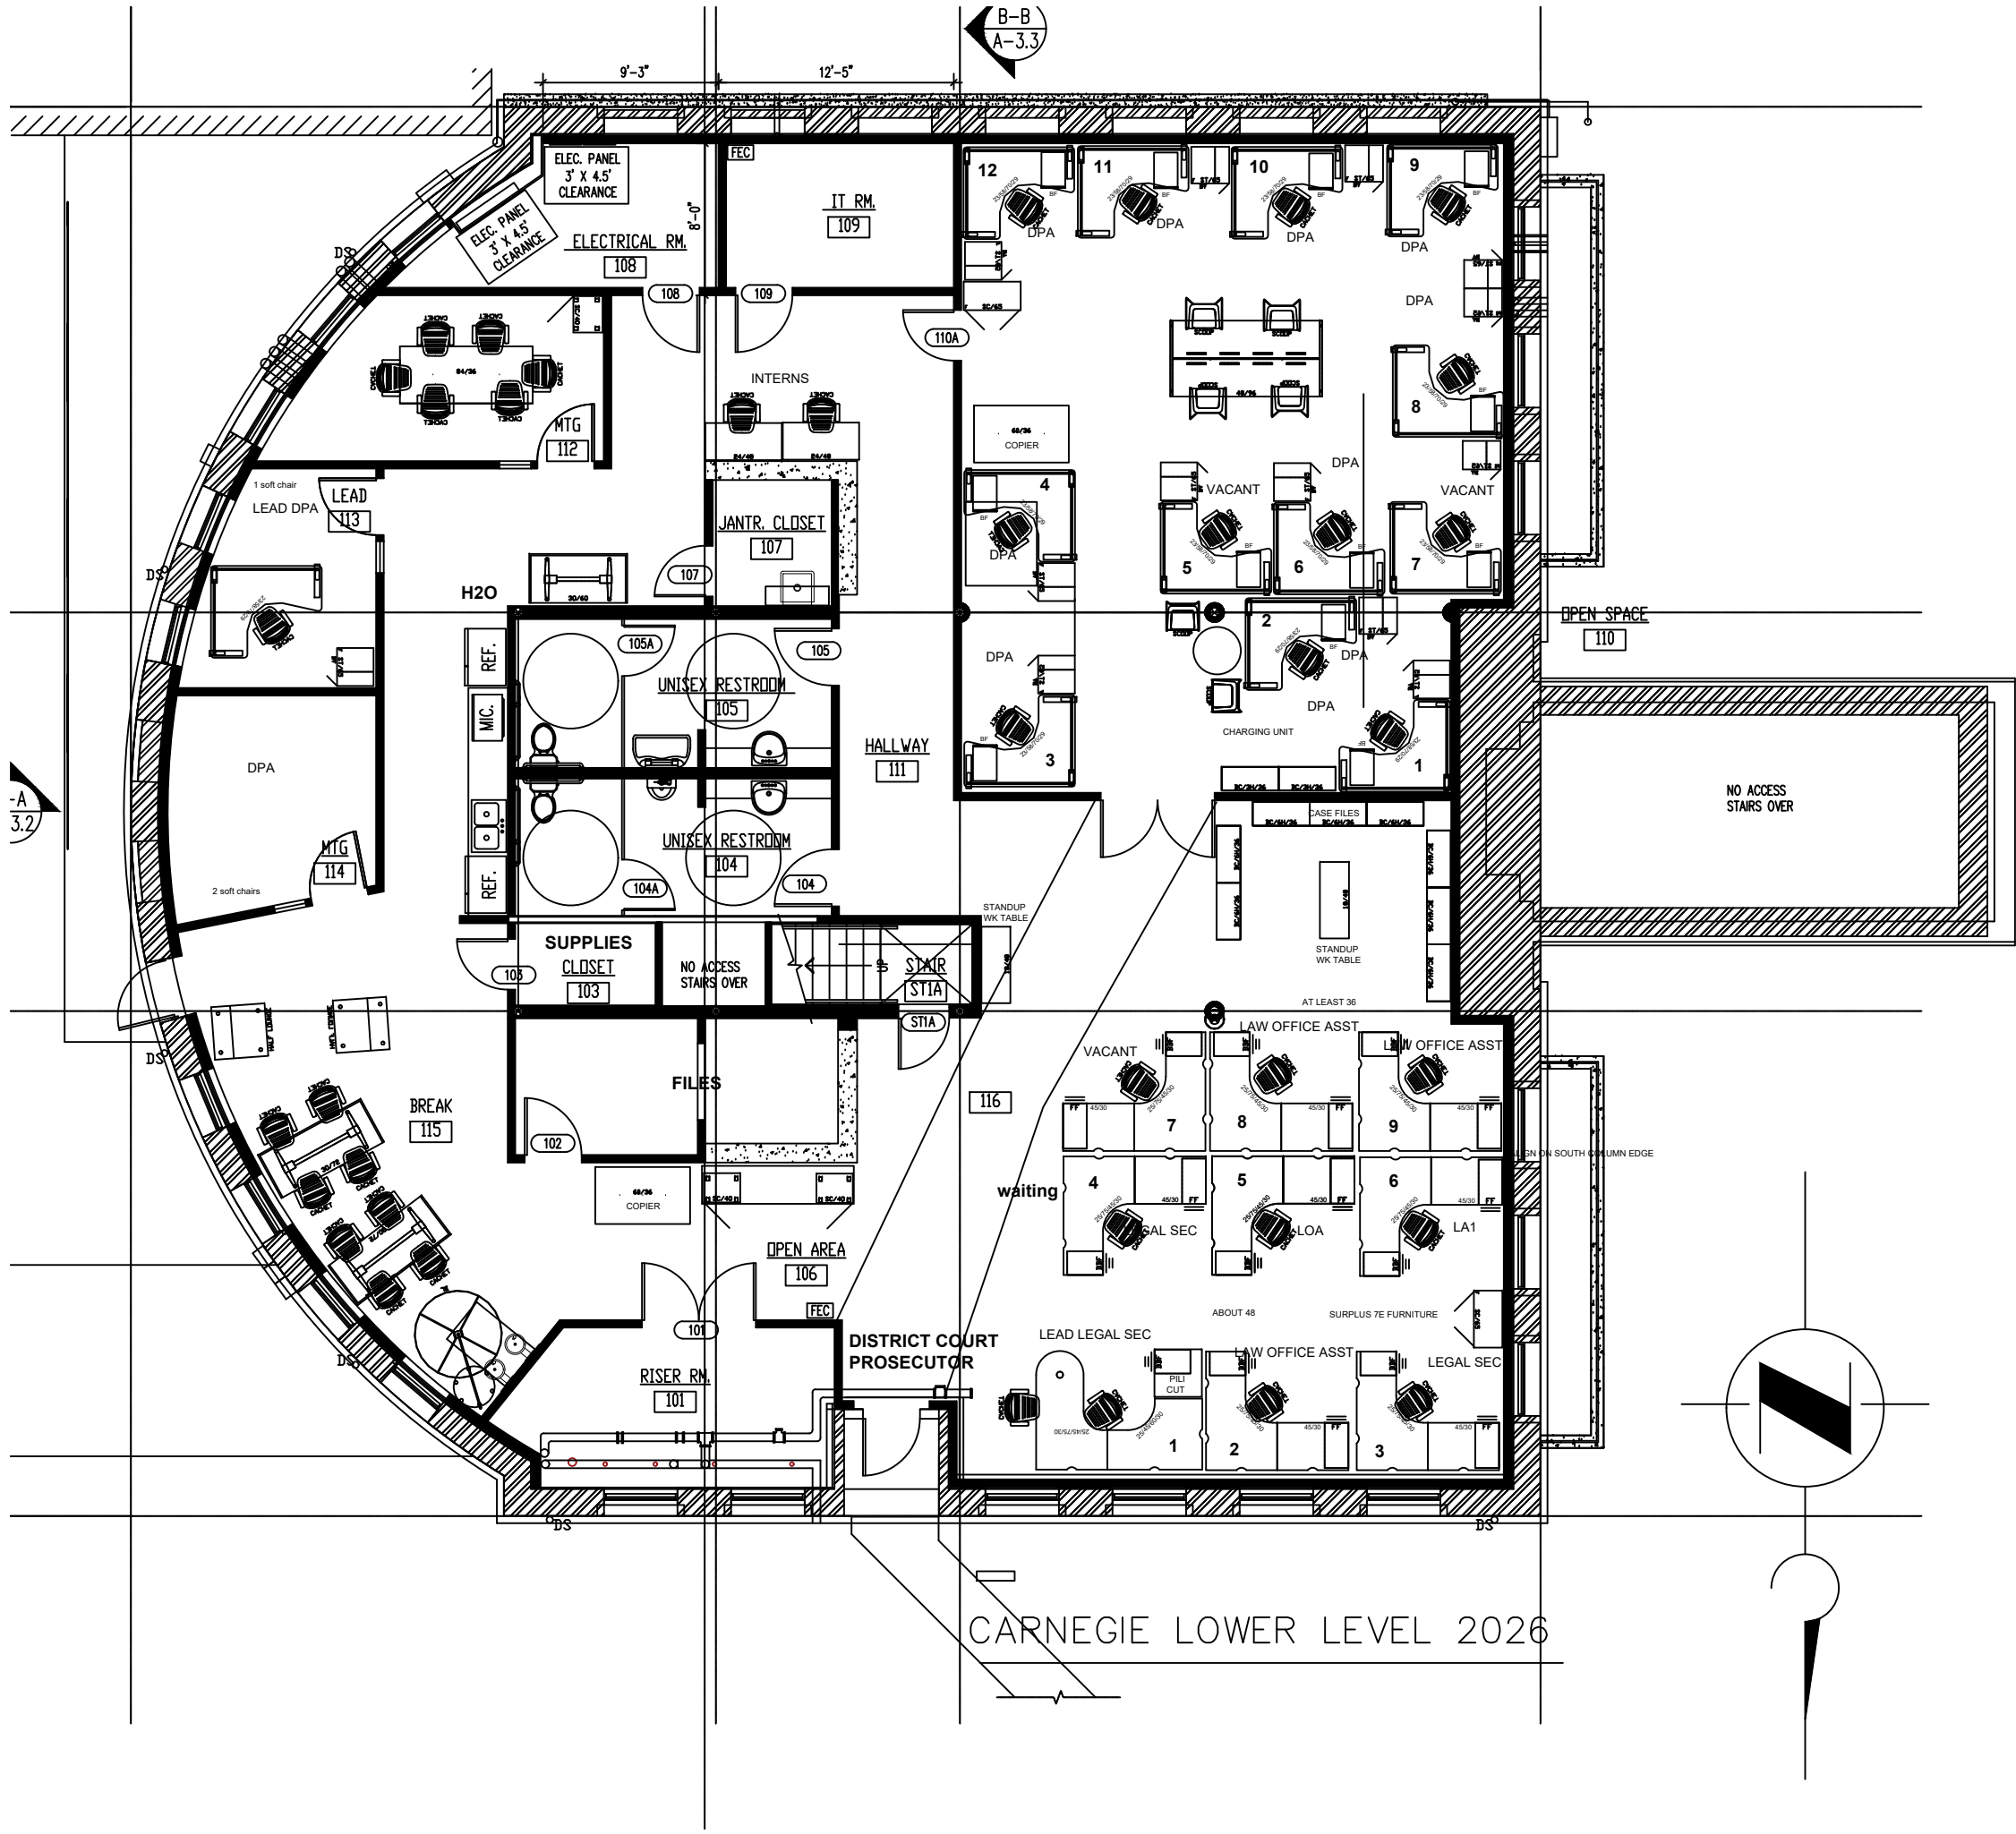

CARNEGIE LOWER LEVEL 2026

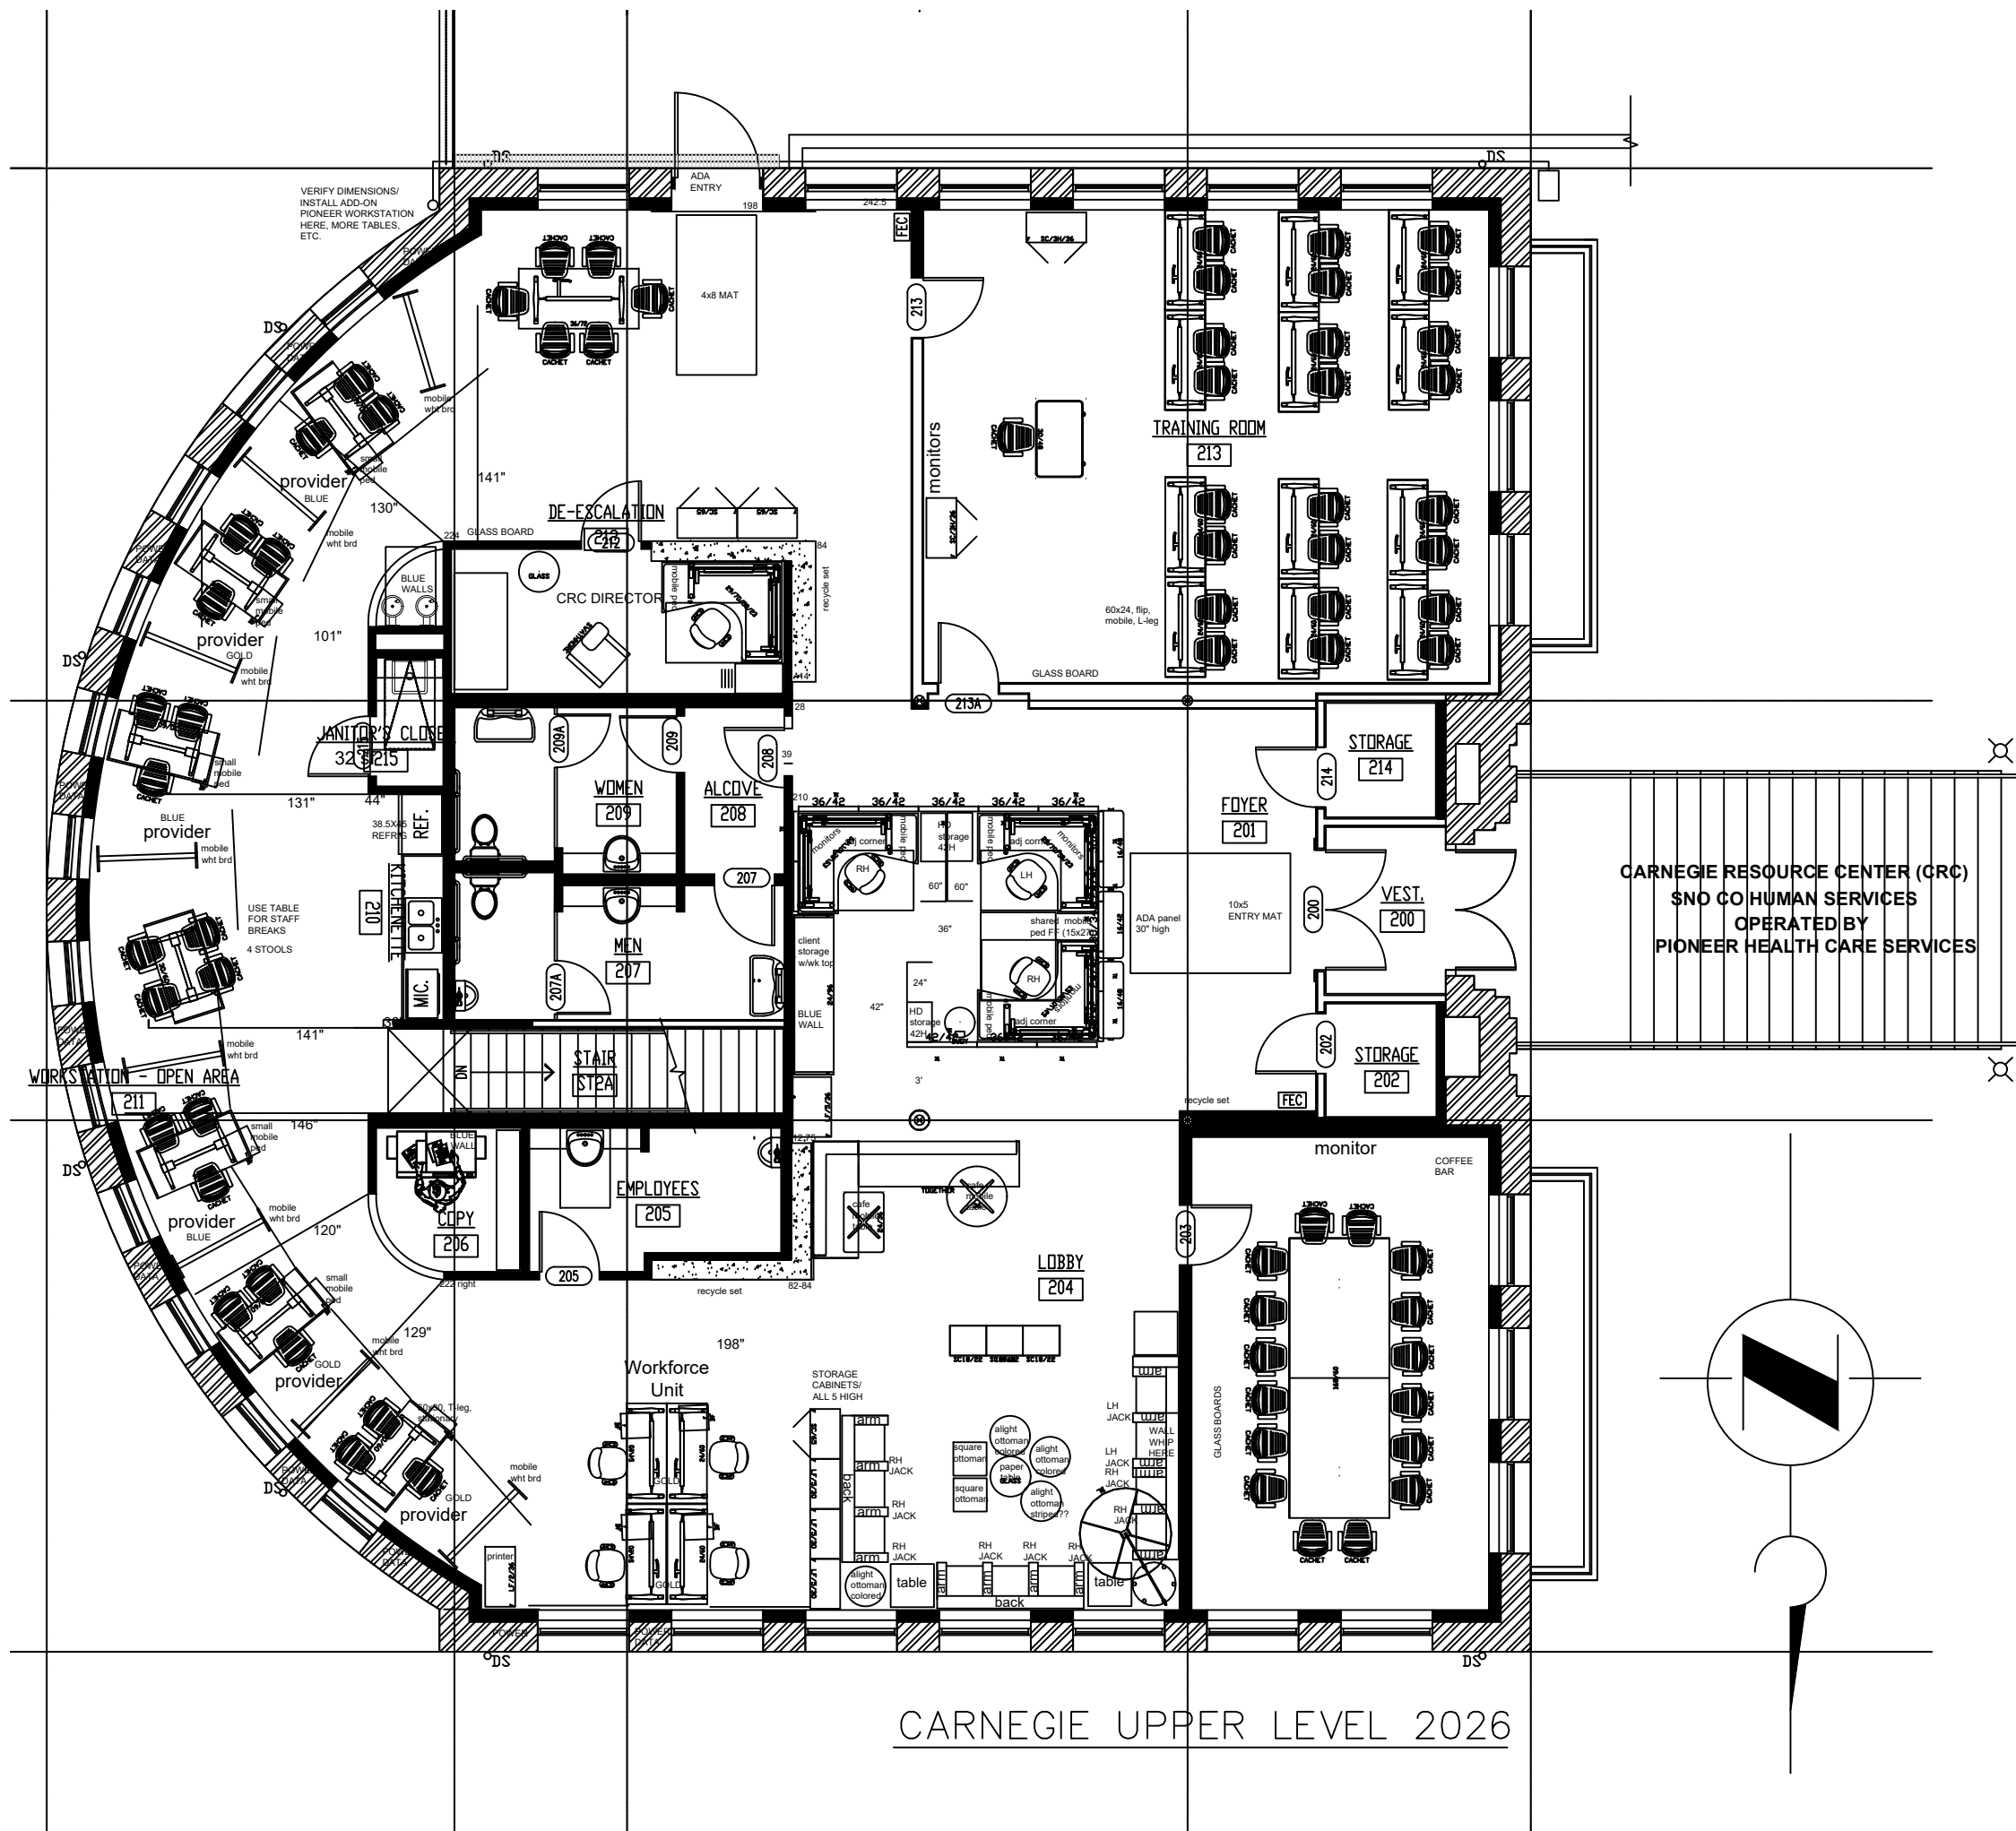


CARNEGIE UPPER LEVEL 2026


Xref 2503-ASG-0a.dwg


 CATHCART BLDG A FLOOR PLAN 1 2026




 CATHCART BLDG A FLOOR PLAN 1 2026

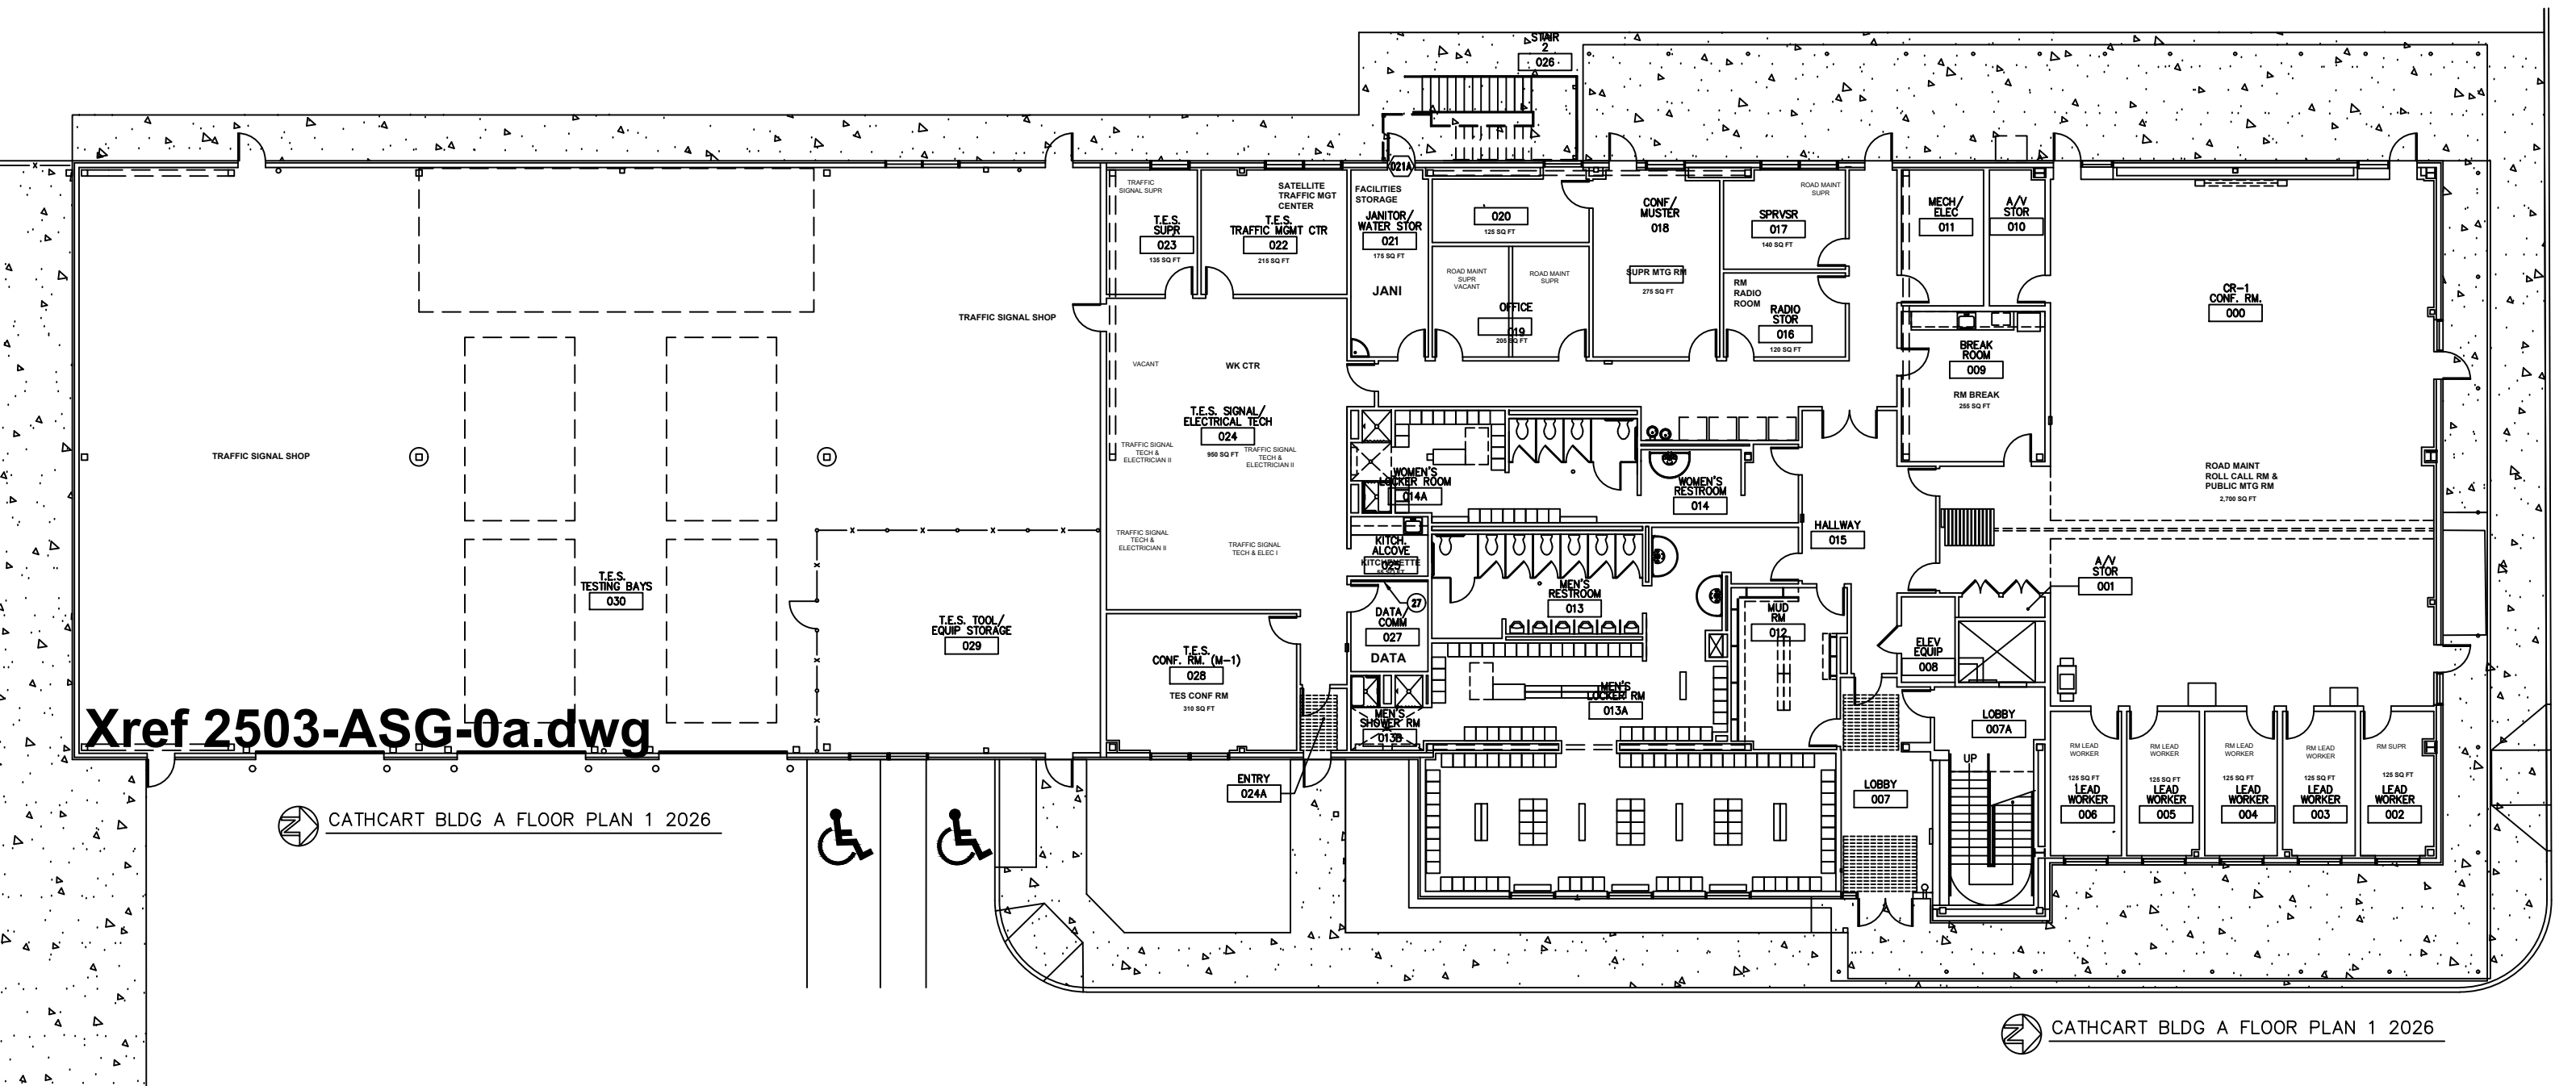

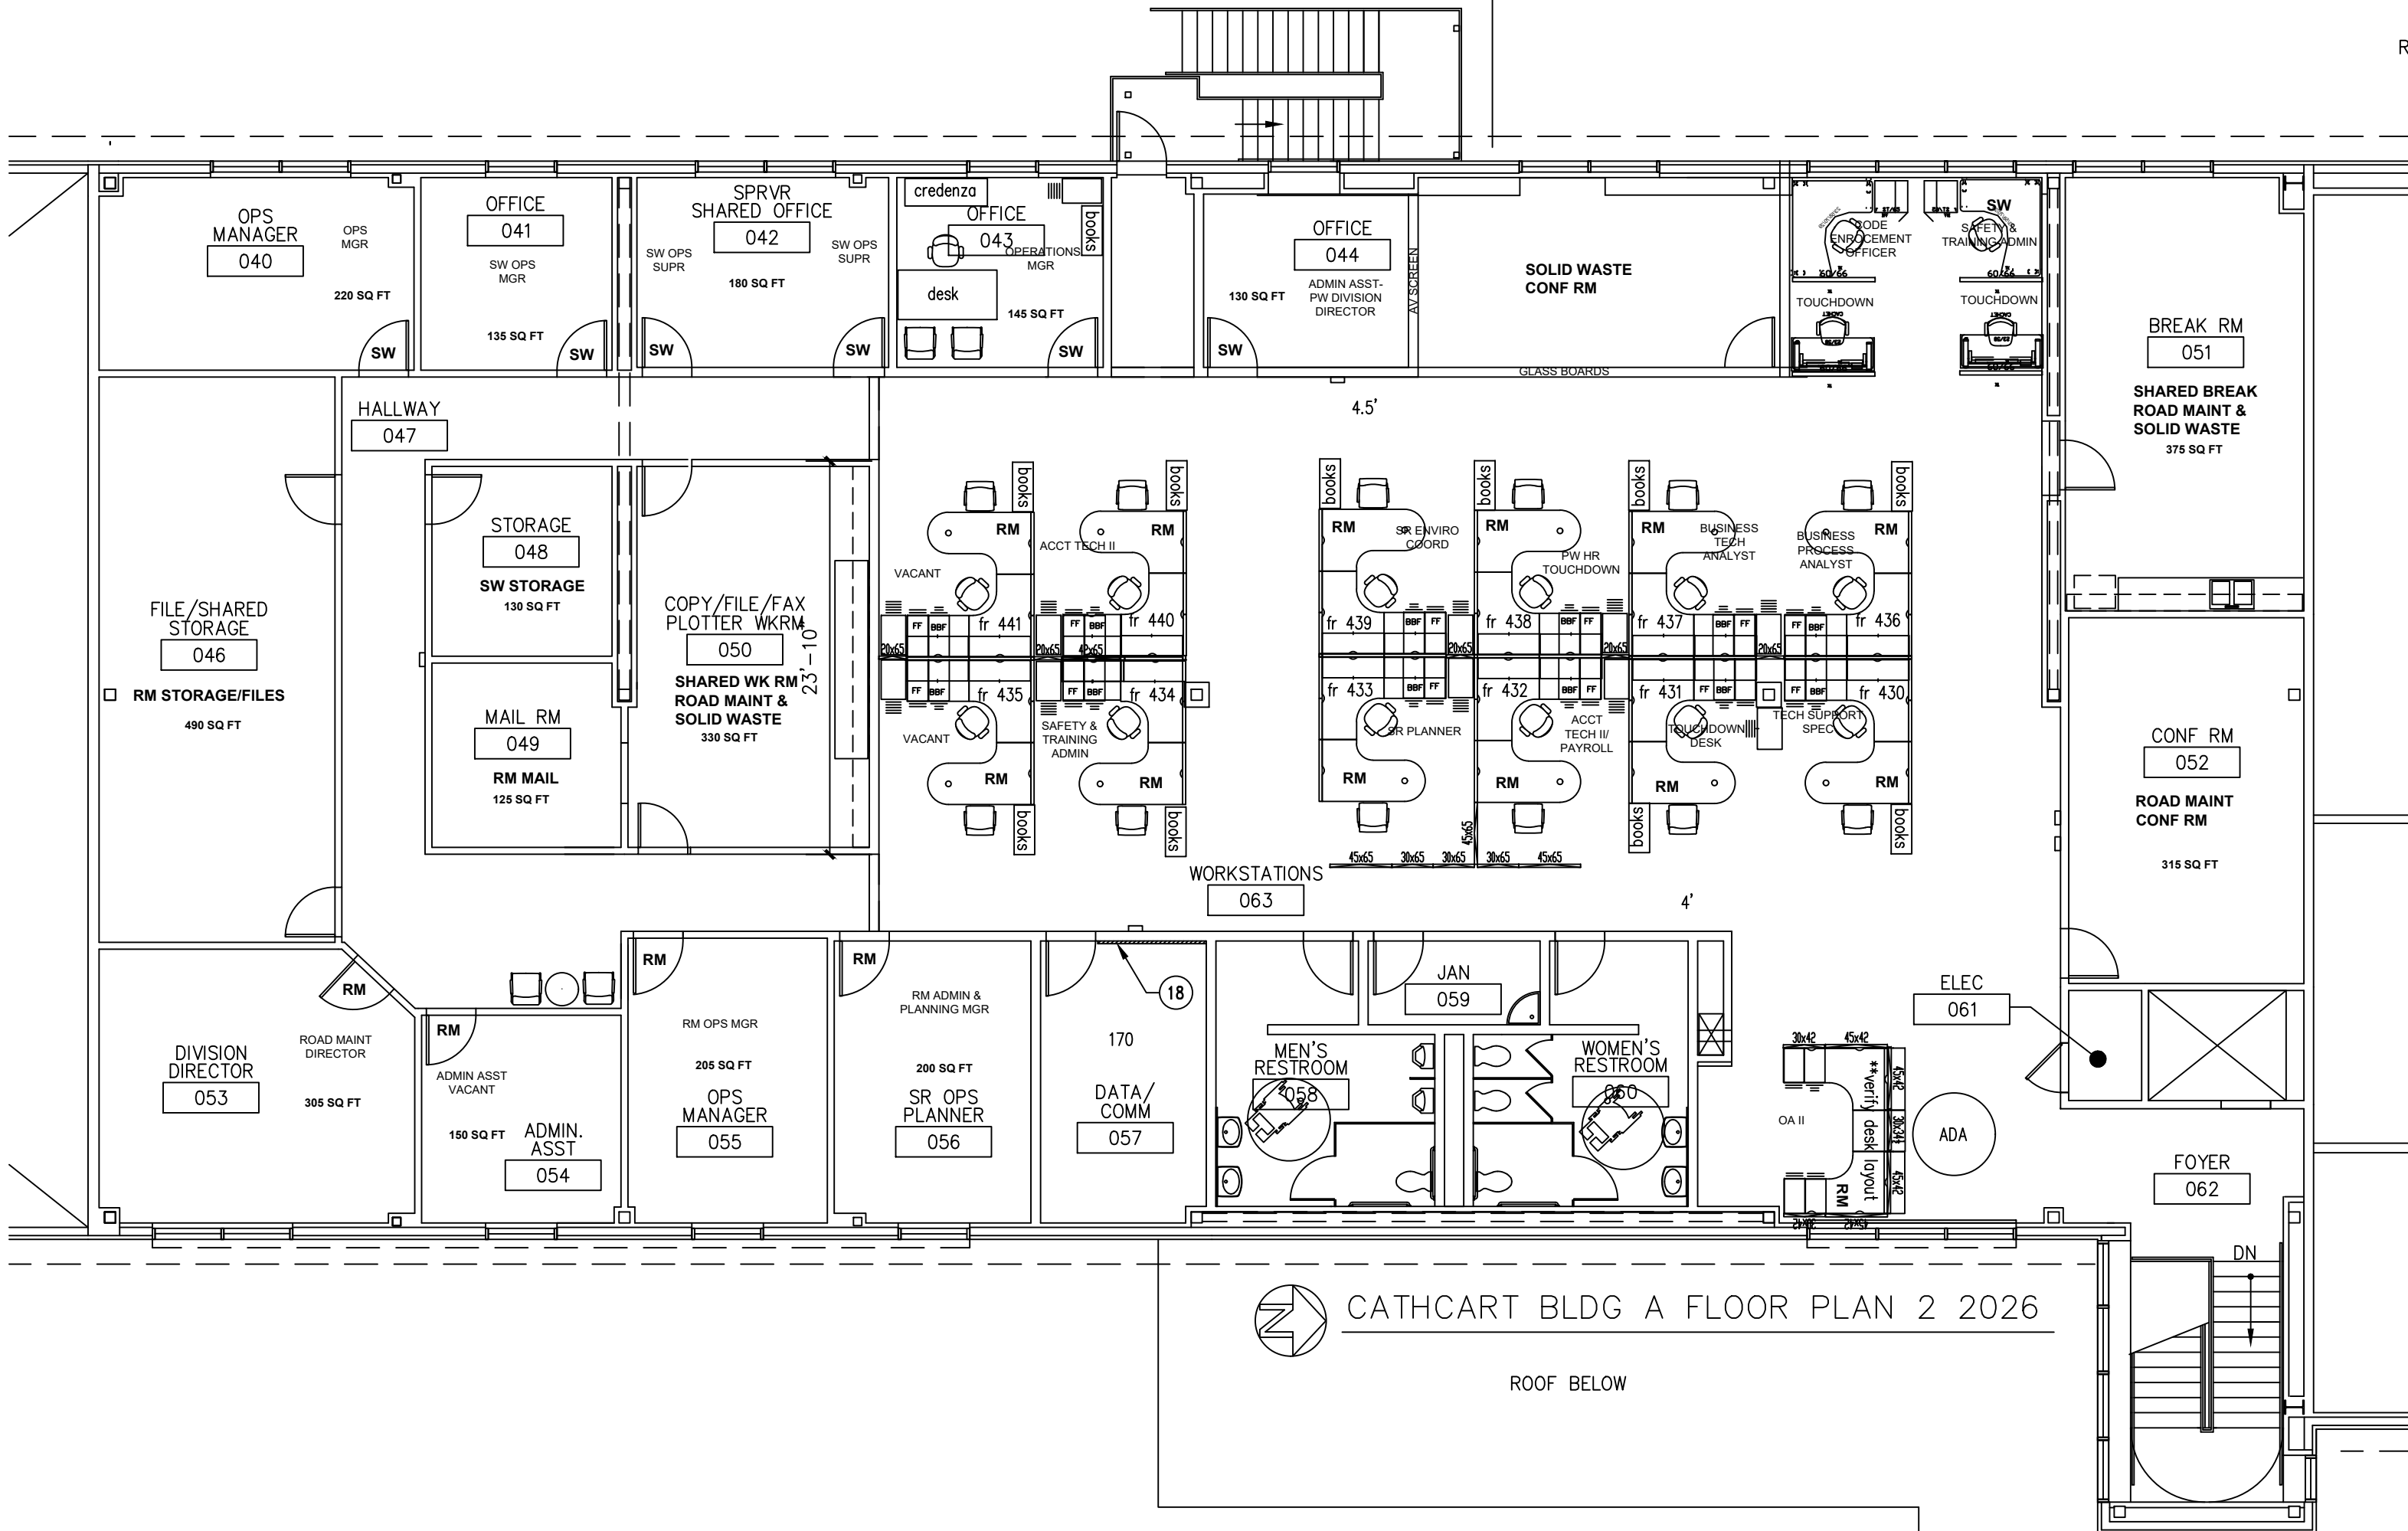


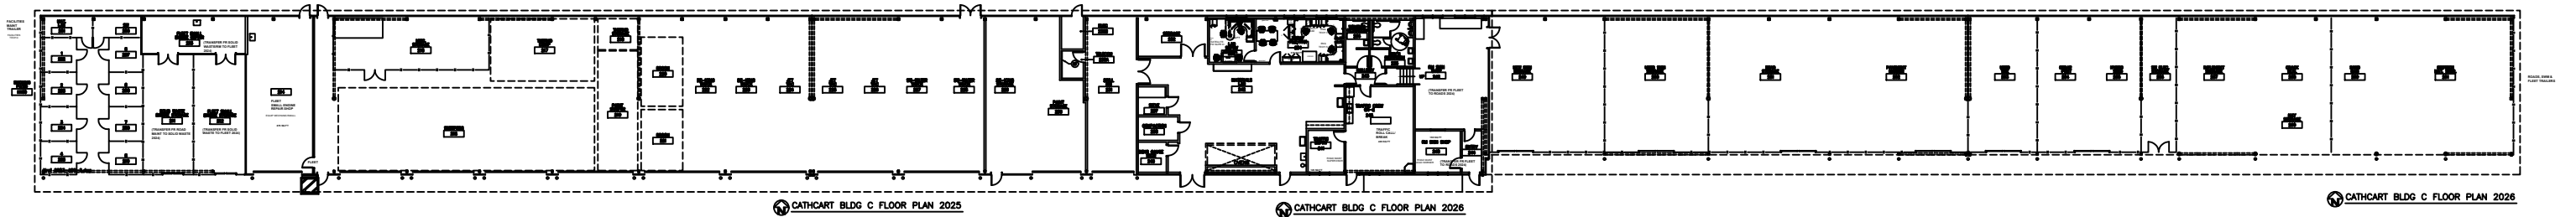

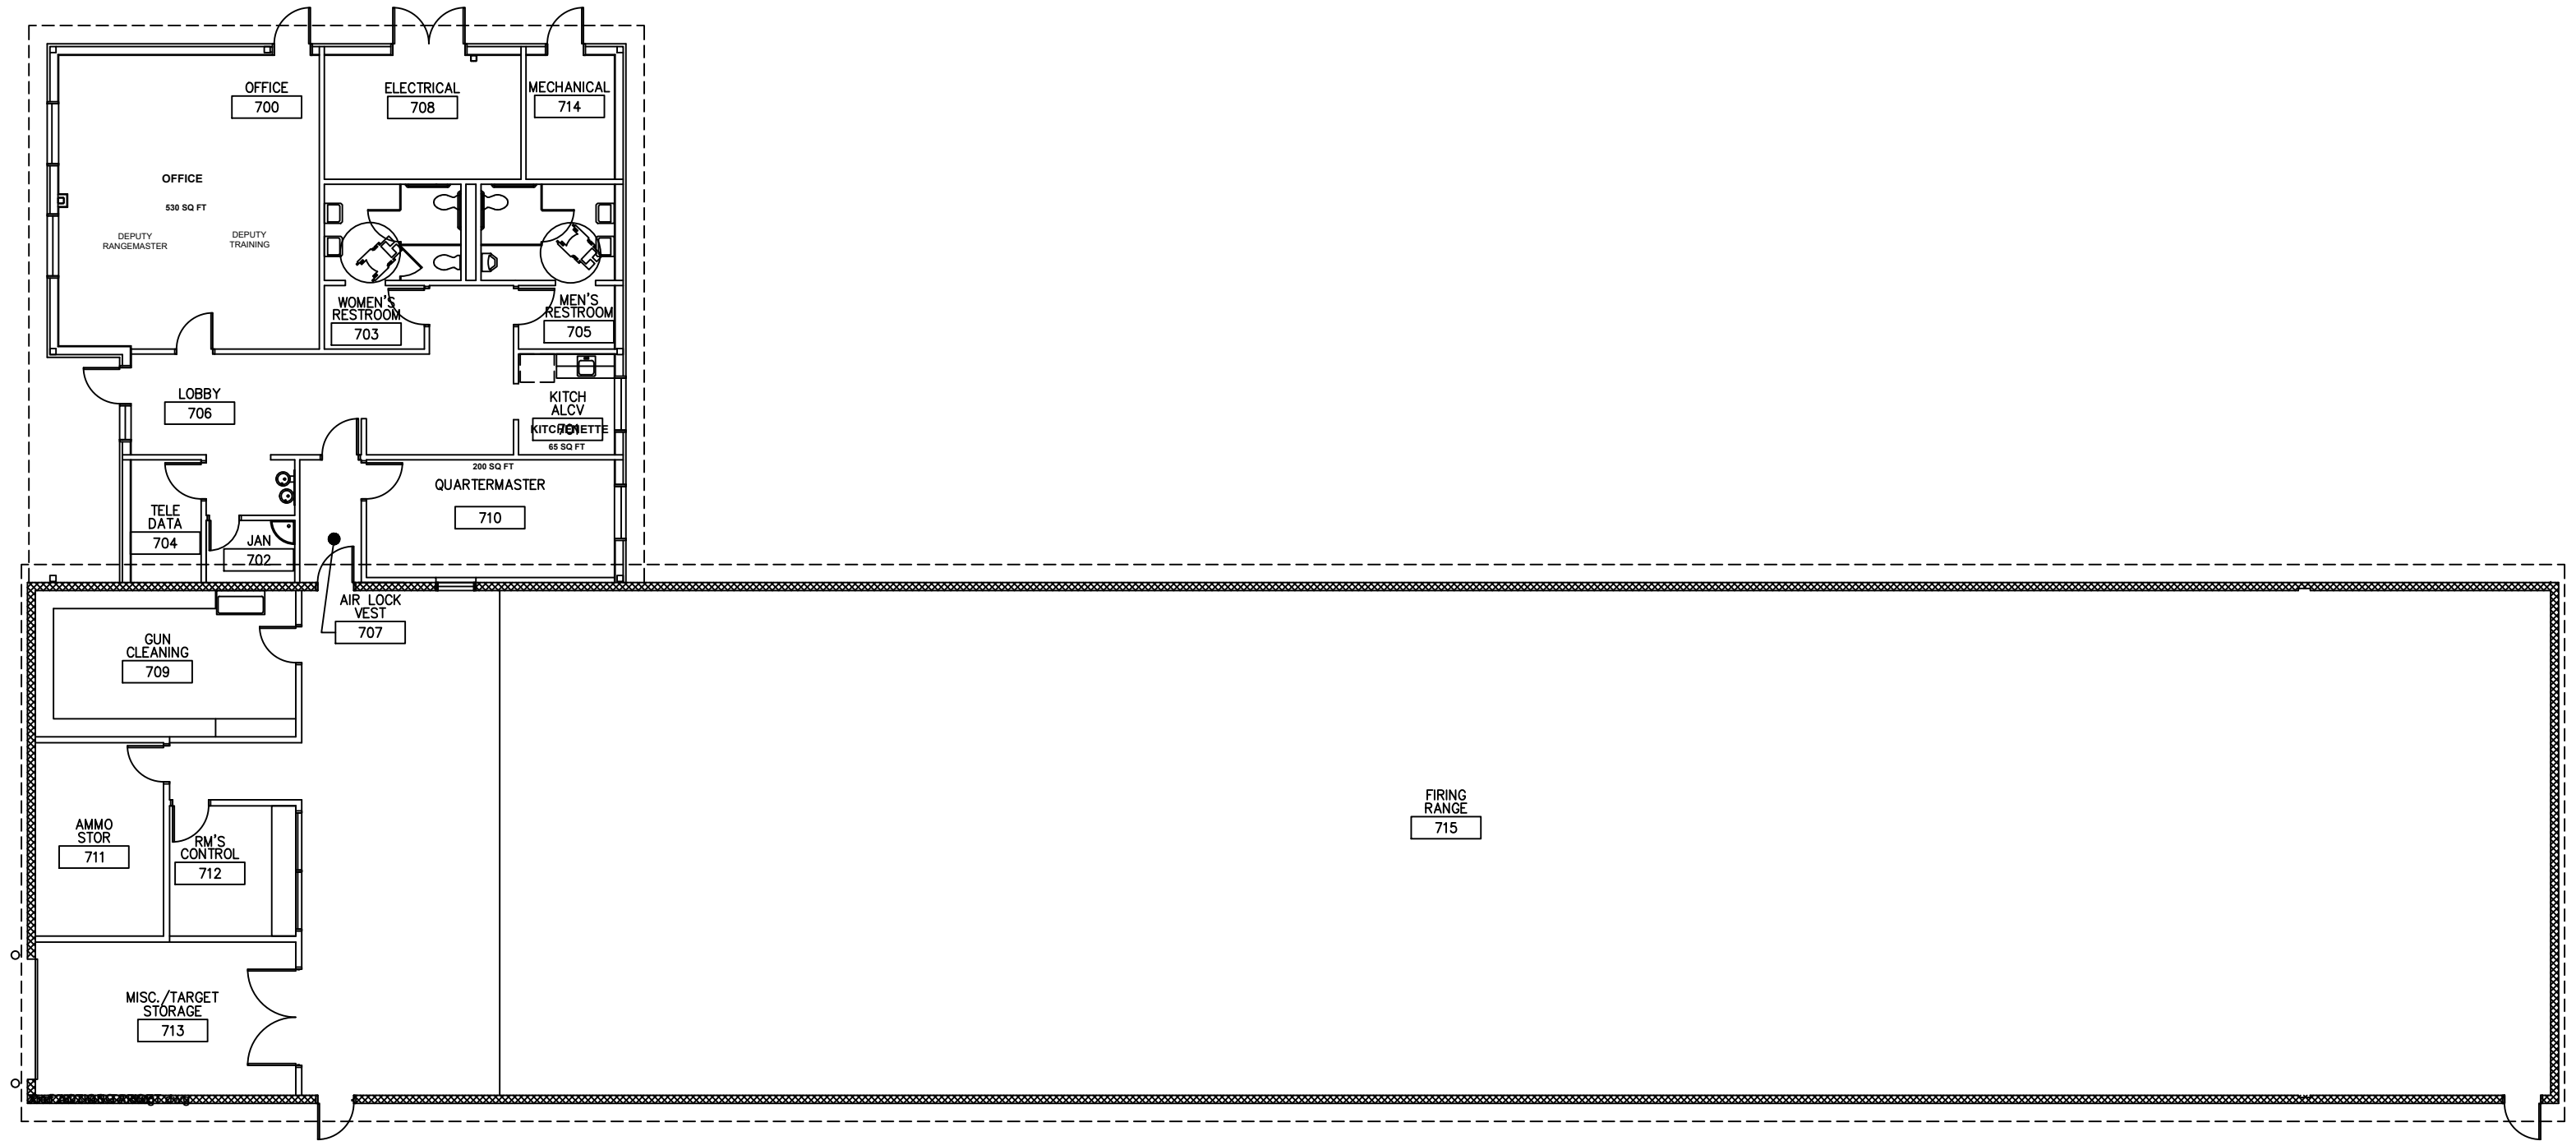



SOLID WASTE
WASTEWATER PRETREATMENT FACILITY
ESS - CATHCART BLDG K
(ENVIRONMENTAL SERVICES)
2026


ENVIRO MONITORING SUPR, SALIH
HYDRO-GEOLOGIST, EYCHESON
SCADA SYSTEMS ADMIN, DOTSON
ENVIRO SPEC SR, LAWLESS
ENVIRO SPEC IV, ARNOLD
ENVIRO SPEC I, BLOCK

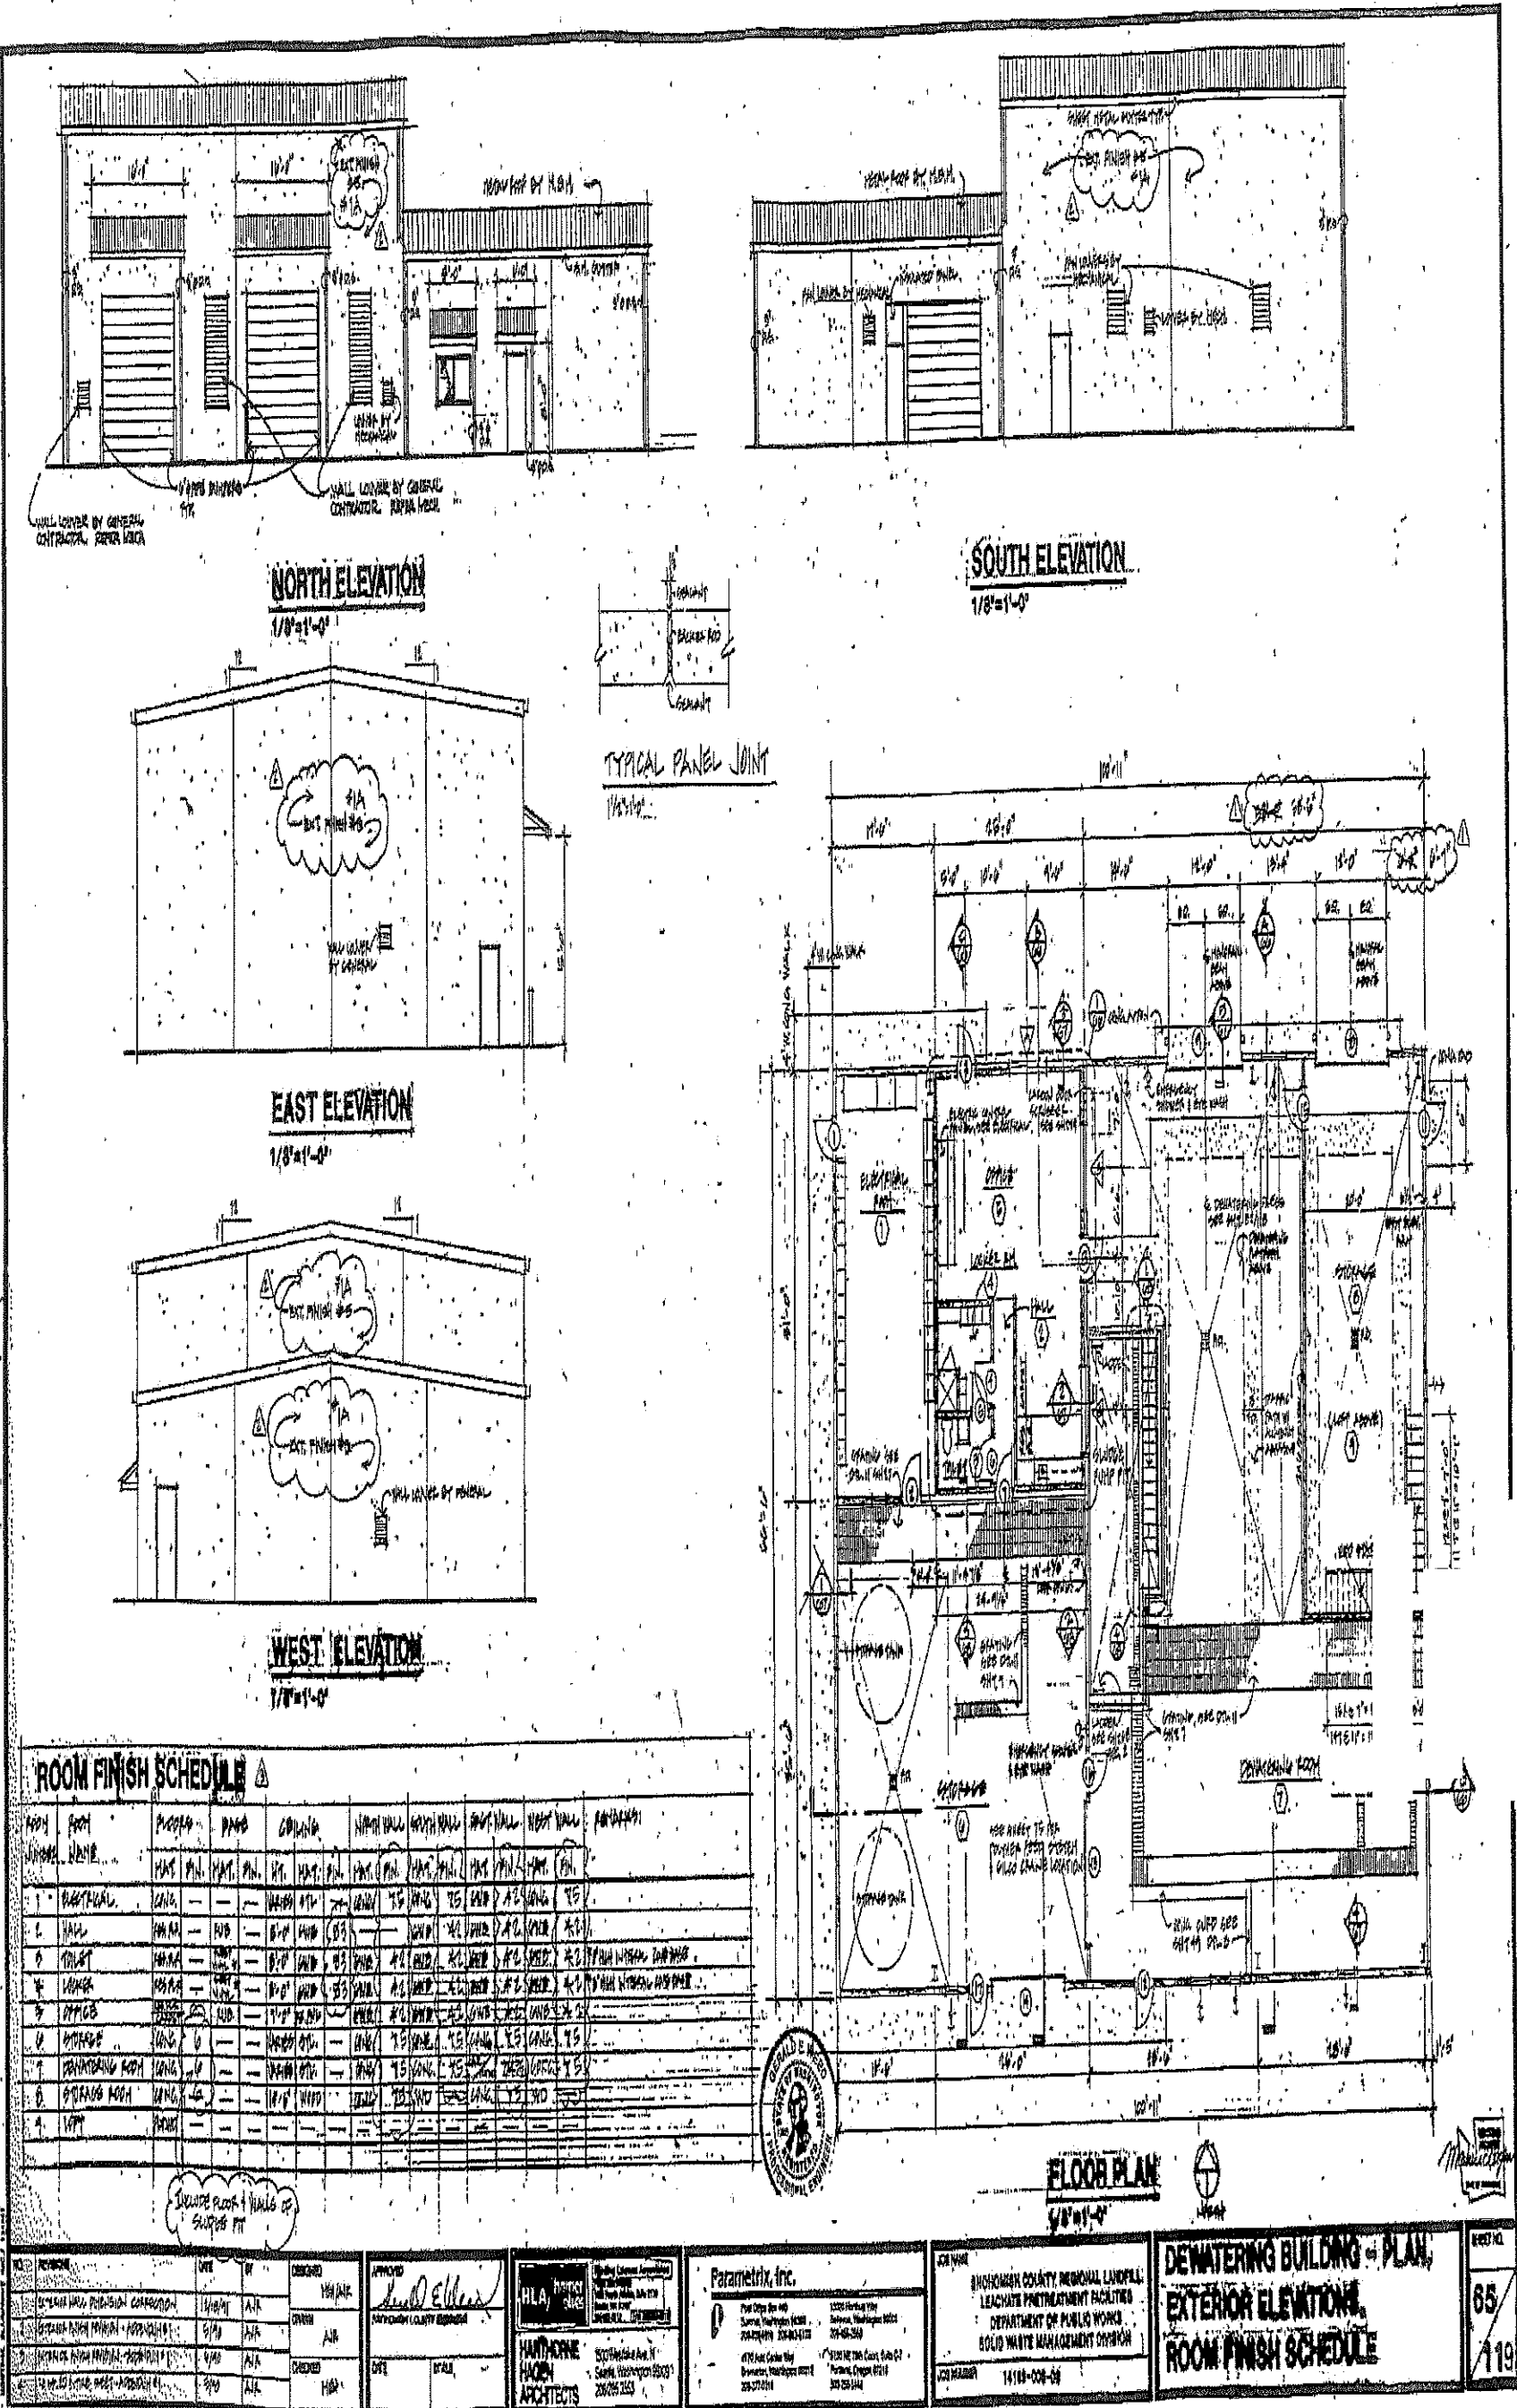

CATHCART SOLID WASTE BUILDING M

2026

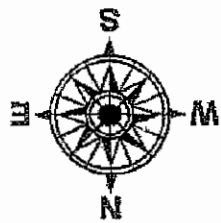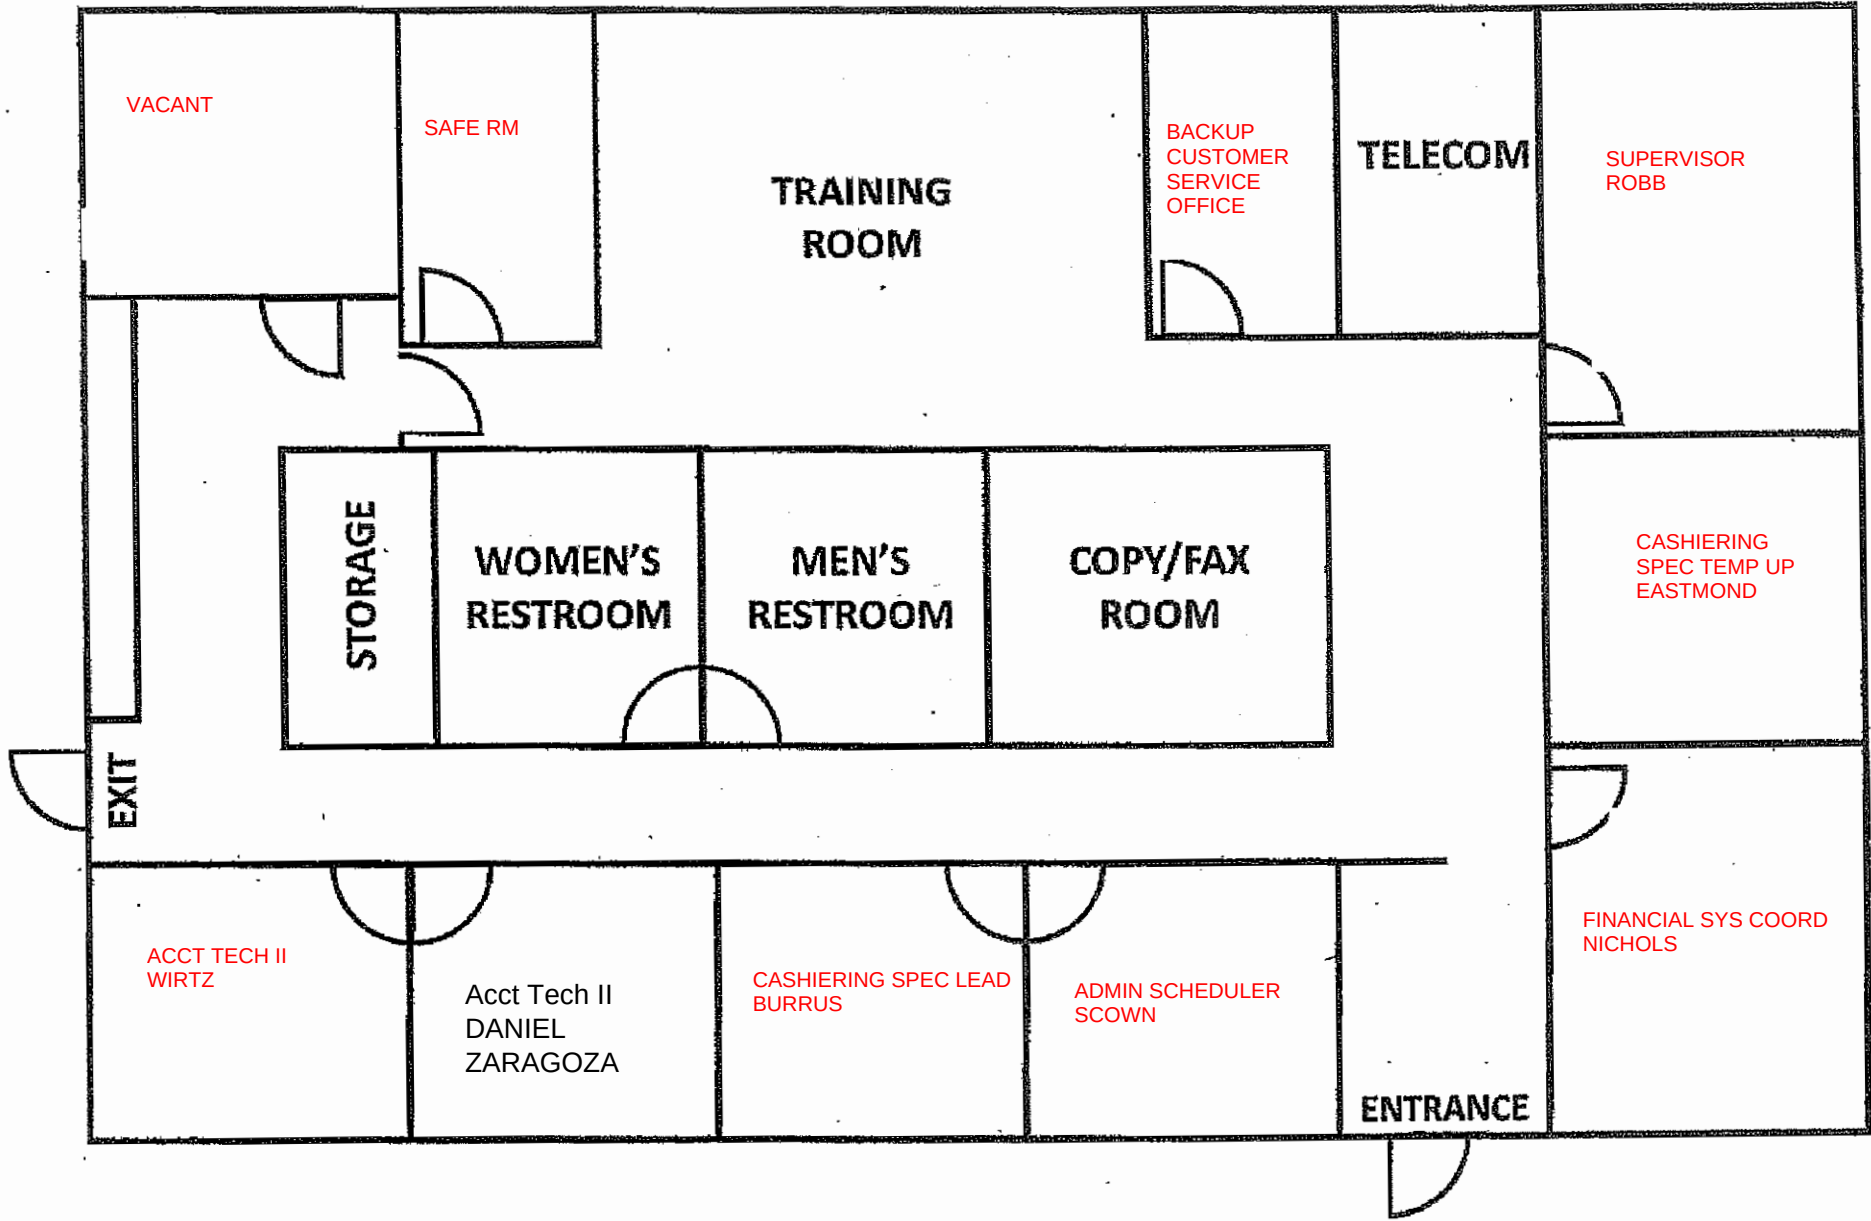

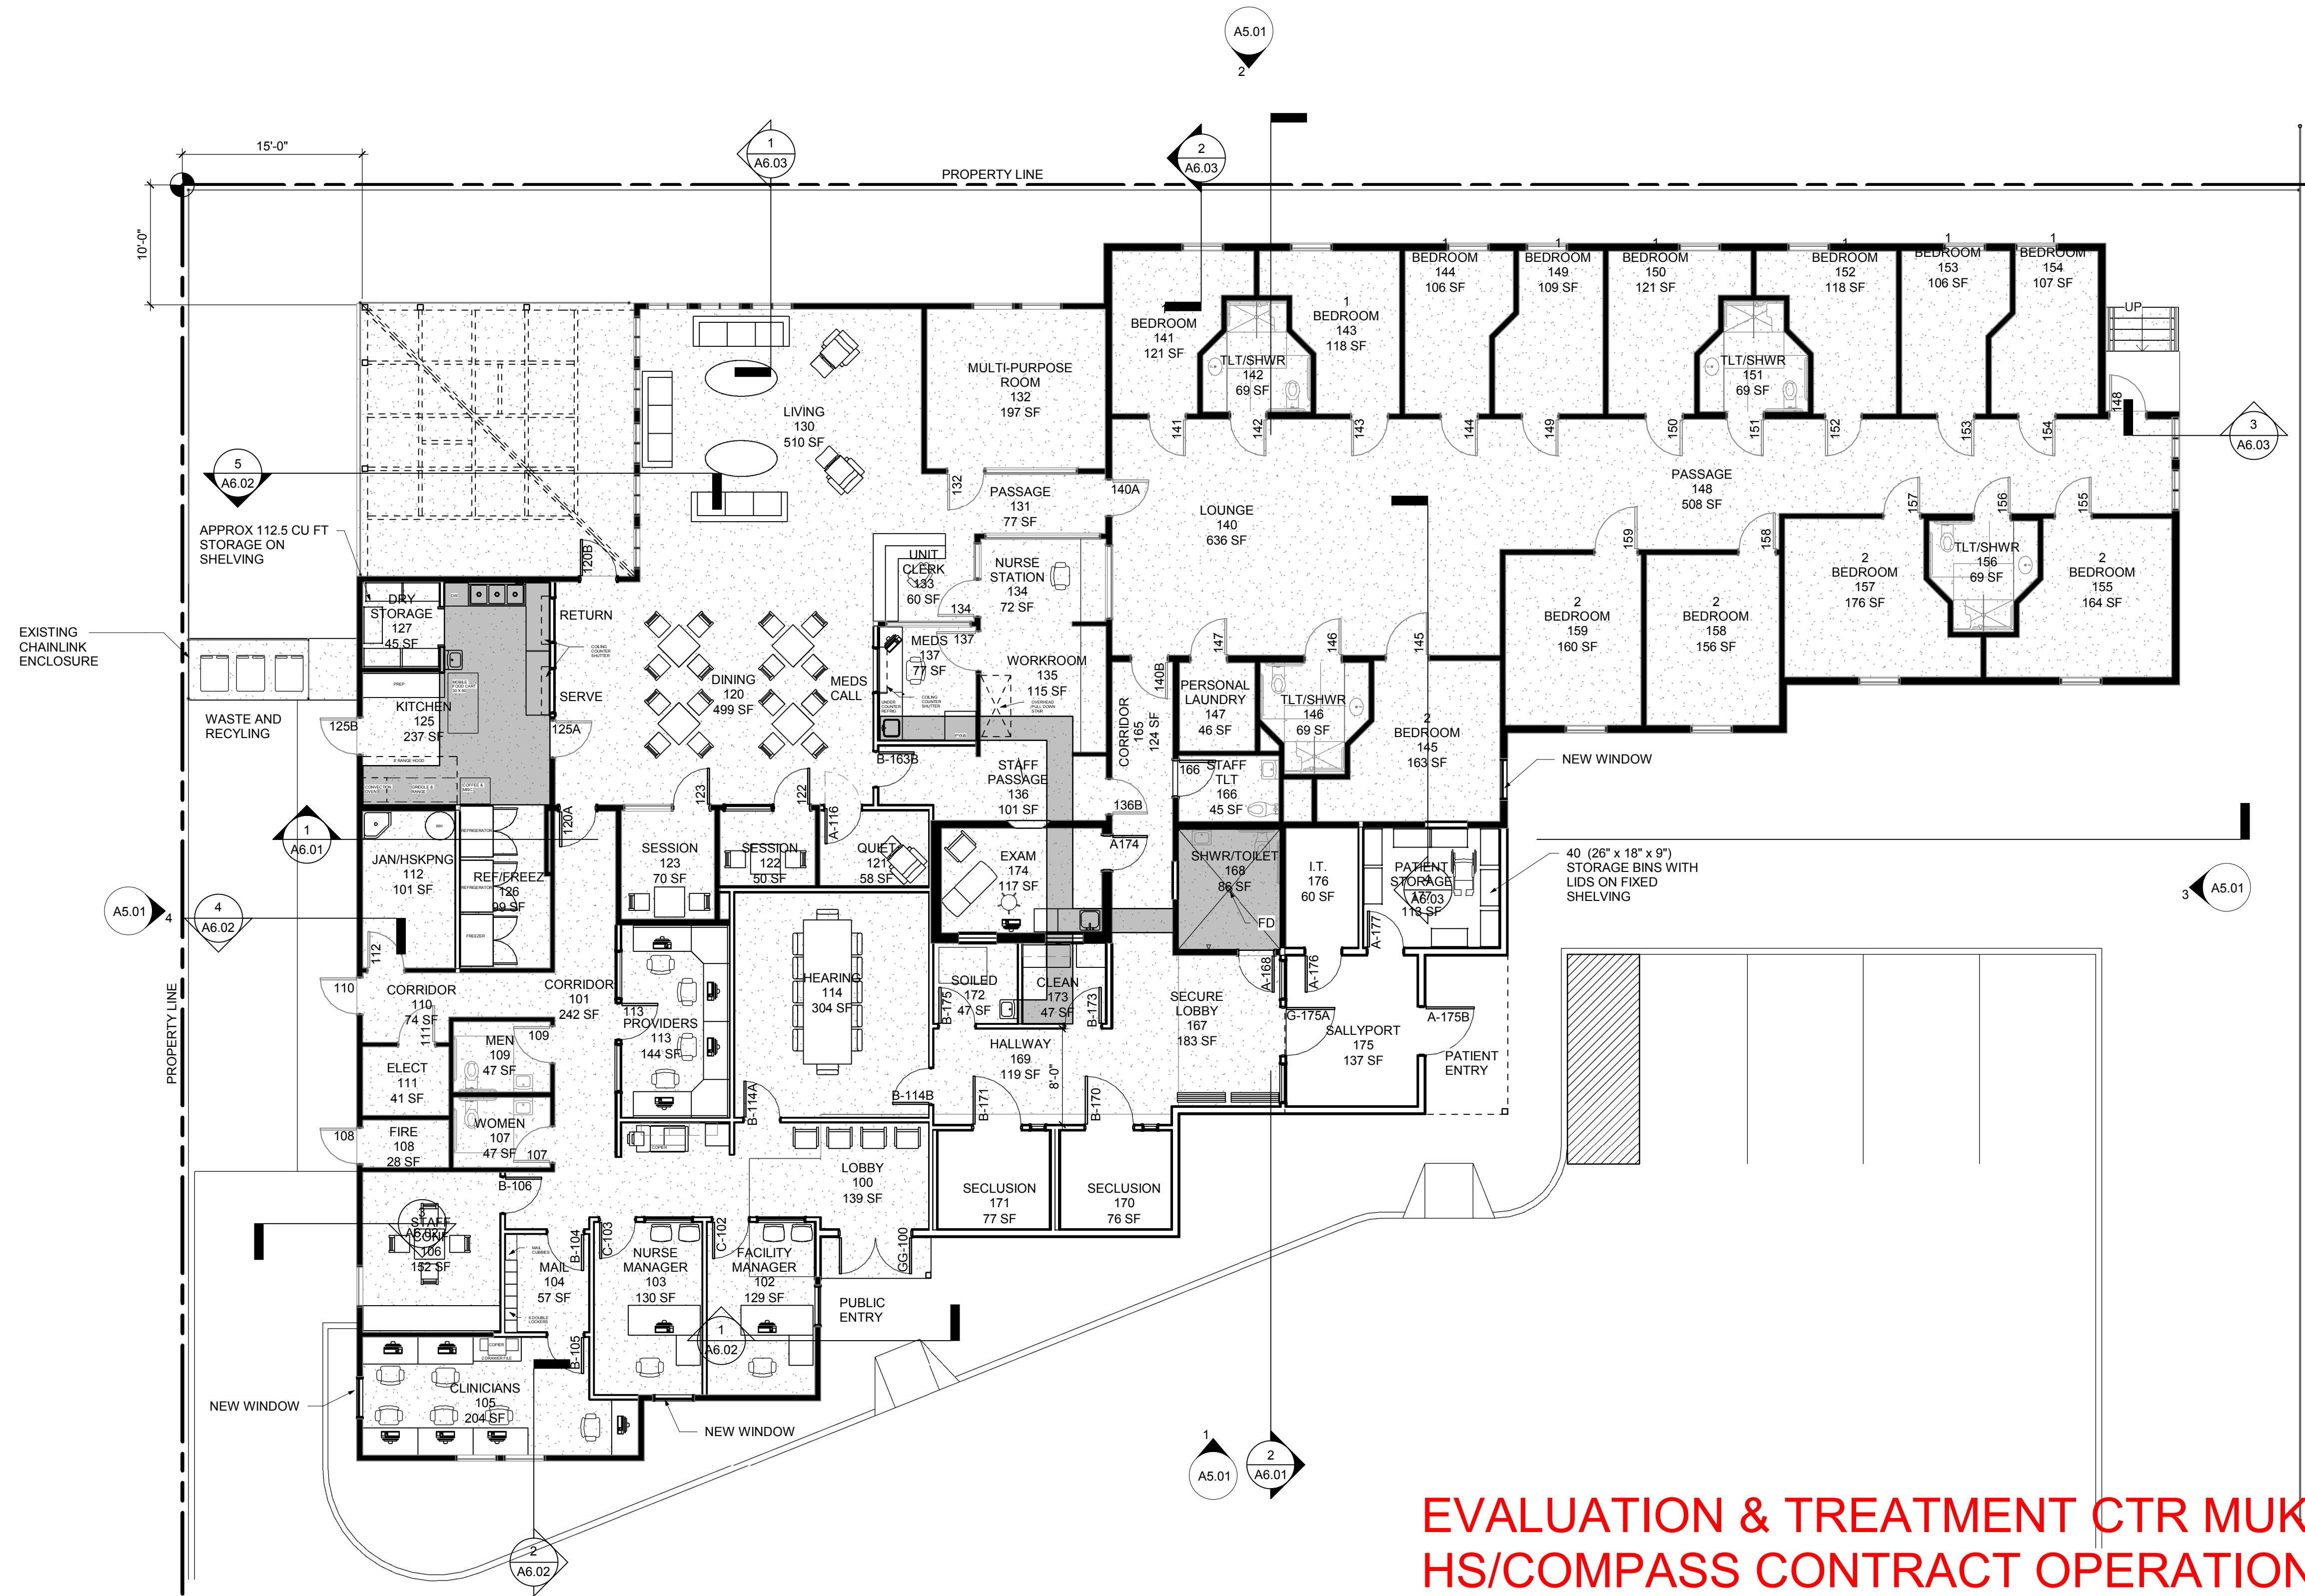

1 FLOOR PLAN - LEVEL 1

EVALUATION & TREATMENT CTR MUKILTEO
HS/COMPASS CONTRACT OPERATIONS
VACATE EARLY 2026 TO NEW BROADWAY
FACILITY

GENERAL NOTES

PLAN LEGEND

- EXISTING WALL TO REMAIN
- NEW GYPSUM BOARD WALL ASSEMBLY
- CONCRETE REMOVED AND REPLACED FOR NEW PLUMBING WASTE LINES AND/OR FLOOR DRAINS

NO.	DESCRIPTION	DATE



417 montgomery street
suite 200
san francisco, ca 94104
t 415.398.5191
kmdarchitects.com

SNOHOMISH
COUNTY

SNOHOMISH COUNTY
E & T

10710 MUKILTEO SPEEDWAY
MUKILTEO, WA 98275

BUILDING

PROJECT NO. 468-205


DRAWN BY 12/3/18

DATE 12/3/18

SCALE As indicated

TITLE FLOOR PLAN - LEVEL 1

NUMBER A2.01

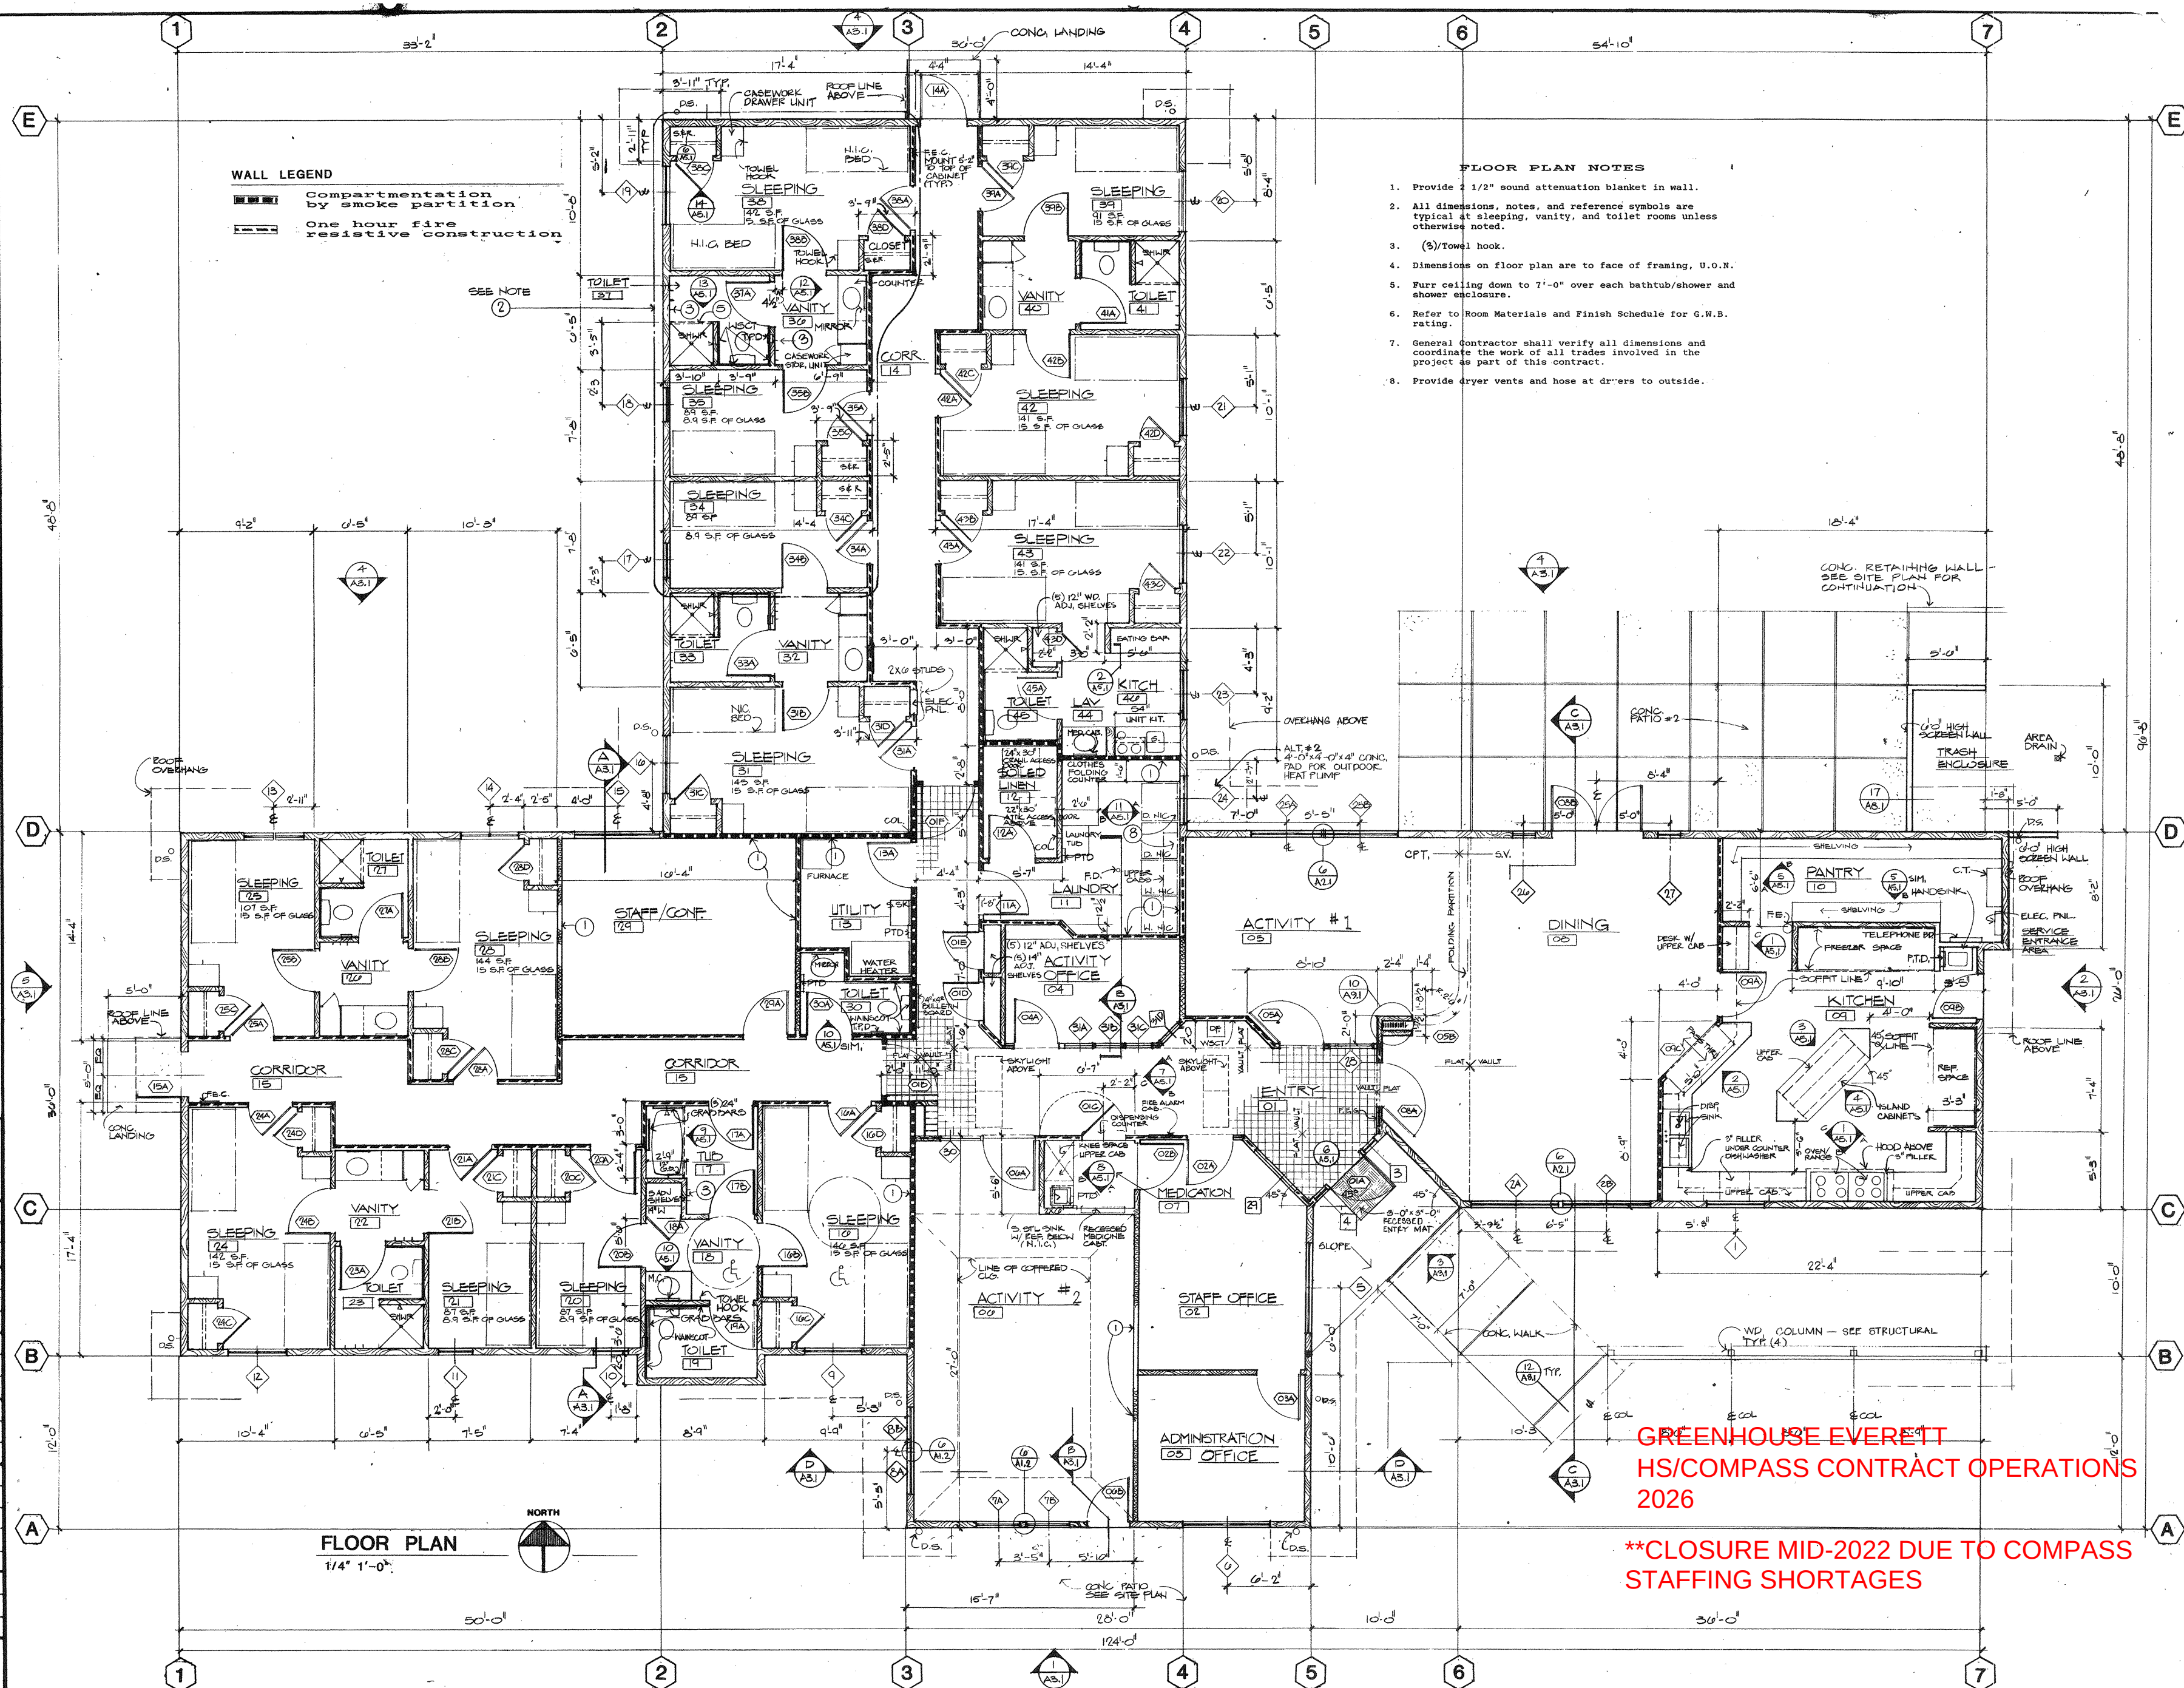

AN ADULT RESIDENTIAL REHABILITATION CENTER
Mental Health Services, Inc. /
Everett Housing Authority

dykeman, ogden,
aldrige & quintonarchitects p.s.
washington 98201 206 259-3161

revisions:	
drwn:	
chkd:	MSF
date:	11-11-86


85-081

A2.2

of 18 sheets


GREENHOUSE EVERETT
HS/COMPASS CONTRACT OPERATIONS
2026


****CLOSURE MID-2022 DUE TO COMPASS STAFFING SHORTAGES**

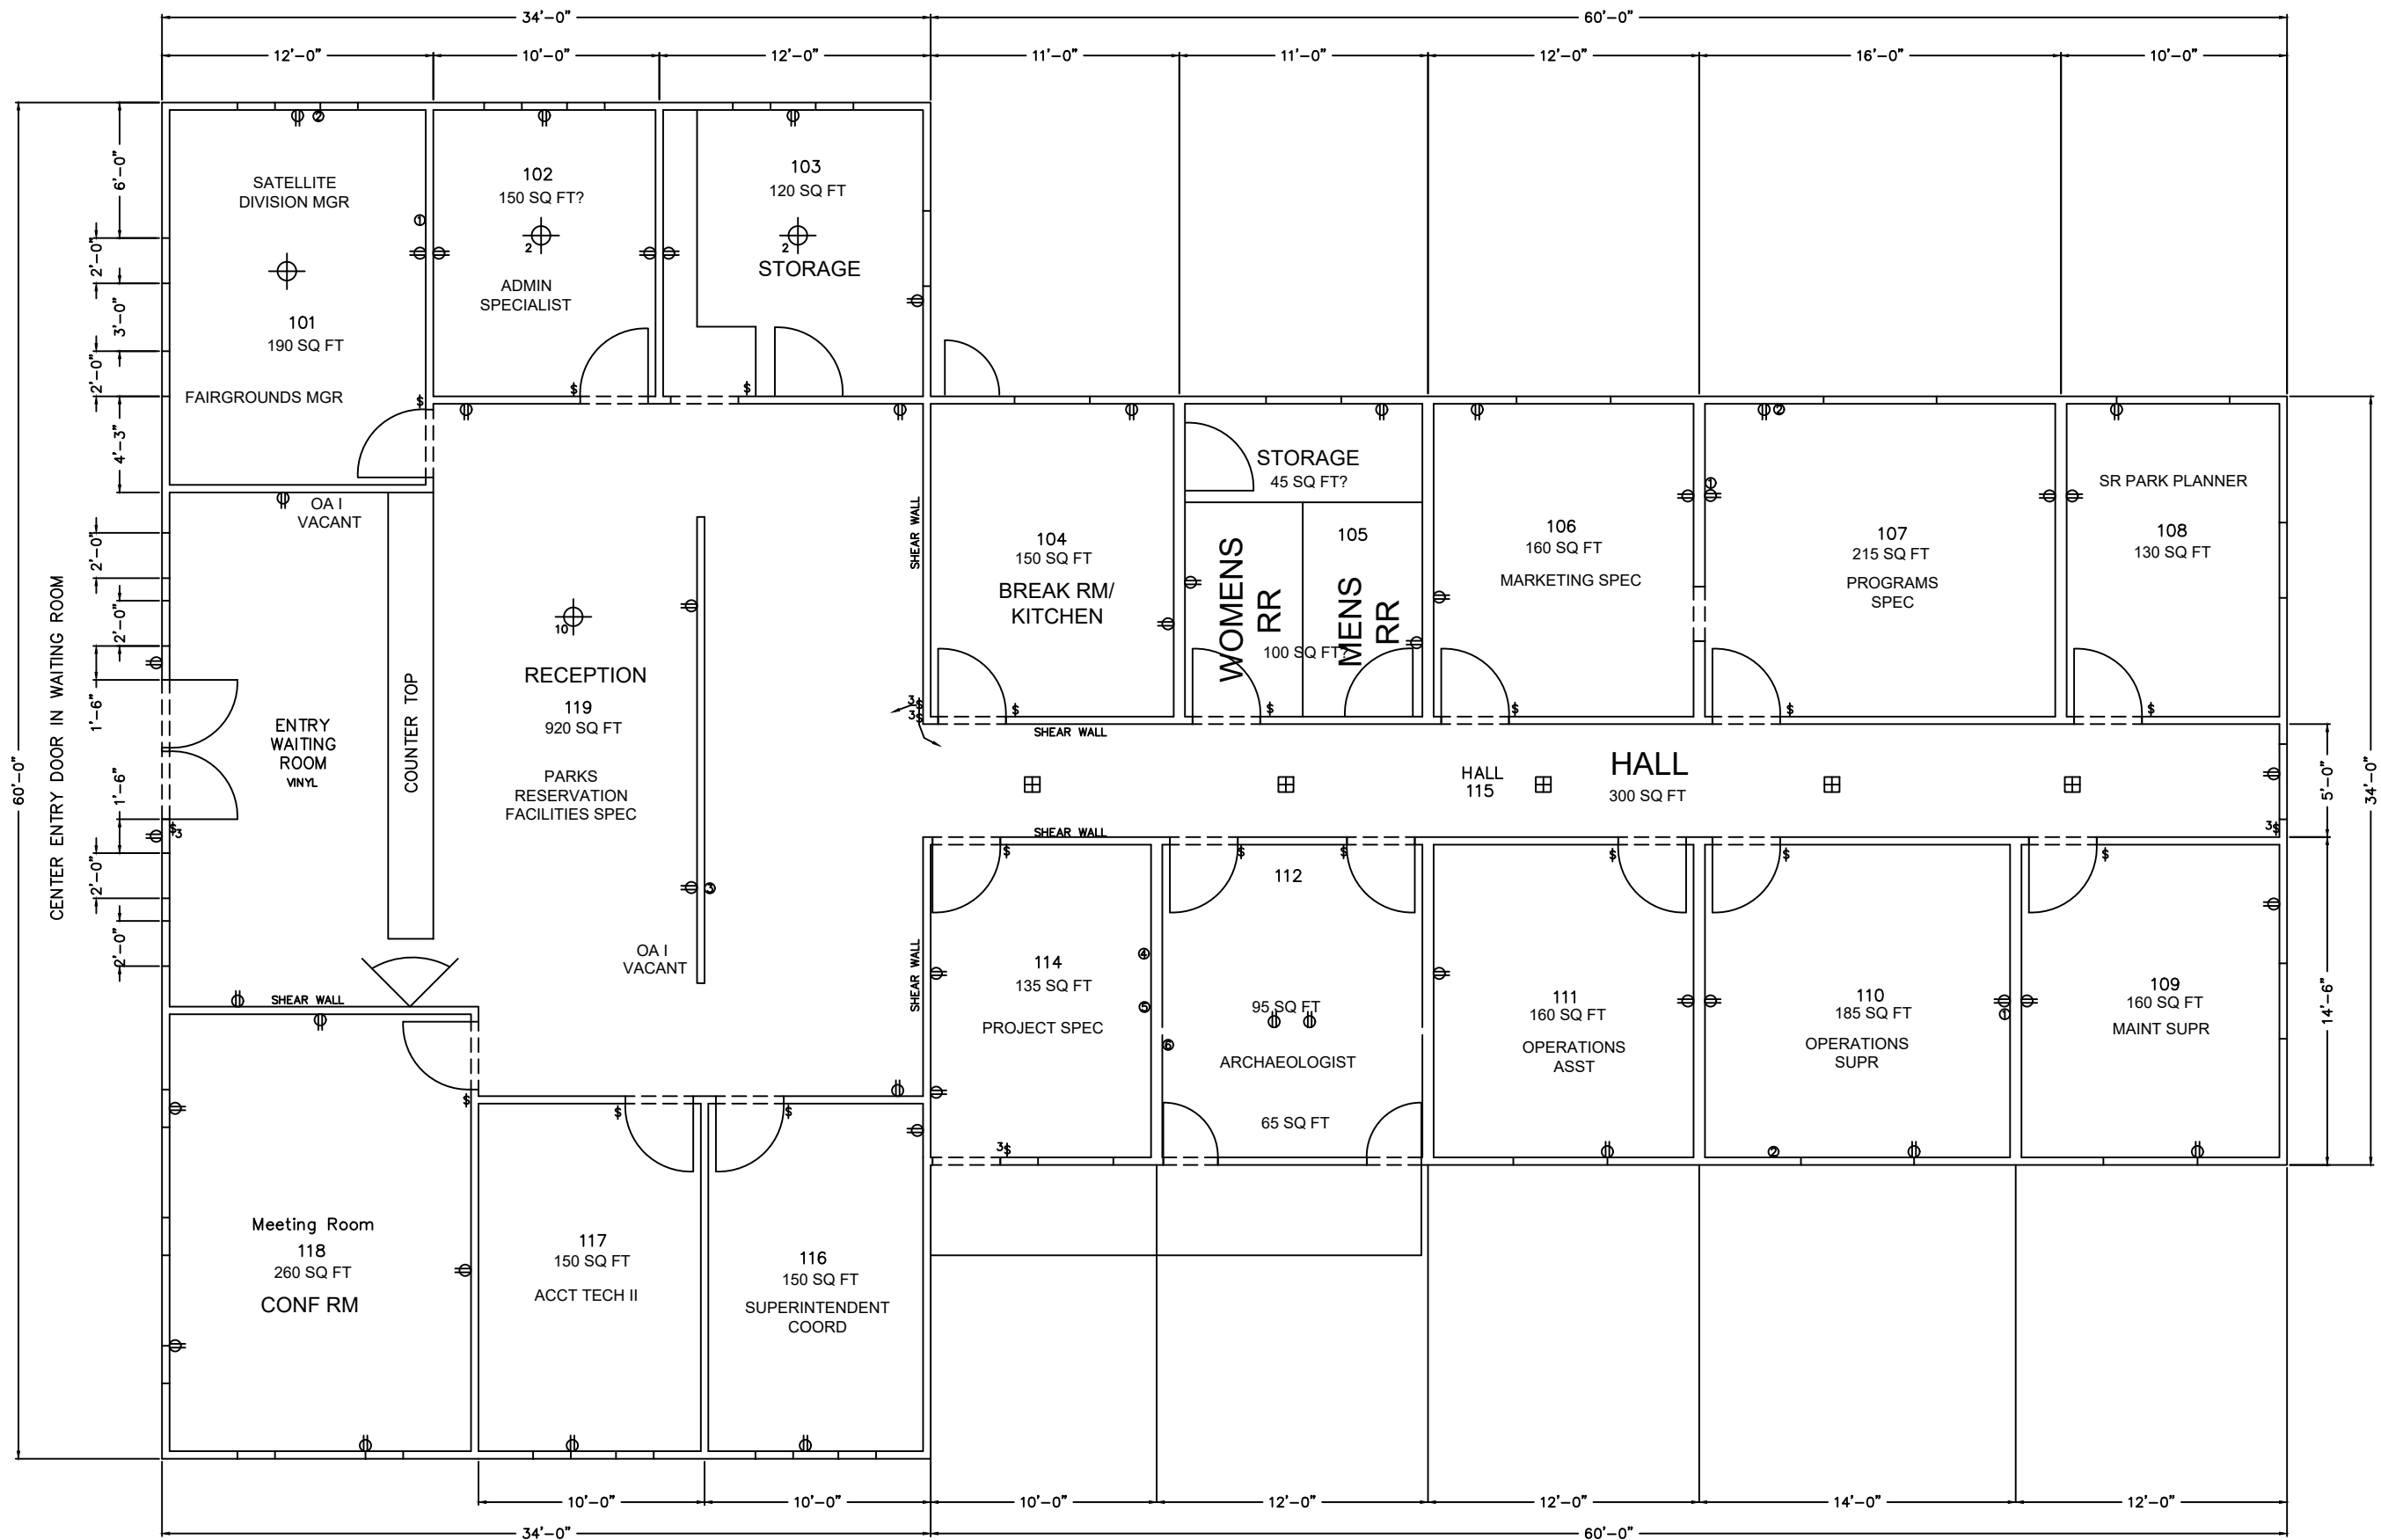


EVERGREEN STATE FAIRGROUNDS ADMINISTRATION BLDG FLOOR PLAN 2026 (A2)
 SCALE 1/8" = 1'-0"


DCNR MONROE
FAIRGROUNDS MAINTENANCE
2026

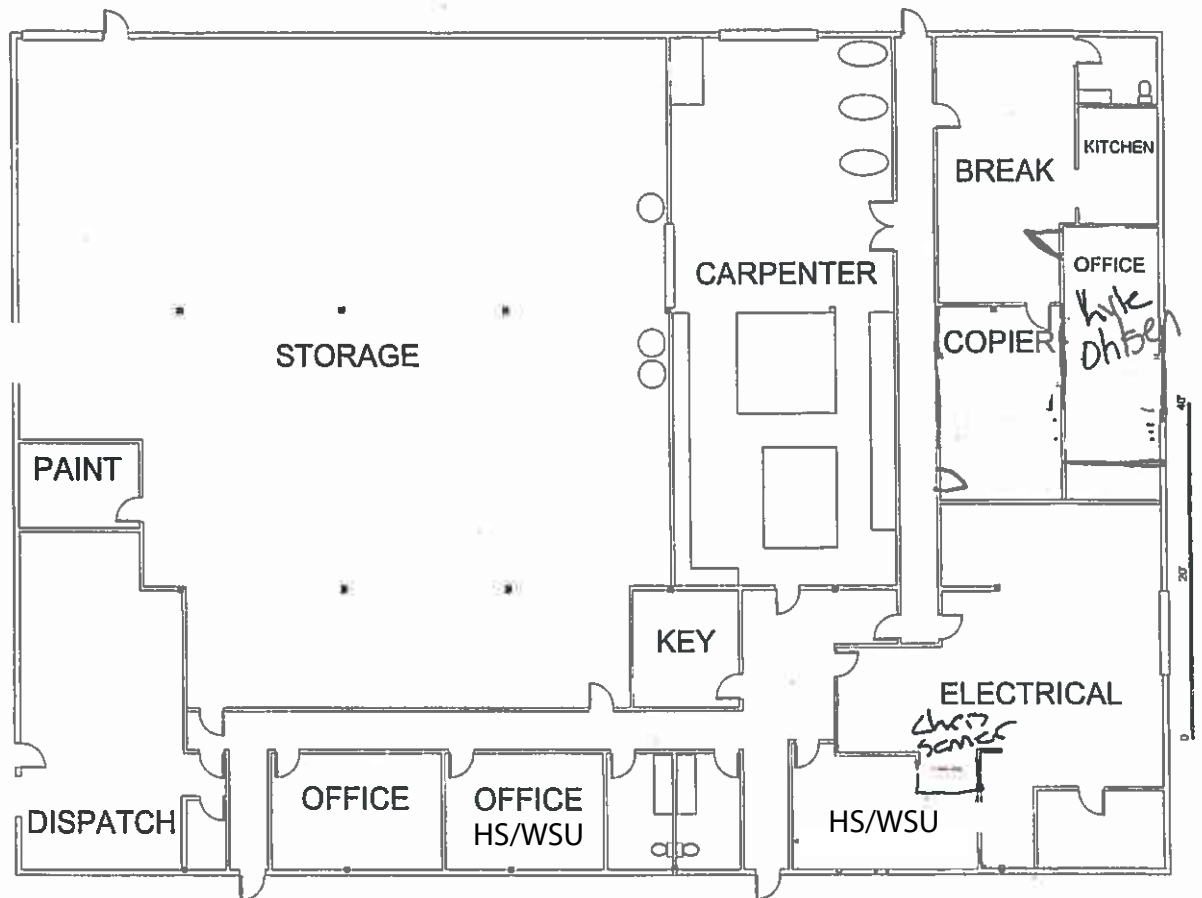


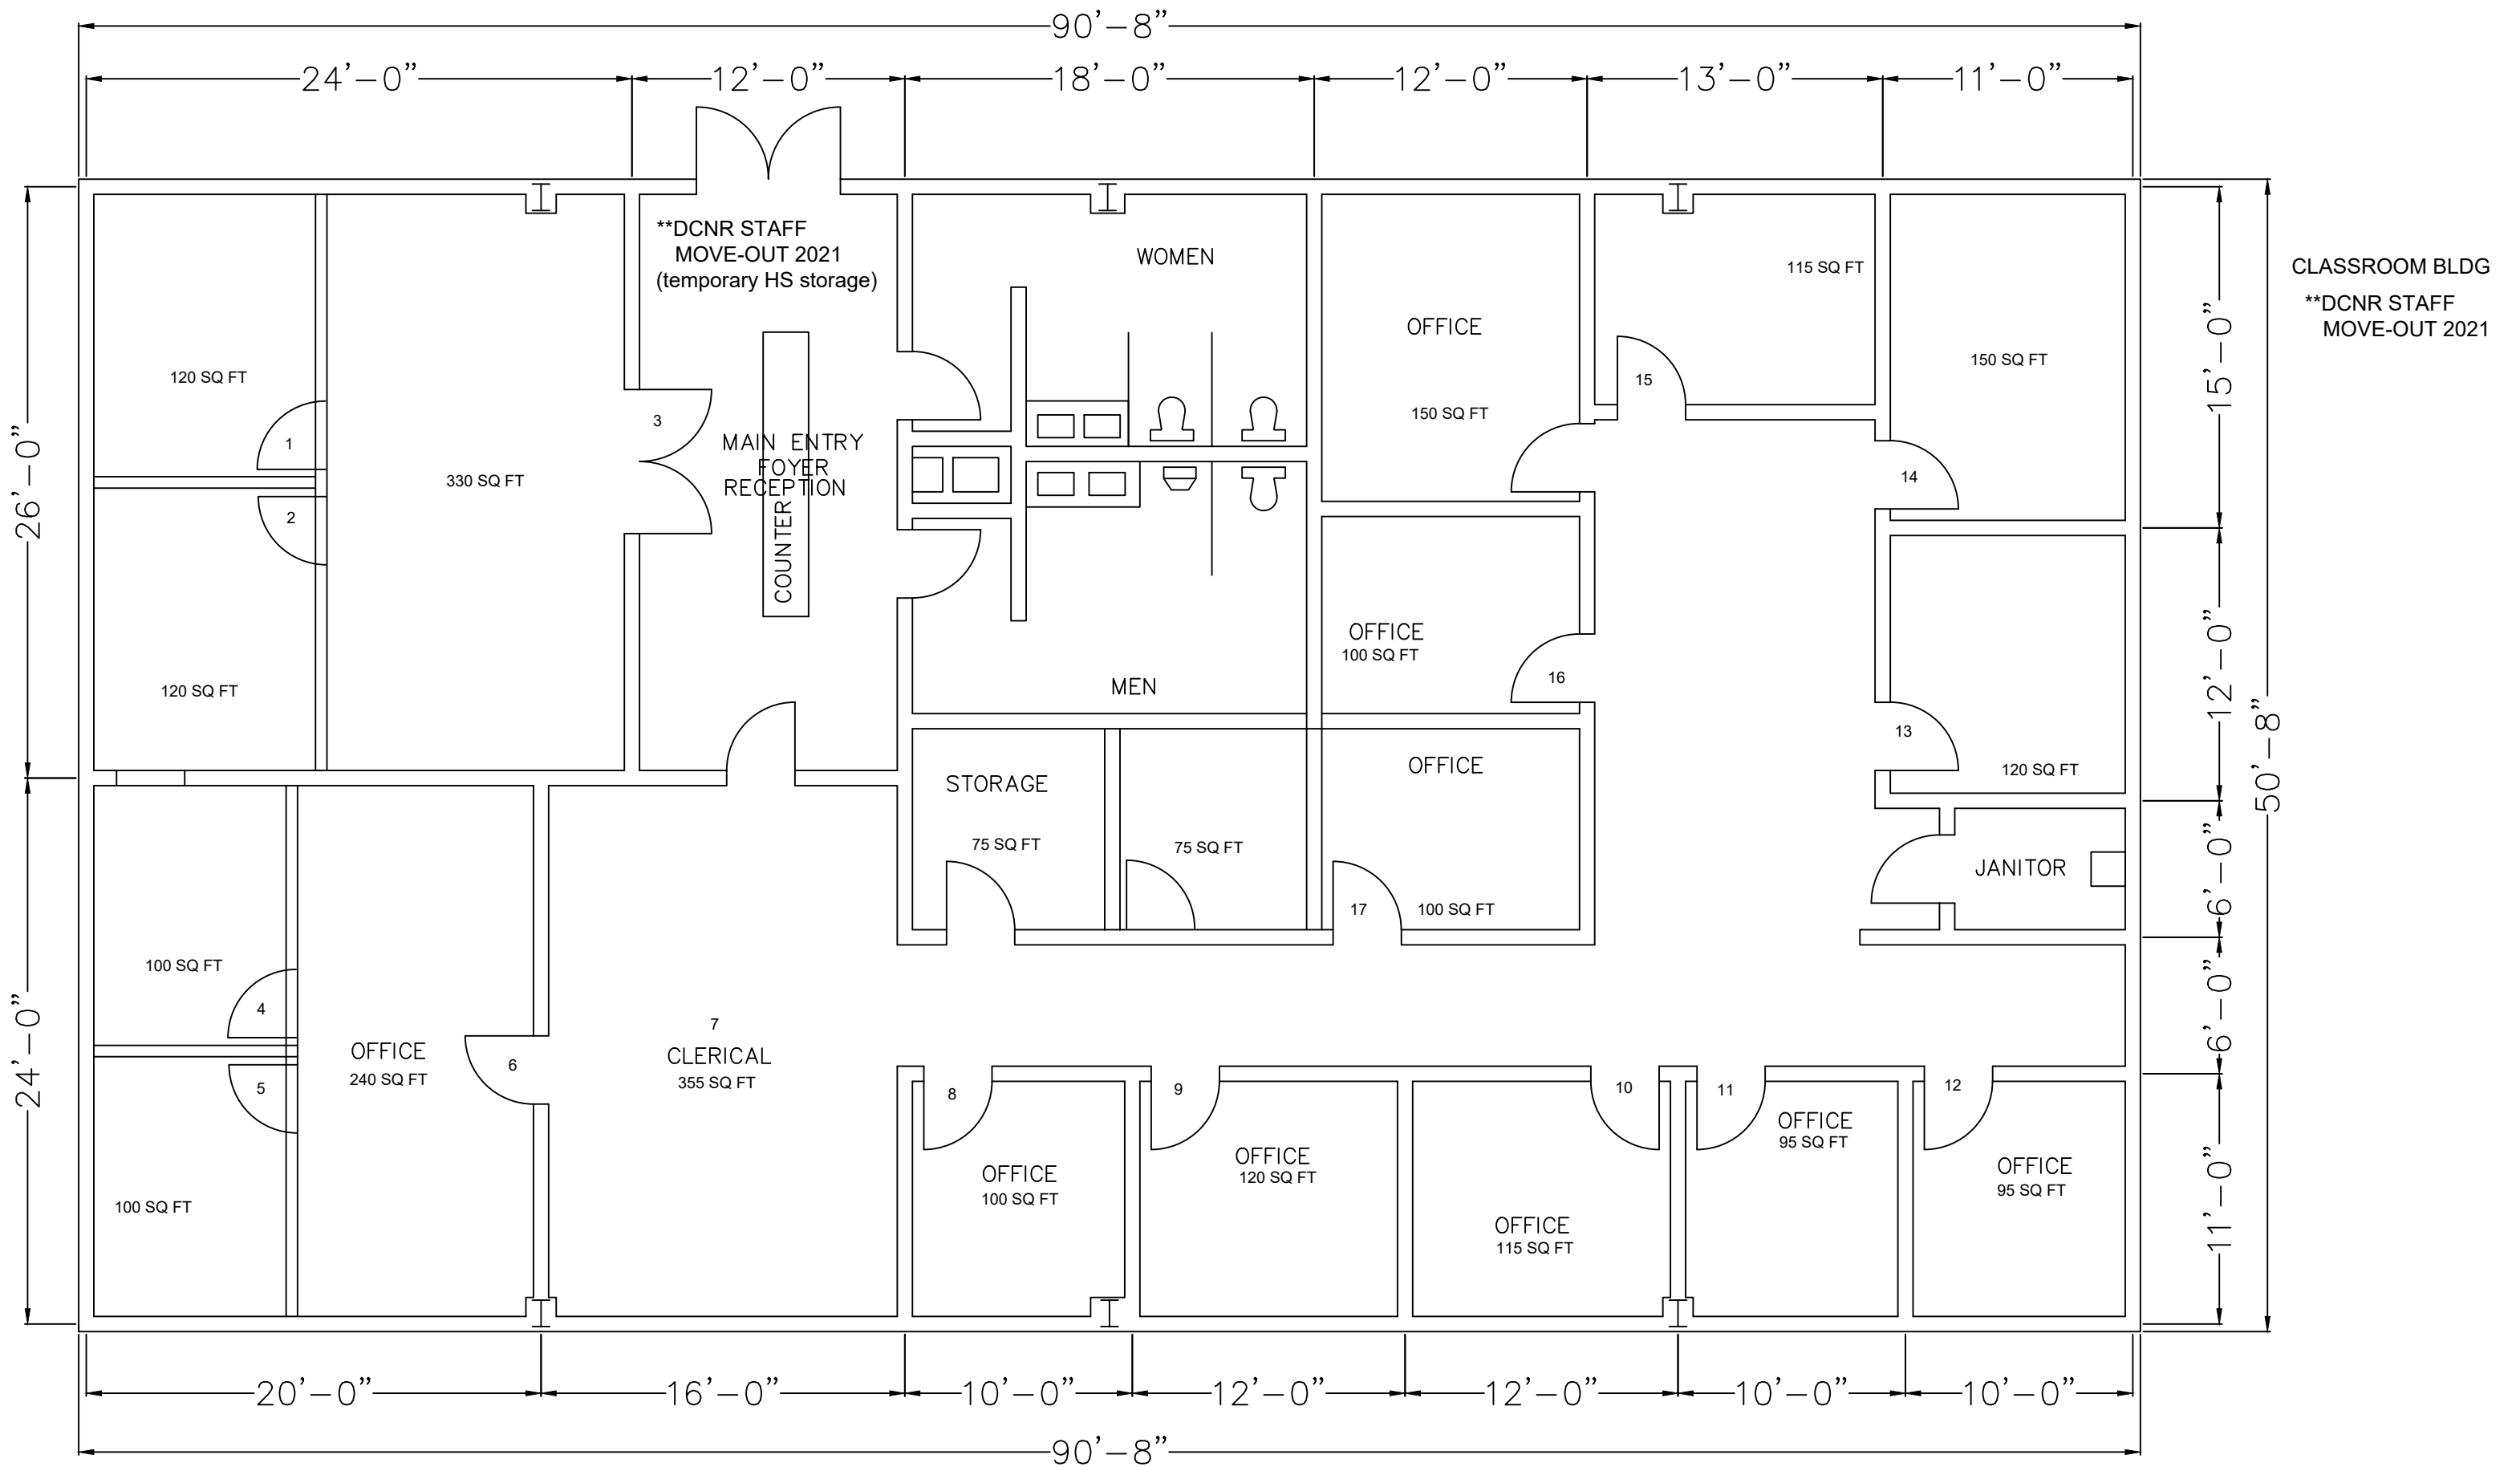

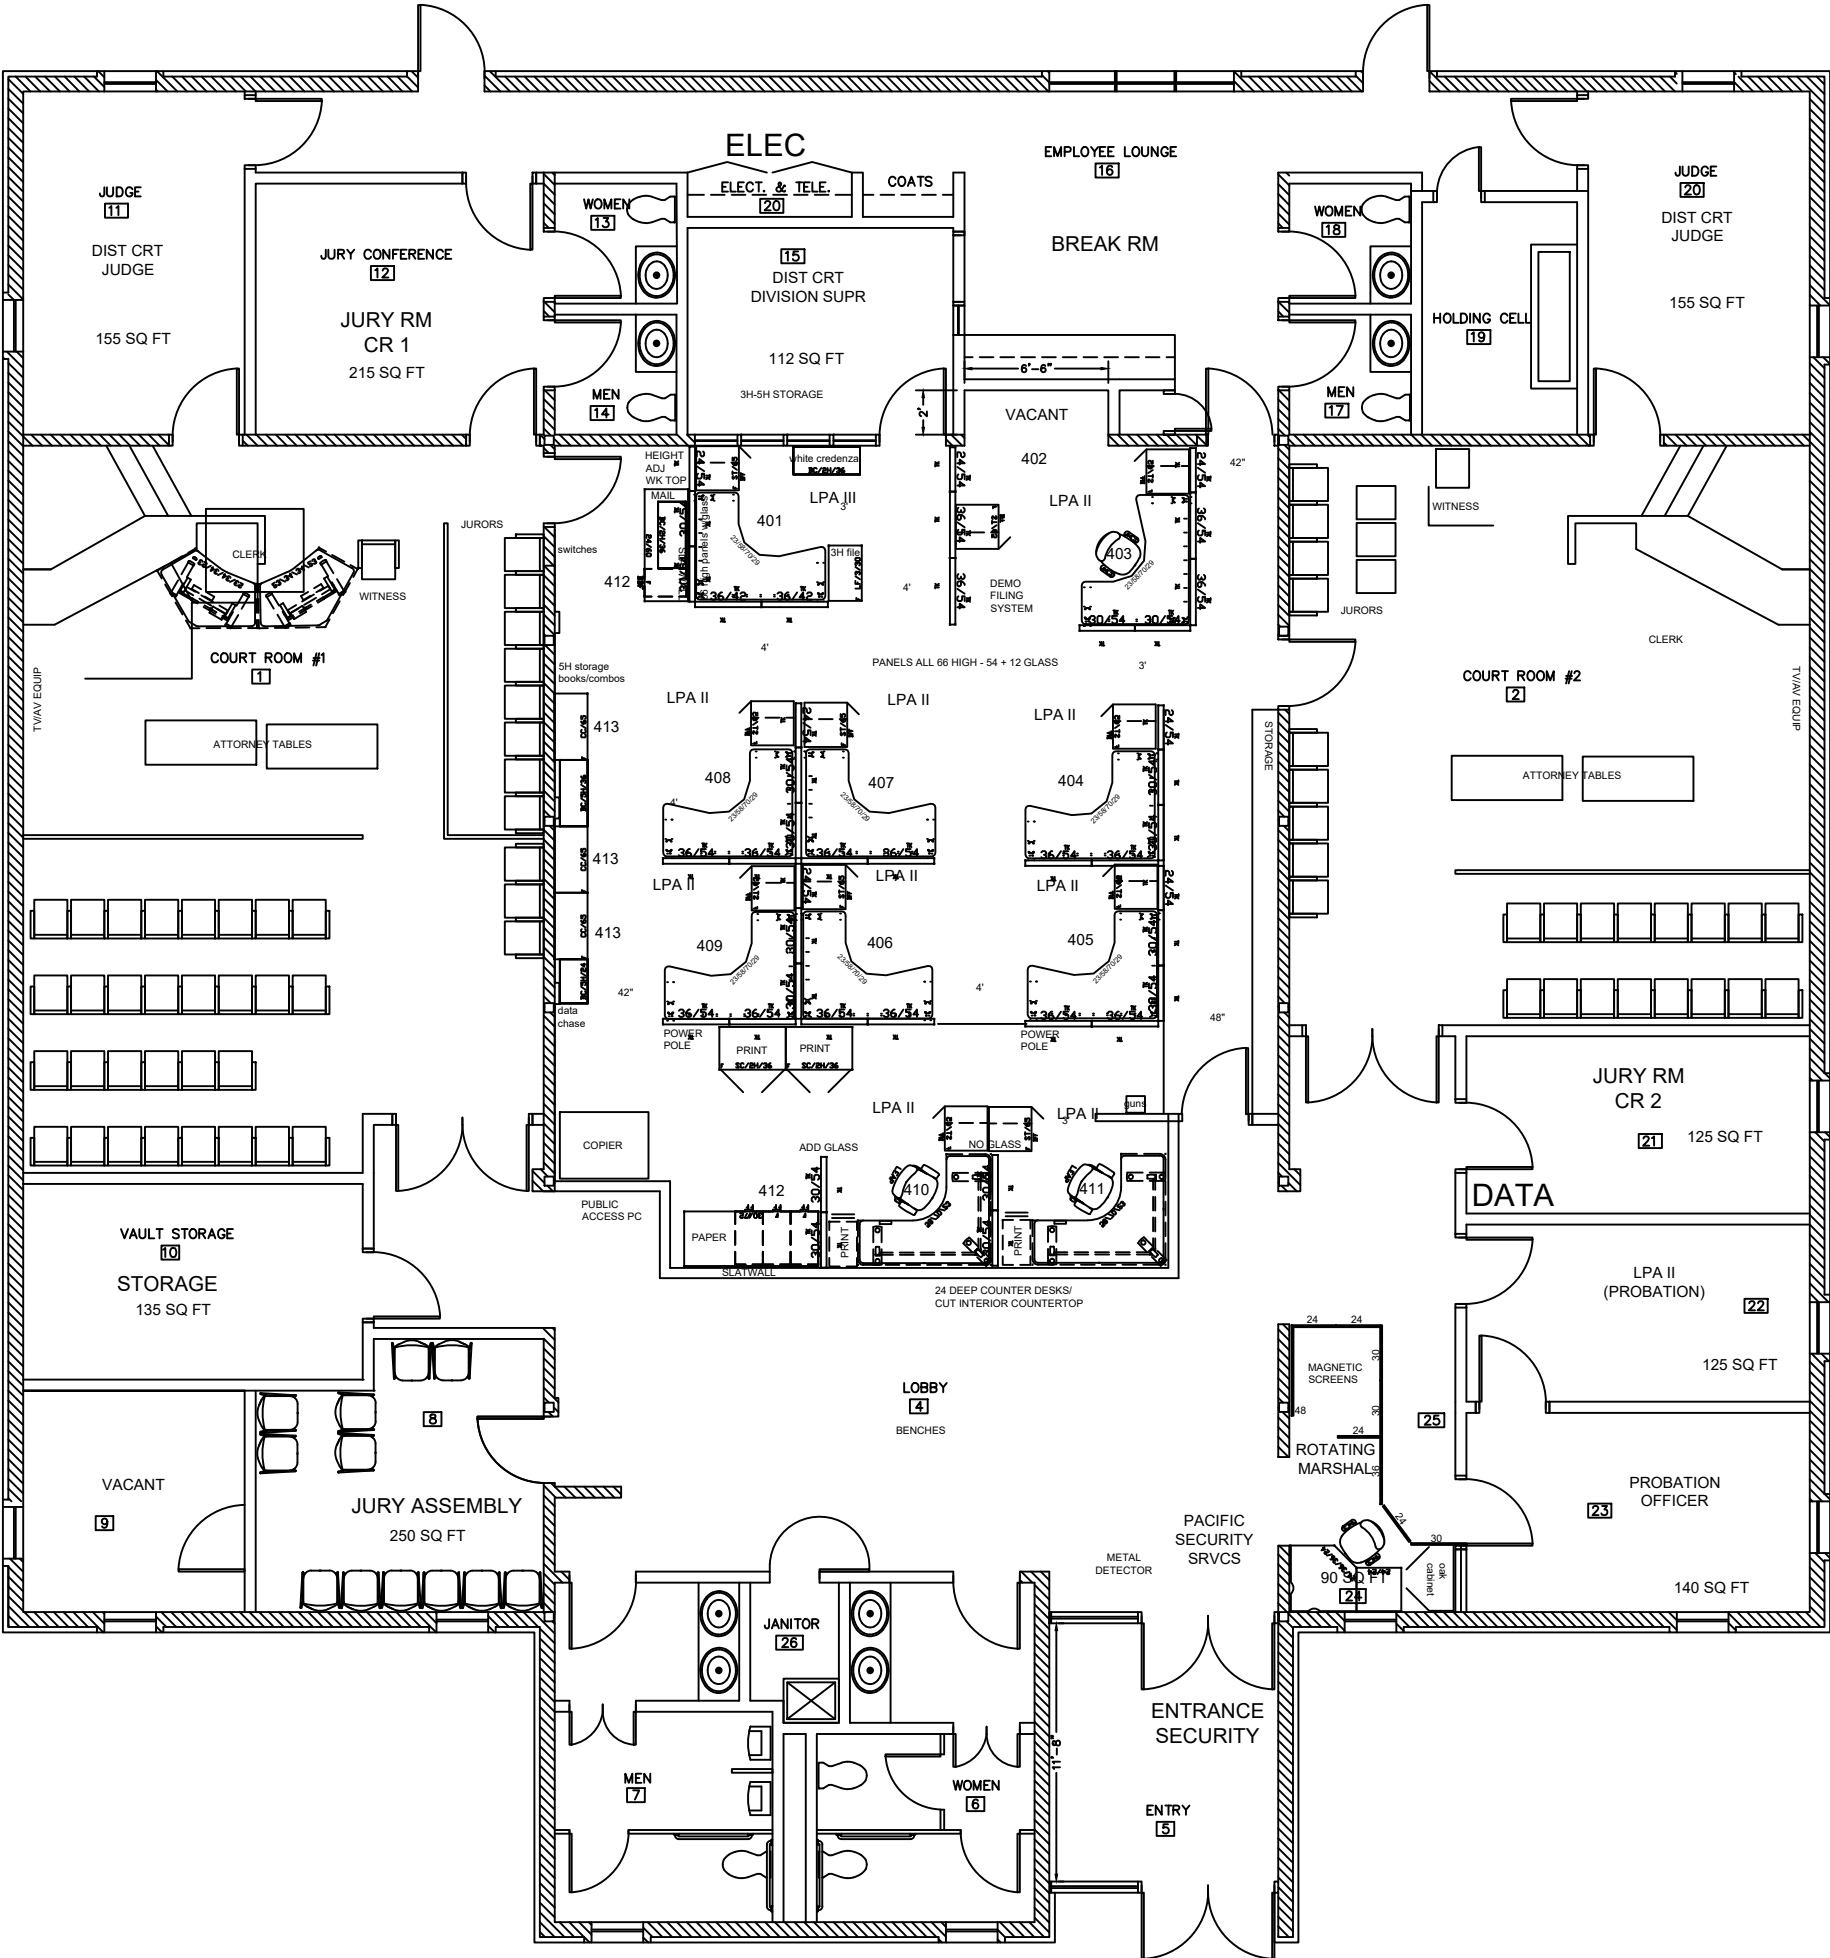

CASCADE DIST COURT FLOOR PLAN 2026
3/16"=1'-0"

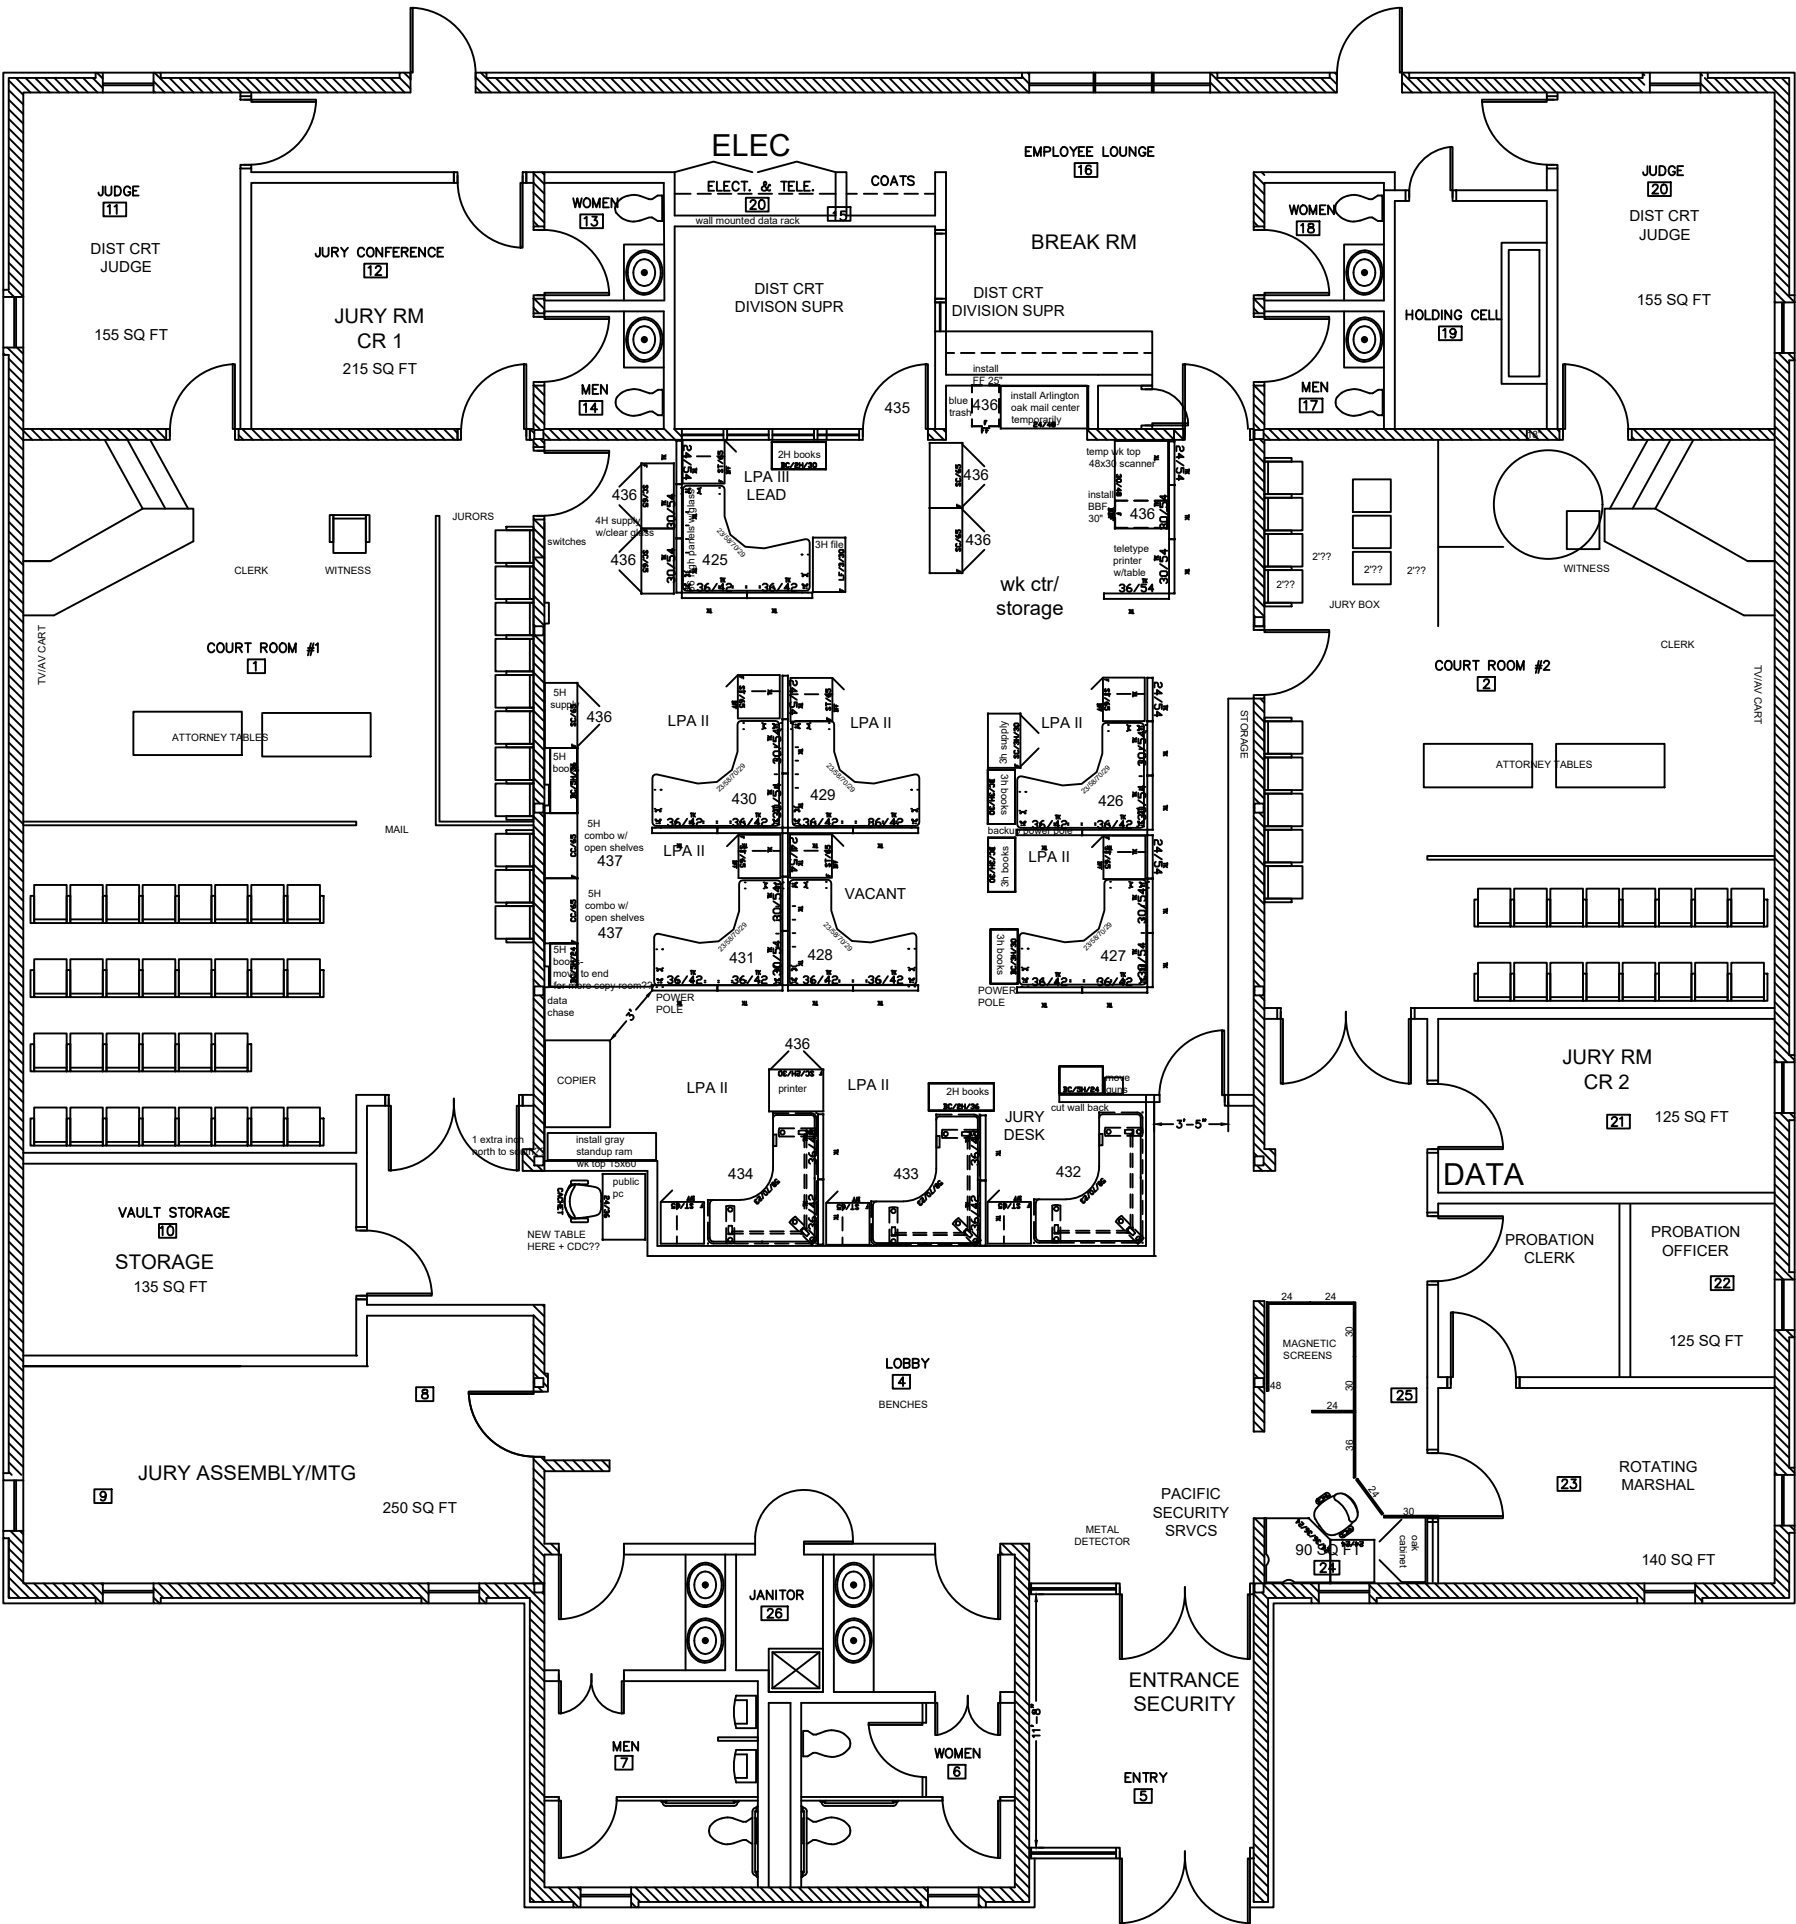

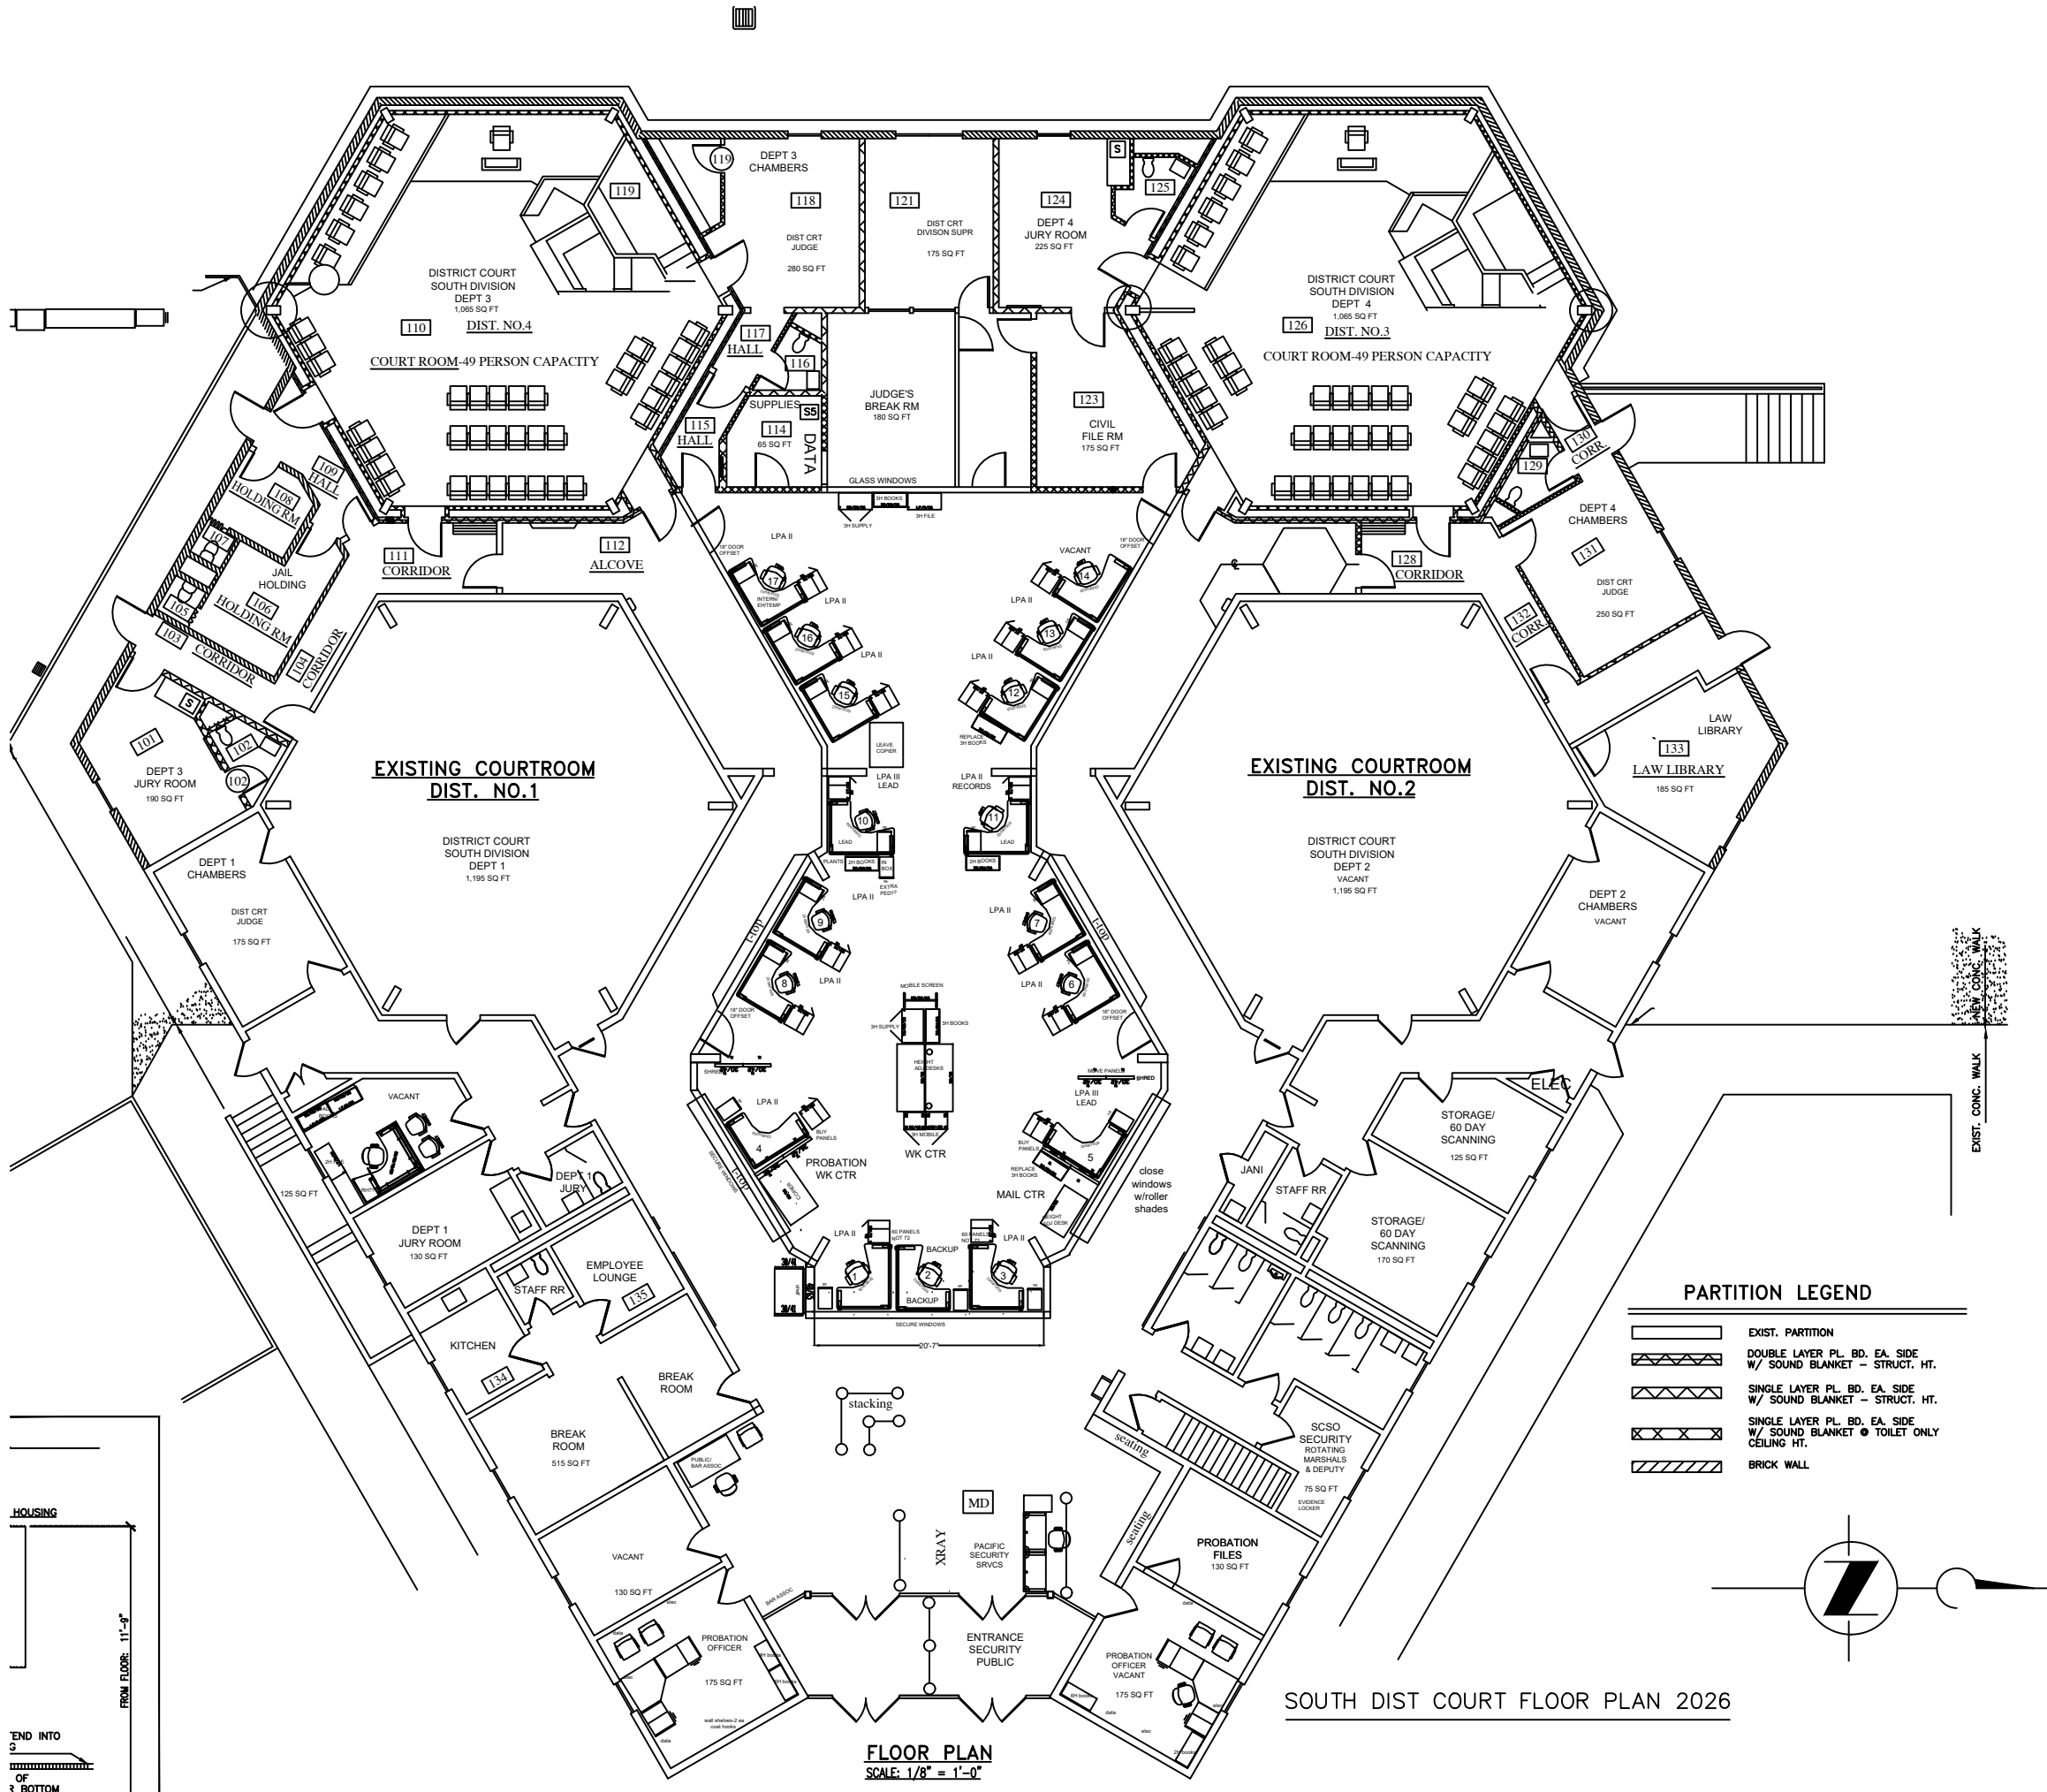

HOUSING

FROM FLOOR: 11'-9"

TEND INTO


OF


3 BOTTOM

SOUTH DIST COURT FLOOR PLAN 2026

FLOOR PLAN
SCALE: 1/8" = 1'-0"

PARTITION LEGEND	
	EXIST. PARTITION
	DOUBLE LAYER PL. BD. EA. SIDE W/ SOUND BLANKET - STRUCT. HT.
	SINGLE LAYER PL. BD. EA. SIDE W/ SOUND BLANKET - STRUCT. HT.
	SINGLE LAYER PL. BD. EA. SIDE W/ SOUND BLANKET • TOILET ONLY CEILING HT.
	BRICK WALL

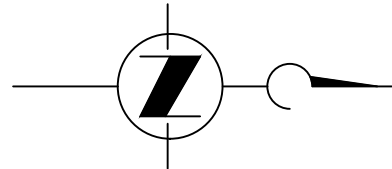

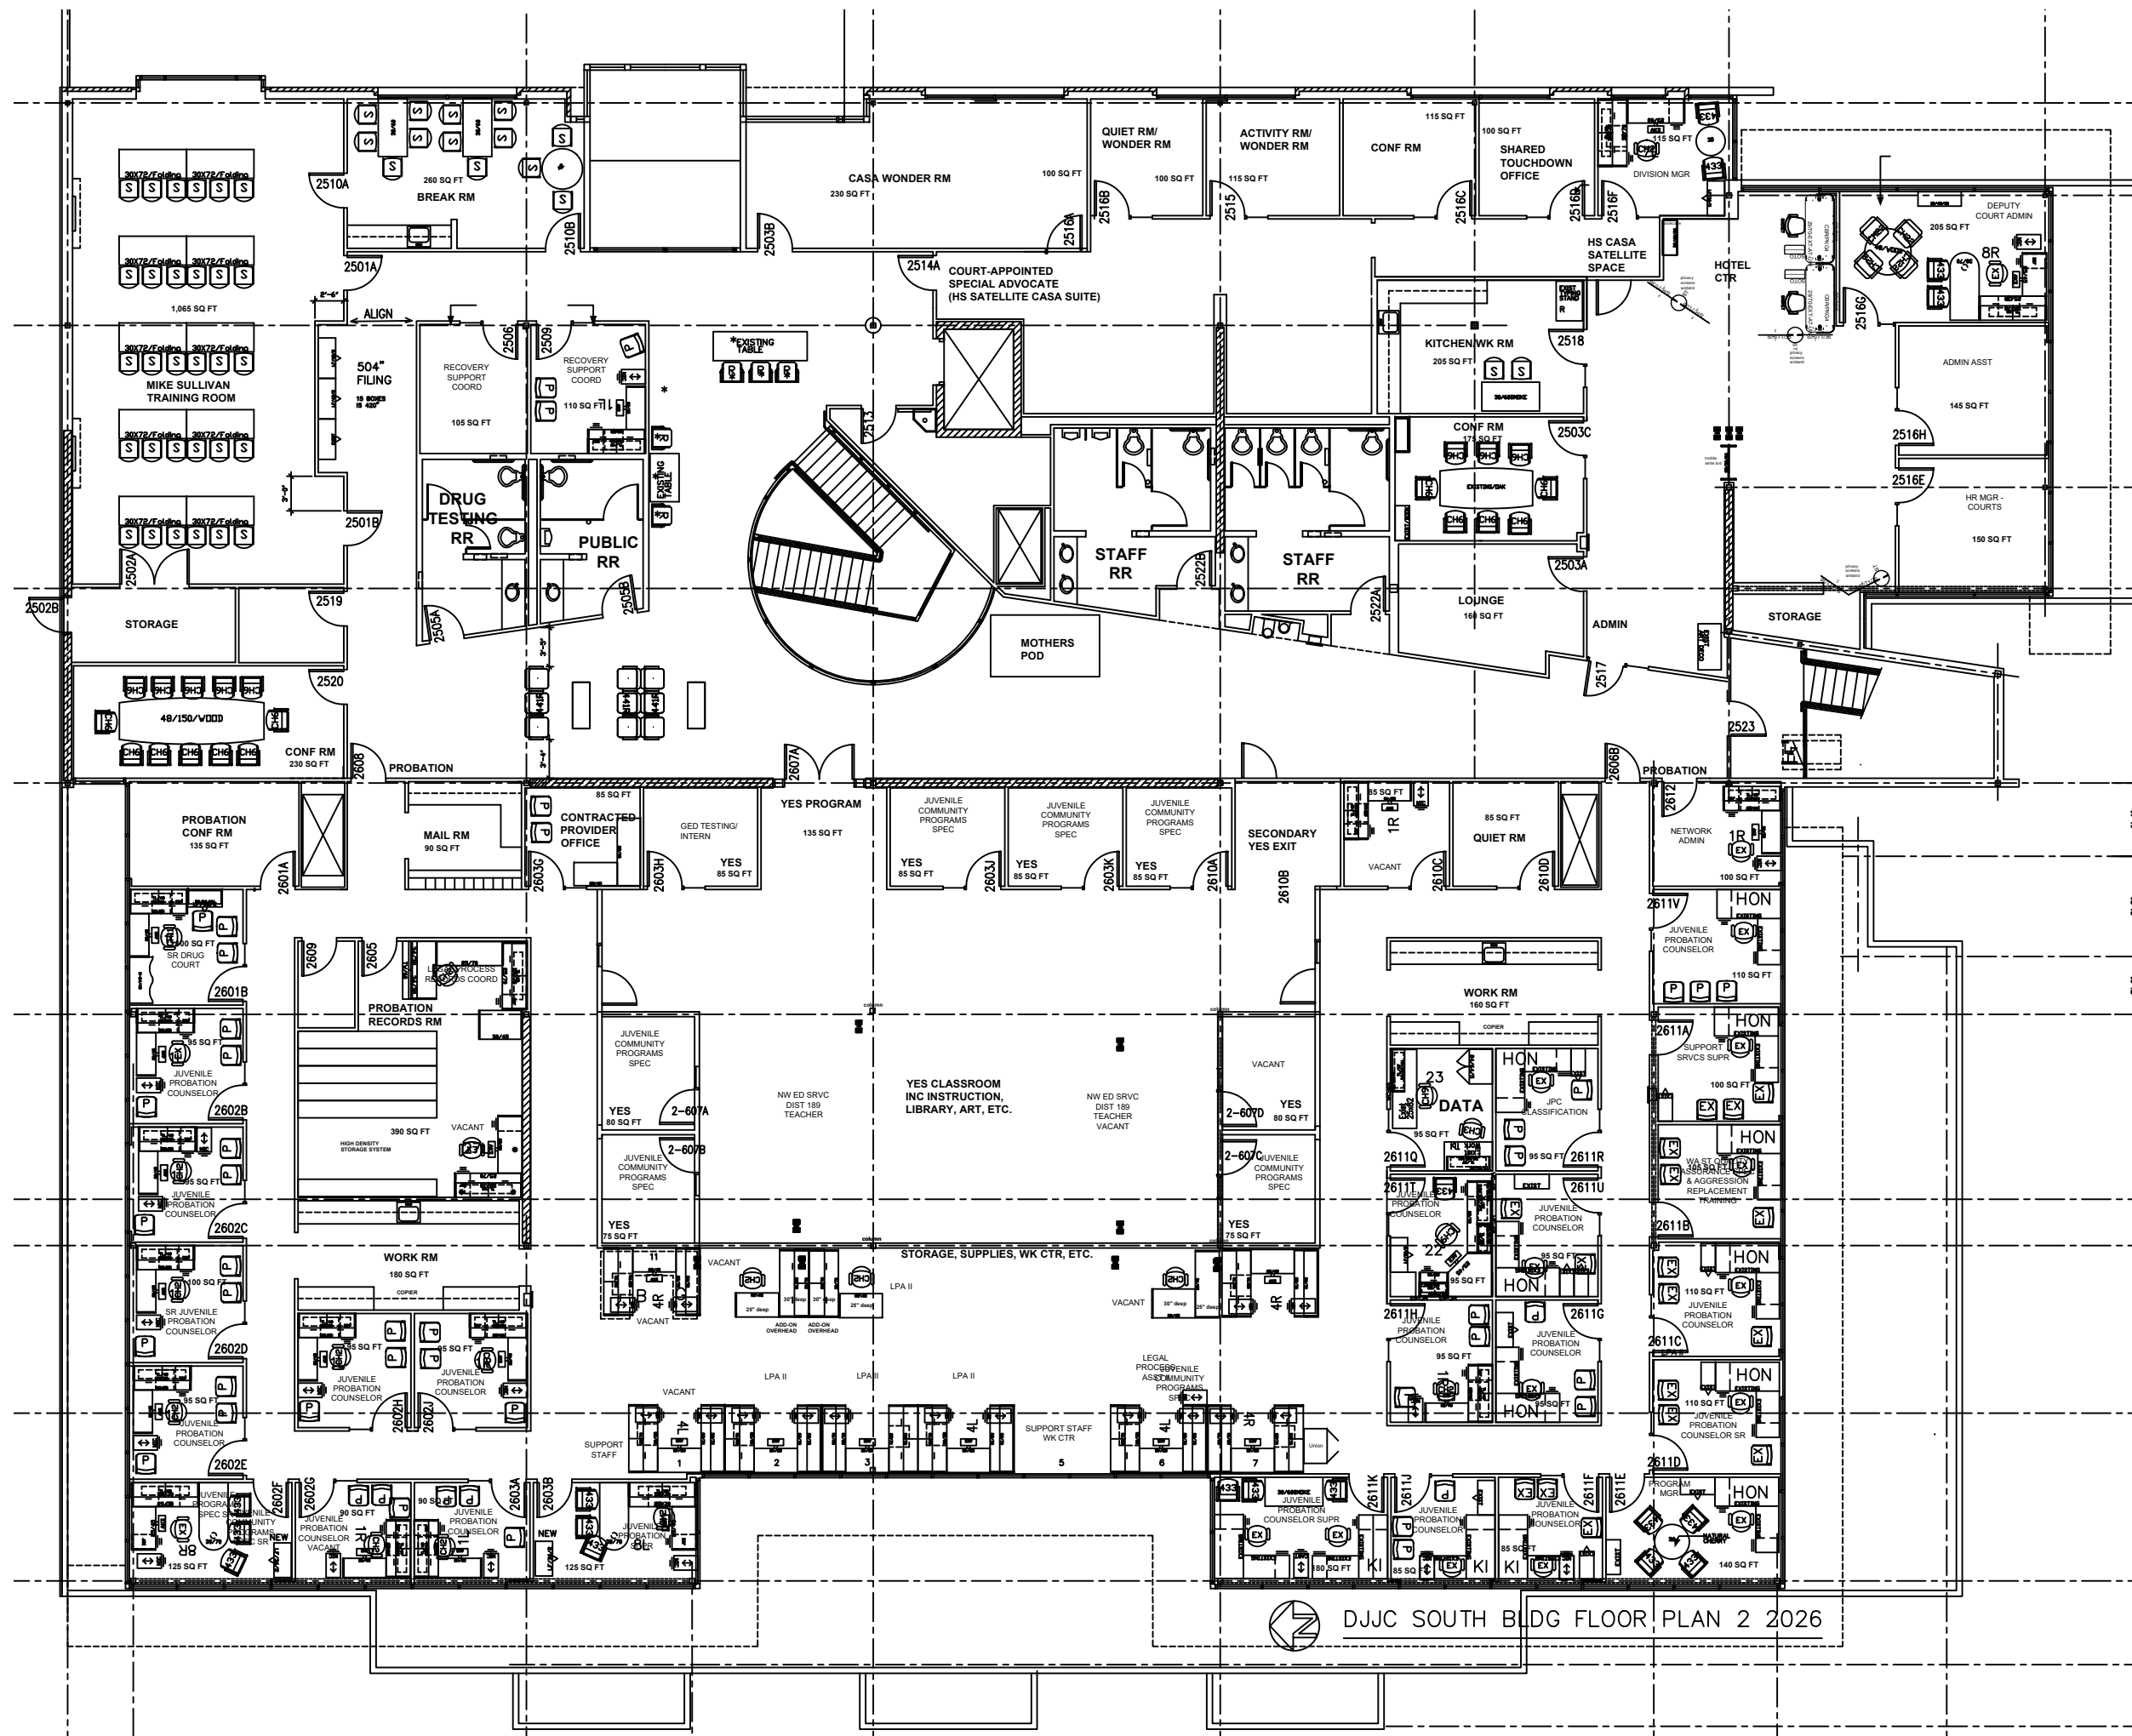

	C	D	E	G	H
1	Job	Position	FTE	Program	Notes
2	PROGRAM ASSISTANT II	SHD1024R	1.00	Vital Records	
3	PROGRAM ASSISTANT II	SHD1025R	1.00	Vital Records	
4	PROGRAM SPECIALIST II	SHD1035R	1.00	Vital Records	
5	PUBLIC RECORDS SPECIALIST	SHD1044R	1.00	Public Records	
6	PROGRAM ASSISTANT II	SHD1033R	1.00	Vital Records	Vacant as of 10/31
7	PROGRAM ASSISTANT II	SHD1177R	1.00	Vital Records	
8	PROGRAM ASSISTANT II	SHD1034R	1.00	Vital Records	
9	PRIVACY AND PUBLIC RECORDS OFFICER I	SHD1159R	1.00	Public Records/HIPAA, Vital Records	
10	FINANCE MANAGER	SHD1150R	1.00	Finance Office	
11	COMMUNICATIONS MANAGER II	SHD1145R	1.00	Communications	
12	BUSINESS MANAGEMENT ANALYST	SHD1143R	1.00	Business IT	
13	HUMAN RESOURCES SPECIALIST	SHD1156R	1.00	Human Resources	
14	SR HUMAN RESOURCES SPECIALIST	SHD1160R	1.00	Human Resources	
15	PURCHASING COORDINATOR	SHD1045R	1.00	Finance Office	
16	ACCOUNTING SUPERVISOR	SHD1140R	1.00	Finance Office	
17	FINANCIAL REPORTING & BUDGET SUPERVISOR	SHD1192R	1.00	Finance Office	
18	ACCOUNTANT I	SHD1166R	1.00	Finance Office	Supervisor position is vacant, currently supervised by TB
19	ACCOUNTANT I - SHD	SHD1217R	1.00	Finance Office	Supervisor position is vacant, currently supervised by TB
20	ACCOUNTANT I - SHD	SHD1139R	1.00	Finance Office	Supervisor position is vacant, currently supervised by TB
21	PROGRAM ASSISTANT II	SHD1011R	1.00	ODIR Admin	
22	PROGRAM SPECIALIST II	SHD1188R	1.00	ODIR Admin	
23	ADMINISTRATIVE ASSISTANT	SHD1141R	1.00	ODIR Admin	
24	HEALTHY COMMUNITIES SPECIALIST	SHD1128R	1.00	Healthy Communities	
25	HEALTHY COMMUNITIES SPECIALIST	SHD1205P	1.00	Healthy Communities	
26	HEALTHY COMMUNITIES SPECIALIST	SHD1132R	1.00	Healthy Communities	
27	HEALTH EDUCATOR	SHD1199R	1.00	Healthy Communities	
28	ENVIRONMENTAL HEALTH SUPERVISOR	SHD1046R	1.00	Food Safety	
29	ENVIRONMENTAL HEALTH SUPERVISOR	SHD1048R	1.00	Food Safety	
30	ENVIRONMENTAL HEALTH SUPERVISOR	SHD1051R	1.00	Food Safety	
31	PREVENTION SERVICES ASST DIRECTOR	SHD1017R	1.00	PS Admin	
32	PREVENTION SERVICES ASST DIRECTOR	SHD1018R	1.00	PS Admin	


	C	D	E	G	H
33	HEALTHY COMMUNITIES SPECIALIST	SHD1127R	1.00	Healthy Communities	
34	HEALTHY COMMUNITIES SPECIALIST	SHD1129R	1.00	Healthy Communities	
35	HEALTHY COMMUNITIES SPECIALIST	SHD1130R	1.00	Healthy Communities	
36	HEALTHY COMMUNITIES SPECIALIST	SHD1208P	1.00	Healthy Communities	
37	HEALTHY COMMUNITIES SPECIALIST	SHD1196R	1.00	Healthy Communities	
38	HEALTHY COMMUNITIES SPECIALIST	SHD1134R	1.00	Healthy Communities	
39	HEALTH EDUCATOR	SHD1206P	1.00	Healthy Communities	
40	PROGRAM ASSISTANT II	SHD1028R	1.00	Customer Service	
41	PROGRAM ASSISTANT II	SHD1029R	1.00	Customer Service	
42	PROGRAM ASSISTANT II	SHD1031R	1.00	Customer Service	
43	PROGRAM ASSISTANT II	SHD1030R	1.00	Customer Service	
44	PROGRAM SPECIALIST II	SHD1037R	1.00	Customer Service	
45	ENVIRONMENTAL HEALTH SPECIALIST II	SHD1053R	1.00	Safe Environments	
46	ENVIRONMENTAL HEALTH SPECIALIST III	SHD1182R	1.00	Safe Environments	
47	ENVIRONMENTAL HEALTH SPECIALIST II	SHD1065R	1.00	Safe Environments	
48	ENVIRONMENTAL HEALTH SPECIALIST II	SHD1064R	1.00	Safe Environments	
49	ENVIRONMENTAL HEALTH SPECIALIST II	SHD1052R	1.00	Safe Environments	
50	ENVIRONMENTAL HEALTH SPECIALIST III	SHD1082R	1.00	Safe Environments	
51	ENVIRONMENTAL HEALTH SPECIALIST II	SHD1072R	1.00	Safe Environments	
52	ENVIRONMENTAL HEALTH SPECIALIST II	SHD1058R	1.00	Safe Environments	
53	ENVIRONMENTAL HEALTH SPECIALIST I	SHD1054R	1.00	Safe Environments	
54	HEALTH EDUCATOR	SHD1211R	1.00	Safe Environments	
55	ENVIRONMENTAL HEALTH SPECIALIST I/II	SHD1189R	1.00	Safe Environments	
56	ENVIRONMENTAL HEALTH SPECIALIST I/II	SHD1078R	1.00	Safe Environments	
57	PUBLIC HEALTH NURSE	SHD1087R	1.00	Communicable Disease	
58	DISEASE INTERVENTION SPECIALIST	SHD1107R	1.00	Communicable Disease	
59	PROGRAM SPECIALIST II	SHD1027R	1.00	Communicable Disease	
60	PUBLIC HEALTH NURSE	SHD1163R	1.00	Communicable Disease	
61	PUBLIC HEALTH NURSE	SHD1216R	1.00	Communicable Disease	
62	INFECTION PREVENTIONIST	SHD1157R	1.00	Communicable Disease	
63	ENVIRONMENTAL HEALTH ASST DIRECTOR	SHD1015R	1.00	EH Admin	
64	ENVIRONMENTAL HEALTH SPECIALIST III	SHD1179R	1.00	EH Admin	
65	HEALTHY COMMUNITIES SPECIALIST	SHD1197R	1.00	EH Admin	
66	TECHNICAL PROJECT MANAGER	SHD1173R	1.00	EH Admin	
67	ADMINISTRATIVE ASSISTANT	SHD1026R	1.00	EH Admin	
68	ENVIRONMENTAL HEALTH ASST DIRECTOR	SHD1016R	1.00	EH Admin	
69	EMERGENCY MANAGEMENT SPECIALIST	SHD1116R	1.00	PHEPR	Vacant as of 10/30

	C	D	E	G	H
70	EMERGENCY MANAGEMENT SPECIALIST	SHD1201R	1.00	PHEPR	
71	EMERGENCY MANAGEMENT SPECIALIST	SHD1214R	1.00	PHEPR	
72	EMERGENCY MANAGEMENT SPECIALIST	SHD1117R	1.00	PHEPR	
73	EMERGENCY MANAGEMENT SPECIALIST	SHD1118R	1.00	PHEPR	
74	HEALTH DEPARTMENT DIRECTOR	SHD1174R	1.00	ODIR Admin	
75	EPIDEMIOLOGIST II	SHD1218R	1.00	Epidemiology & Informatics	
76	EPIDEMIOLOGIST II	SHD1119R	1.00	Epidemiology & Informatics	
77	EPIDEMIOLOGIST II	SHD1190R	1.00	Epidemiology & Informatics	
78	EPIDEMIOLOGIST II	SHD1120R	1.00	Epidemiology & Informatics	
79	LEAD EPIDEMIOLOGIST	SHD1135R	1.00	Epidemiology & Informatics	
80	EPIDEMIOLOGIST II	SHD1186R	1.00	Epidemiology & Informatics	
81	PROGRAM ASSISTANT II	SHD1105R	1.00	Epidemiology & Informatics	
82	EPIDEMIOLOGIST I	SHD1181R	1.00	Epidemiology & Informatics	
83	EPIDEMIOLOGIST II	SHD1210R	1.00	Epidemiology & Informatics	
84	EPIDEMIOLOGIST I	SHD1219R	0.50	Epidemiology & Informatics	
85	GRAPHIC DESIGNER	SHD1021R	1.00	Communications	
86	GRAPHIC DESIGNER	SHD1022R	1.00	Communications	
87	COMMUNICATIONS COORDINATOR	SHD1147R	1.00	Communications	
88	COMMUNICATIONS COORDINATOR	SHD1146R	1.00	Communications	
89	ENVIRONMENTAL HEALTH SPECIALIST II	SHD1068R	1.00	Food Safety	
90	ENVIRONMENTAL HEALTH SPECIALIST II	SHD1055R	1.00	Food Safety	
91	ENVIRONMENTAL HEALTH SPECIALIST III	SHD1057R	1.00	Food Safety	
92	ENVIRONMENTAL HEALTH SPECIALIST III	SHD1178R	1.00	Food Safety	
93	ENVIRONMENTAL HEALTH SPECIALIST II	SHD1061R	1.00	Food Safety	
94	PROGRAM SPECIALIST II - PERMIT TECHNICIAN	SHD1194P	1.00	Food Safety	
95	ENVIRONMENTAL HEALTH SPECIALIST II	SHD1069R	1.00	Food Safety	
96	ENVIRONMENTAL HEALTH SPECIALIST I	SHD1076R	1.00	Food Safety	
97	ENVIRONMENTAL HEALTH SPECIALIST II	SHD1169R	1.00	Food Safety	
98	PROGRAM SPECIALIST II - PERMIT TECHNICIAN	SHD1195P	1.00	Food Safety	
99	ENVIRONMENTAL HEALTH SPECIALIST II	SHD1075R	1.00	Food Safety	
100	ENVIRONMENTAL HEALTH SPECIALIST III	SHD1083R	1.00	Food Safety	
101	ENVIRONMENTAL HEALTH SPECIALIST II	SHD1077R	1.00	Food Safety	
102	ENVIRONMENTAL HEALTH SPECIALIST III	SHD1081R	1.00	Land Use	
103	ENVIRONMENTAL HEALTH SPECIALIST II	SHD1060R	1.00	Land Use	
104	ENVIRONMENTAL HEALTH SPECIALIST II	SHD1071R	1.00	Land Use	
105	ENVIRONMENTAL HEALTH SPECIALIST II	SHD1074R	1.00	Land Use	
106	ENVIRONMENTAL HEALTH SPECIALIST I	SHD1056R	1.00	Land Use	


	C	D	E	G	H
107	ENVIRONMENTAL HEALTH SPECIALIST I	SHD1180R	1.00	Land Use	
108	ENVIRONMENTAL HEALTH SPECIALIST II	SHD1059R	1.00	Land Use	
109	ENVIRONMENTAL HEALTH SPECIALIST I	SHD1067R	1.00	Land Use	
110	ENVIRONMENTAL HEALTH SPECIALIST III	SHD1183R	1.00	Land Use	
111	EPIDEMIOLOGY AND INFORMATICS MANAGER	SHD1185R	1.00	Epidemiology	
112	OUTREACH WORKER	SHD1136P	1.00	Refugee Health	
113	PUBLIC HEALTH NURSE	SHD1092R	1.00	Refugee Health	
114	PUBLIC HEALTH NURSE	SHD1089R	0.50	Refugee Health	
115	PROGRAM SPECIALIST II	SHD1032R	1.00	Refugee Health	As of 11/01/25
116	ADMINISTRATIVE SUPERVISOR	SHD1142R	1.00	Customer Service	
117	ENVIRONMENTAL HEALTH SUPERVISOR	SHD1047R	1.00	Safe Environments	
118	ENVIRONMENTAL HEALTH SUPERVISOR	SHD1049R	1.00	Land Use	
119	ENVIRONMENTAL HEALTH SUPERVISOR	SHD1050R	1.00	Land Use	
120	IMMUNIZATION & VACCINE PREVENTABLE DISEASE SUP	SHD1184R	1.00	Communicable Disease	
121	COMMUNICABLE DISEASE AND PHEPR SUPERVISOR	SHD1144R	1.00	Communicable Disease	
122	REFUGEE HEALTH SUPERVISOR	SHD1098R	1.00	Refugee Health	
123	STD SUPERVISOR	SHD1161R	1.00	STD/HIV	
124	TUBERCULOSIS SUPERVISOR	SHD1162R	1.00	TB - Tuberculosis	
125	HEALTH EDUCATOR	SHD1123R	1.00	PS Admin	
126	CLINIC MANAGER	SHD1203P	1.00	PS Admin	
127	ENVIRONMENTAL HEALTH SPECIALIST II	SHD1187R	1.00	Land Use	
128	ENVIRONMENTAL HEALTH SPECIALIST II	SHD1066R	1.00	Land Use	
129	PROGRAM SPECIALIST II - PERMIT TECHNICIAN	SHD1041R	1.00	Land Use	
130	PROGRAM SPECIALIST II - PERMIT TECHNICIAN	SHD1042R	1.00	Land Use	
131	HEALTHY COMMUNITIES SPECIALIST	SHD1073R	1.00	Land Use	
132	HEALTH EDUCATOR	SHD1122R	1.00	Land Use	
133	ENVIRONMENTAL HEALTH SPECIALIST III	SHD1084R	1.00	Land Use	
134	HEALTH EDUCATOR	SHD1121R	1.00	Land Use	
135	LEAD DISEASE INTERVENTION SPECIALIST	SHD1175R	1.00	STD/HIV	
136	DISEASE INTERVENTION SPECIALIST	SHD1106R	1.00	STD/HIV	
137	PROGRAM SPECIALIST II	SHD1043R	1.00	STD/HIV	As of 11/04/25
138	DISEASE INTERVENTION SPECIALIST	SHD1109R	1.00	STD/HIV	
139	DISEASE INTERVENTION SPECIALIST	SHD1108R	1.00	STD/HIV	
140	DISEASE INTERVENTION SPECIALIST	SHD1111R	1.00	STD/HIV	
141	DISEASE INTERVENTION SPECIALIST	SHD1113R	1.00	STD/HIV	
142	DISEASE INTERVENTION SPECIALIST	SHD1112R	1.00	STD/HIV	
143	OUTREACH WORKER	SHD1137R	1.00	TB - Tuberculosis	


	C	D	E	G	H
144	PUBLIC HEALTH NURSE	SHD1095R	1.00	TB - Tuberculosis	
145	PROGRAM SPECIALIST II	SHD1038R	1.00	TB - Tuberculosis	
146	OUTREACH WORKER	SHD1168R	1.00	TB - Tuberculosis	
147	PUBLIC HEALTH NURSE	SHD1088R	1.00	TB - Tuberculosis	
148	LEAD PUBLIC HEALTH NURSE	SHD1086R	1.00	TB - Tuberculosis	
149	DISEASE INTERVENTION SPECIALIST	SHD1114R	1.00	TB - Tuberculosis	
150	PUBLIC HEALTH NURSE	SHD1172R	1.00	TB - Tuberculosis	
151	HEALTHY COMMUNITIES SUPERVISOR	SHD1155R	1.00	Healthy Communities	
152	HEALTHY COMMUNITIES SUPERVISOR	SHD1200R	1.00	Healthy Communities	
153	HEALTH EDUCATOR	SHD1124R	1.00	PS Admin	
154	MATERNAL CHILD HEALTH SUPERVISOR	SHD1158R	1.00	Children & Family Health	
155	PROGRAM SPECIALIST II	SHD1039R	1.00	Finance Office	
156	PROGRAM SPECIALIST II - ACCOUNTS PAYABLE	SHD1019R	1.00	Finance Office	
157	PROGRAM SPECIALIST II - ACCOUNTS RECEIVABLE	SHD1202R	0.50	Finance Office	
158	PROGRAM SPECIALIST II - ACCOUNTING SPECIALIST	SHD1023R	1.00	Finance Office	
159	DISEASE INTERVENTION SPECIALIST	SHD1110R	1.00	Food Safety	
160	ENVIRONMENTAL HEALTH SPECIALIST II	SHD1063R	1.00	Food Safety	
161	ENVIRONMENTAL HEALTH SPECIALIST III	SHD1085R	1.00	Food Safety	
162	HEALTH EDUCATOR	SHD1125R	1.00	Food Safety	
163	ENVIRONMENTAL HEALTH SPECIALIST II	SHD1171R	1.00	Food Safety	
164	ENVIRONMENTAL HEALTH SPECIALIST II	SHD1079R	1.00	Food Safety	
165	ENVIRONMENTAL HEALTH SPECIALIST II	SHD1080R	1.00	Food Safety	
166	ENVIRONMENTAL HEALTH SPECIALIST I/II	SHD1062R	1.00	TBD	Paused
167	ENVIRONMENTAL HEALTH SPECIALIST I/II	SHD1170R	1.00	TBD	Paused
168	ENVIRONMENTAL HEALTH SPECIALIST I/II	SHD1220R	1.00	TBD	Paused
169	HEALTHY COMMUNITIES SPECIALIST	SHD1215R	1.00	Healthy Communities	
170	SOUND FOUNDATION MANAGER	SHD1131P	1.00	Policy, Planning, and Partnership	
171	PROGRAM SPECIALIST II	SHD1036R	0.90	Policy, Planning, and Partnership	
172	GRANTS COORDINATOR	SHD1152R	1.00	Policy, Planning, and Partnership	
173	HEALTH POLICY ANALYST	SHD1209R	1.00	Policy, Planning, and Partnership	
174	HEALTH POLICY ANALYST	SHD1198R	1.00	Policy, Planning, and Partnership	
175	VACCINE COORDINATOR	SHD1138R	1.00	VPD - Vaccine Preventable Disease	
176	MEDICAL ASSISTANT - SHD	SHD1204P	1.00	STI Clinic	
177	ADVANCED REGISTERED NURSE PRACTITIONER - SHD	SHD1176R	1.00	STI Clinic	
178	PUBLIC HEALTH NURSE	SHD1090R	1.00	VPD - Vaccine Preventable Disease	
179	PROGRAM SPECIALIST II	SHD1212R	1.00	STI Clinic	
180	REGISTERED NURSE - SHD	SHD1103R	1.00	VPD - Vaccine Preventable Disease	


	C	D	E	G	H
181	MEDICAL ASSISTANT - SHD	SHD1193R	1.00	VPD - Vaccine Preventable Disease	
182	HEALTH DEPARTMENT DIRECTOR	SHD1012R	1.00	ODIR Admin	
183	EXECUTIVE ASSISTANT	SHD1149R	1.00	ODIR Admin	
184	PREVENTION SERVICES DIVISION DIRECTOR	SHD1014R	1.00	PS Admin	
185	ENVIRONMENTAL HEALTH DIRECTOR	SHD1013R	1.00	EH Admin	
186	PUBLIC HEALTH EMERGENCY PREP & RSP PROGRAM MGR	SHD1191R	1.00	PHEPR	
187	HEALTH OFFICER	SHD1010R	1.00	ODIR Admin	
188	PUBLIC AFFAIRS AND POLICY MANAGER	SHD1165R	1.00	Policy, Planning, and Partnership	
189	PROGRAM SPECIALIST II - MCH	SHD1040R	1.00	Children & Family Health	
190	BEHAVIOR HEALTH SPECIALIST	SHD1097R	1.00	Children & Family Health	
191	ENVIRONMENTAL HEALTH SPECIALIST II	SHD1070R	1.00	Children & Family Health	
192	PUBLIC HEALTH NURSE	SHD1091R	1.00	Children & Family Health	
193	PUBLIC HEALTH NURSE	SHD1164R	1.00	Children & Family Health	
194	PUBLIC HEALTH NURSE	SHD1093R	1.00	Children & Family Health	
195	PUBLIC HEALTH NURSE	SHD1096R	0.50	Children & Family Health	

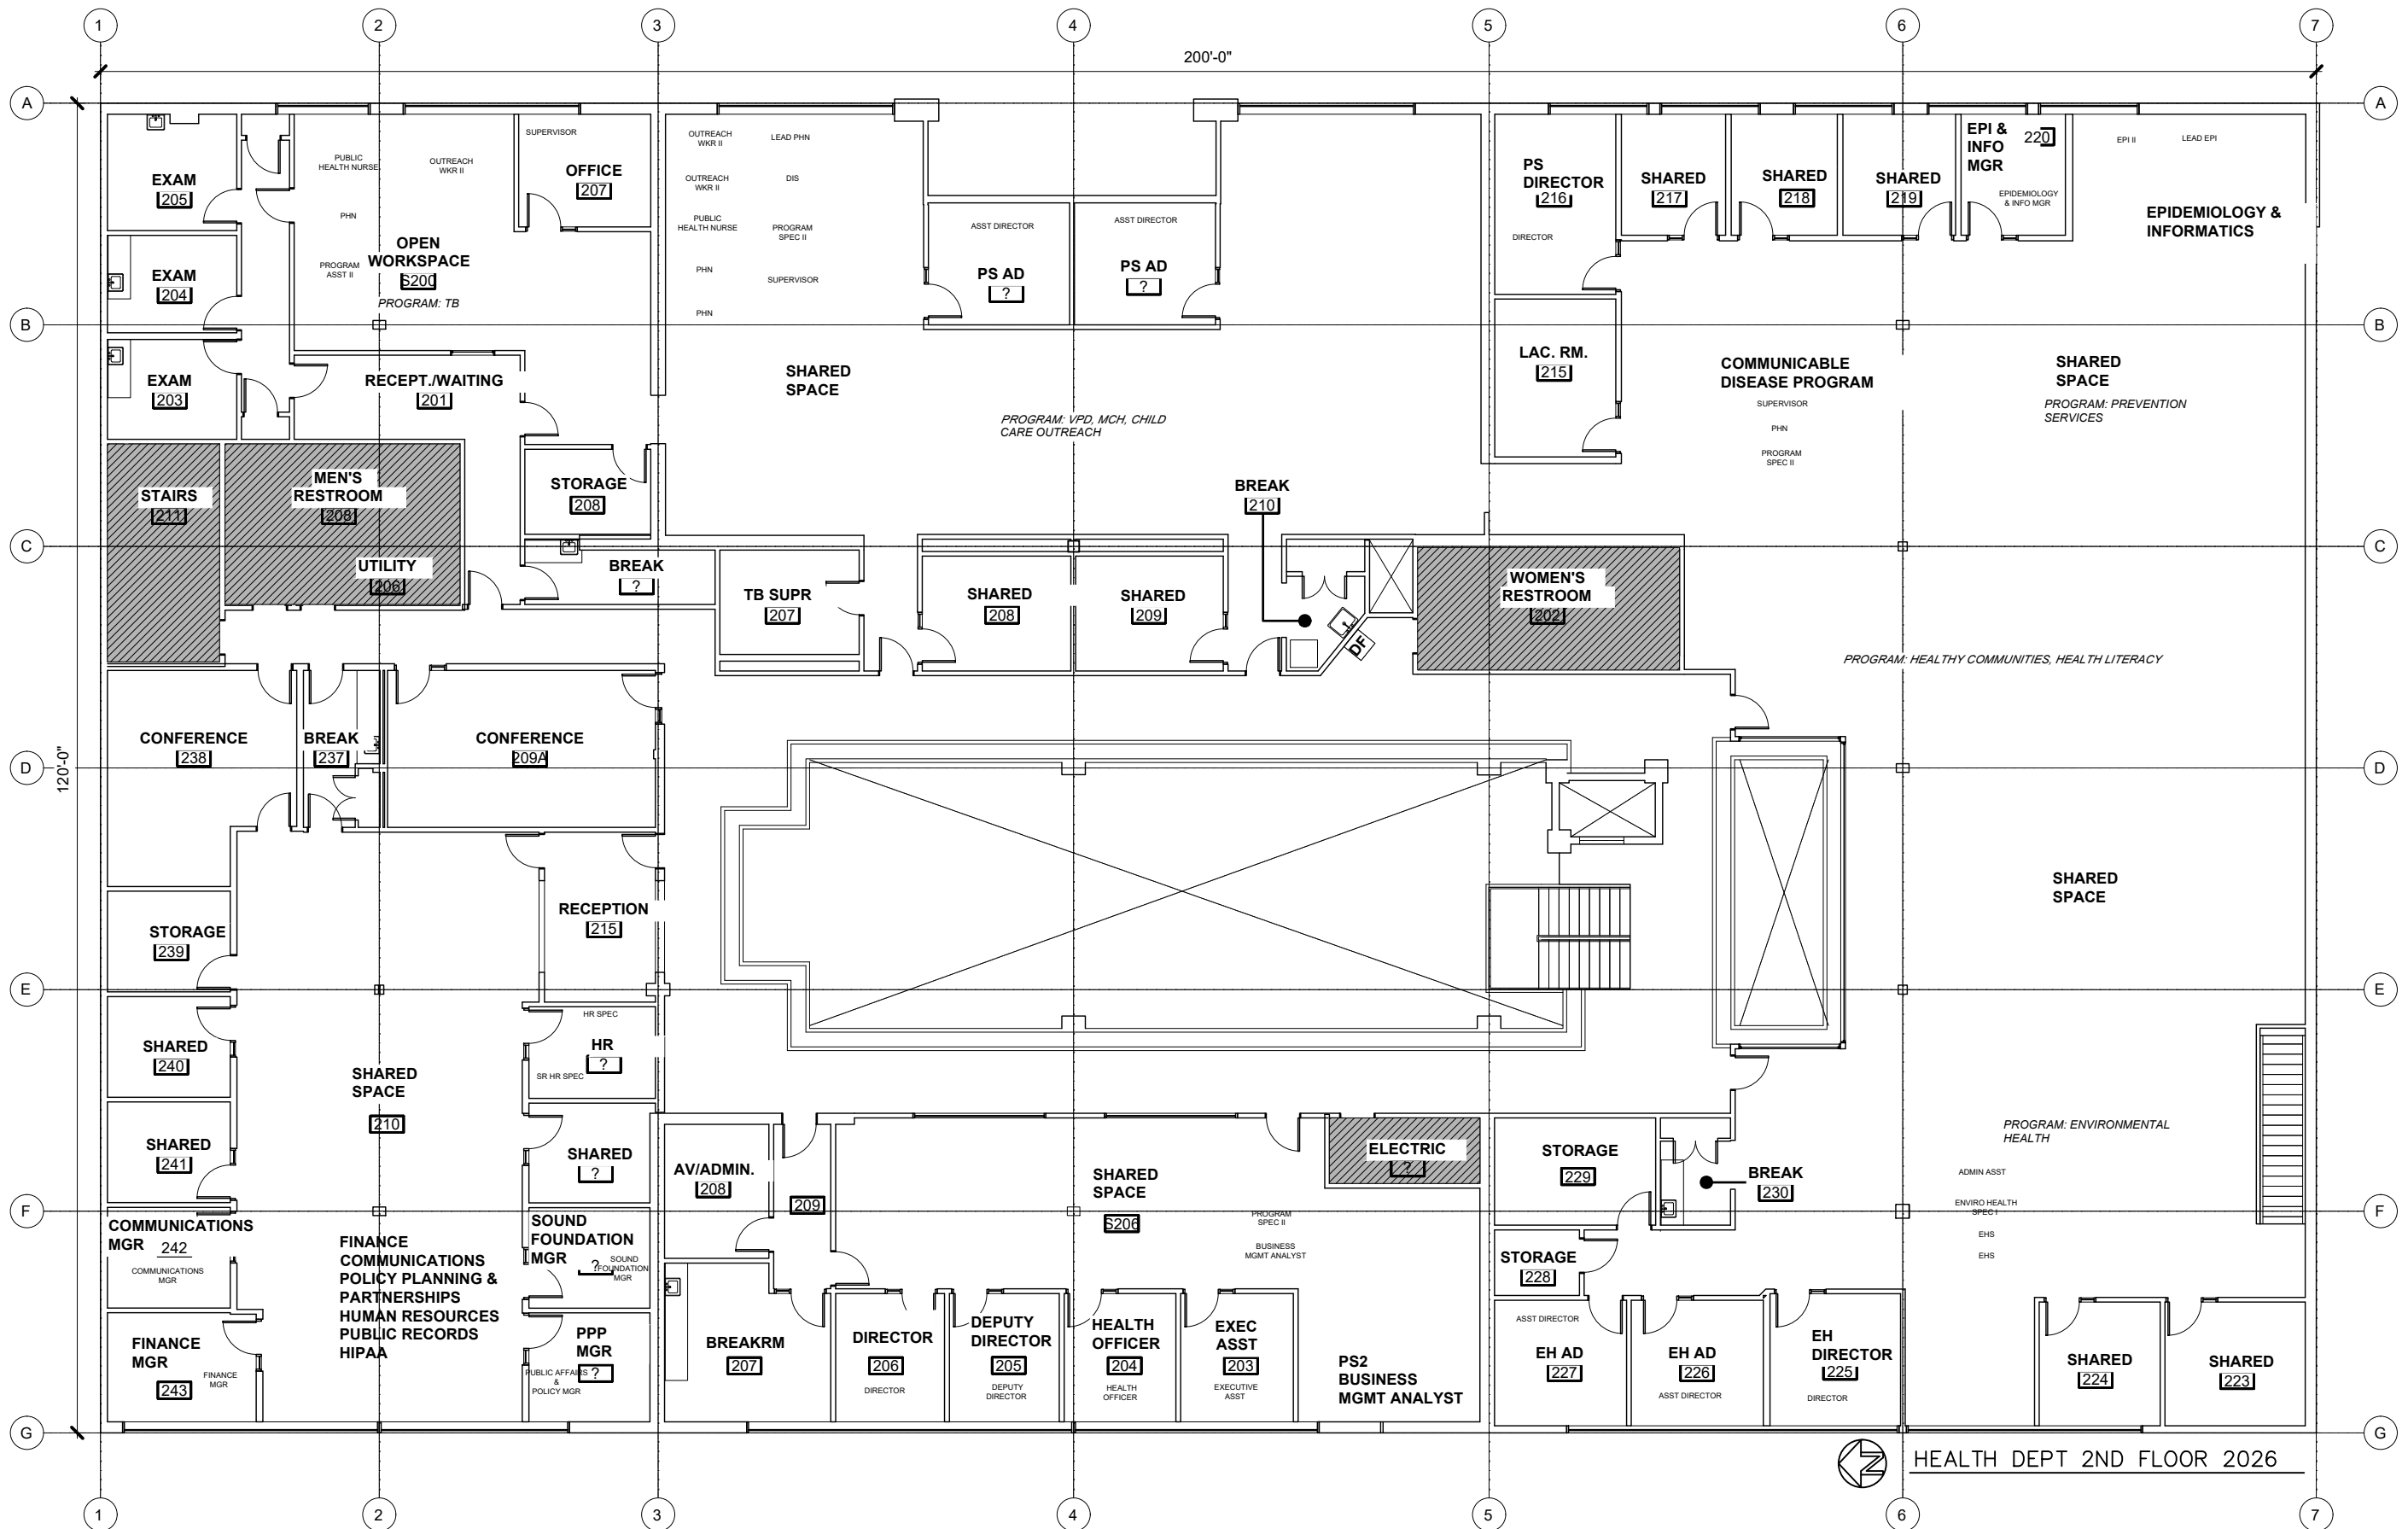


HEALTH DEPT 2ND FLOOR 2026

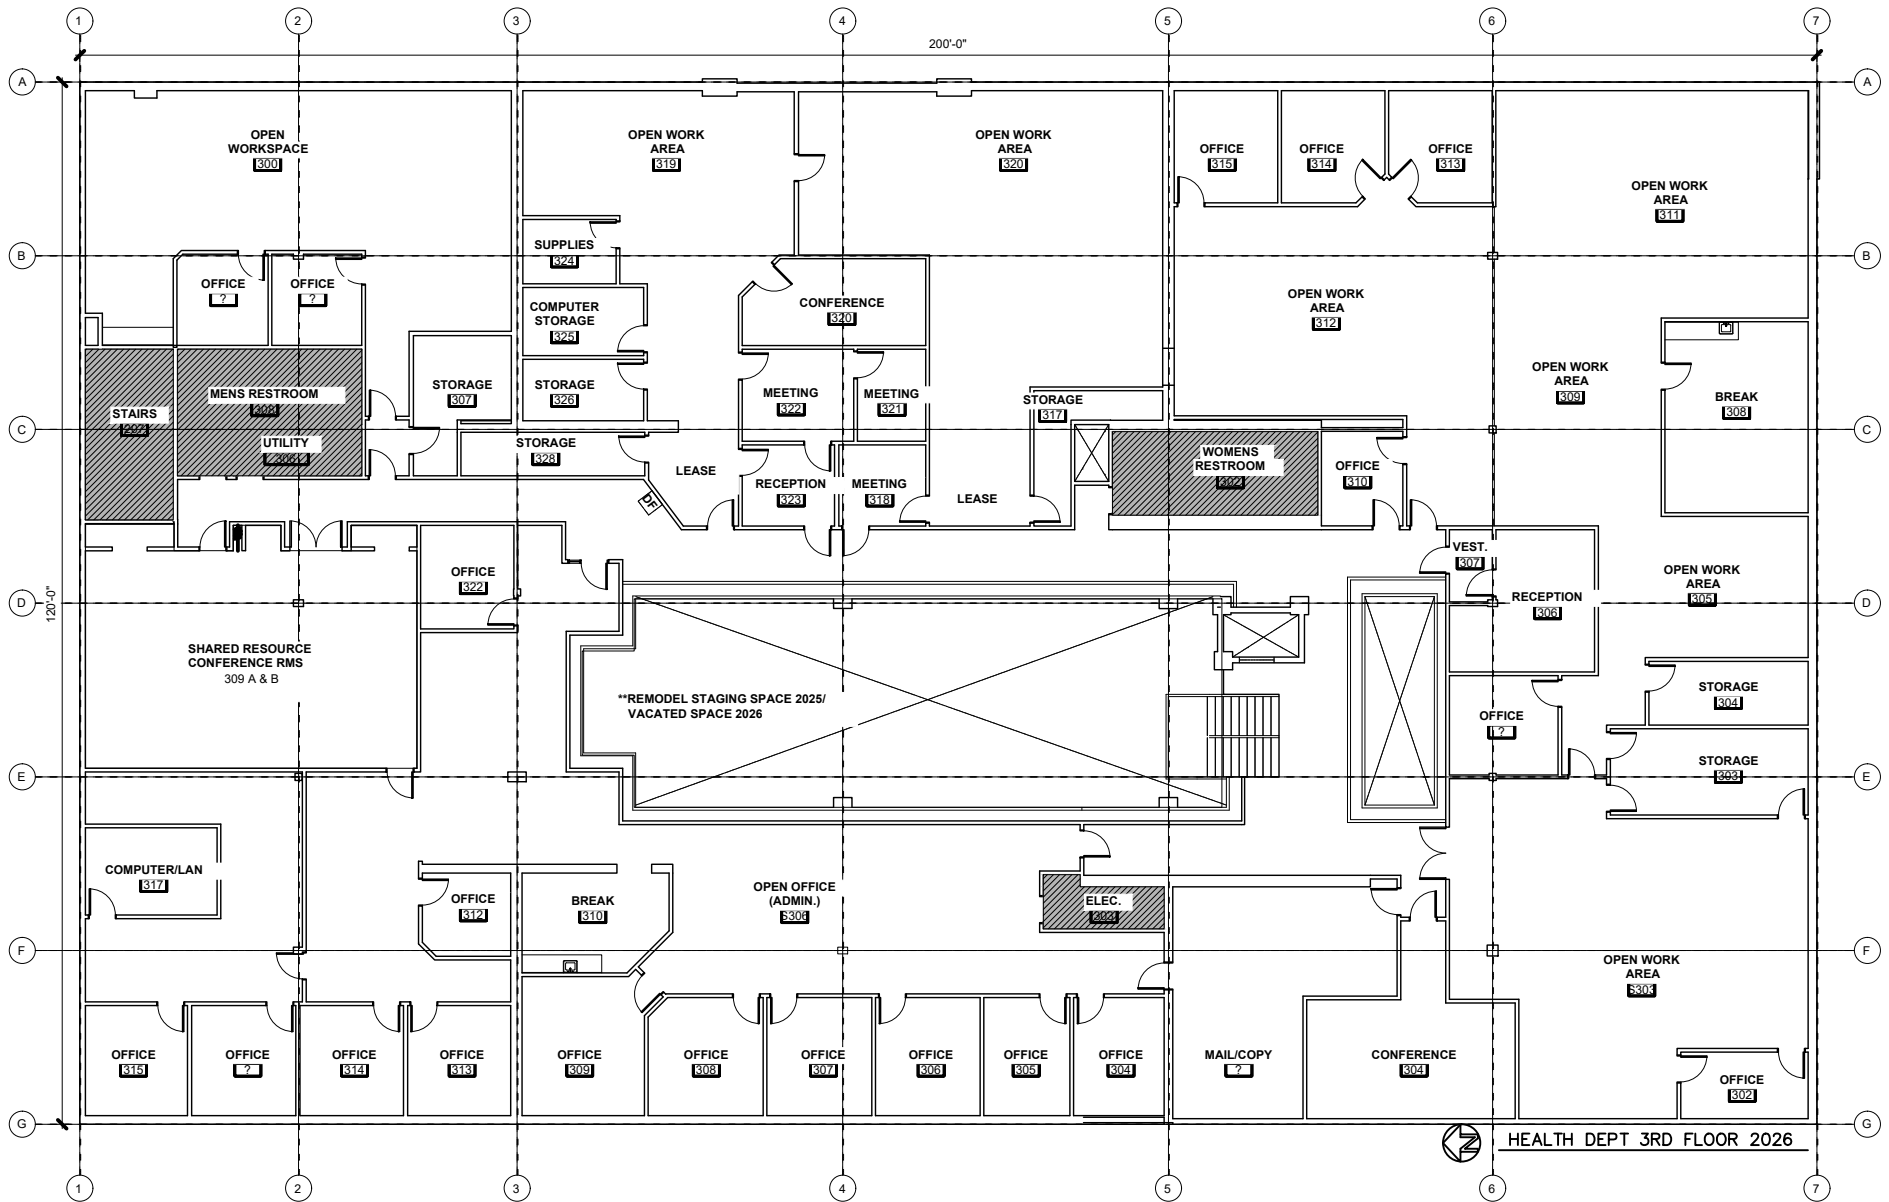

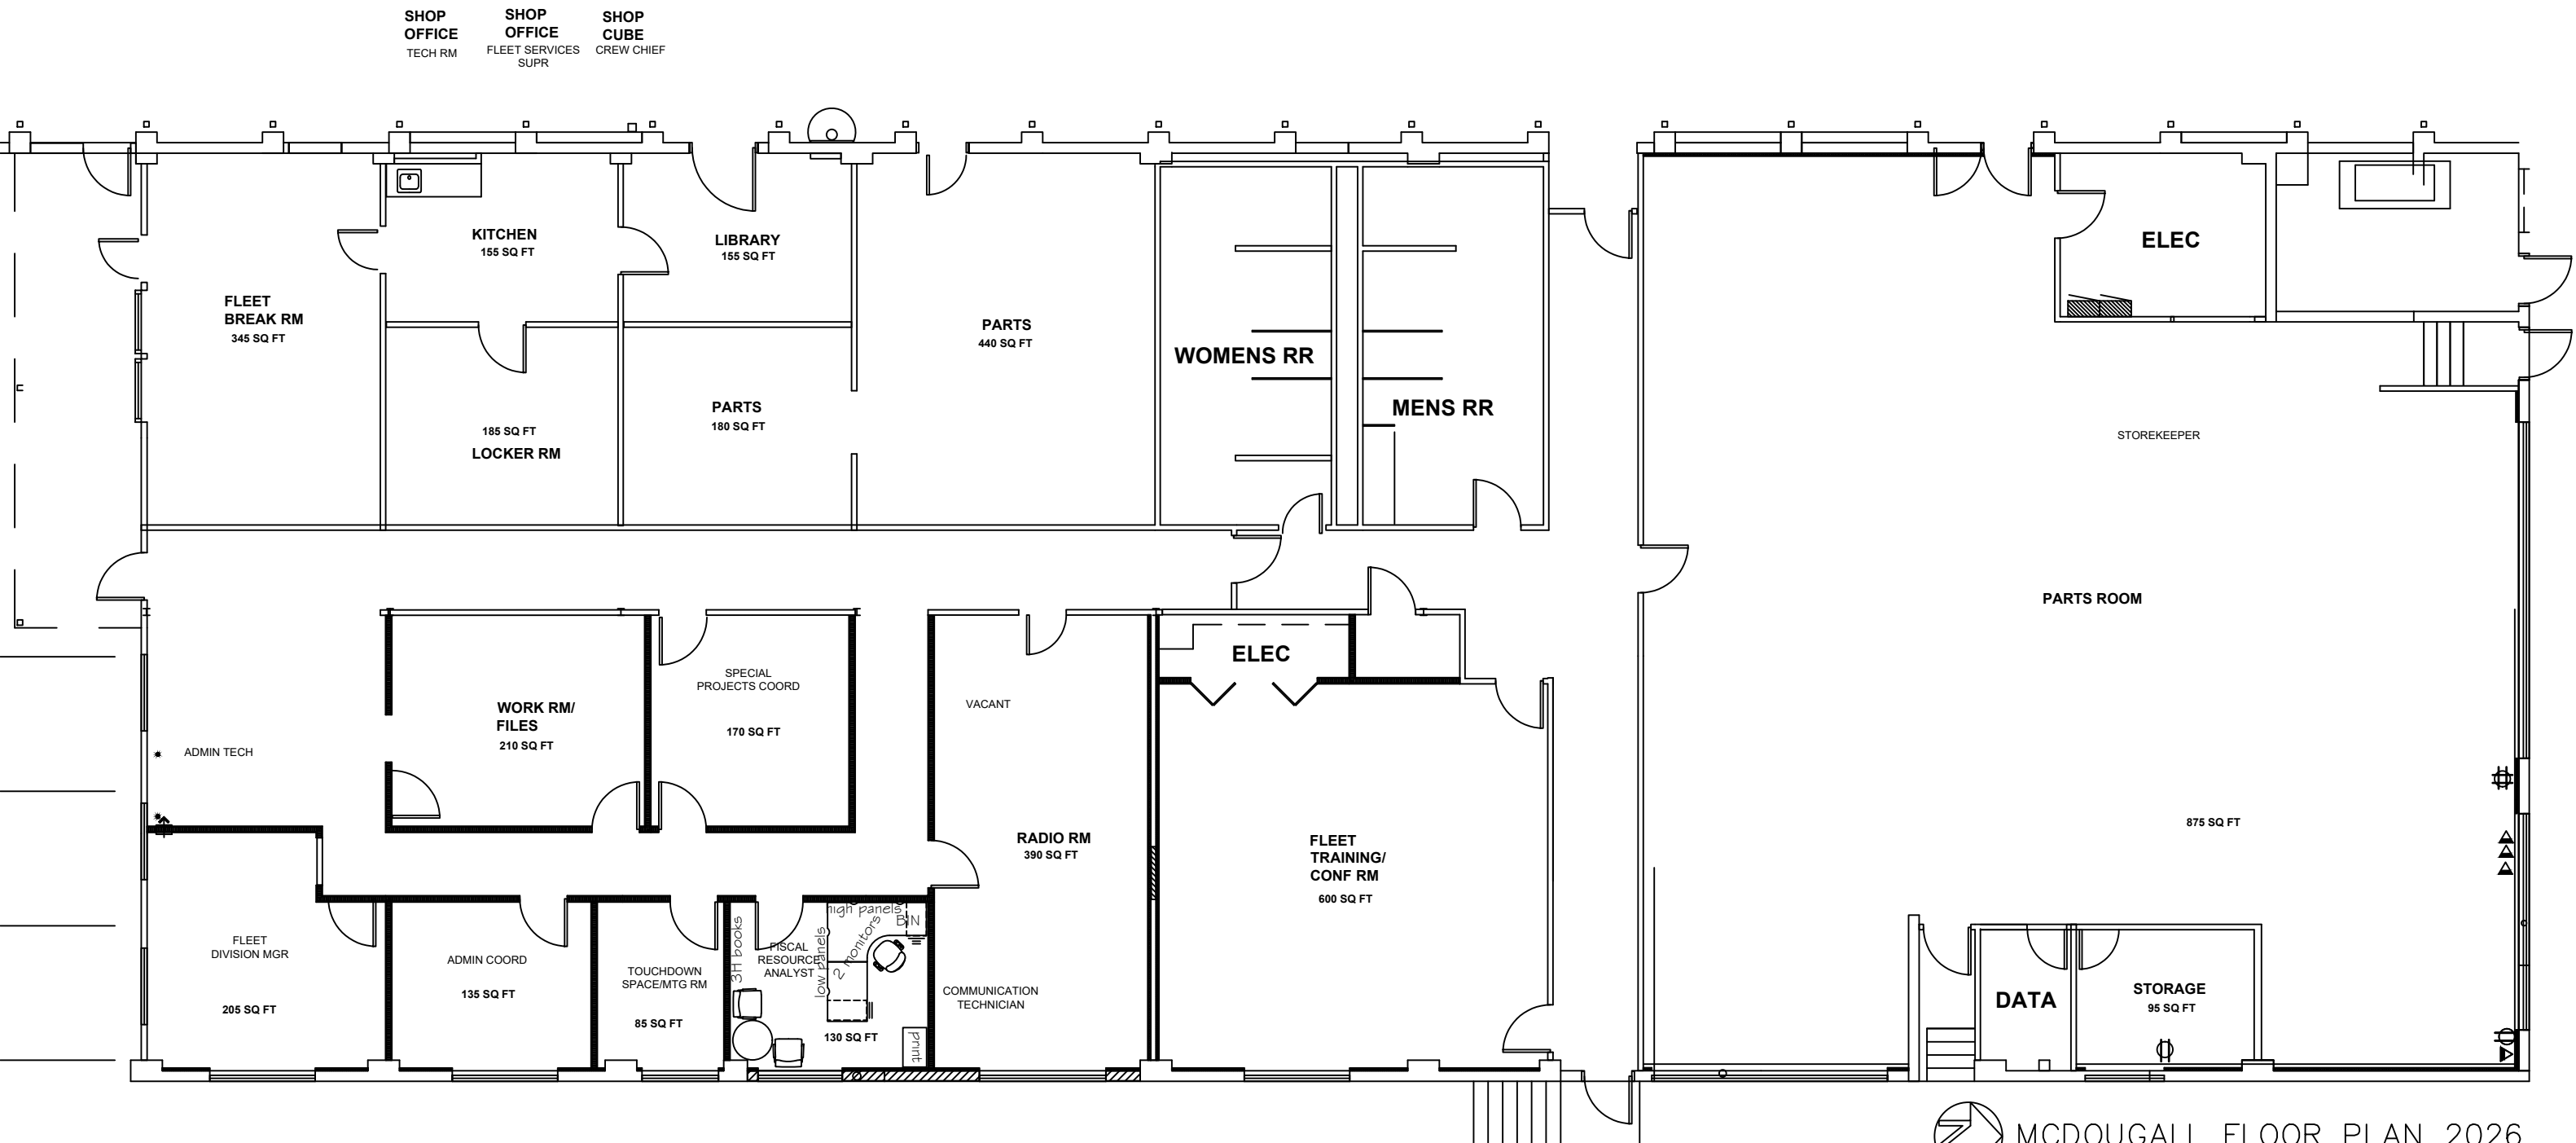

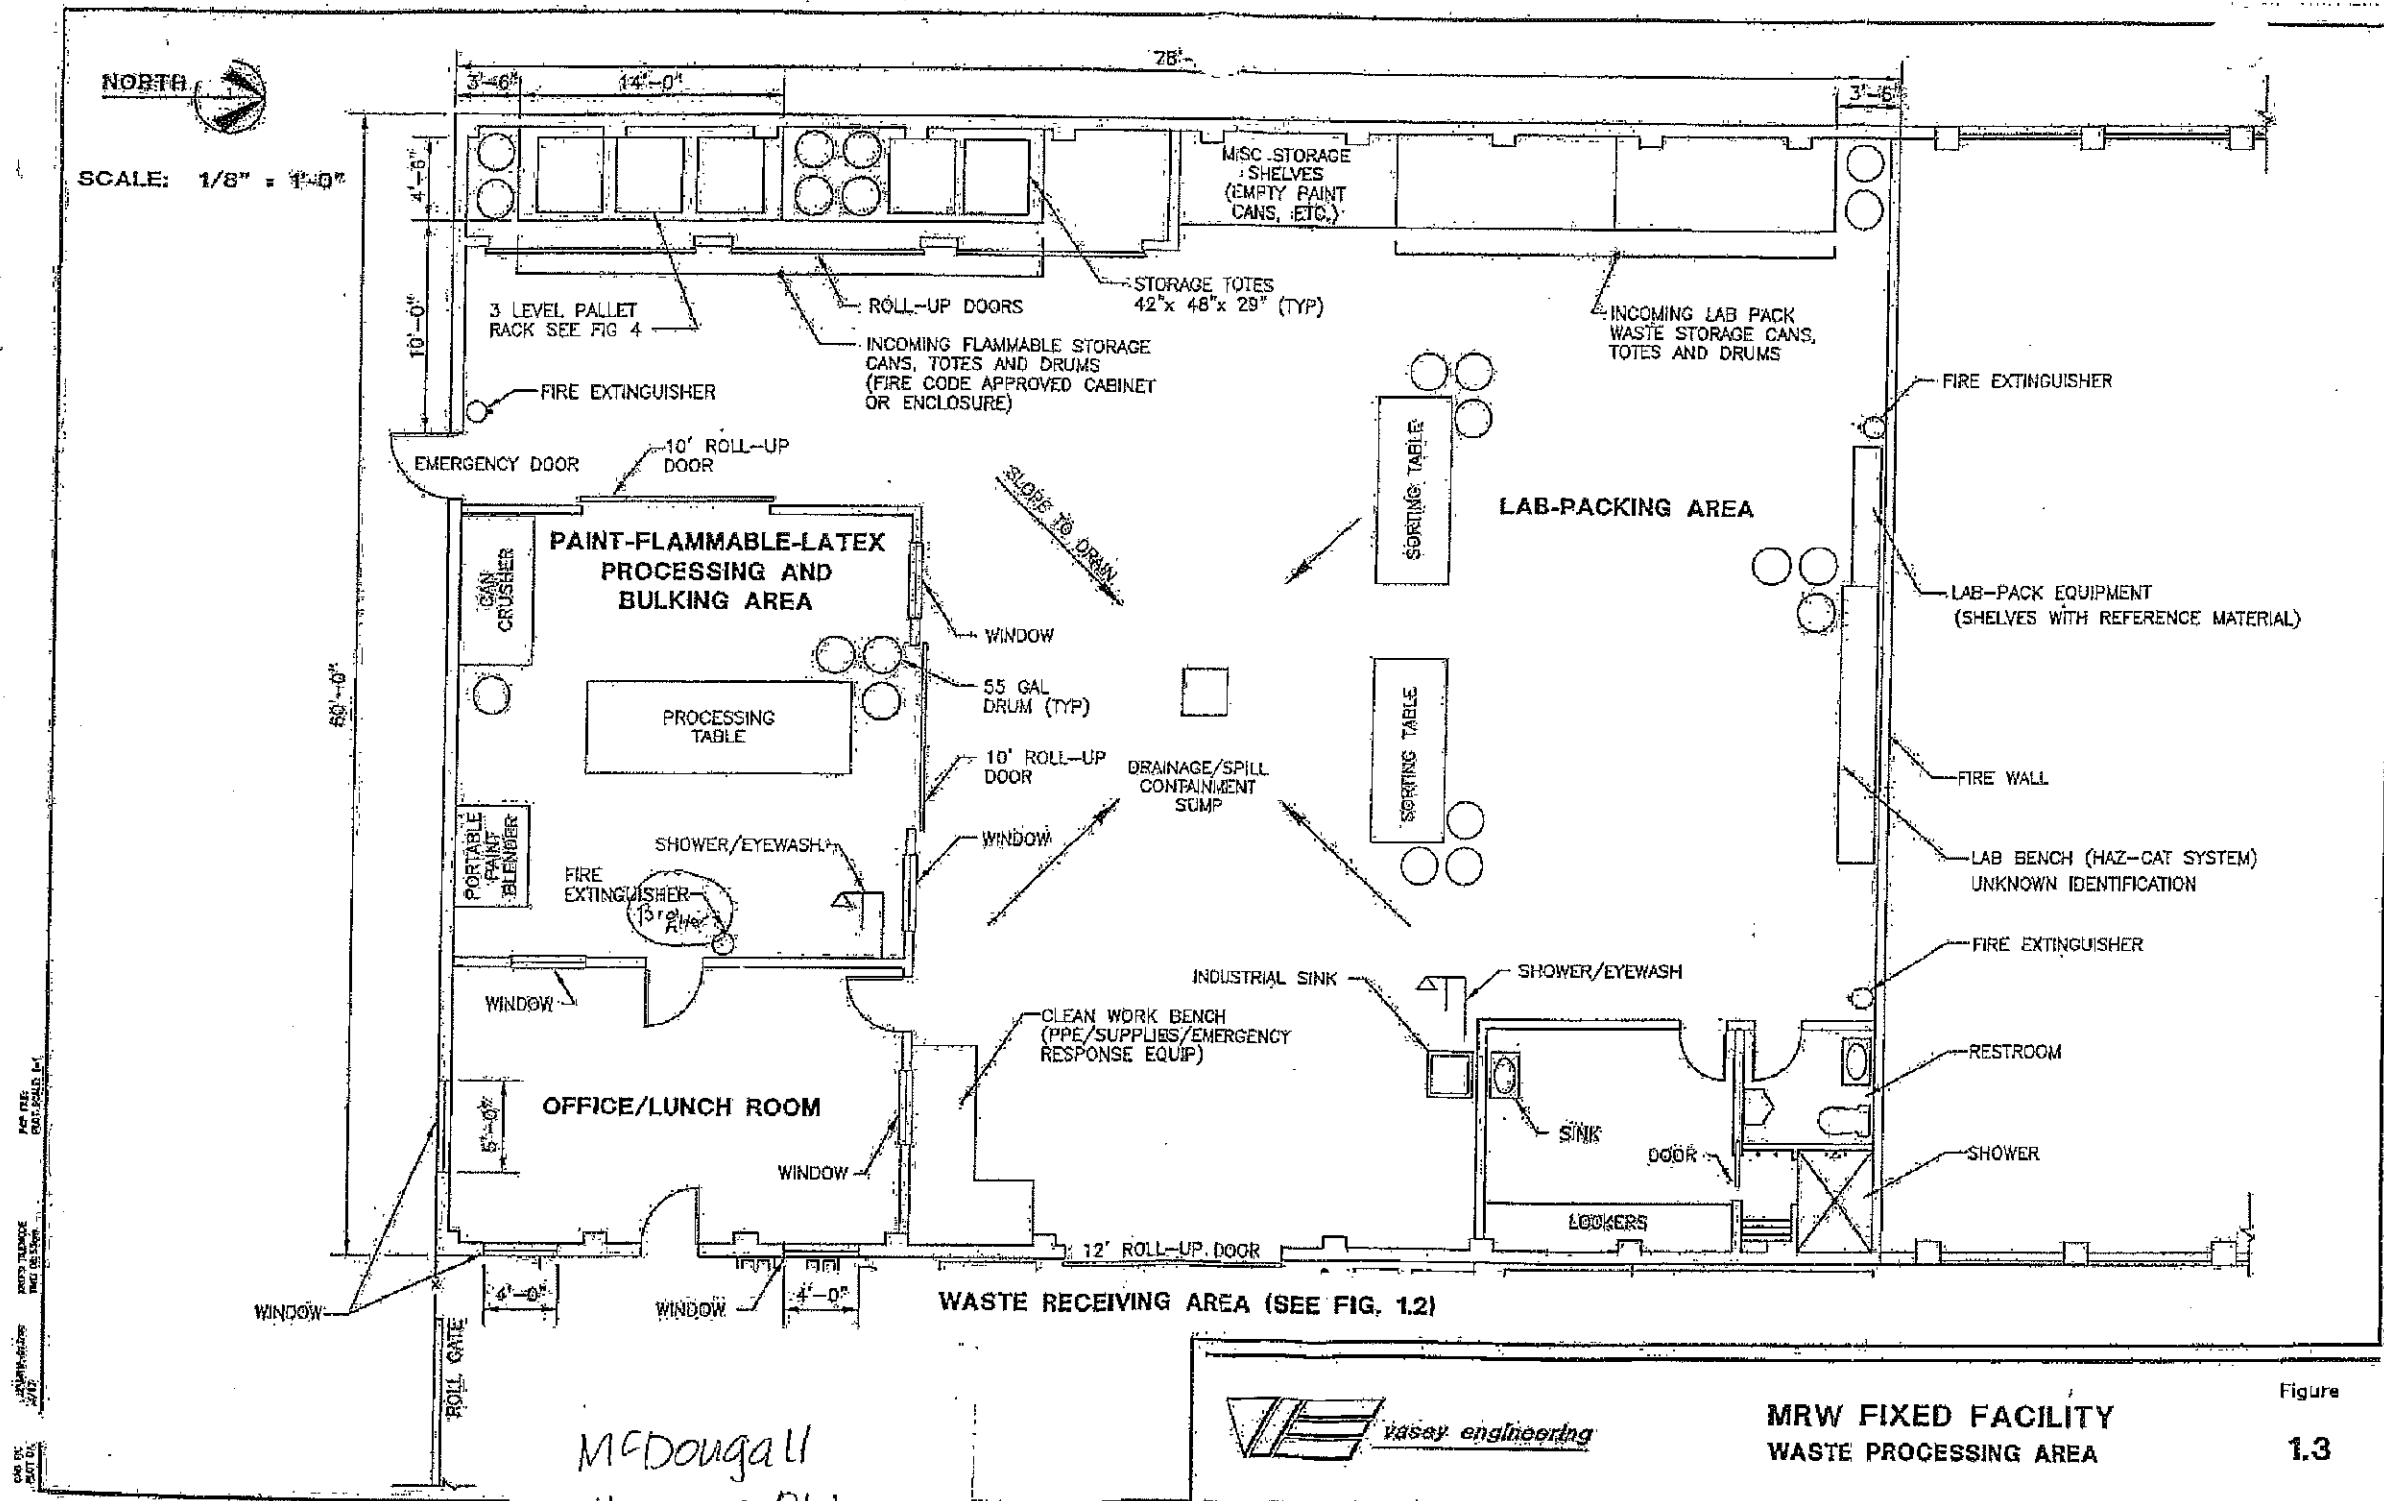

McDougal
Haz Mat Bldg.

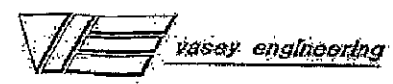




MRW FIXED FACILITY
WASTE PROCESSING AREA

Figure
1.3



HAZARDOUS WASTE/MODERATE
RISK WASTE FACILITY (HHW/MRW):
MGR GRENINGER
MRW SUPR, SWINT
MRW TECH III TEMP, JOHNSON
MRW TECH II, KAYSER
MRW TECH II, MOLITER
MRW TECH II, CARTER
2026

EAST

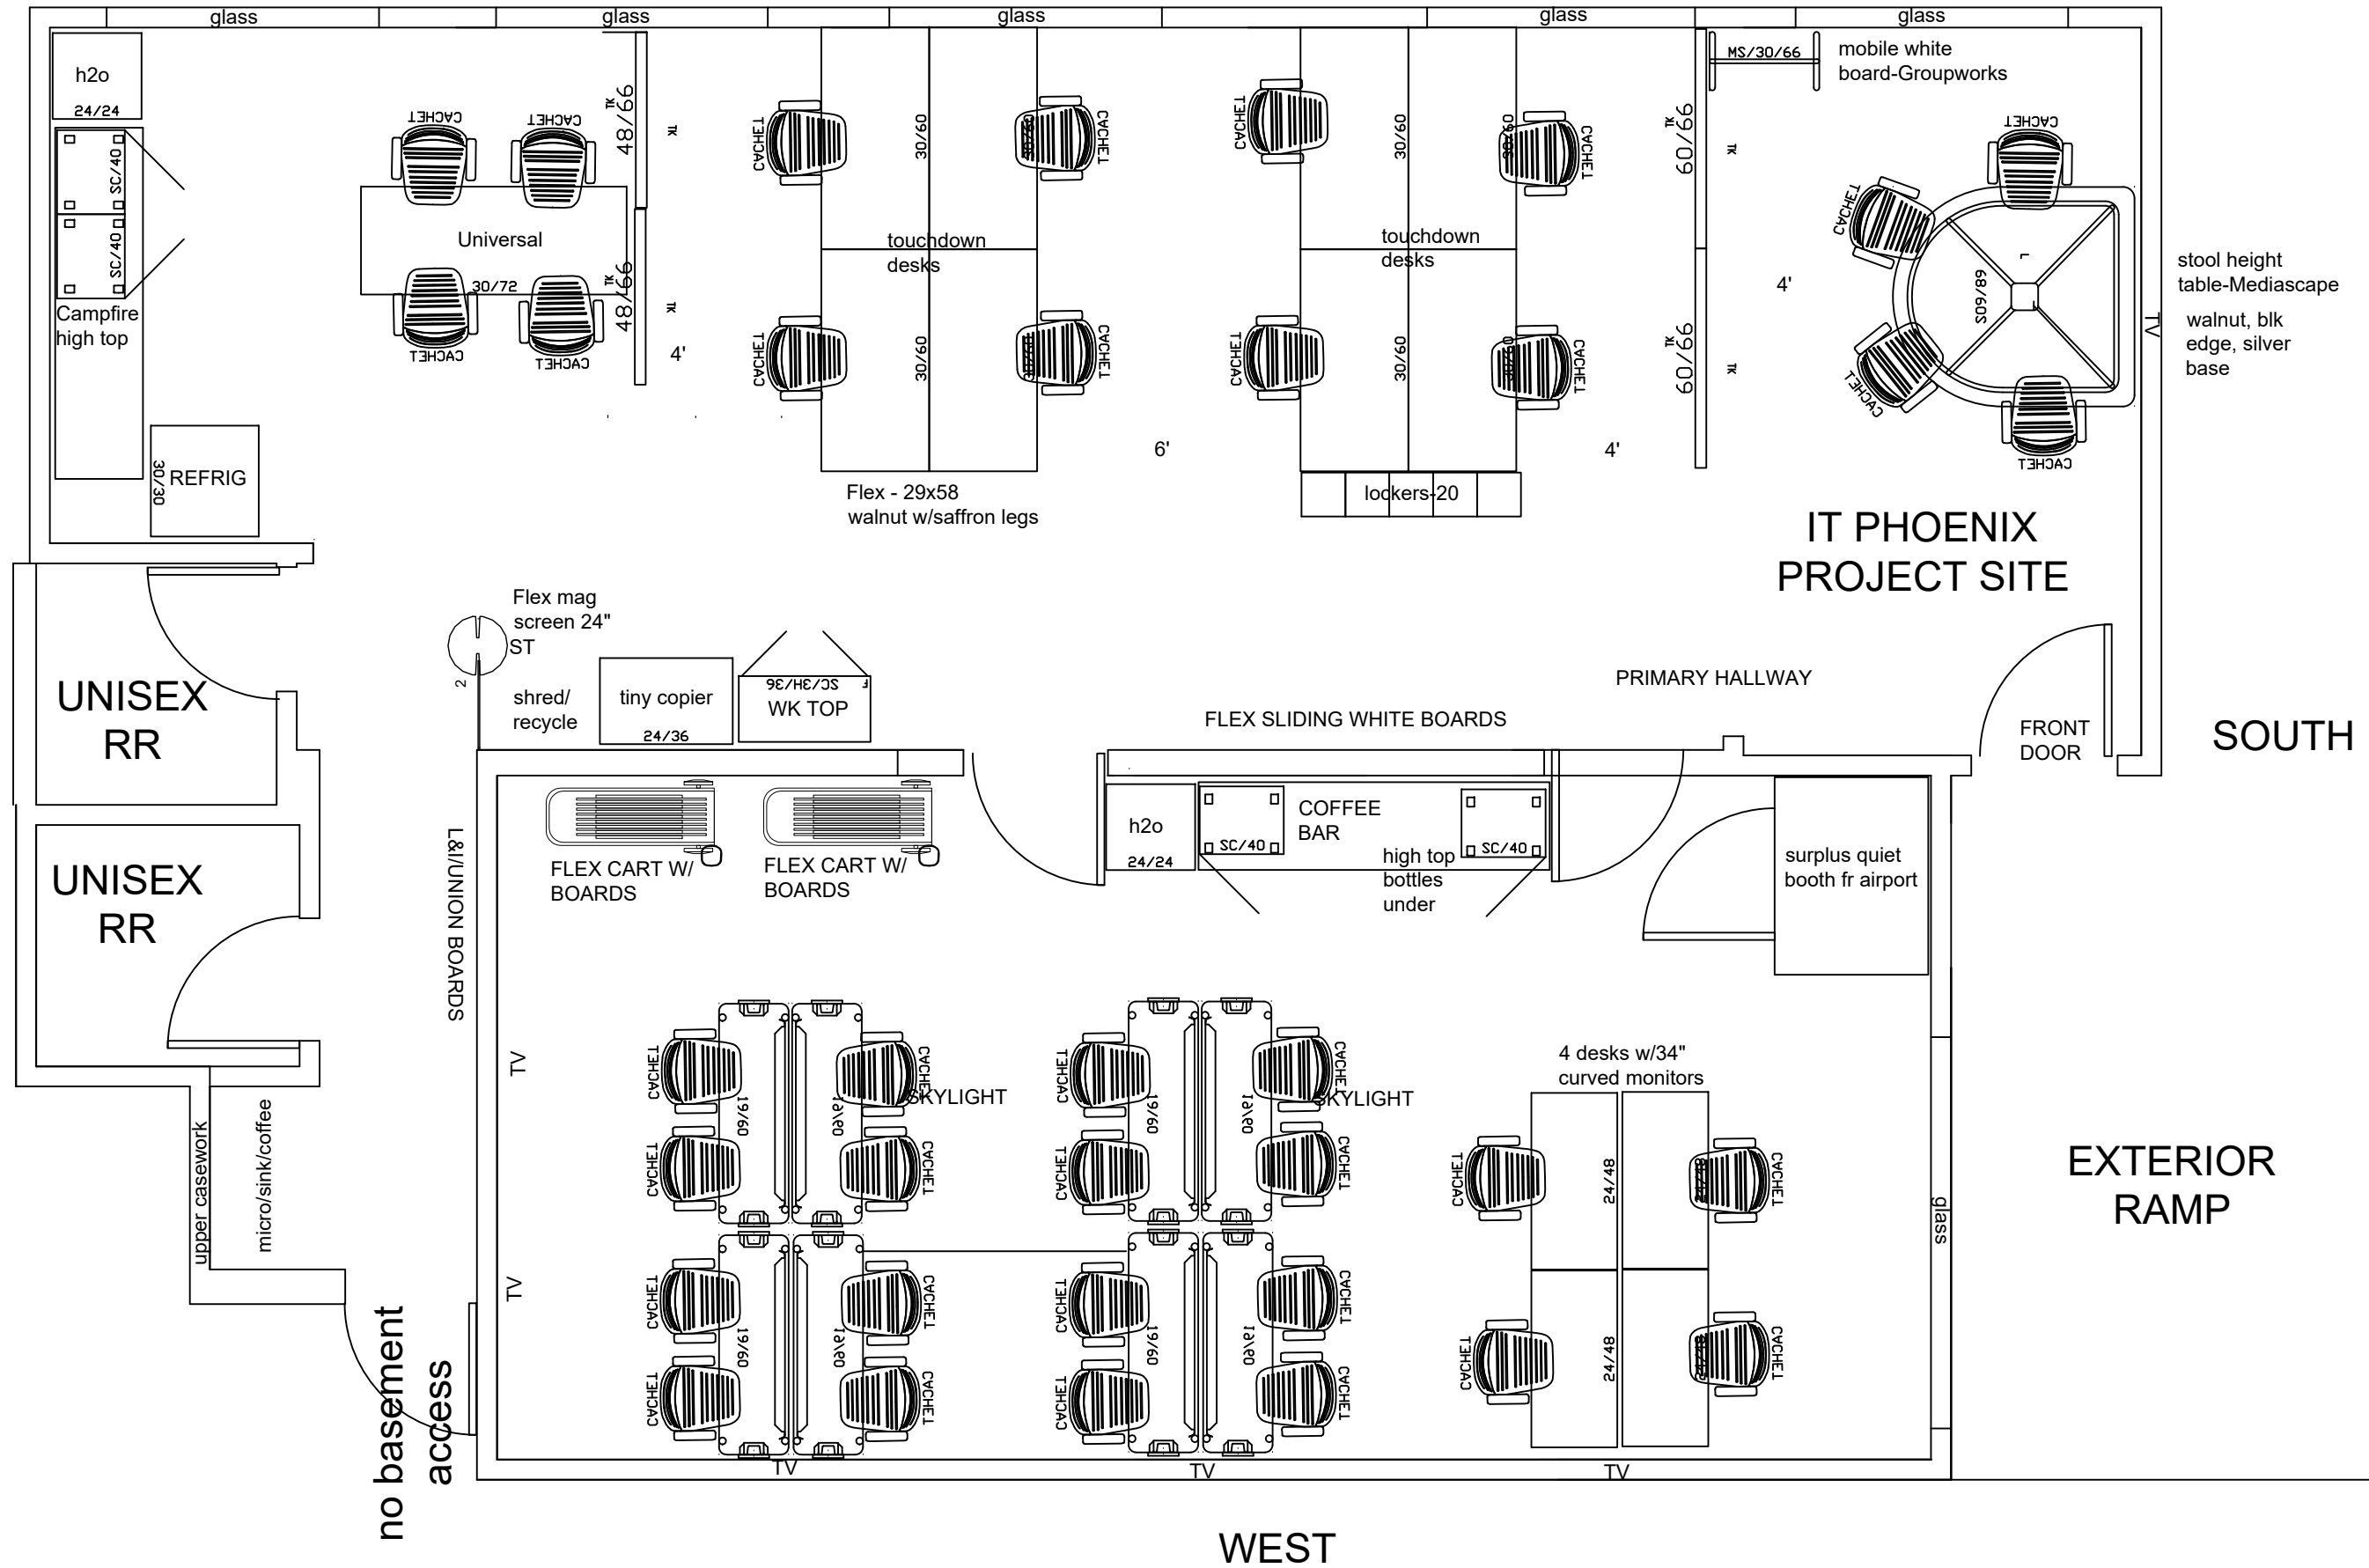


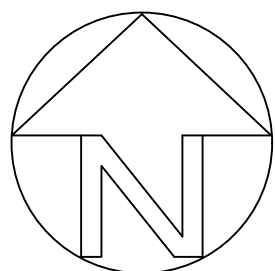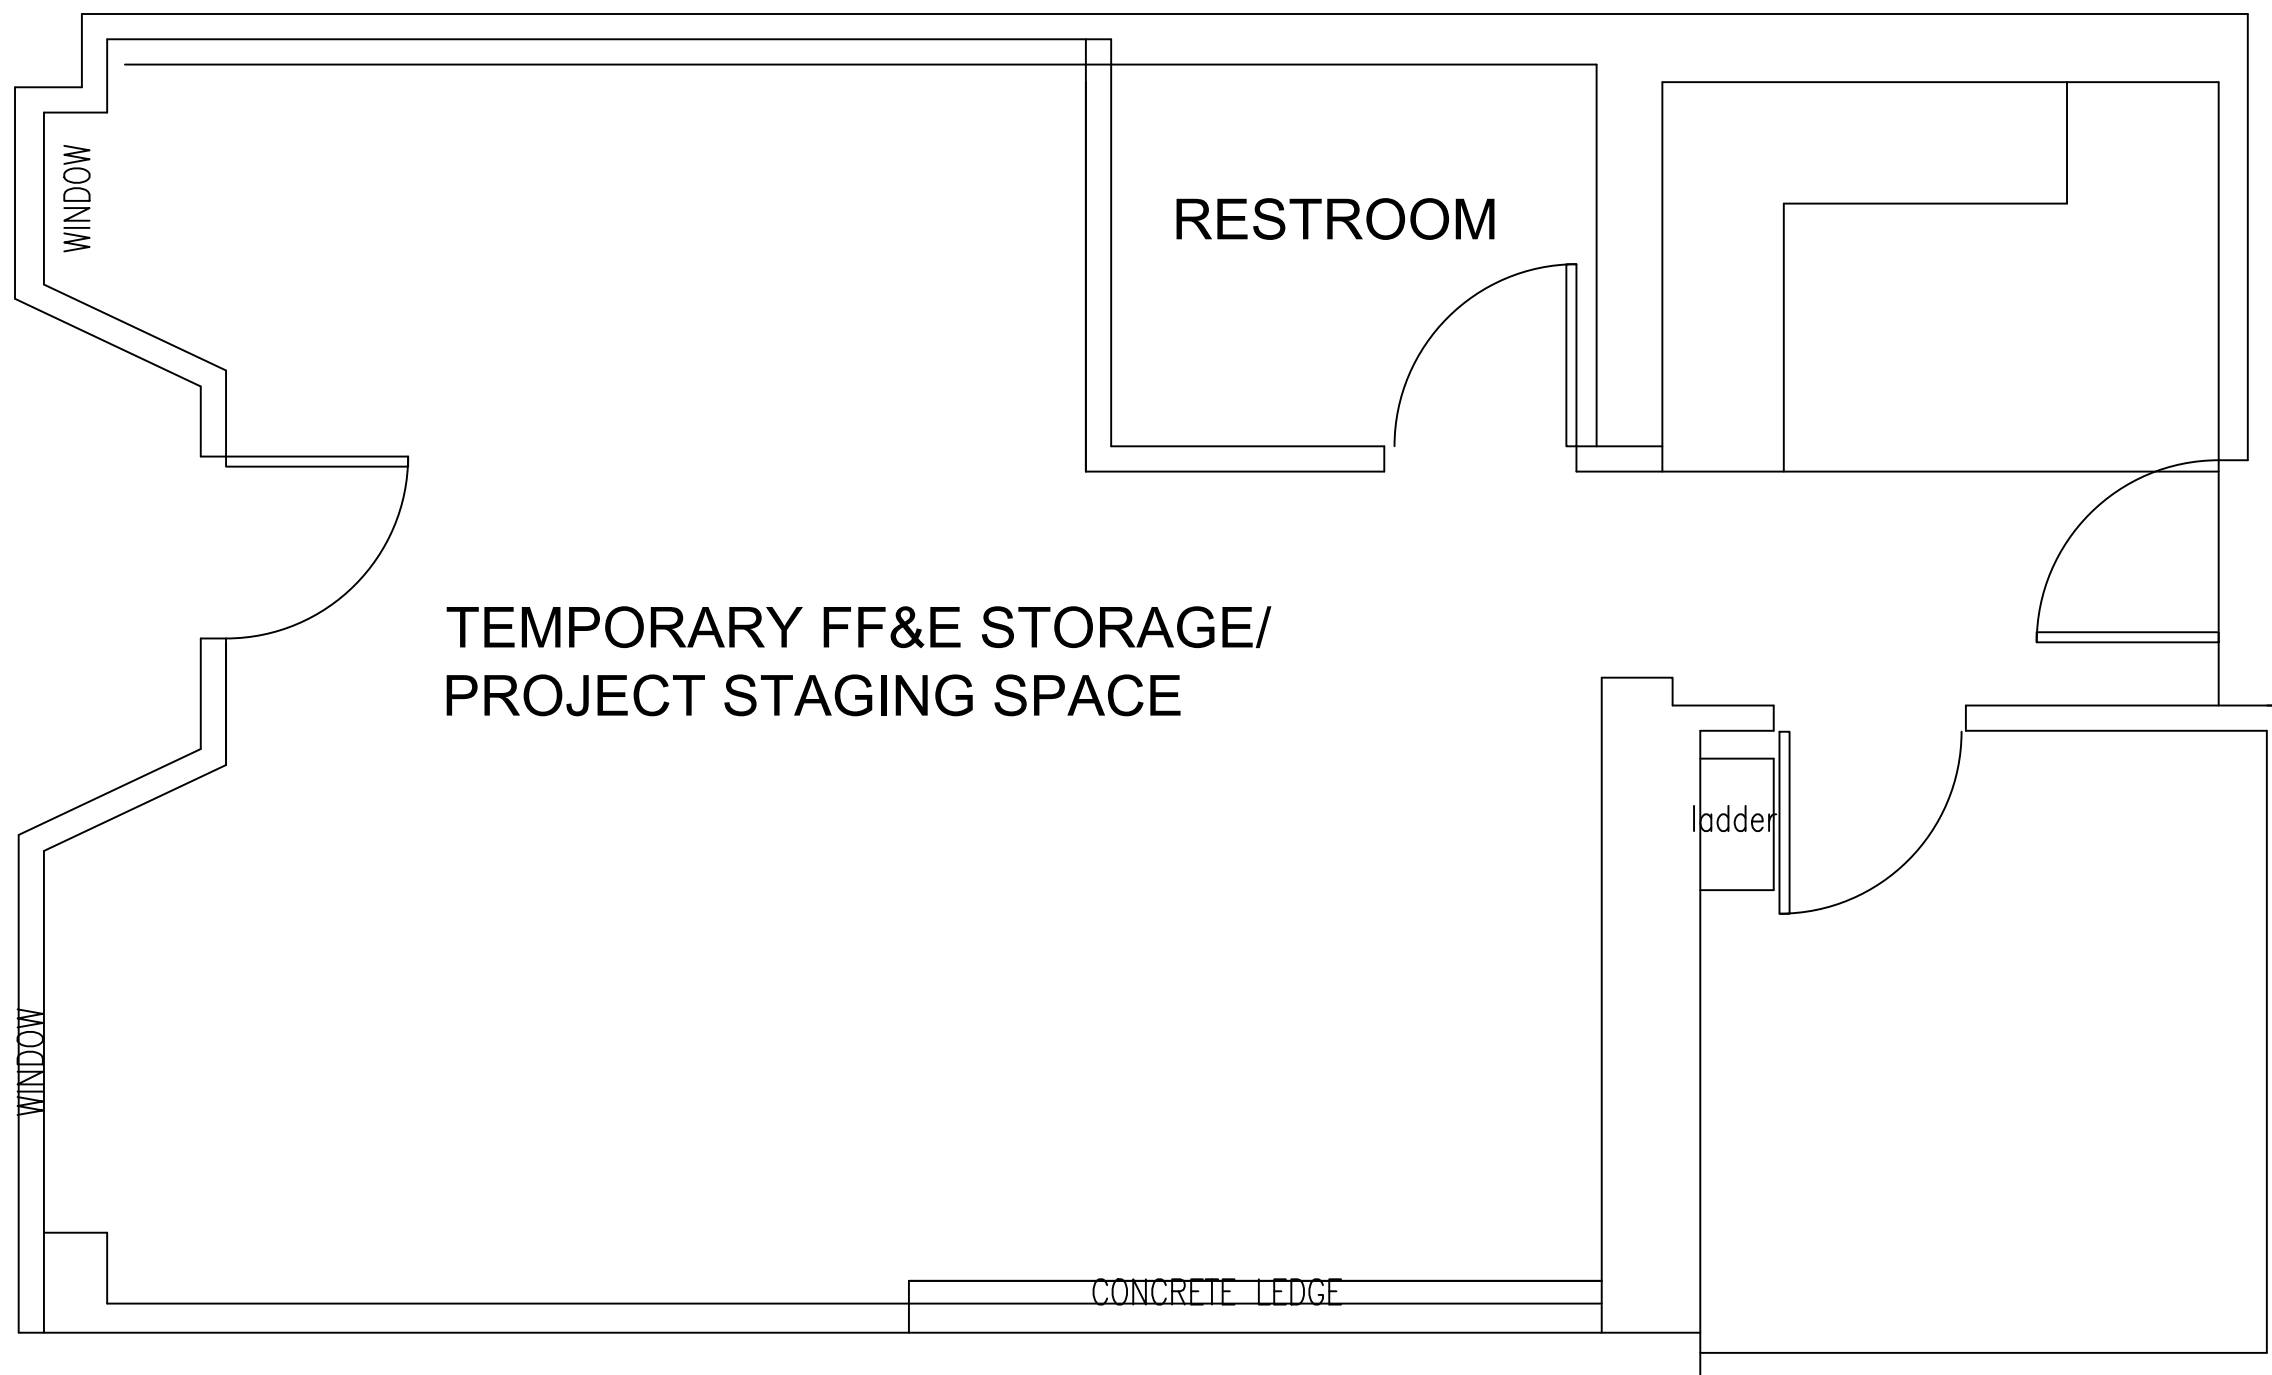


NORTH CAMPUS BLDG B 2026

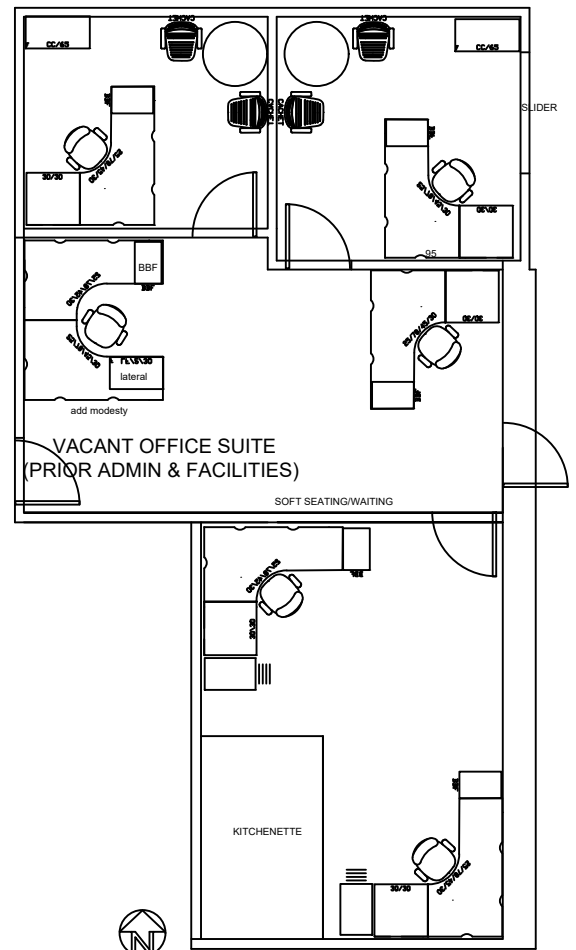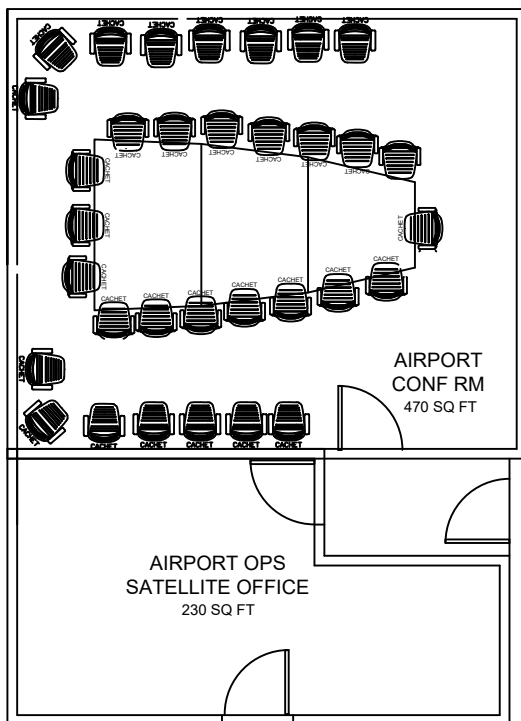

AIRPORT C3, 1ST FL 2026

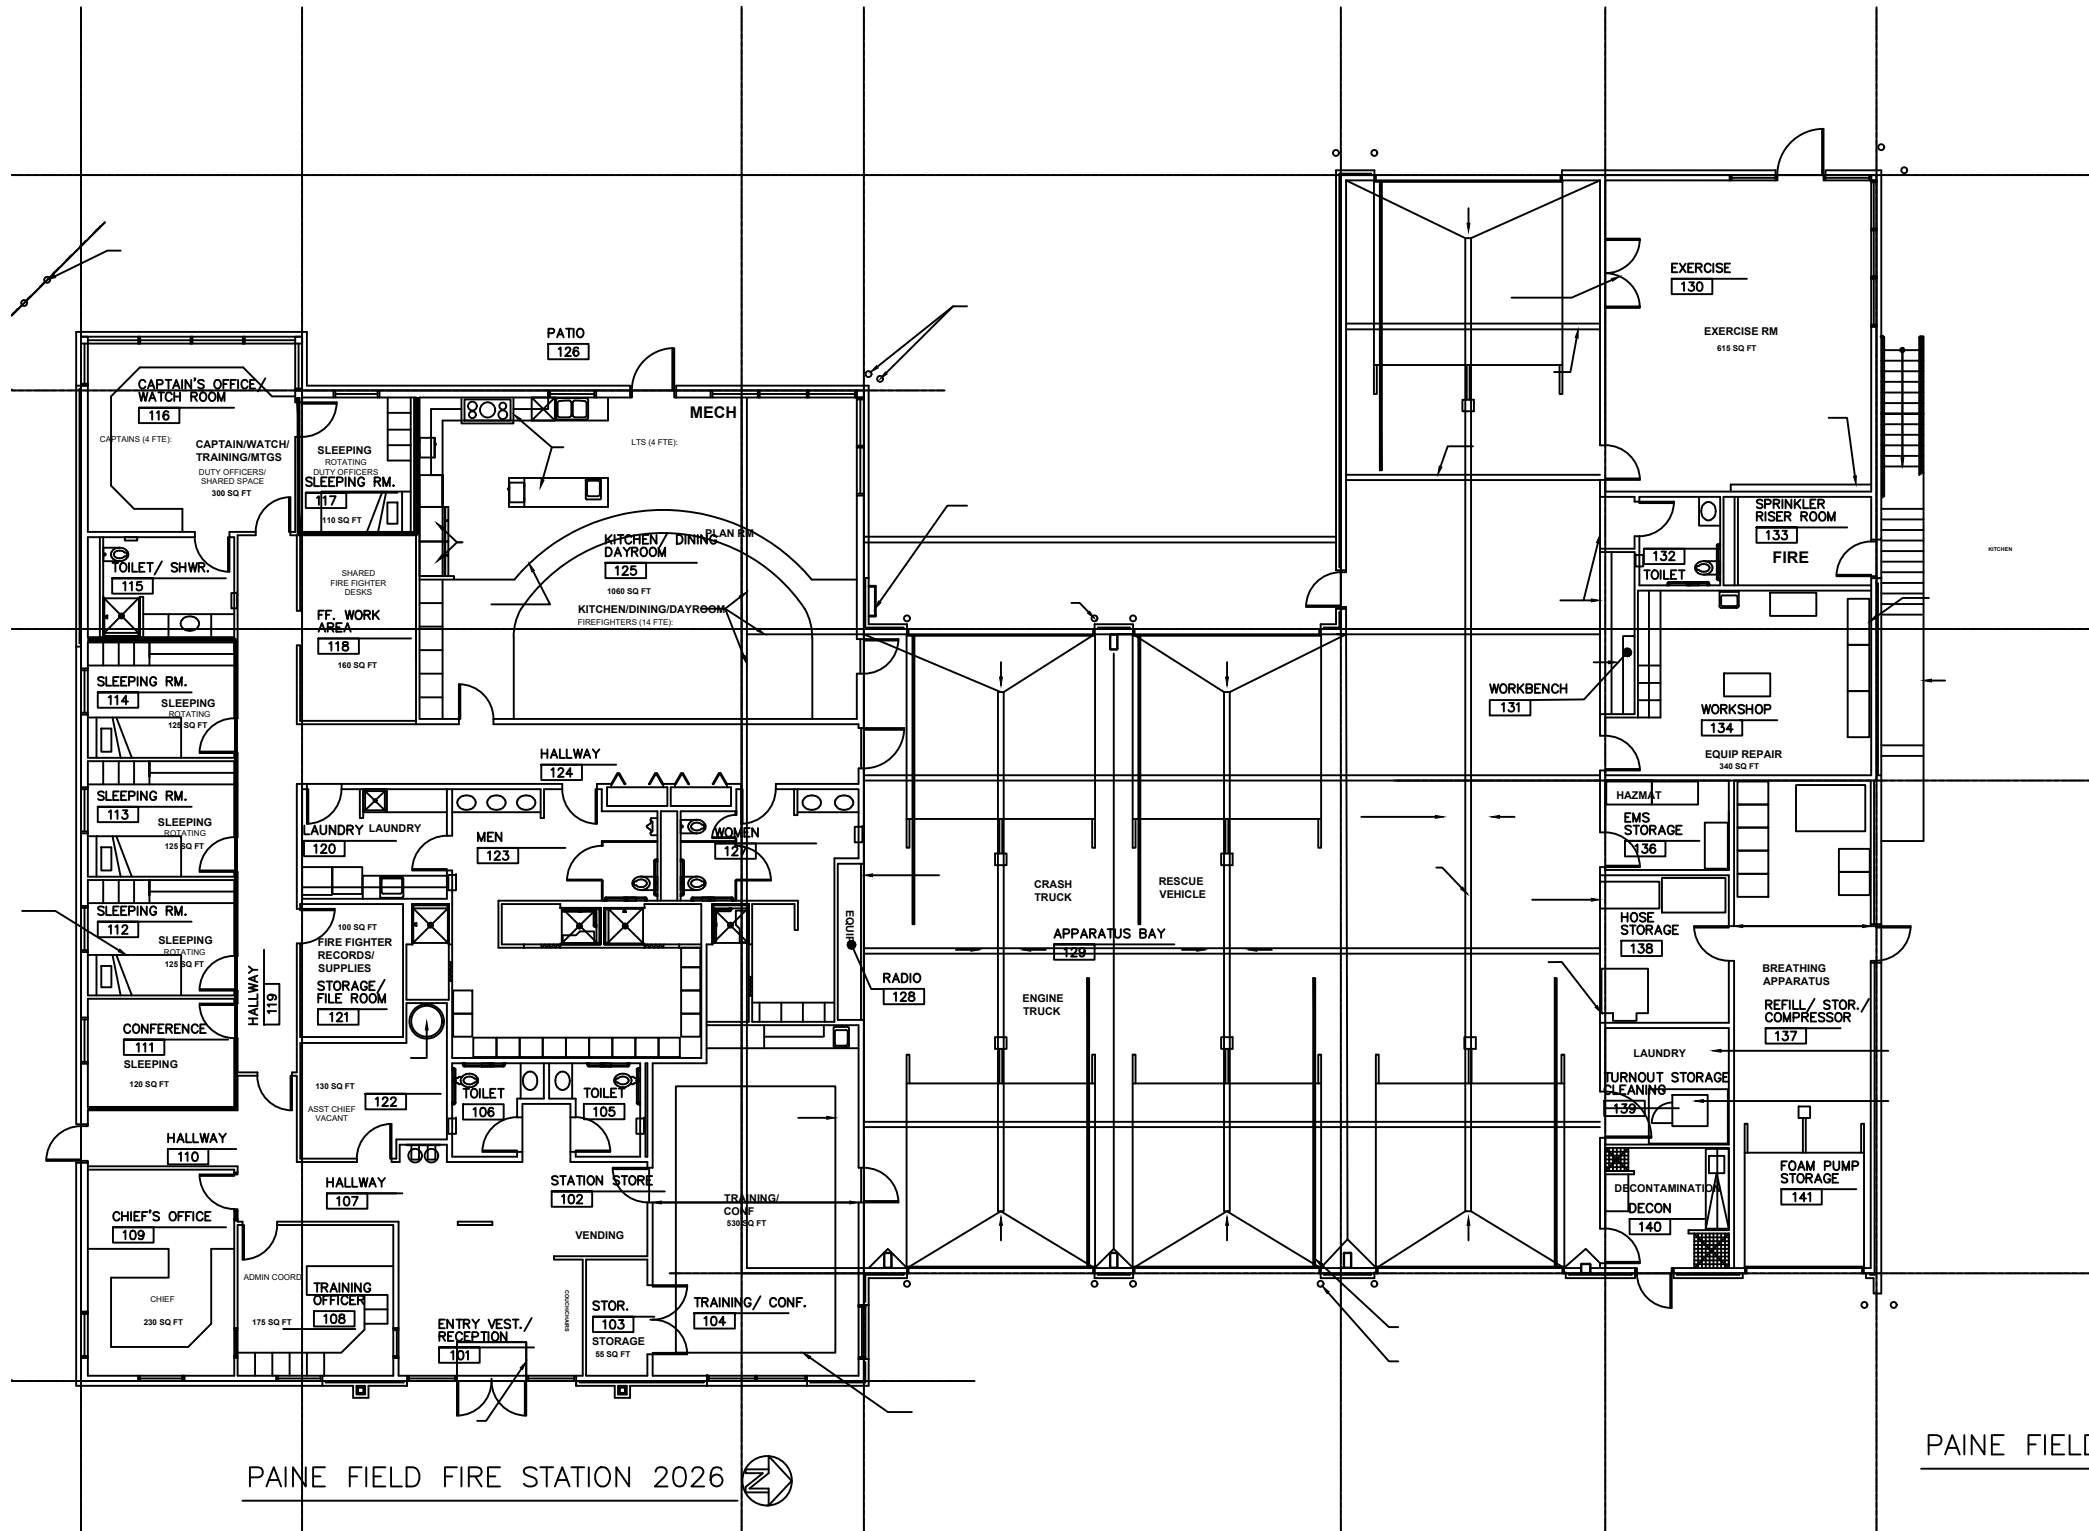

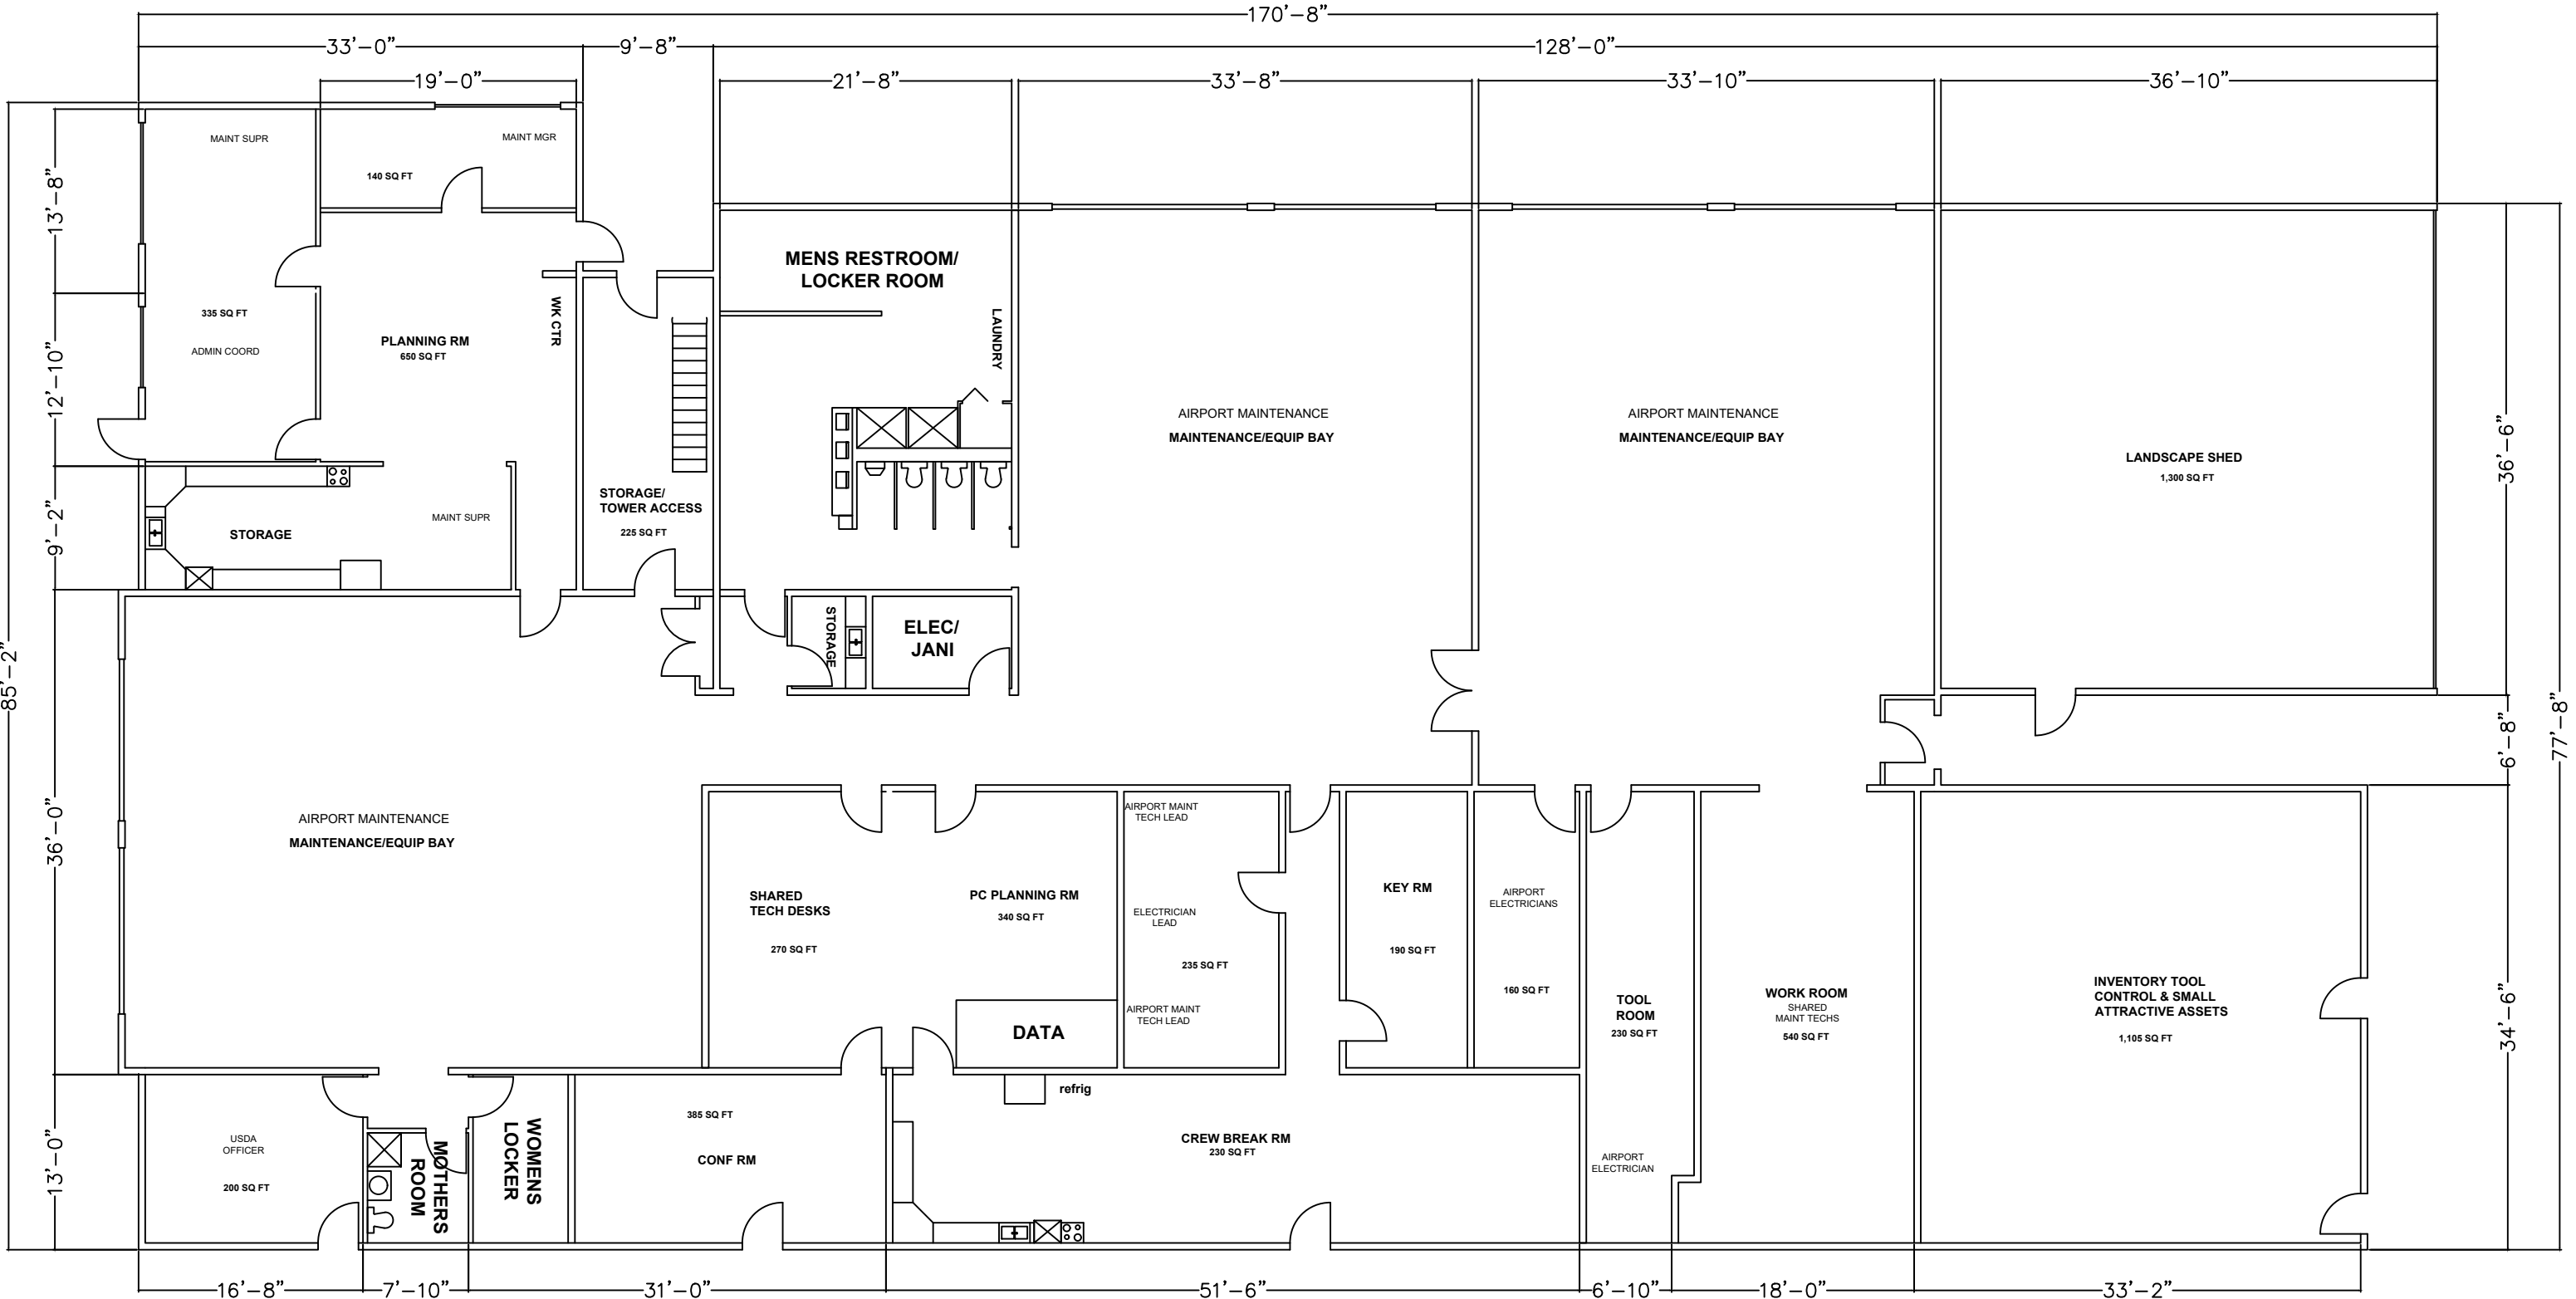



AIRPORT MAINTENANCE BUILDING #219 2026
SCALE 1"= 32'-0"





DRAWING WAS DRAWN TO THE SCALE THAT MATCHED THE DIMENSIONS ON THE DRAWING NOT TO THE SCALE THAT WAS PROVIDED.

THE DRAWING WAS SCALED DOWN BEFORE BEING PROVIDED TO CORRECTIONAL INDUSTRIES. THEREFORE, THE ACCURACY OF THE DRAWING IS IN QUESTION AND WILL NEED TO BE VERIFIED BEFORE THIS DRAWING IS USED FOR REPRODUCTION PURPOSES..

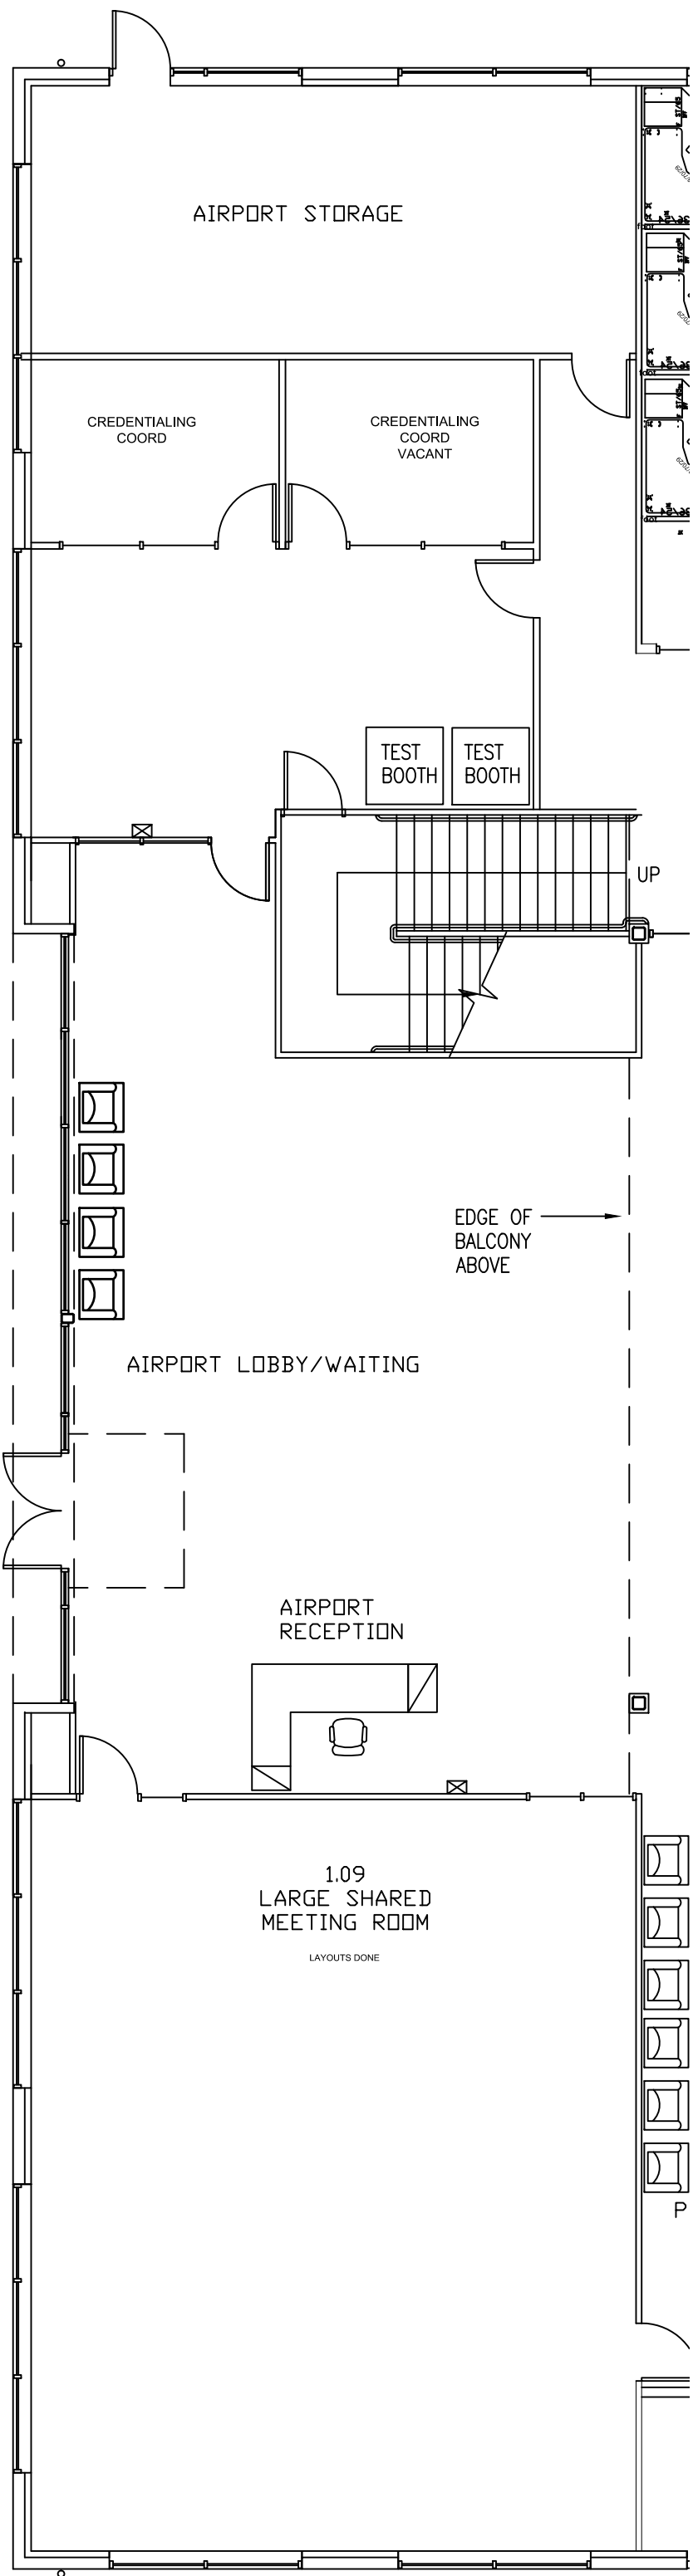


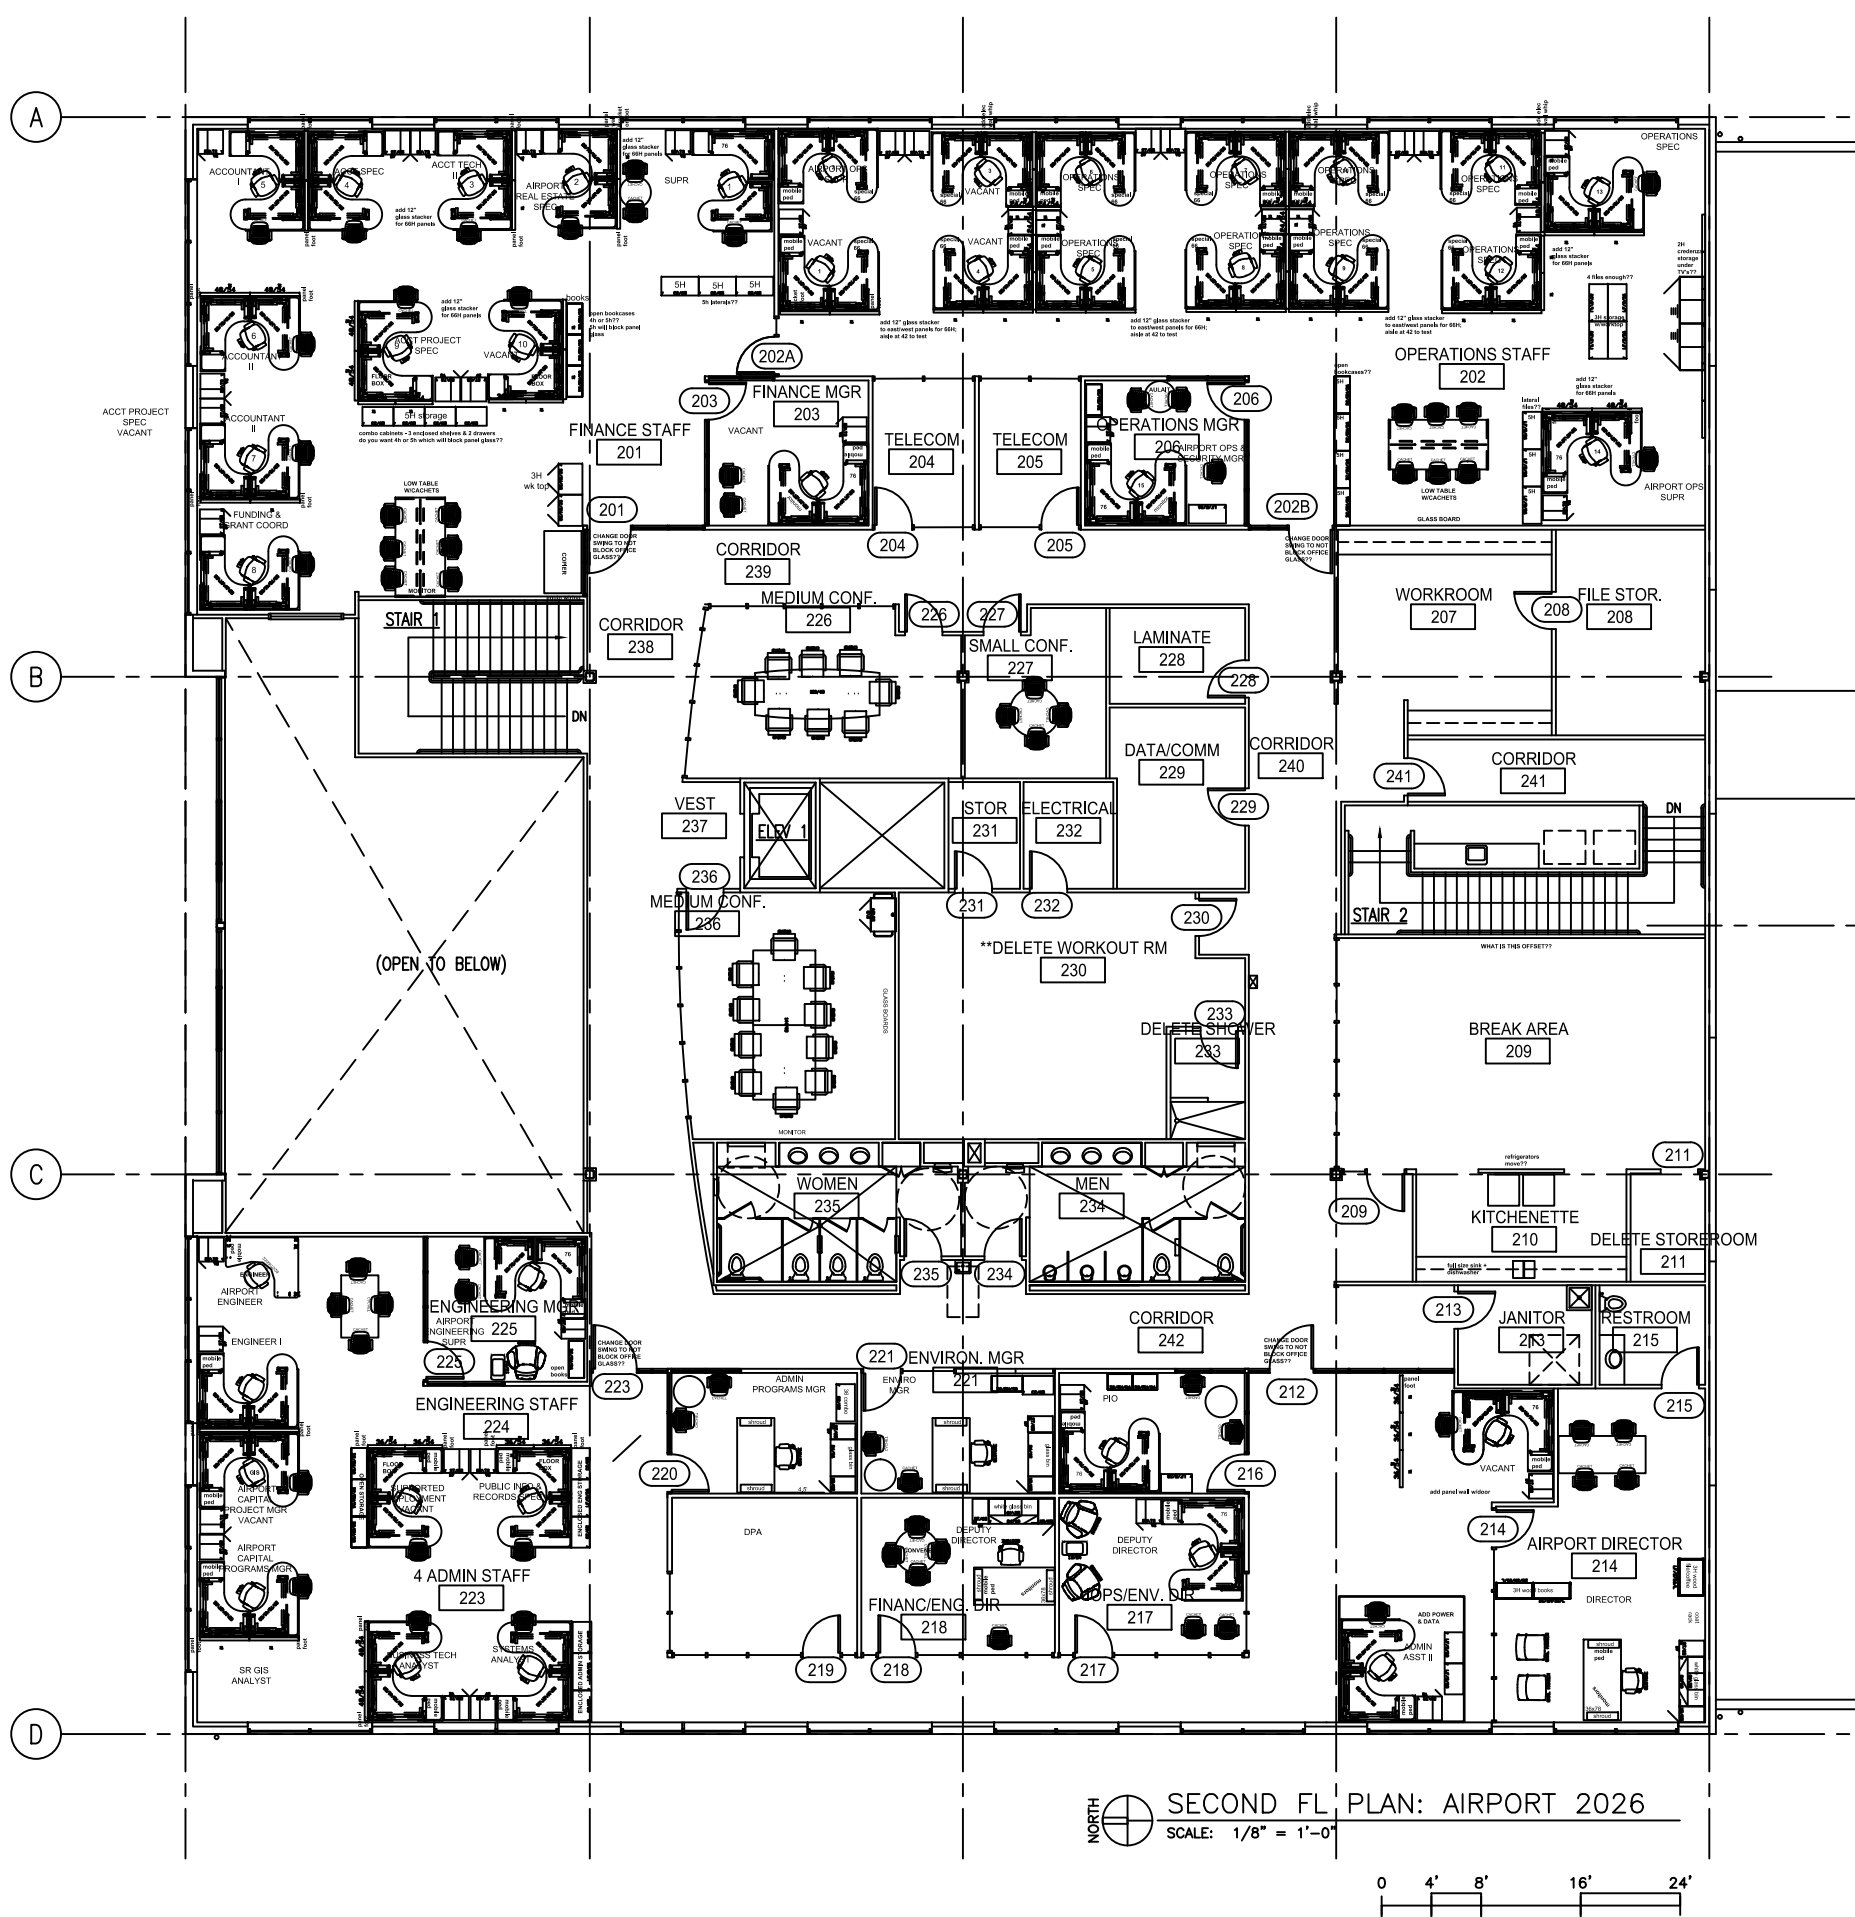


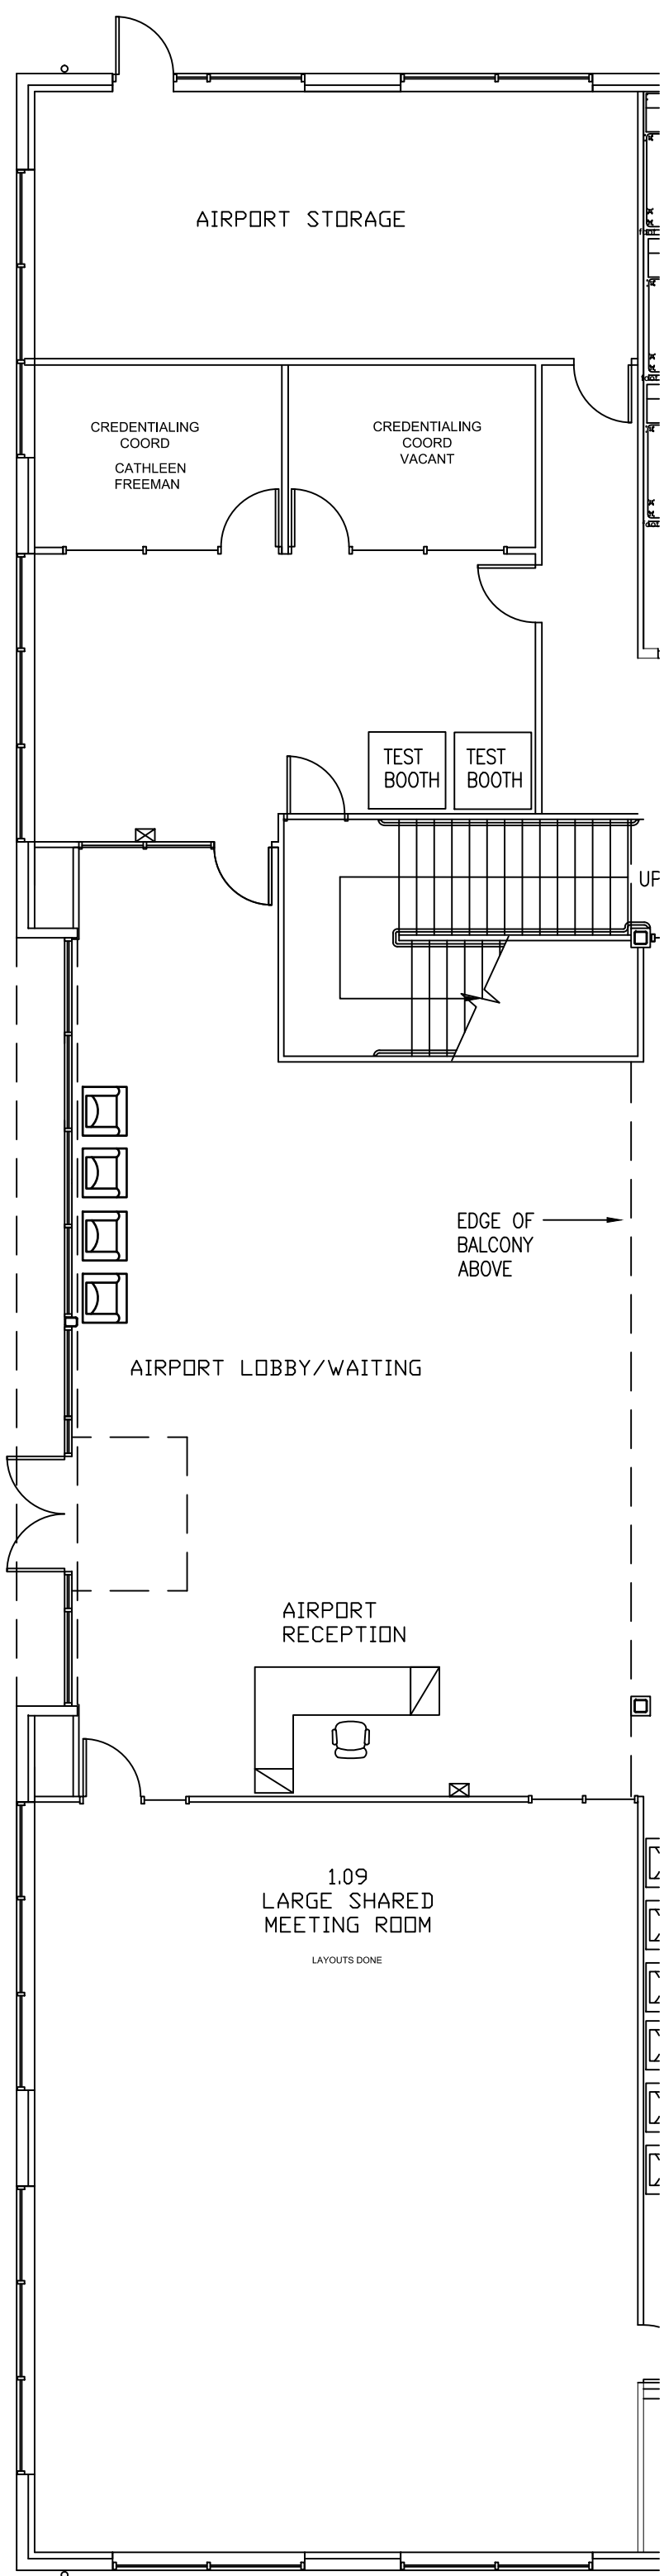


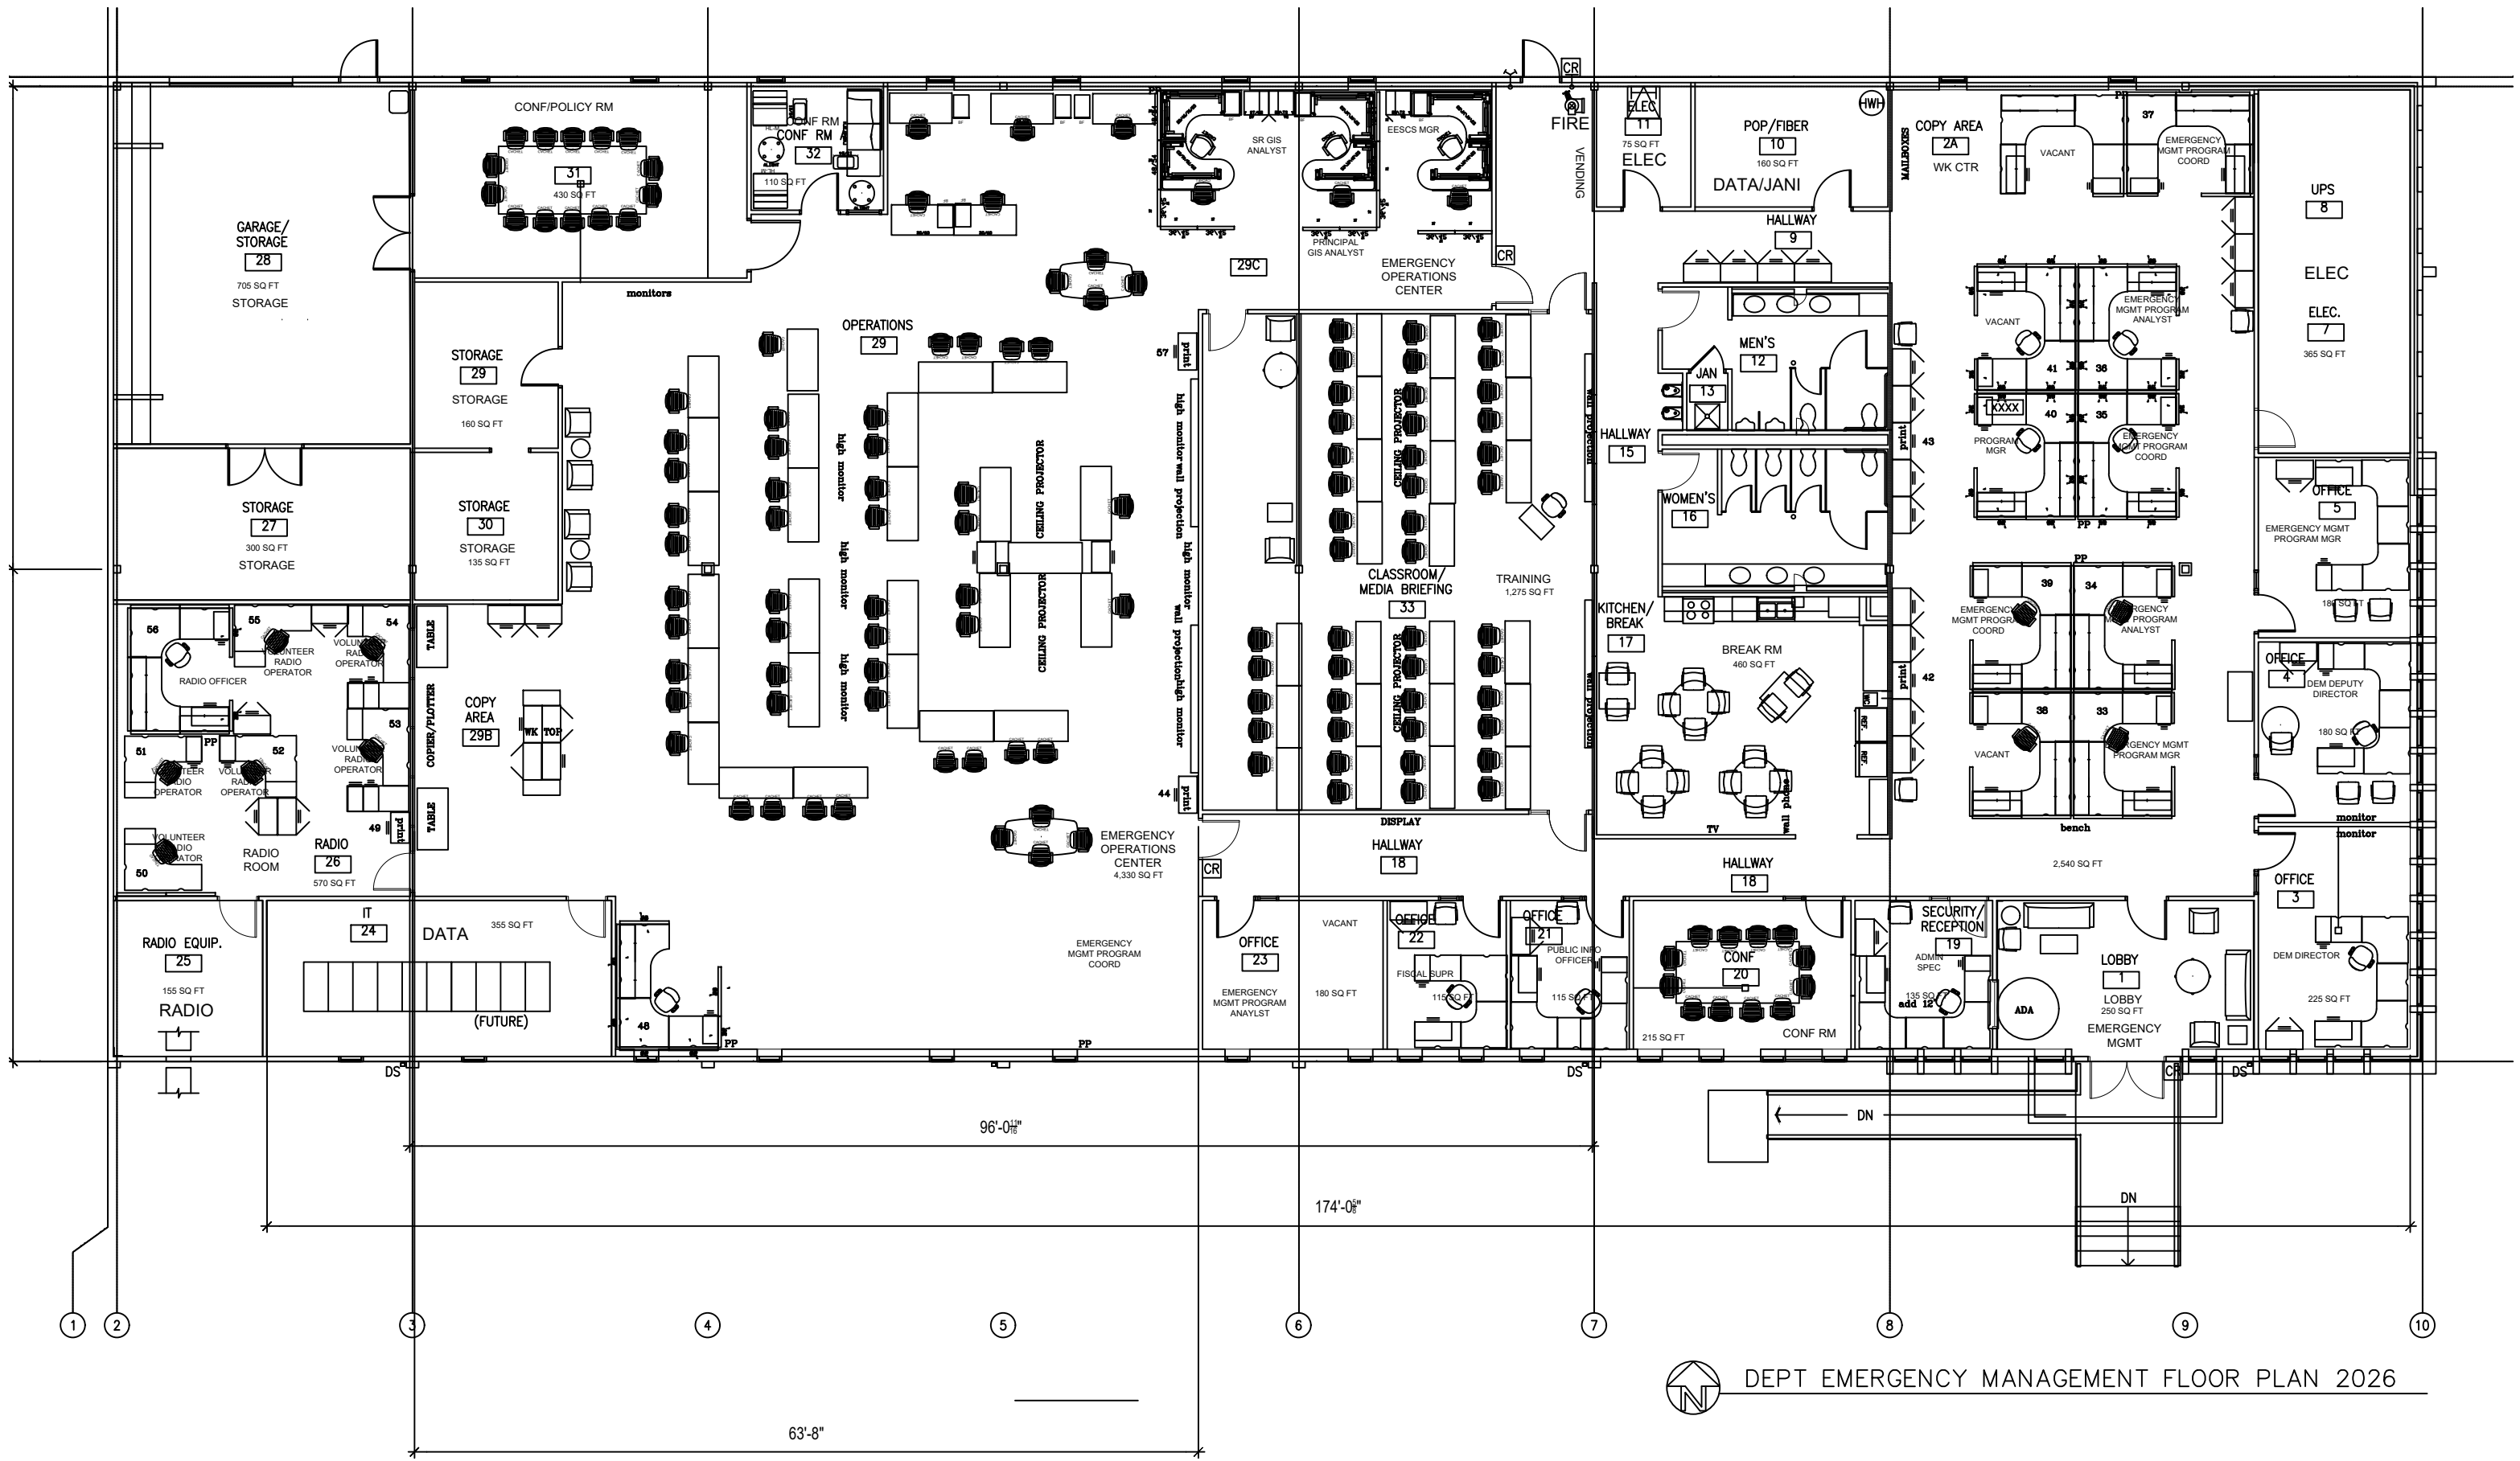

DEPT EMERGENCY MANAGEMENT FLOOR PLAN 2026

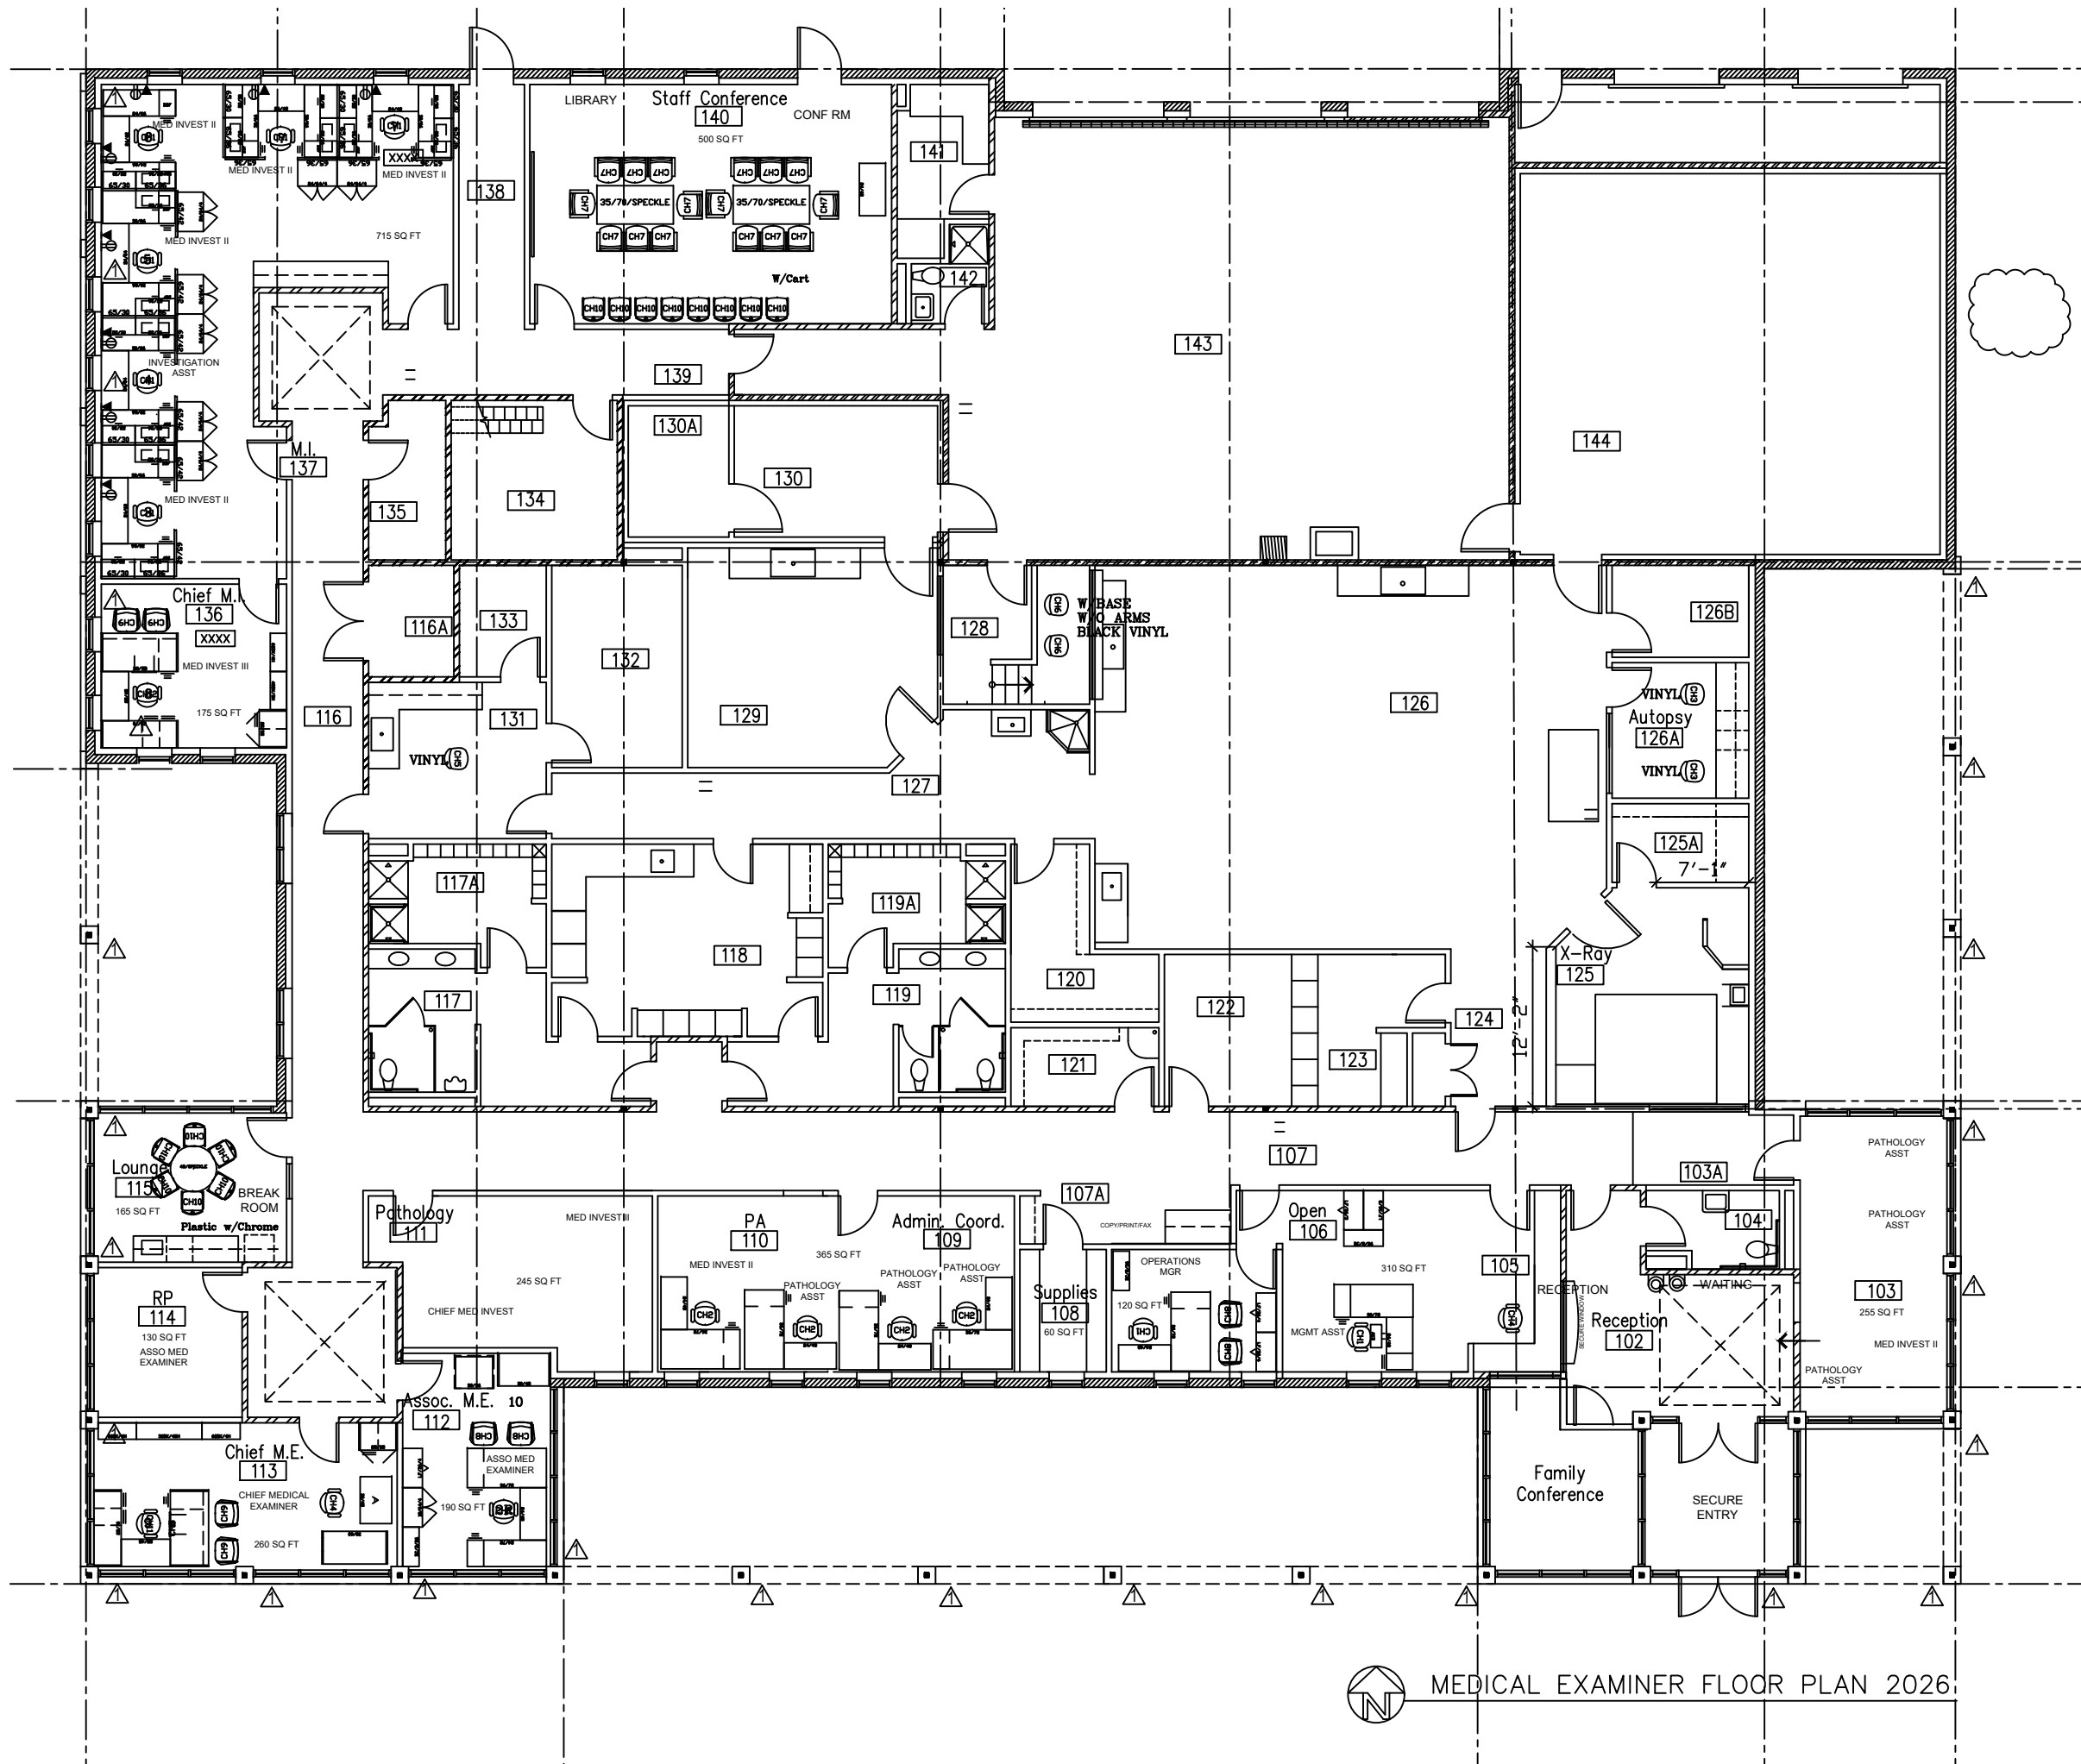

MEDICAL EXAMINER FLOOR PLAN 2026

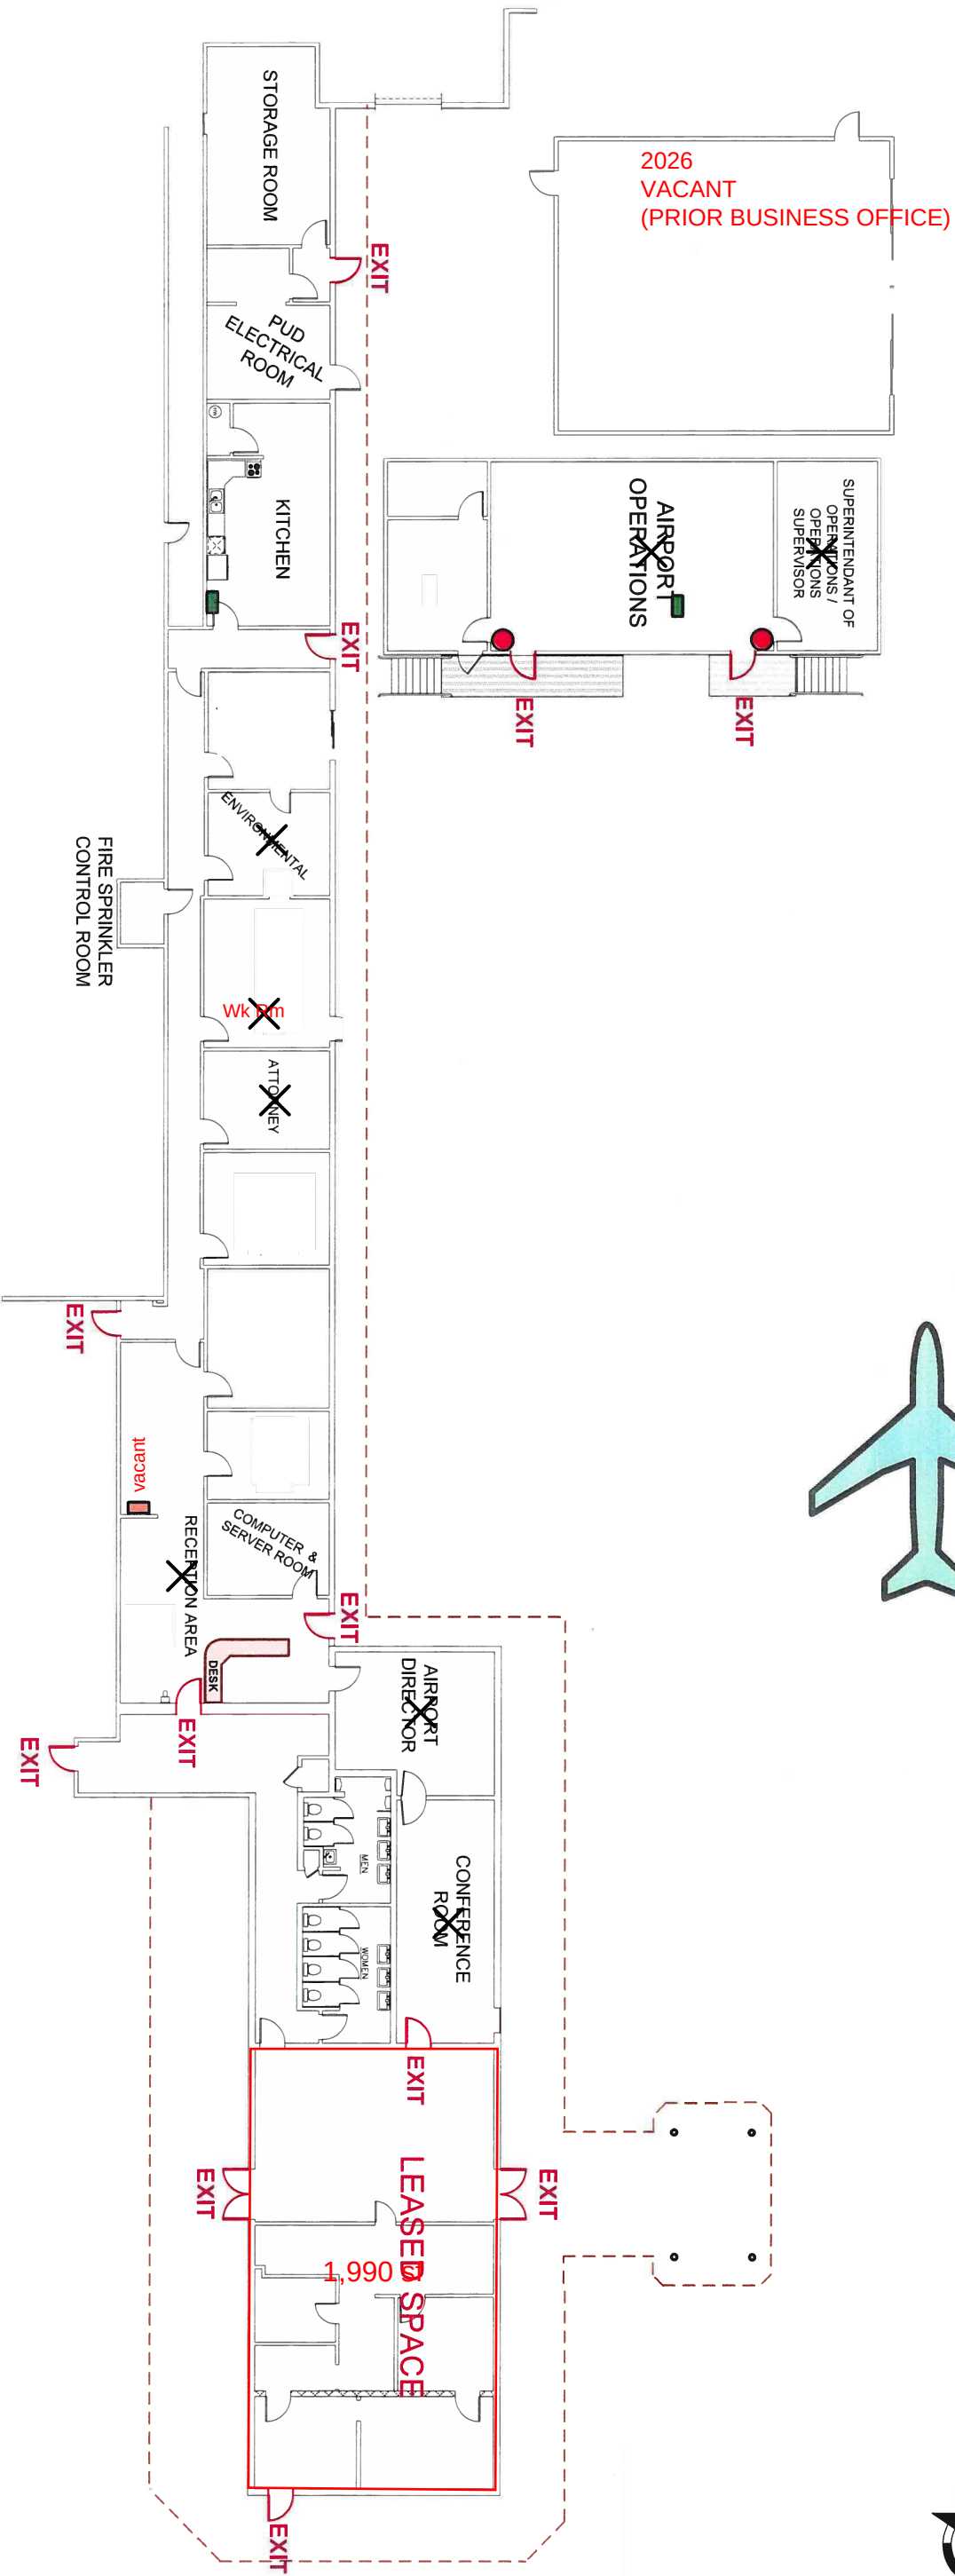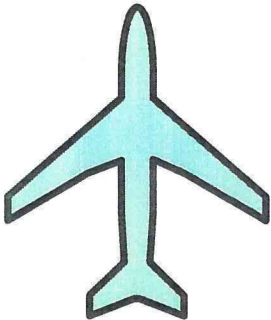


1. In an **EARTHQUAKE**, first **DROP** down to the floor; take **COVER** under a sturdy desk or table; **HOLD** onto the desk / table until the shaking stops.
2. Once the earthquake has subsided, all personnel are to as quickly and safely as possible make their way to the parking lot east of the Airport Office.

- **FIRE EXTINGUISHER LOCATIONS**
- **FIRST AID KIT LOCATIONS**
- **AED LOCATIONS**
- **M.S.D.S**

TITLE		SCALE
Building C-2 Airport Office		1" = 20'
EMERGENCY EXIT PLAN		DATE
2026		2-7-17




EAST PARKING LOT

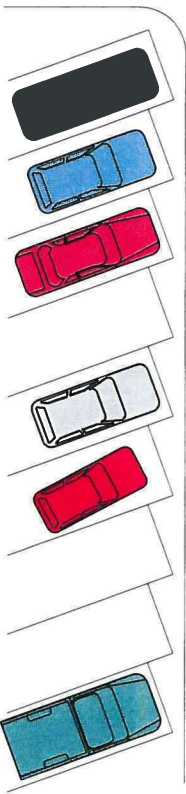



The floor plan shows a large rectangular room with a central area labeled "4 DEPUTIES". This area contains four chairs, each labeled "CACHET", arranged in a 2x2 grid. To the left of the central area is a "COPIER" and a "HEATER". To the right is a "WINDOW" and a "WALL-MOUNT MAIL BIN/ SHRED". The top wall features a "power/data" outlet and a "LF/3/42" label. The bottom wall has a "power/data" outlet and a "LF/3/42" label. The right wall has a "power" outlet and a "LF/3/42" label. The left wall has a "power/data" outlet and a "LF/3/42" label. The central area is labeled "4 DEPUTIES". The top wall has a "WINDOW" and a "WALL-MOUNT MAIL BIN/ SHRED". The bottom wall has a "power/data" outlet and a "LF/3/42" label. The right wall has a "power" outlet and a "LF/3/42" label. The left wall has a "power/data" outlet and a "LF/3/42" label. The central area is labeled "4 DEPUTIES".

The floor plan shows a rectangular room with three operator stations along the top wall and a console along the bottom wall. The top wall features three windows and a central section labeled 'WALL BIN??'. The leftmost station is for the 'COMMANDER LT' (Lieutenant), the middle for an 'SRGT' (Sergeant), and the rightmost for another 'SRGT'. Each station includes a seat with a 'CACHET' (cushion) and a control panel. The left station also has a 'POWER, DATA' panel and a 'BBF' (Base Band Filter) unit. The middle station has a 'FF' (Field of View) unit. The right station has a 'POWER, POWER, DATA' panel and a 'BBF' unit. The console at the bottom has four seats, each with a 'CACHET', and is labeled '2 SRGTS .50 FTE LT'. A 'PRINTER' is located on the left side of the console. The left wall has a 'MONITOR A/V WALL' and a 'HEAT??' unit. The right wall has a 'HEAT' unit and a 'POWER, DATA' panel. The bottom wall has a 'WINDOW'.

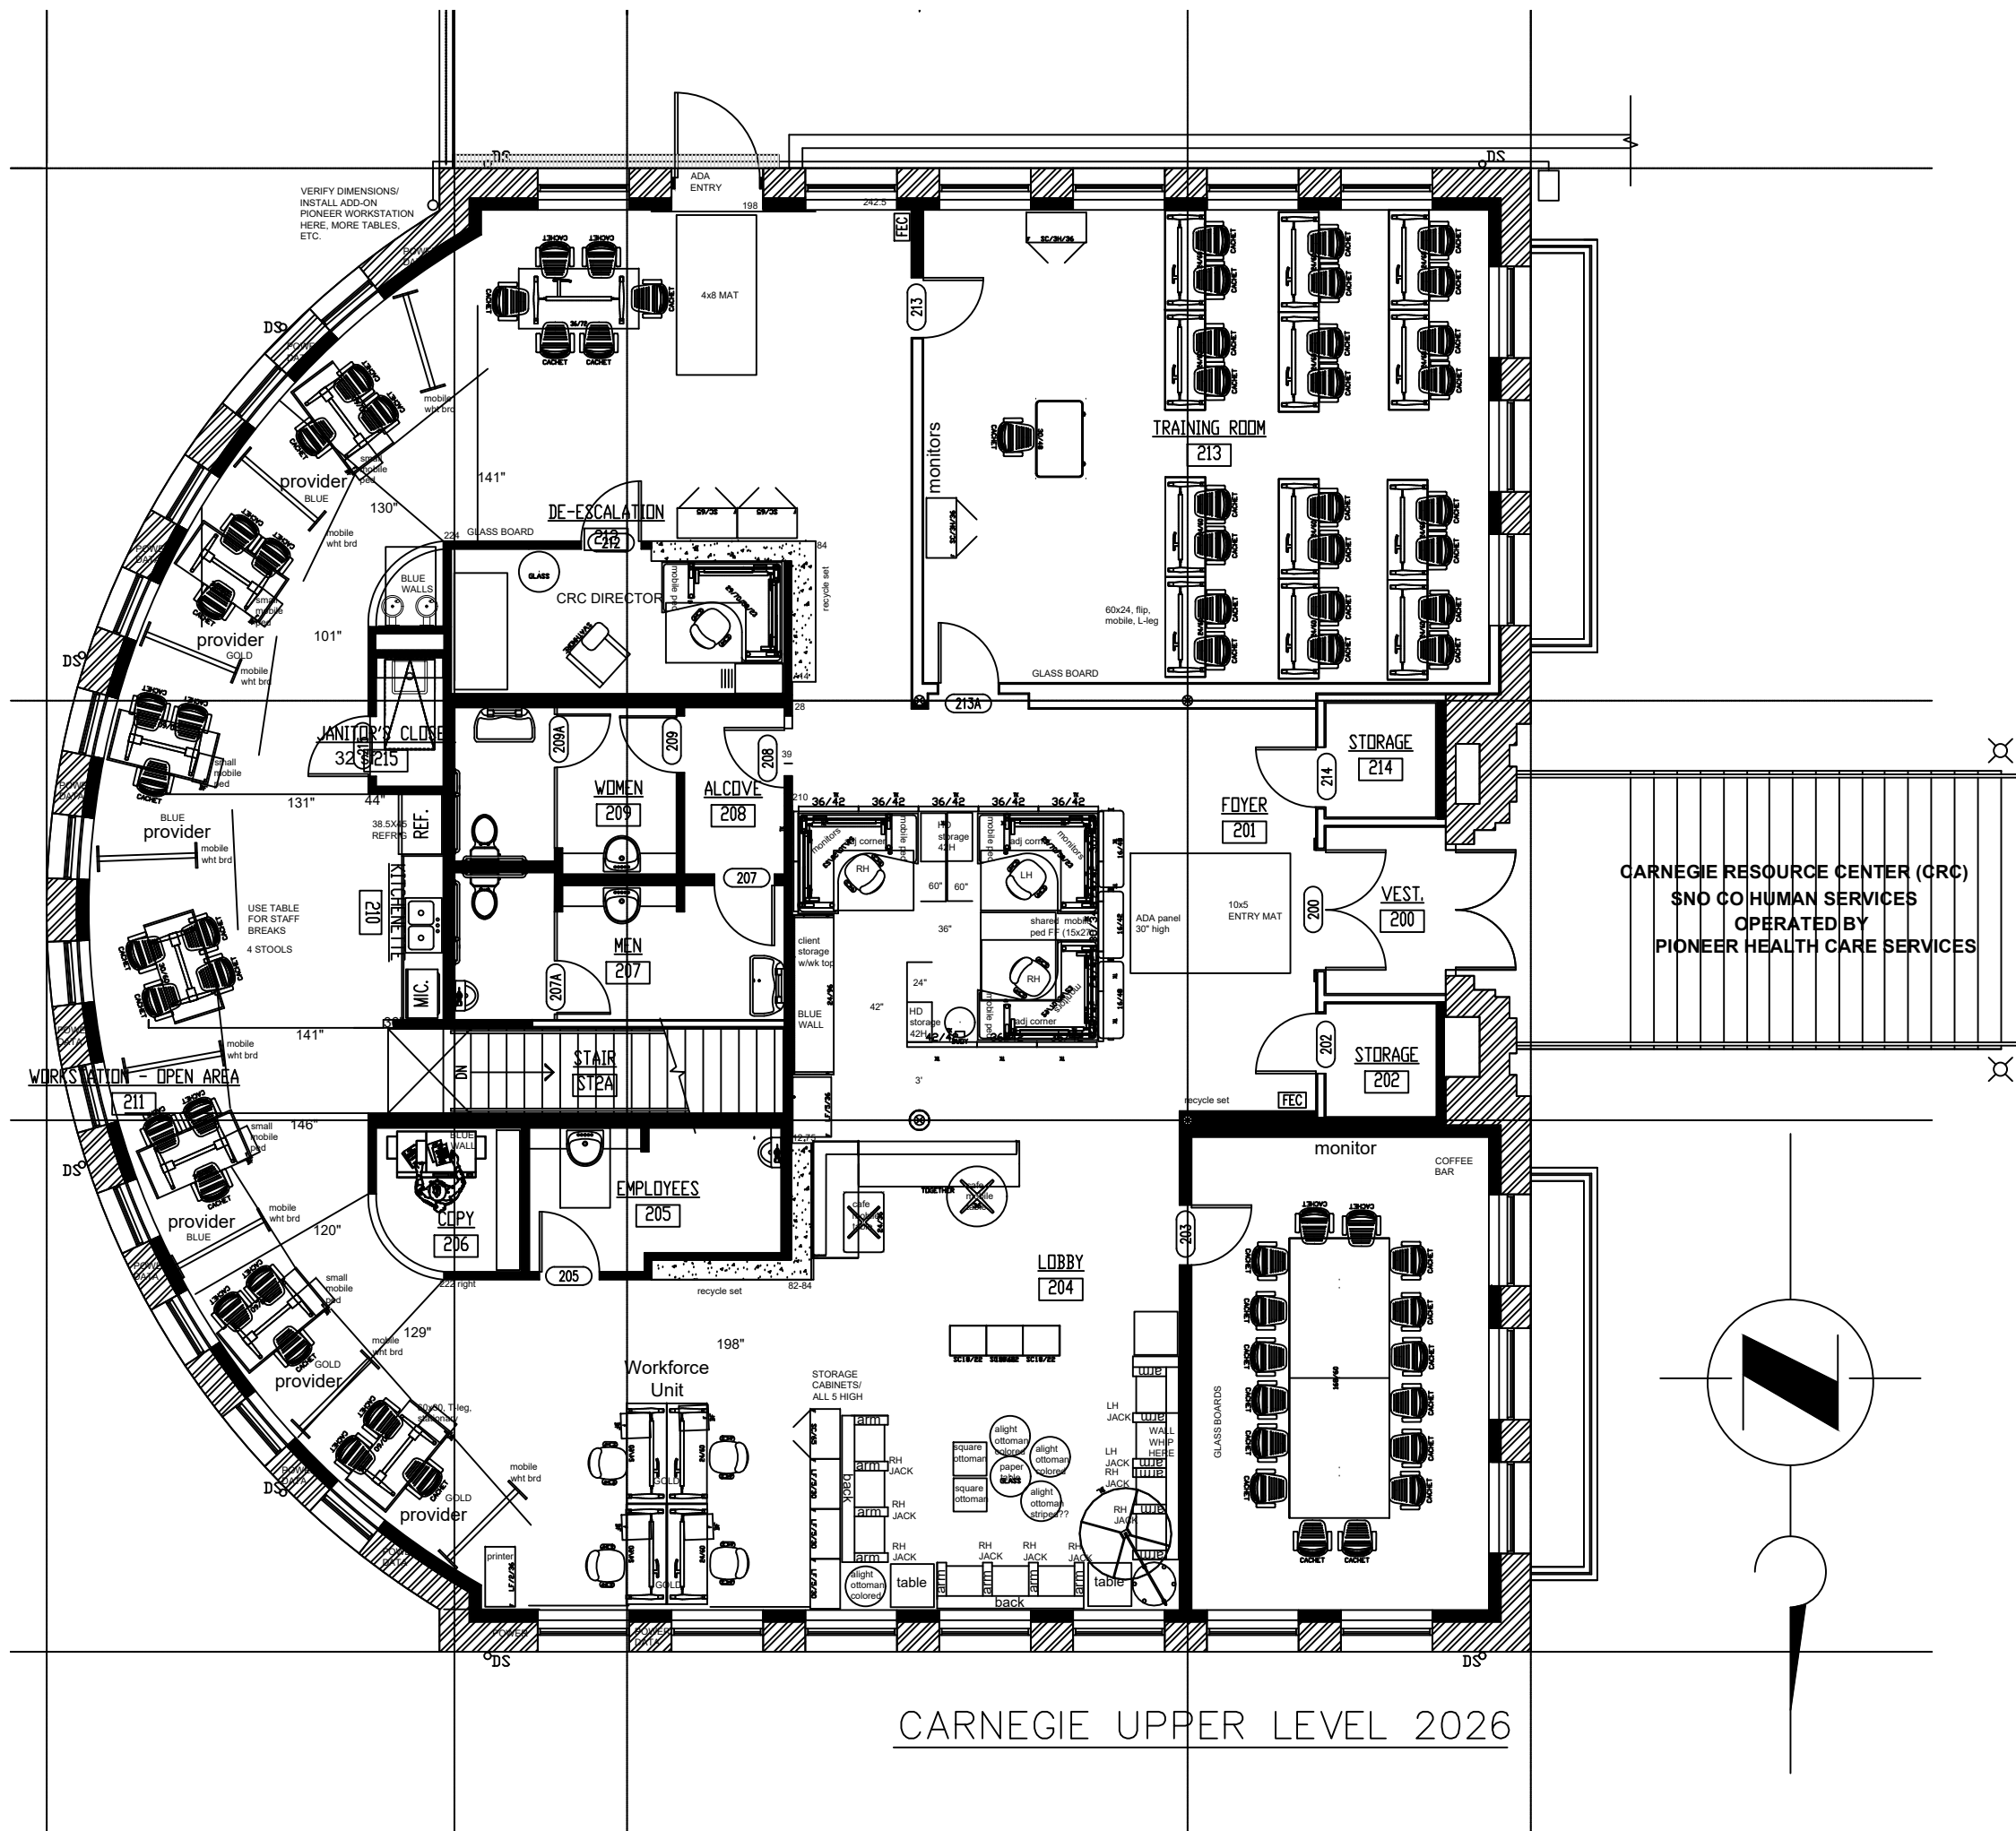



CARNEGIE UPPER LEVEL 2026

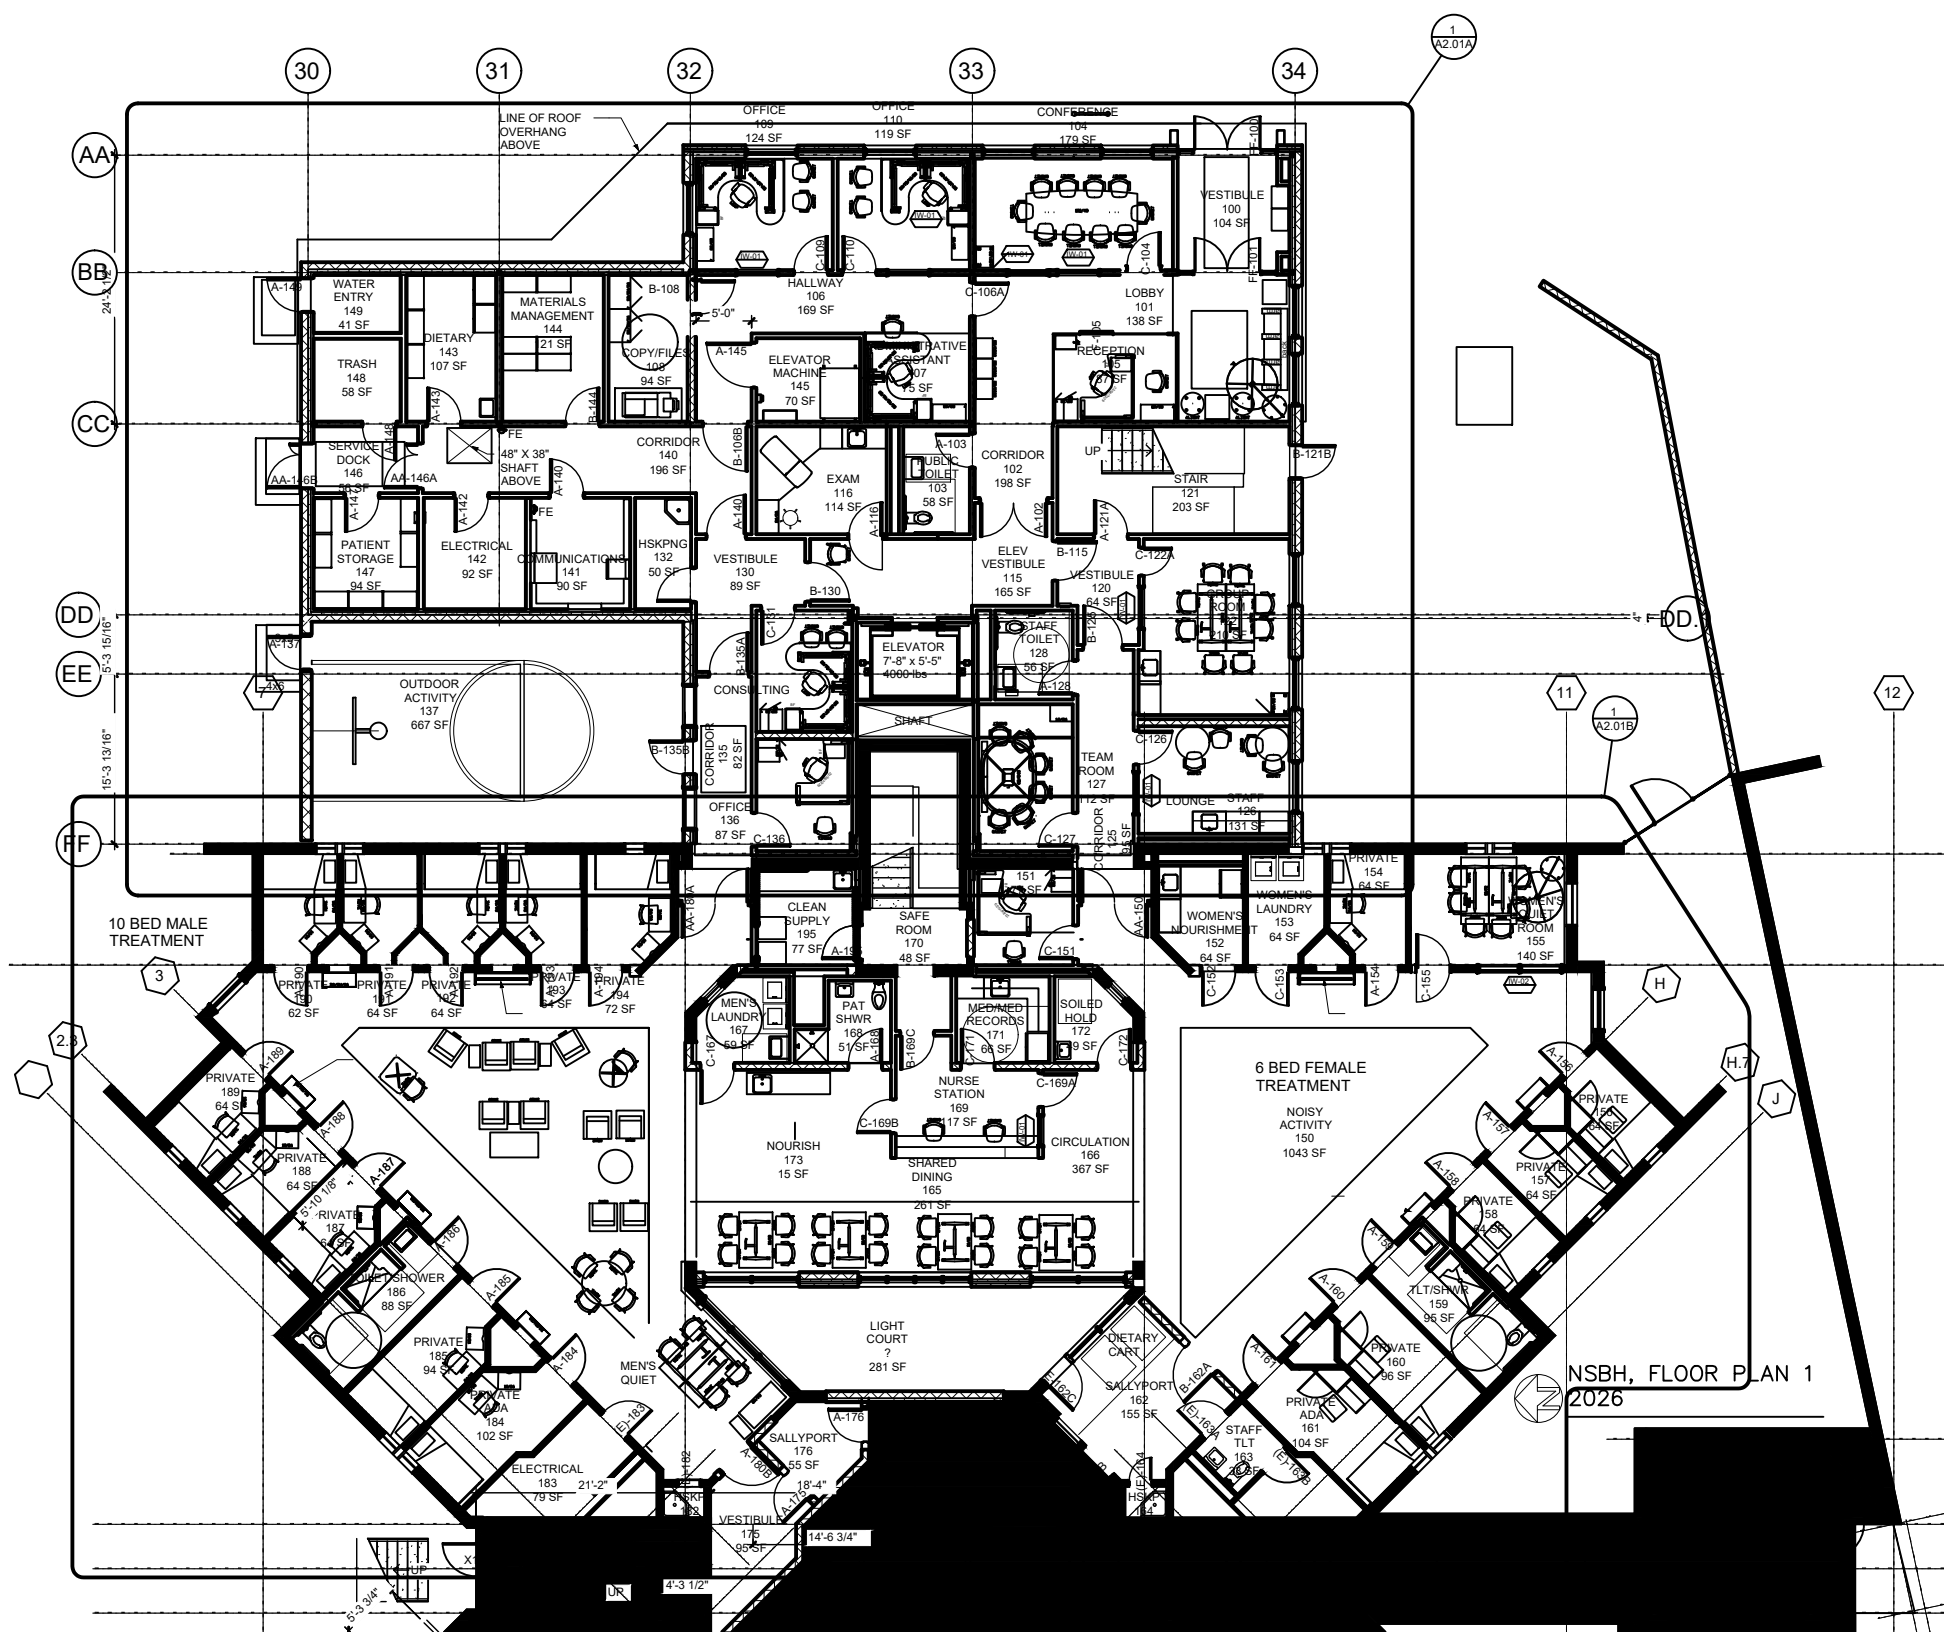

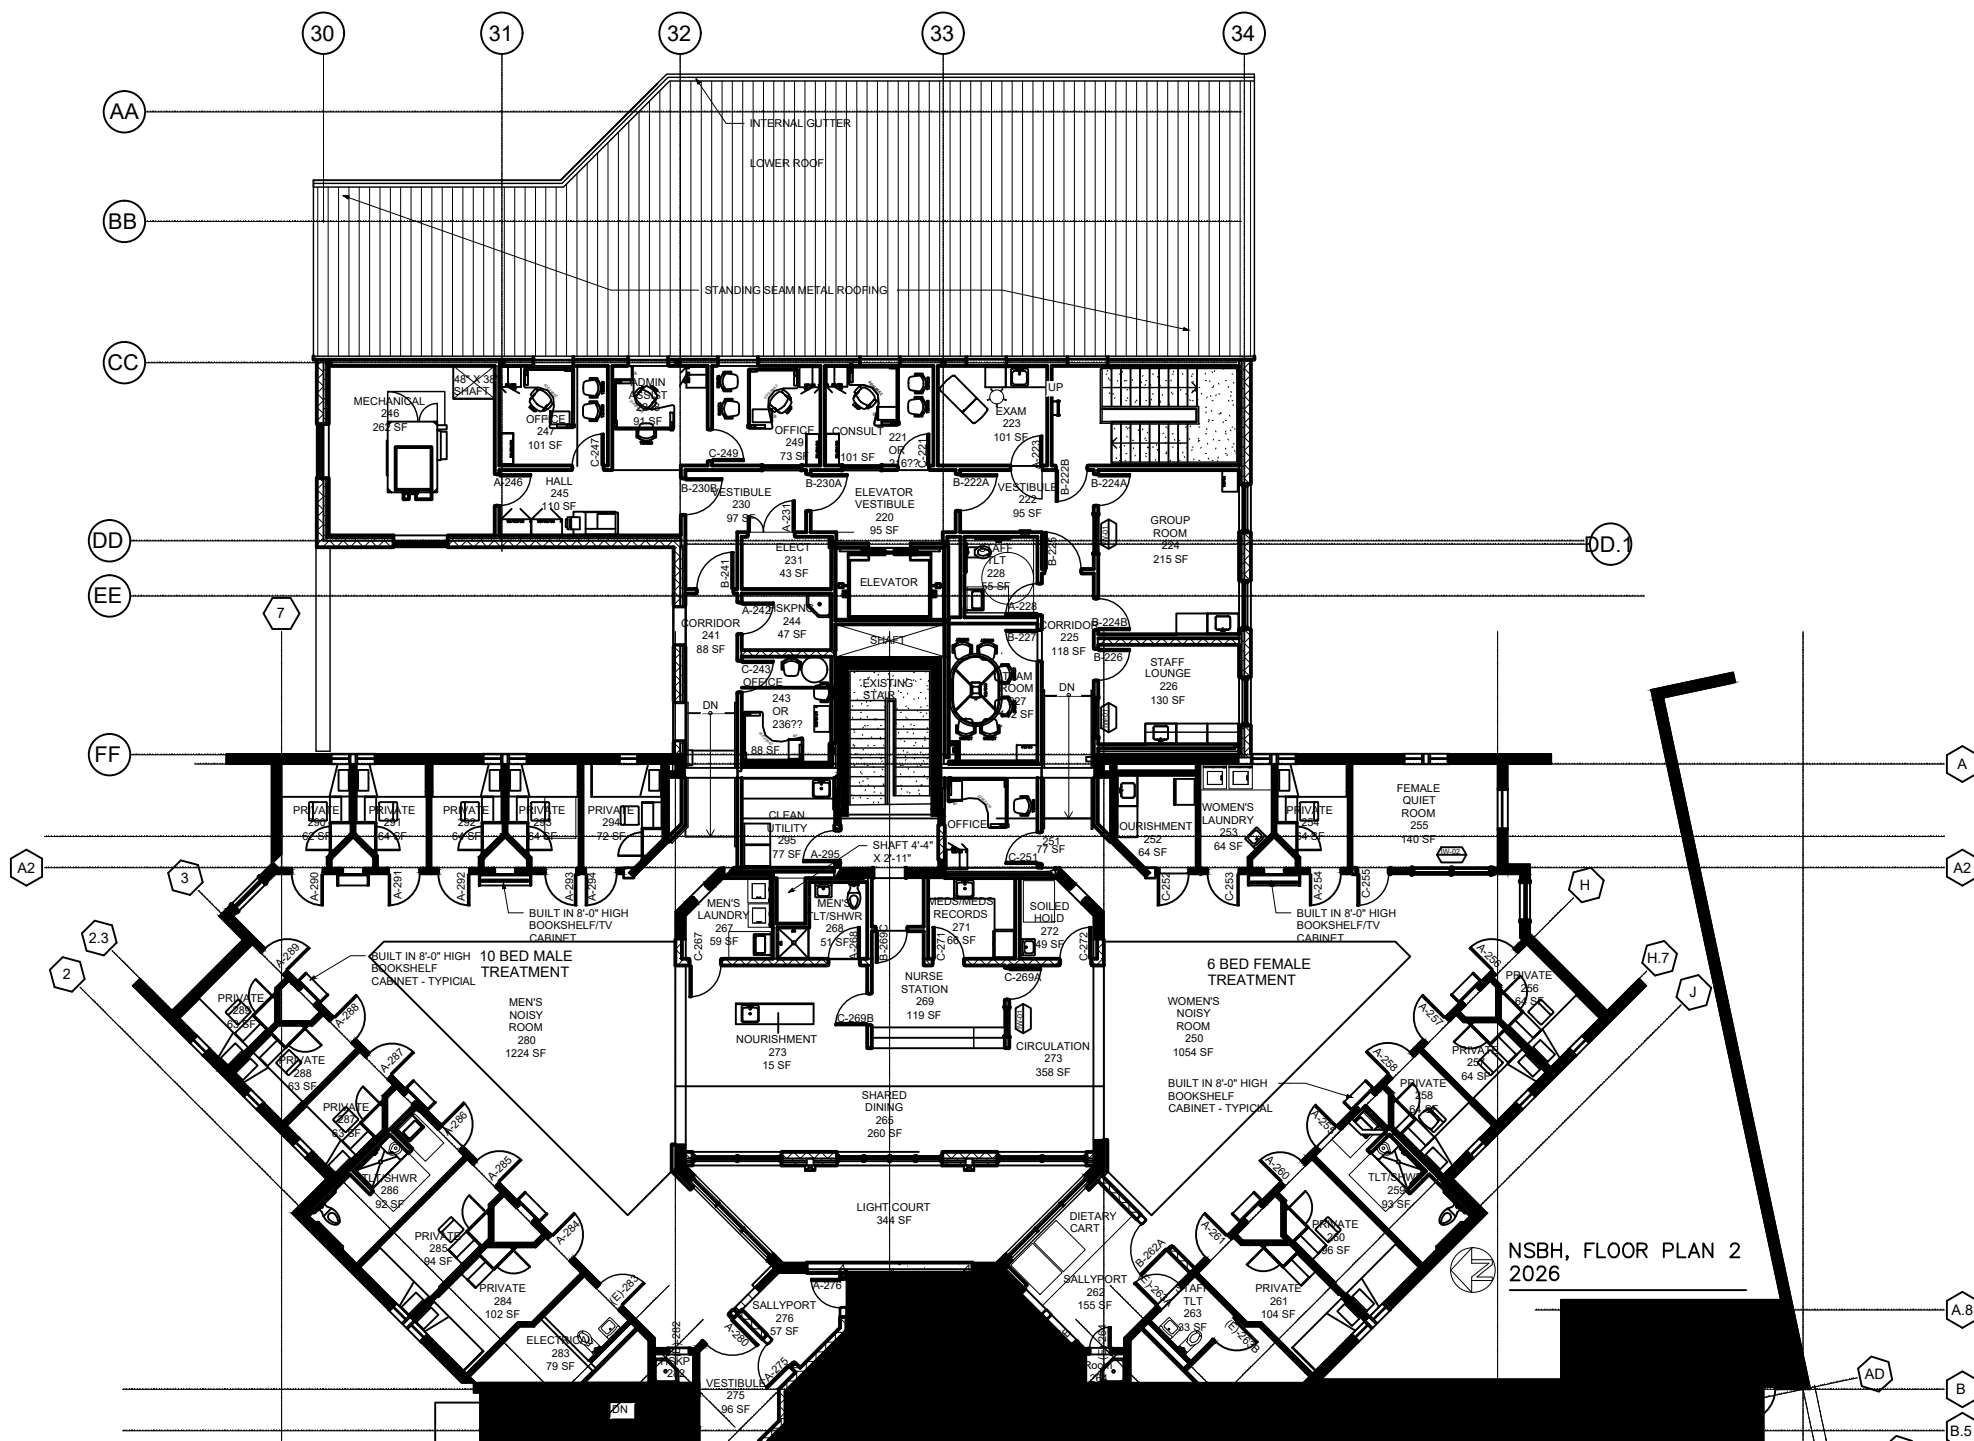


NSBH, FLOOR PLAN 2
2026


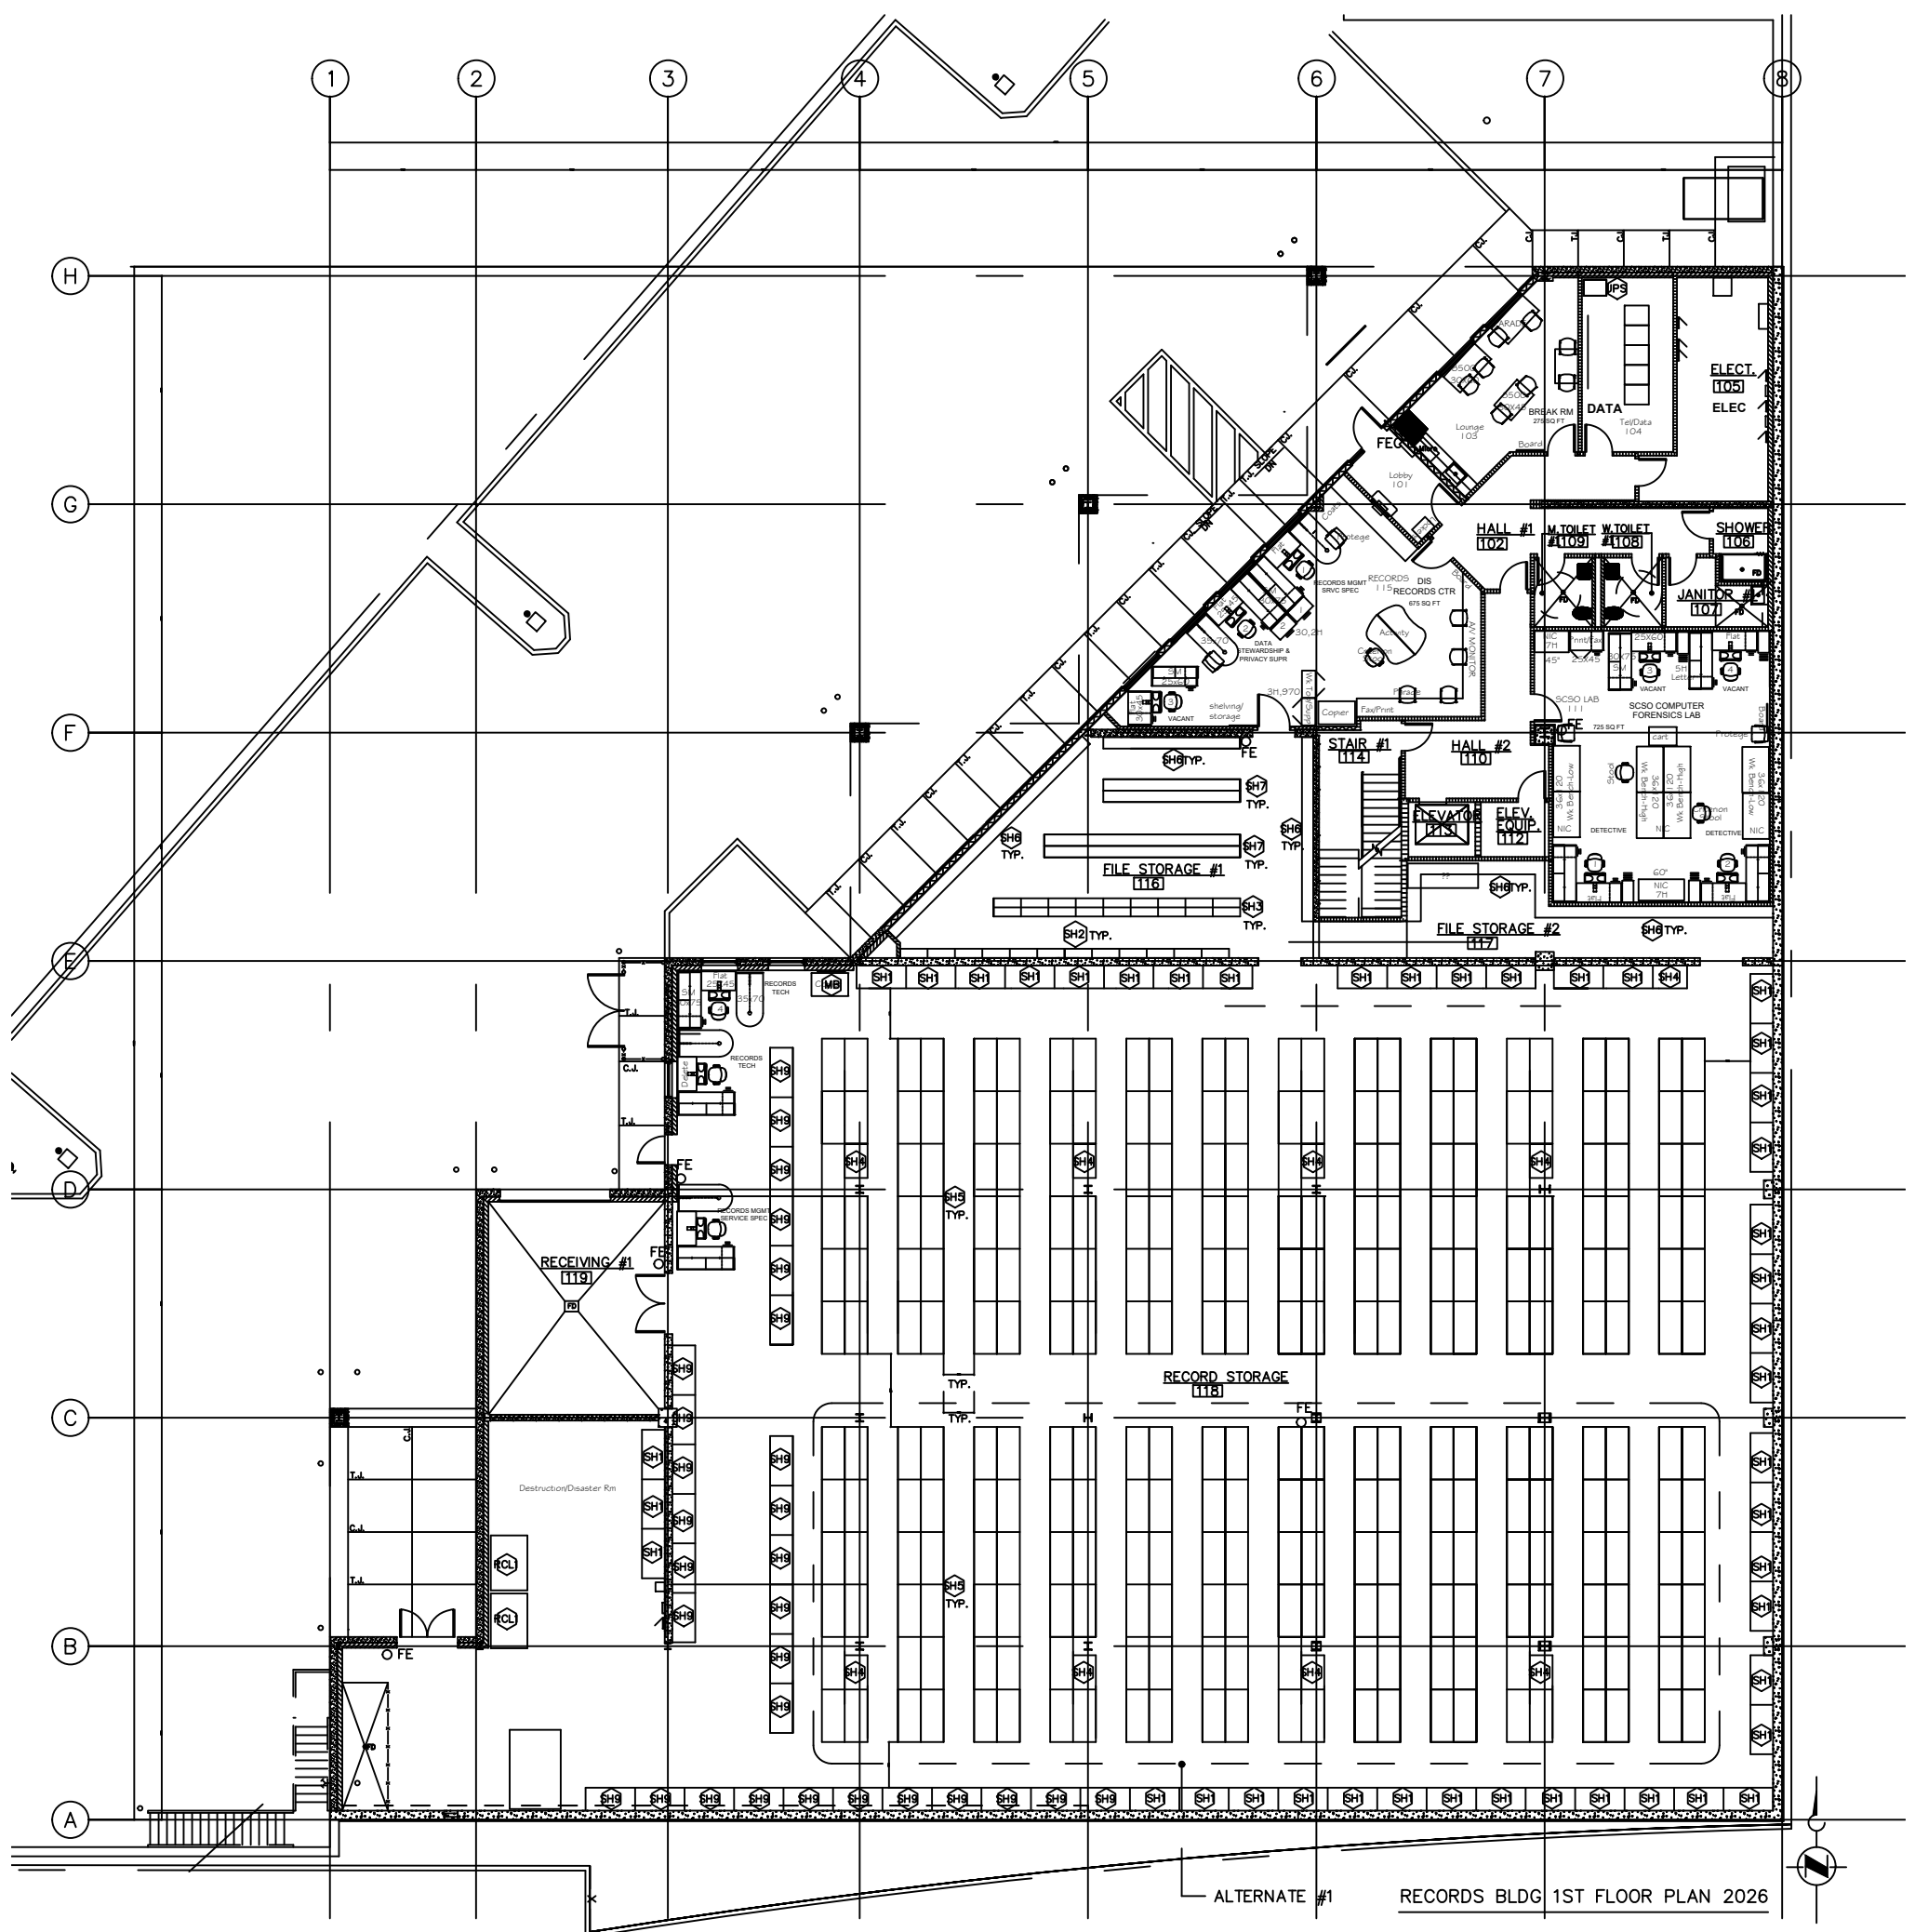


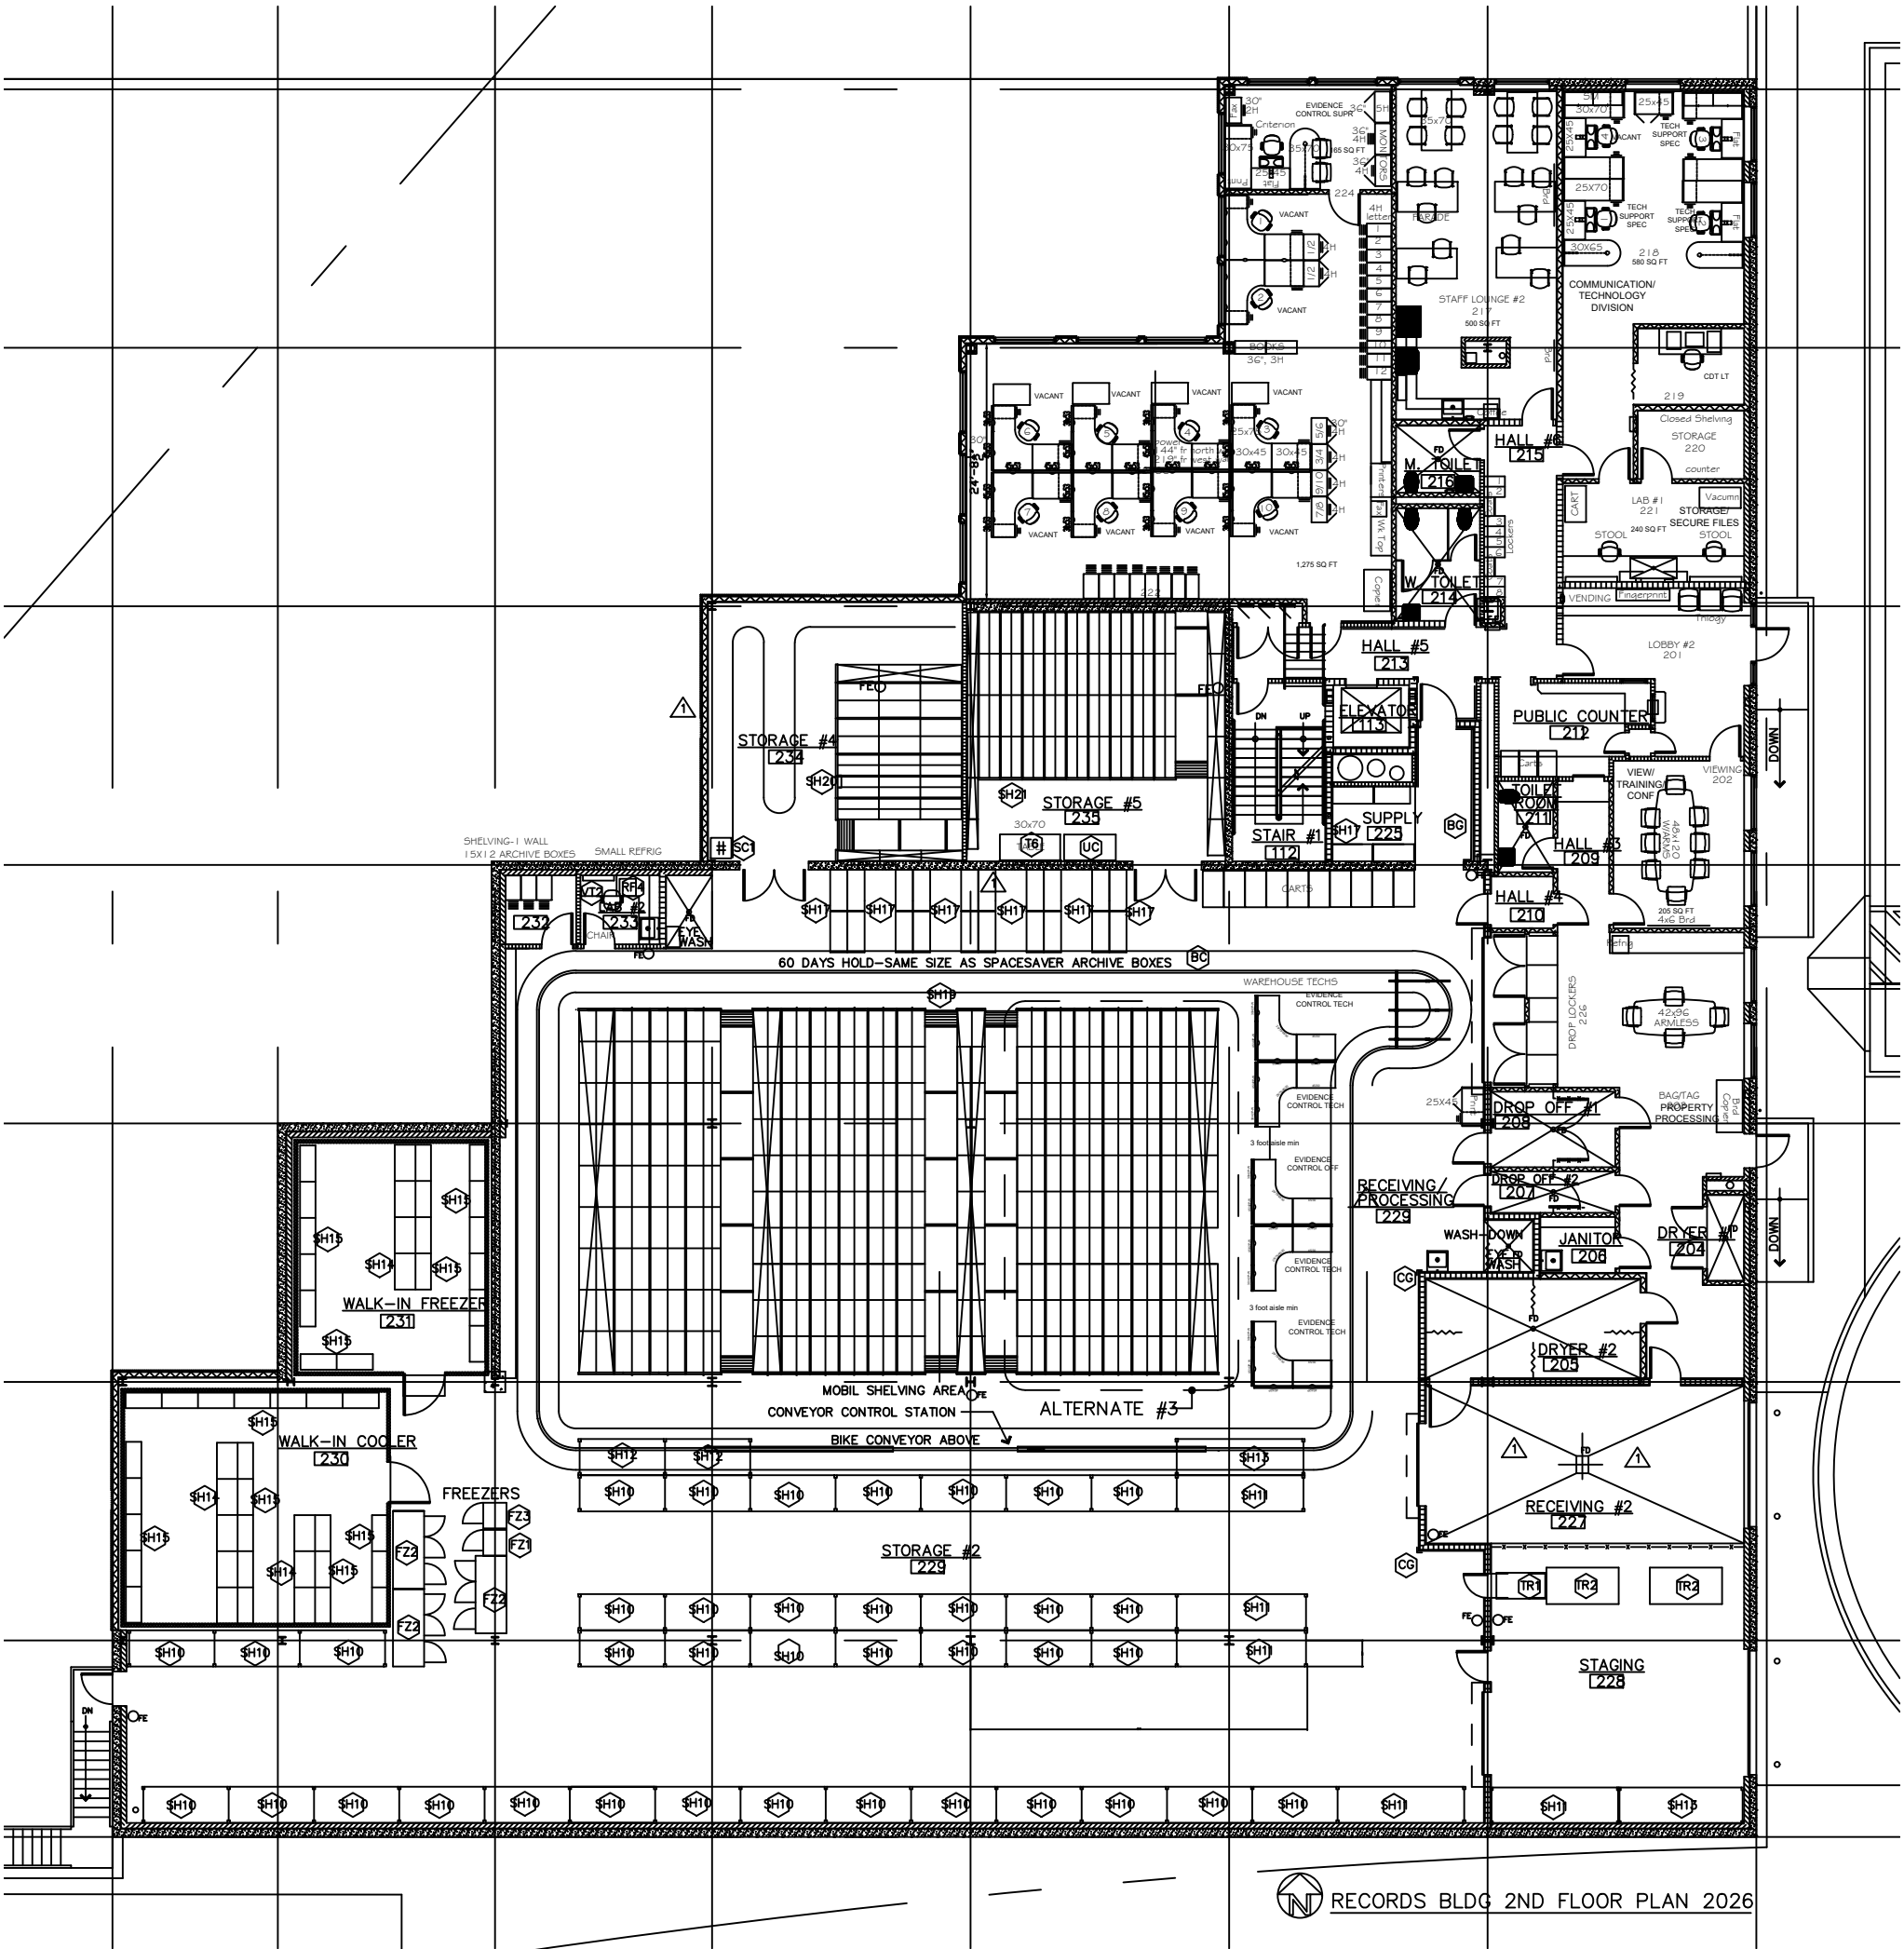

A horizontal number line is shown with tick marks at 0, 4, 8, 16, and 24. Two rectangles are drawn on the line. The first rectangle is positioned between 4 and 8. The second rectangle is positioned between 16 and 24.

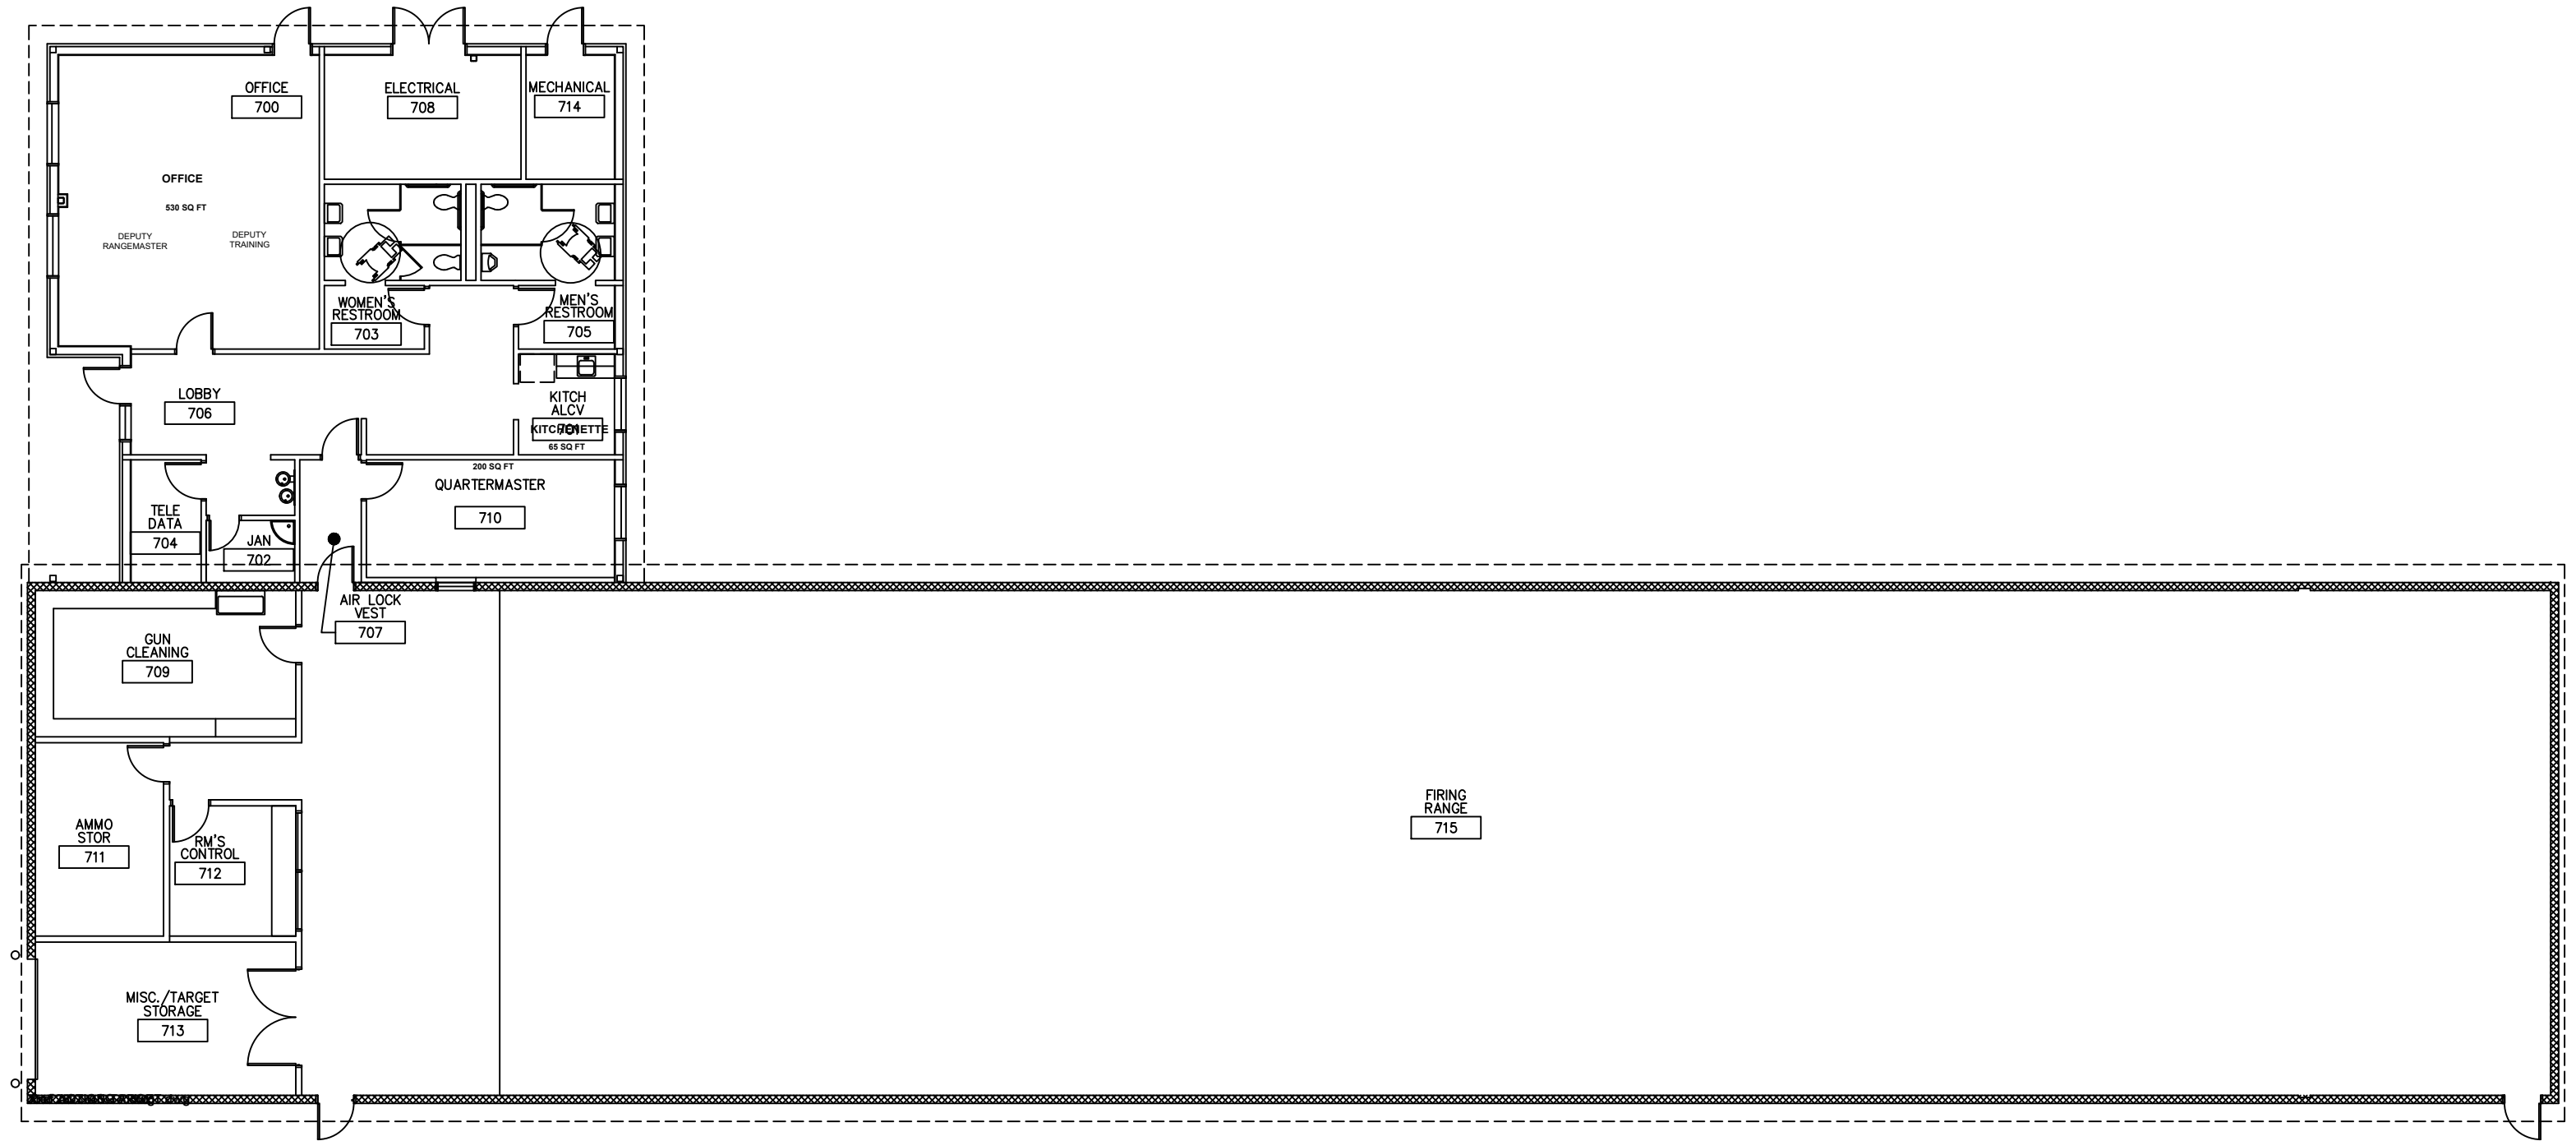

DEPUTIES (4 FTE):

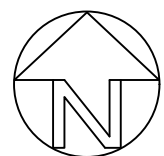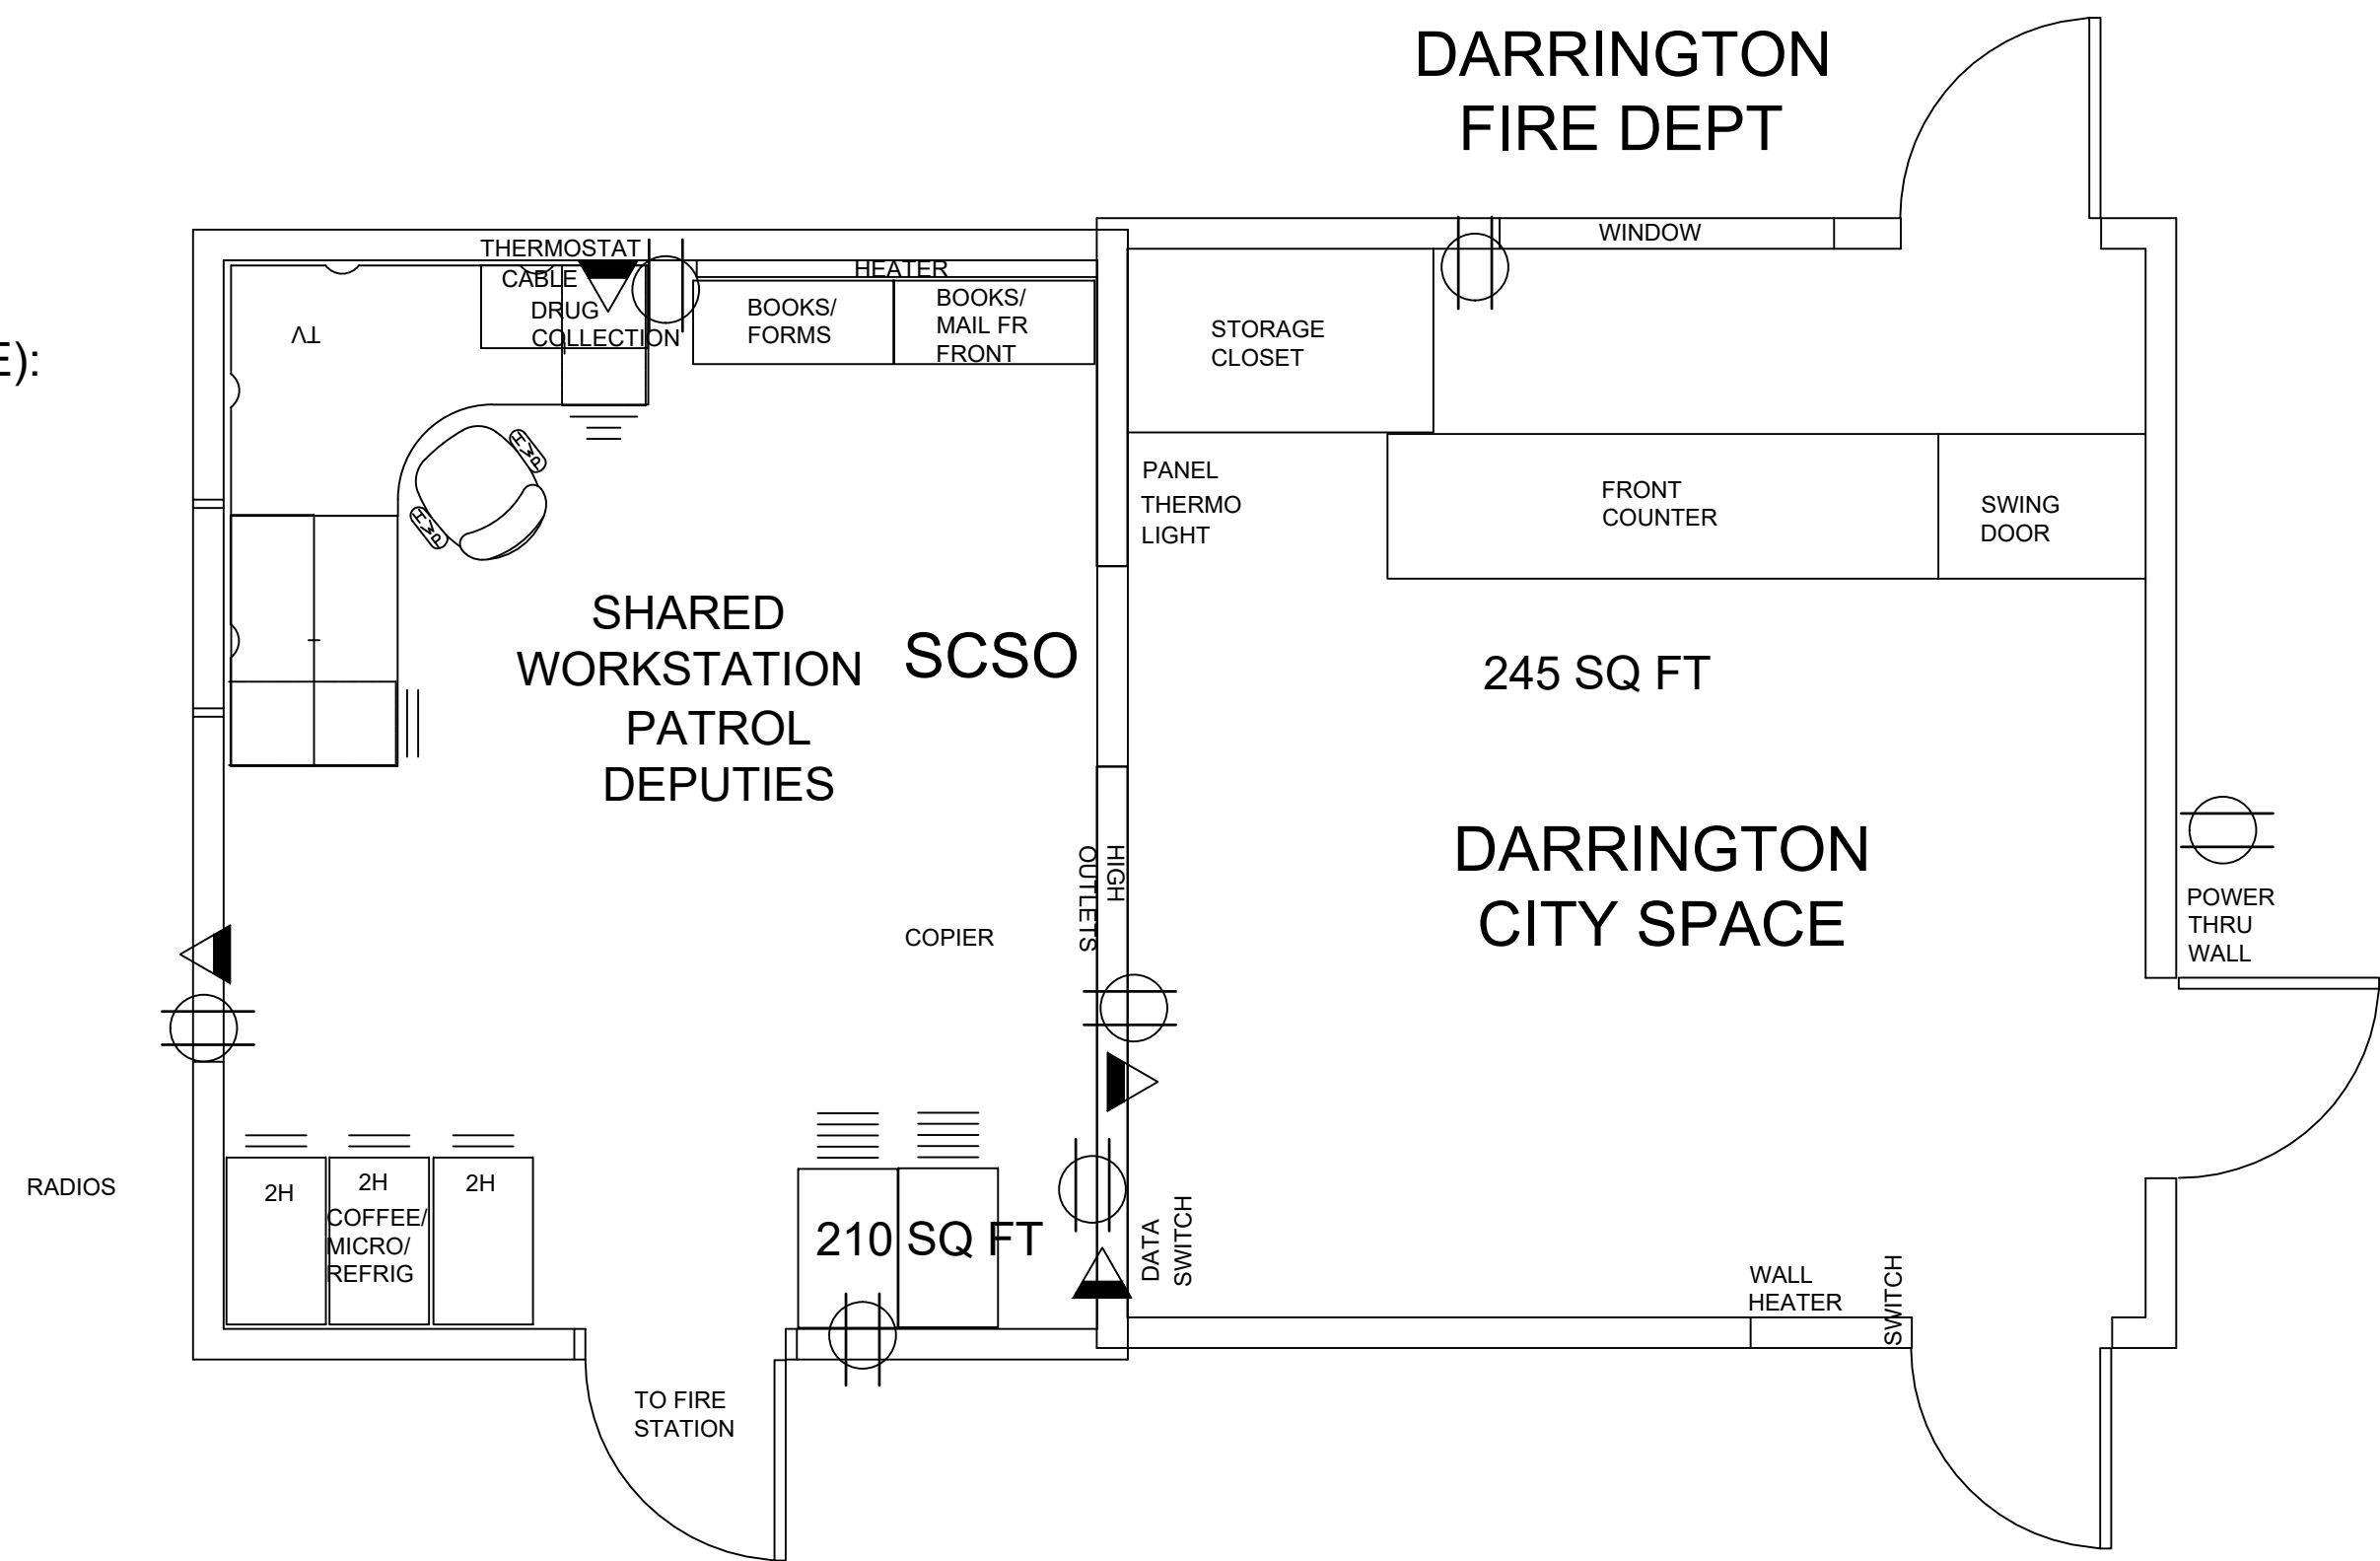

SCSO DARRINGTON SUB-STATION 2026

SNOHOMISH COUNTY SHERIFF &
CITY OF GOLDBAR
POLICE DEPT
2026

01/23/2009 15:18 3507932282

CITY OF GOLD BAR

PAGE 02/02

0. AND MARKED IN CONFORMANCE WITH
OR WEST COAST LUMBER #15, LATEST


F _v	F _b	E
75	2x8 - 1175 2x10 - 1075	1,200,000
95	875	1,600,000
85	1200	1,600,000
165	2400	1,800,000
210	2900	2,000,000


BE FABRICATED IN CONFORMANCE WITH
1. EACH MEMBER SHALL BE ACCOMPANIED
PERFORMANCE AND SHALL BEAR AN ATG
IS SHALL BE DOUGLAS FIR COMBINATION
UNDISTURBED EARTH OR CONTROLLED
BELOW LOWEST ADJACENT EXTERIOR

highline o/
scaffolding w/
@ 12" O.C. field o/
24" O.C. Per Plan w/
o/
ation o/
scaffolding w/
@ 12" O.C. field, U.N.O. o/
Bwn.

o/
Nailed w/
24" O.C. field, U.N.O. o/
24" O.C. w/
o/
2009 Submitted

WHALEN, CHIEF
DRAKE, DEPUTY
GRASSETH, DEPUTY
WINNINGHAM, DEPUTY
GALLINA, DEPUTY

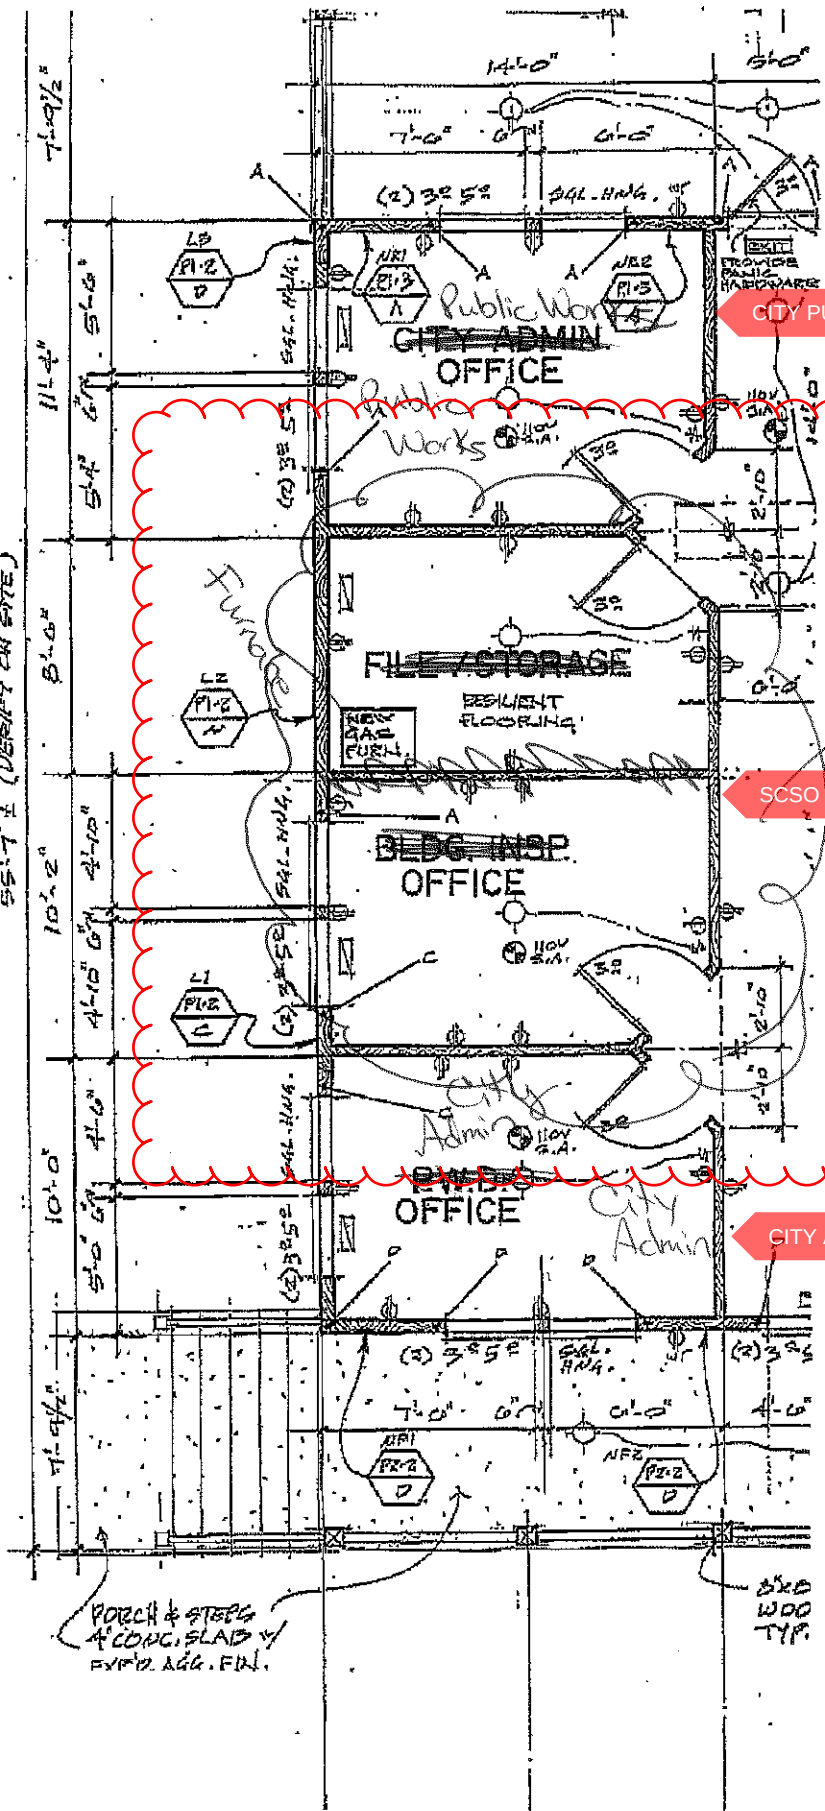


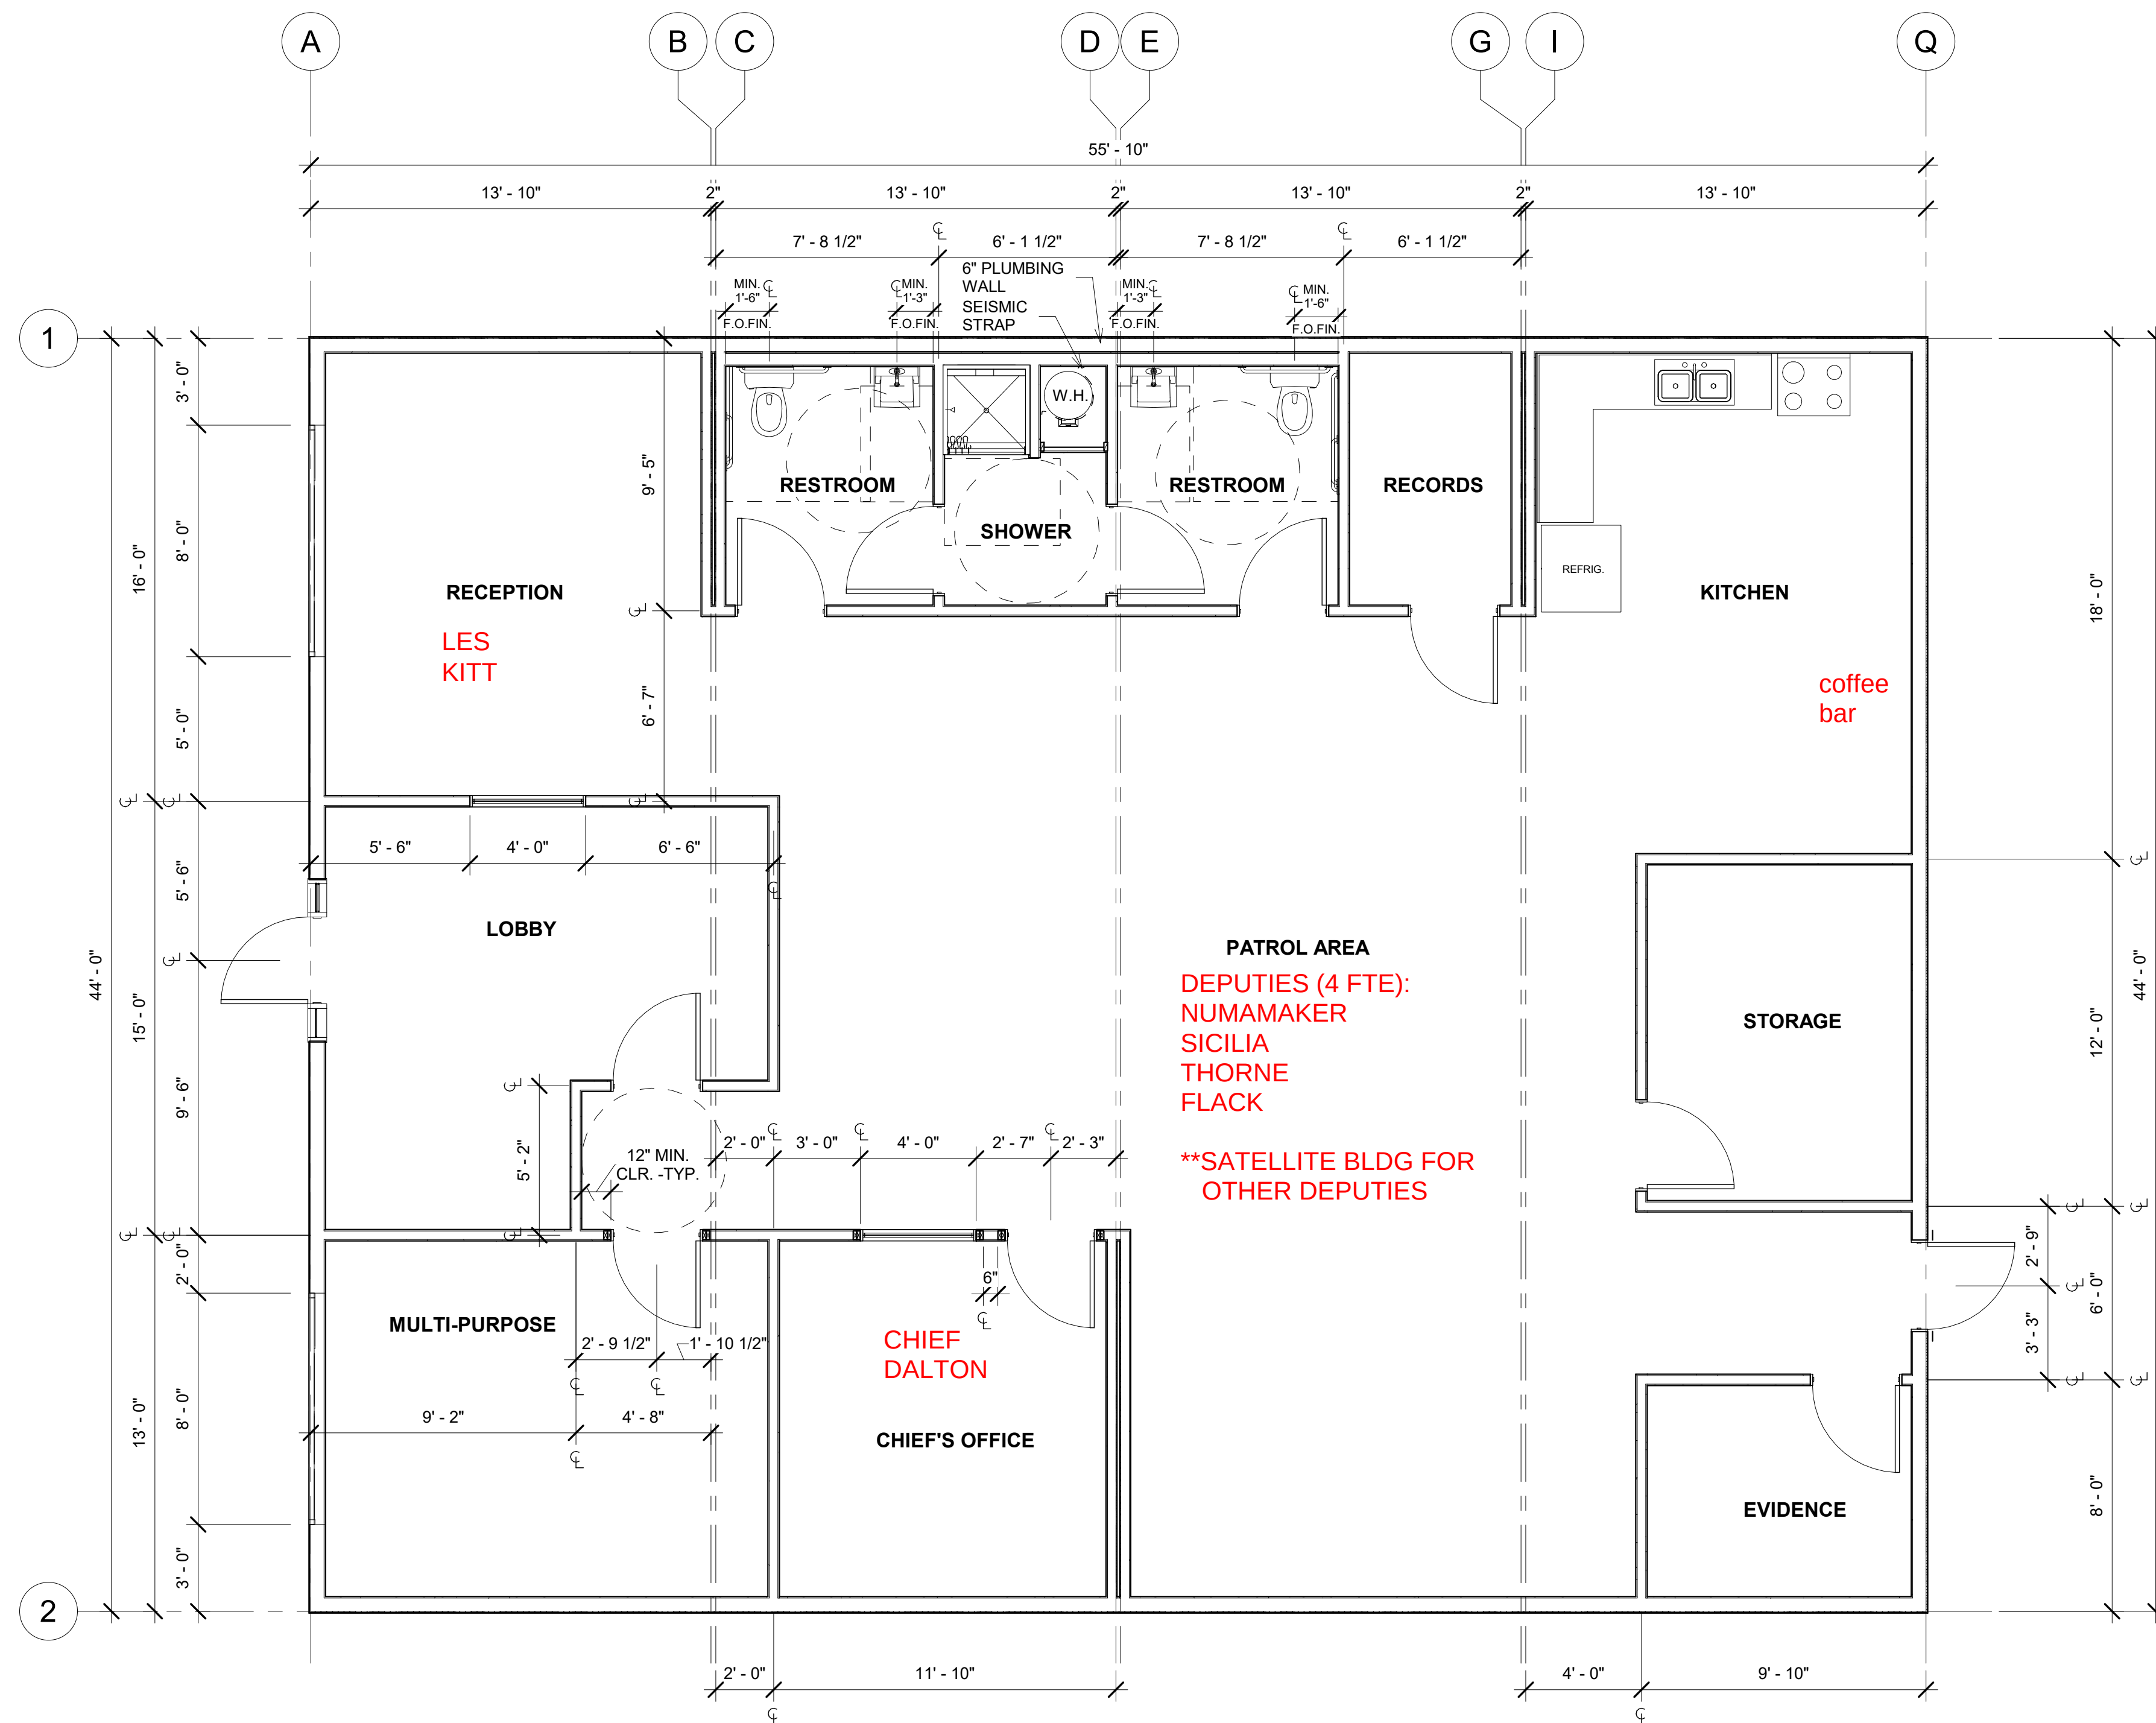


SNOHOMISH COUNTY
SHERIFF & CITY OF
GRANITE FALLS
POLICE DEPT
2026

1 FLOOR PLAN
1/4" = 1'-0"


REV.	DESCRIPTION	DATE	BY	REUSE OF DOCUMENTS THIS DOCUMENT AND THE IDEAS AND DESIGNS INCORPORATED HEREIN ARE THE PROPERTY OF MODERN BUILDING SYSTEMS INC. AND ARE NOT TO BE USED IN WHOLE OR IN PART FOR ANY OTHER USE OR PROJECT WITHOUT WRITTEN AUTHORIZATION.	 MODERN BUILDING SYSTEMS, INC. TELEPHONE: (503) 748-4849 FAX: (503) 748-4565 P.O. BOX 115, 940 PORTER ROAD, AUMVILLE, OR 97202 CHECK OUT OUR WEB PAGE: www.modernbuildingsystems.com © MODERN BUILDING SYSTEMS, INC. 2019	SHEET FLOOR PLAN	JOB# 2020-16
						PROJ. 44' x 56' MODULAR OFFICE GRANITE FALLS PD	SHEET # A 1.0
						ADDRESS 205 S. GRANITE AVE., GRANITE FALLS, WA. 98252	DATE 2/13/20

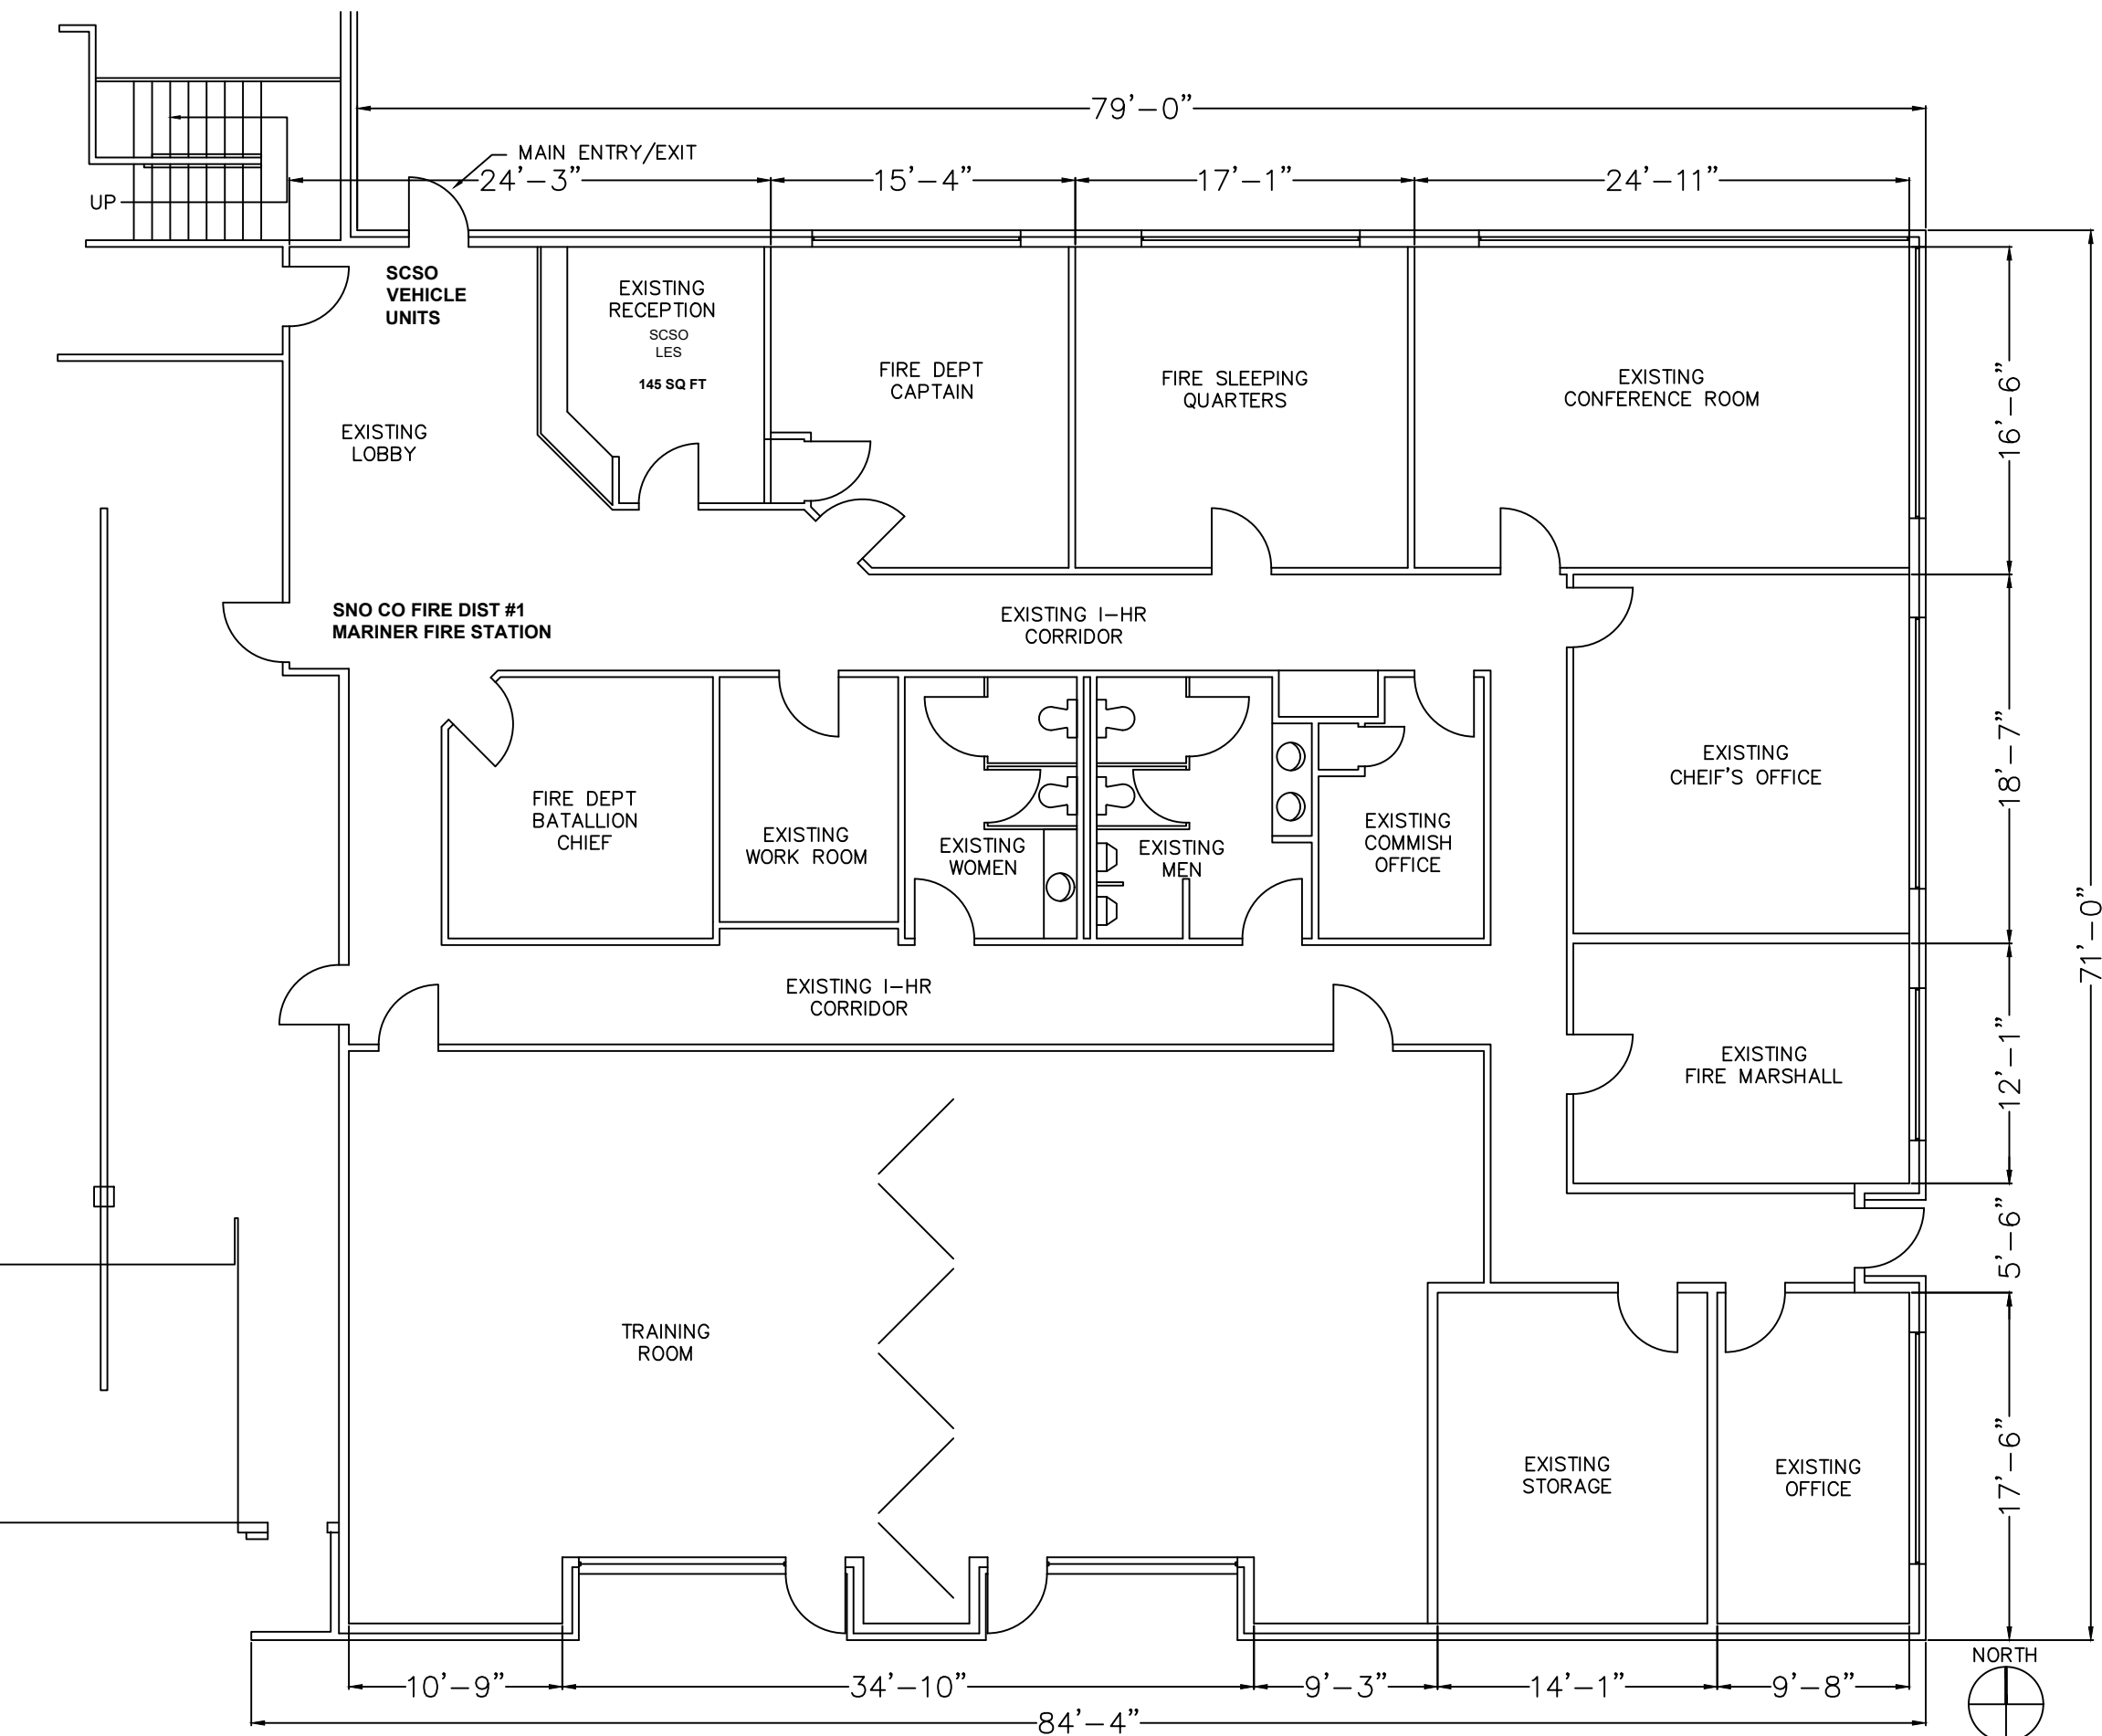



 SCSO MARINER FIRE STATION FIRST FLOOR PLAN 2026
1/4"=1'-0"

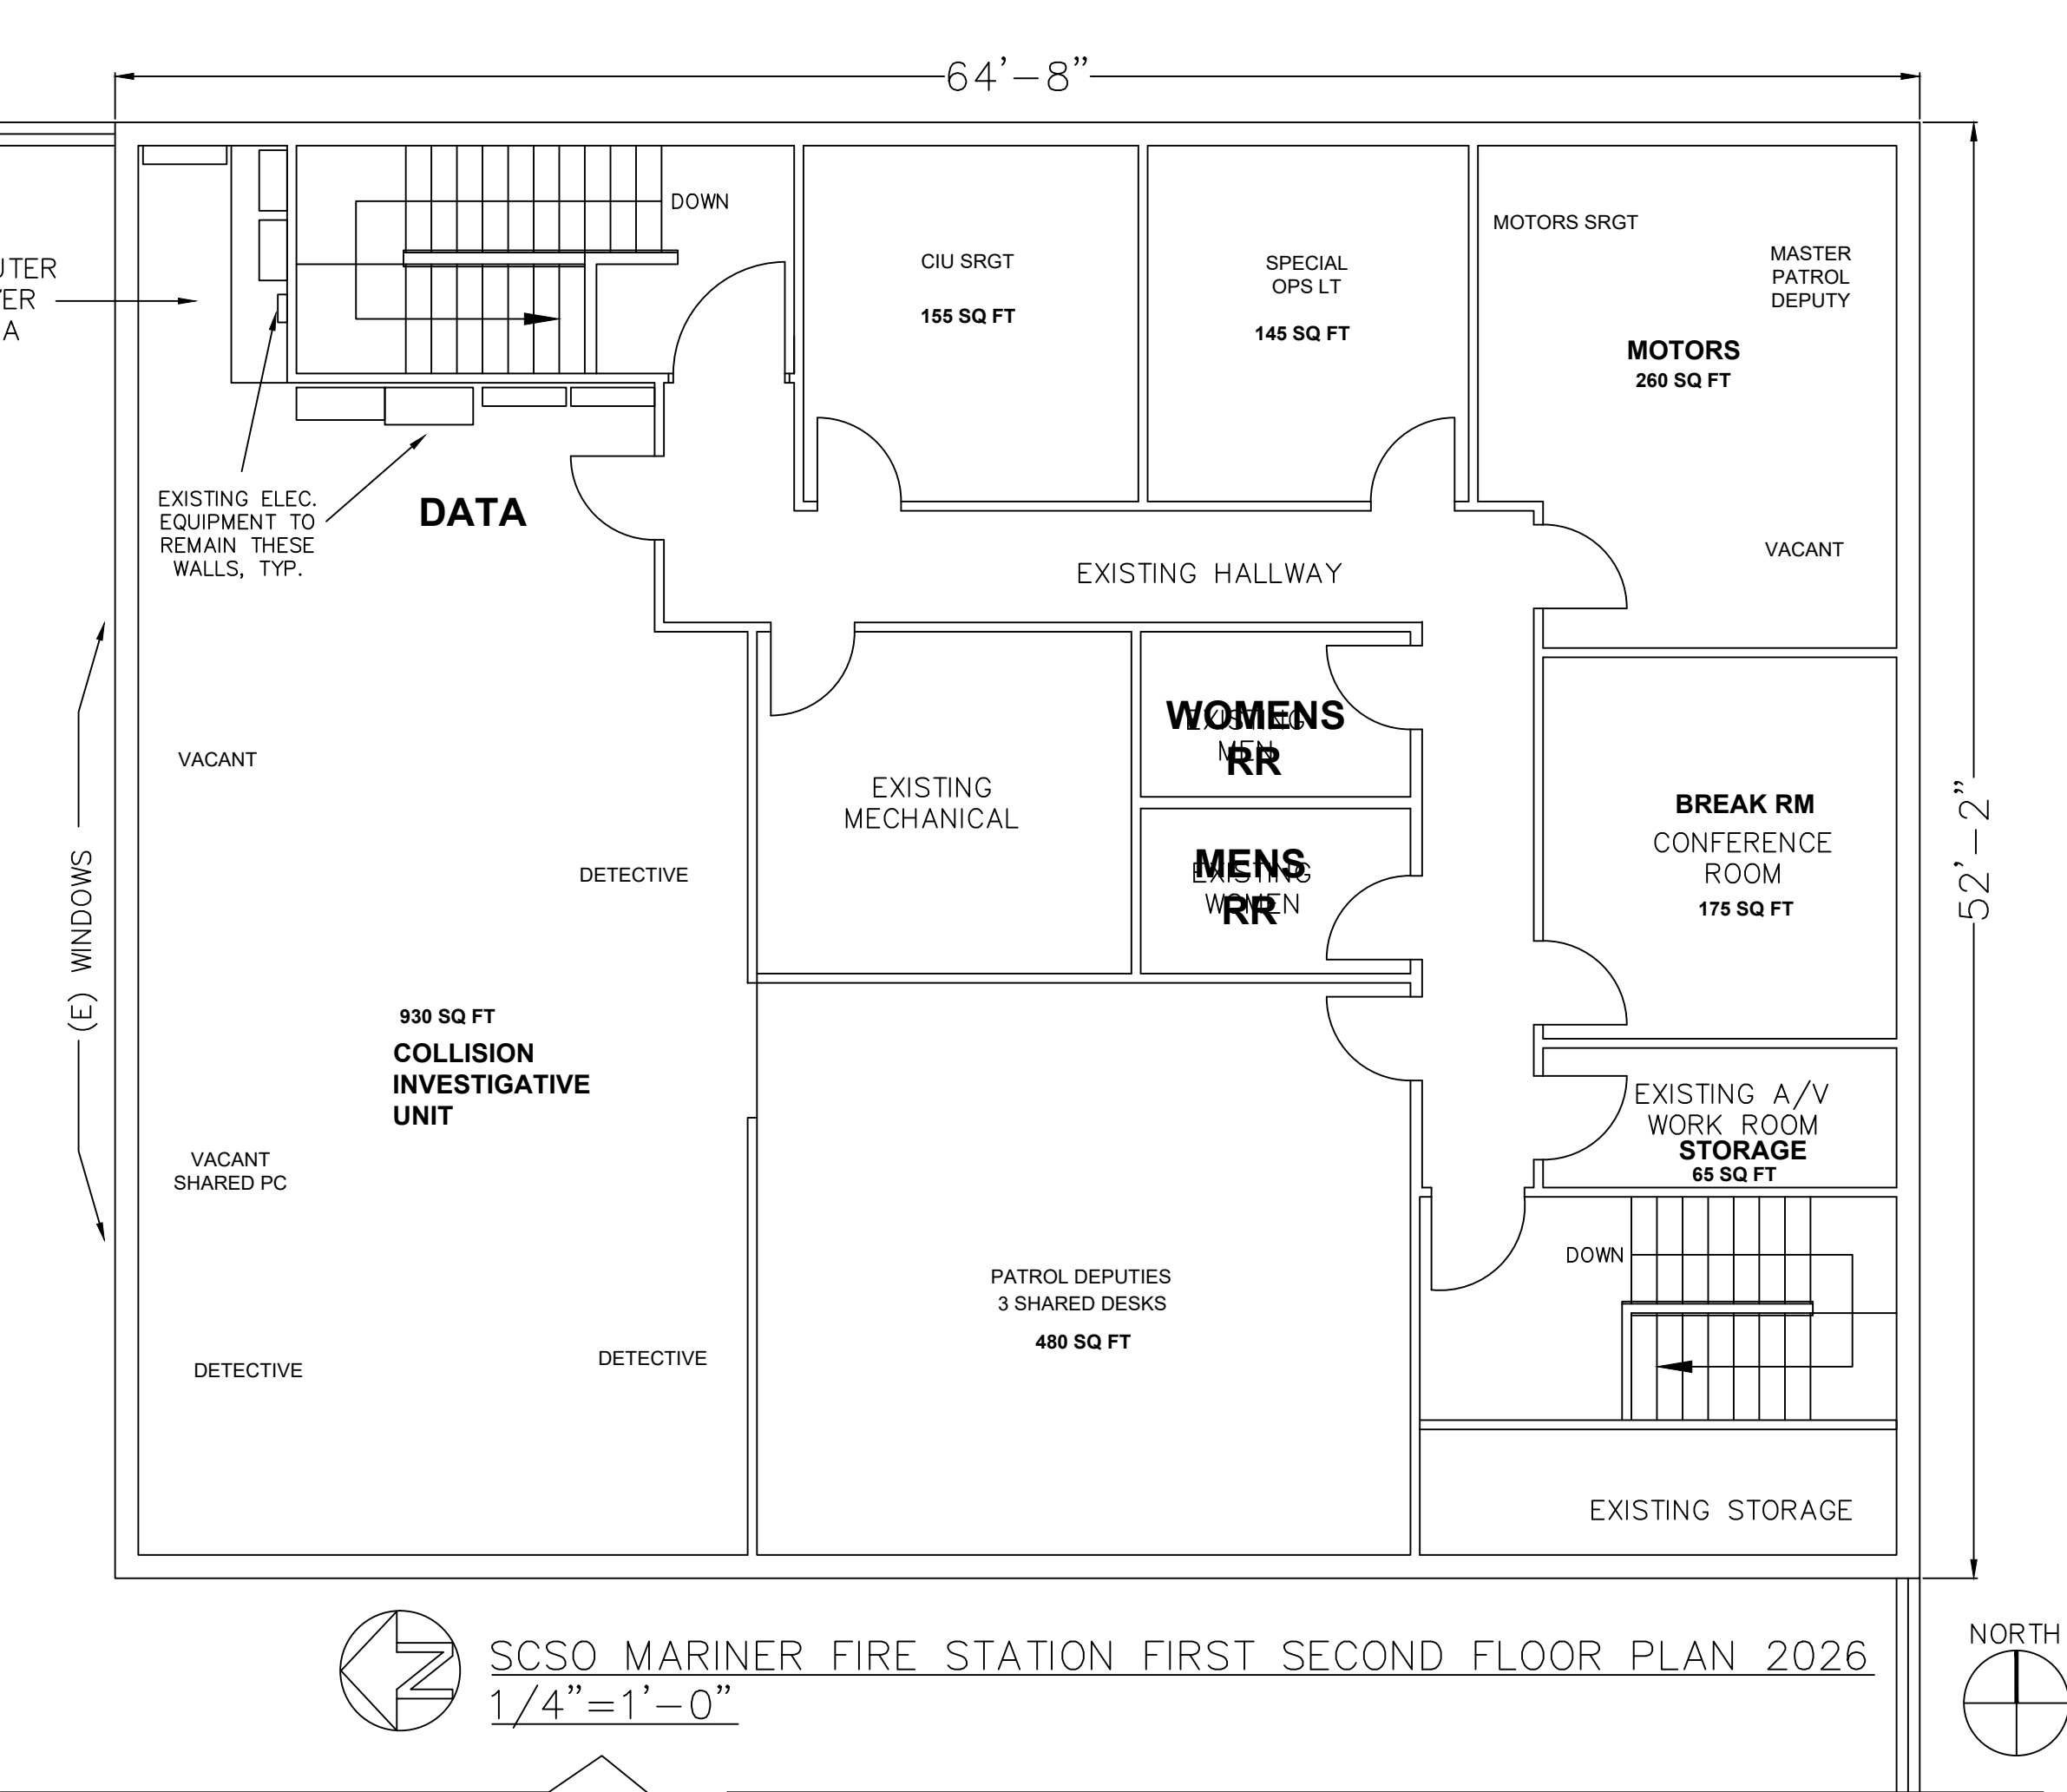

SNOHOMISH COUNTY SHERIFF
OFFICE OF NEIGHBORHOODS
MARINER SQUARE - 2026
12717 4TH AVE W
EVERETT, WA
(Srgt Fortney, Deputy Teigen)

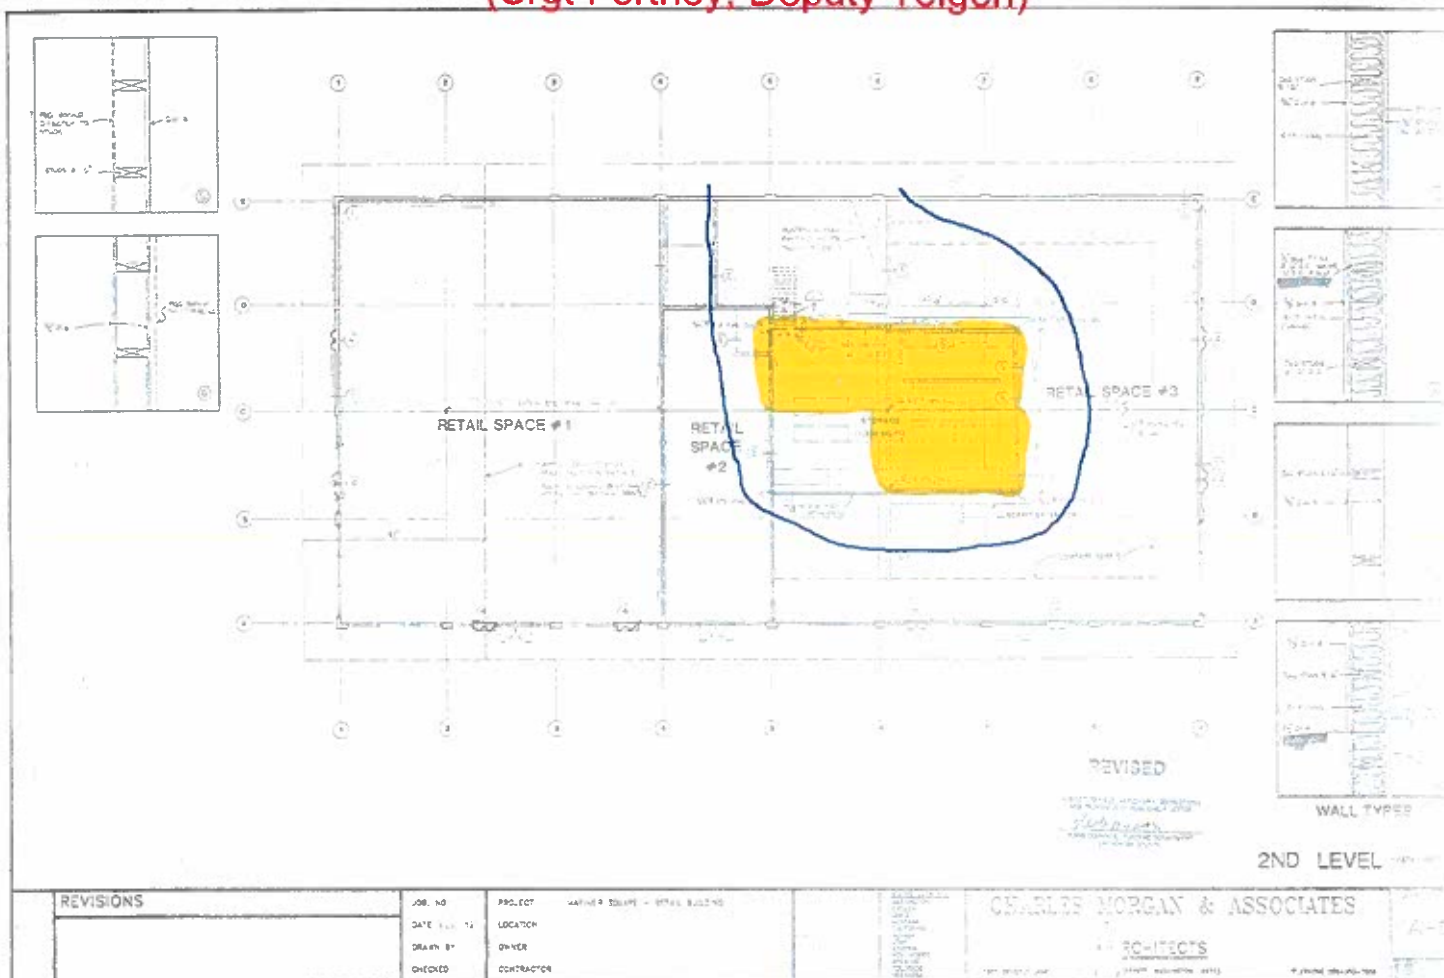


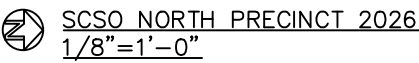

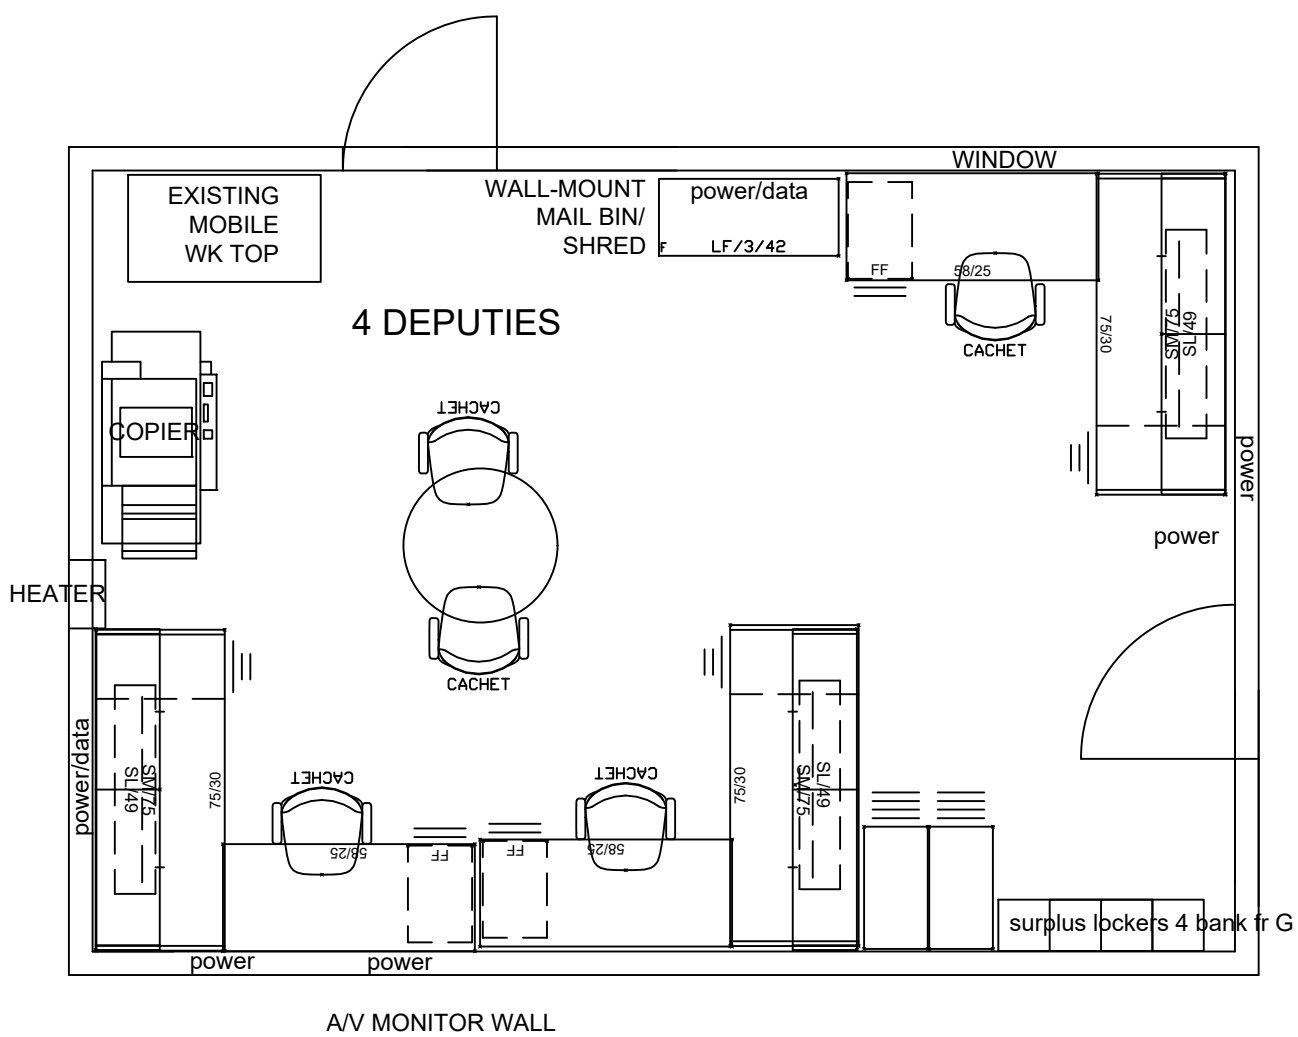

BLDG C-3 HANGAR,

LOWER LEVEL

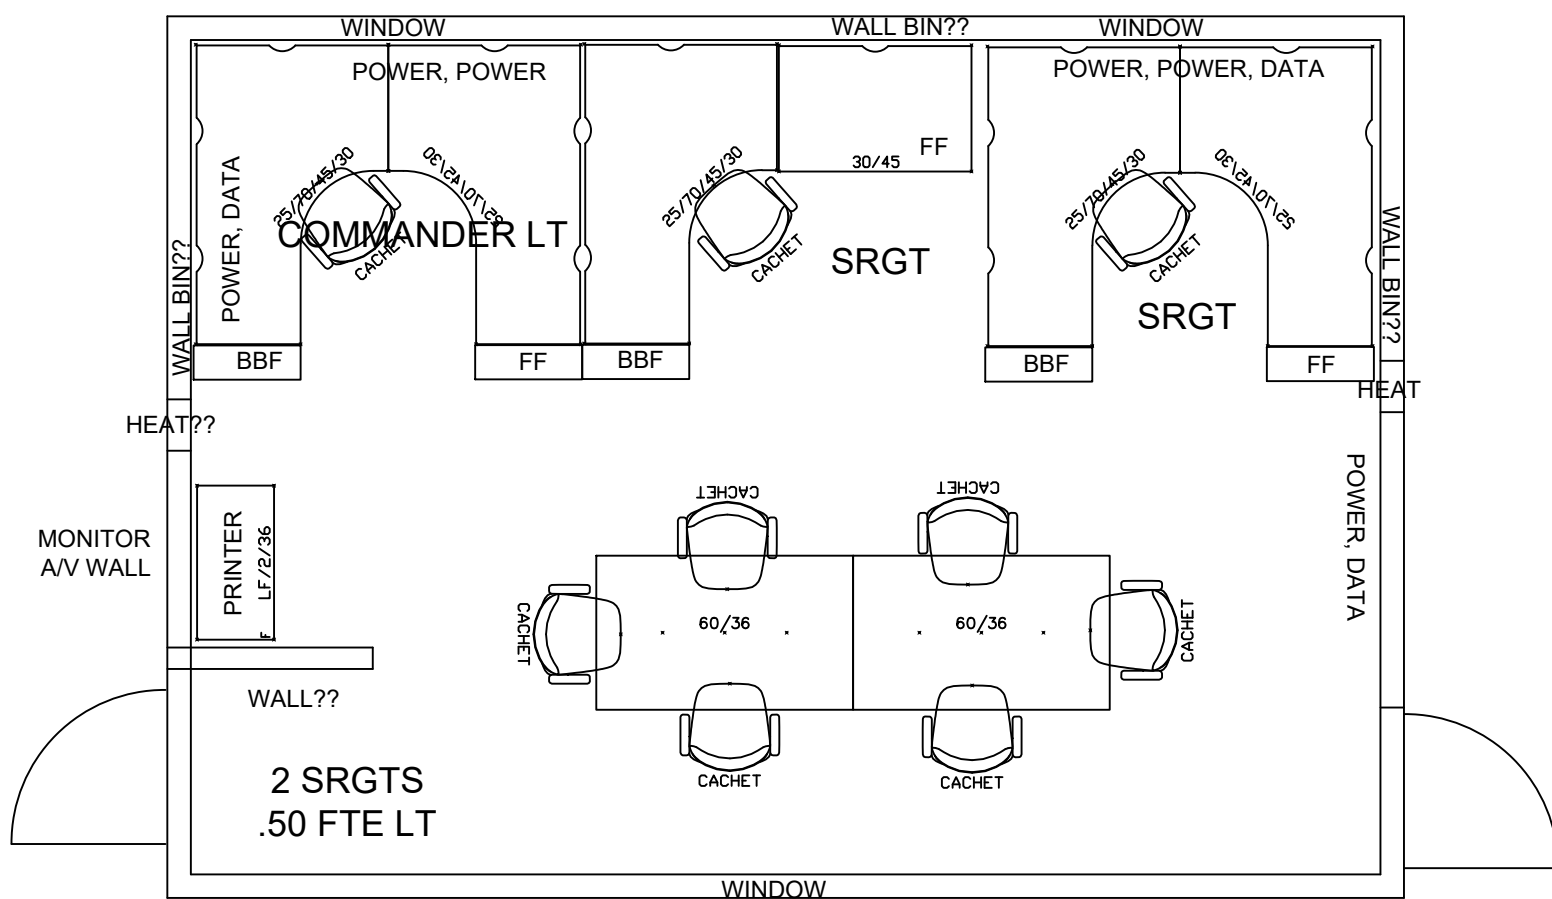


BLDG C-3 HANGAR,
UPPER LEVEL

	A	B
1	SCSO SCHOOL RESOURCE OFFICERS 2026:	LOCATION:
2	WEEKES	GLACIER PEAK HIGH SCHOOL
3	MCCURRY	STANWOOD HIGH SCHOOL
4	BOND	MARINER HIGH SCHOOL
5	LYNCH	SULTAN HIGH SCHOOL
6	PT SRO	LAKEWOOD HIGH SCHOOL

TRANSIT POLICE UNIT
COMMUNITY TRANSIT
2300 KASCH PARK RD
EVERETT, WA 98203
2026

KPOB Bldg. A - 2nd Floor

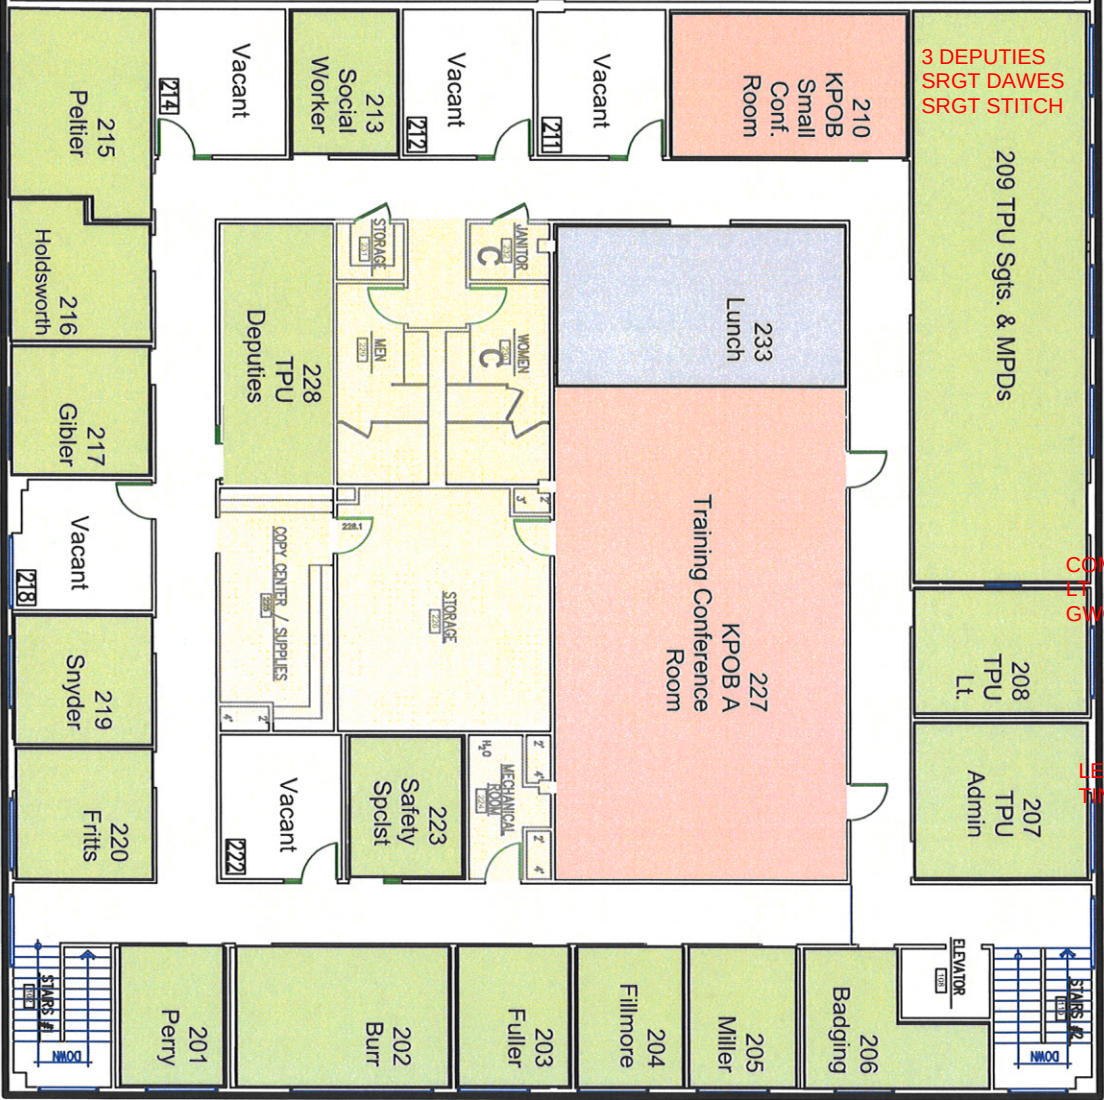

LEGEND

AMENITIES

WORKING SPACES

NON-WORKING SPACES


FLEXIBLE SPACES

DEPARTMENTS

RISK & SECURITY

SHERIFF SEARCH & RESCUE
(TAYLOR'S LANDING)
2026

Location of buildings on property
A1 - Hanger
B2 - Office & Garage
C3 - mobile Home
D4 - Garage

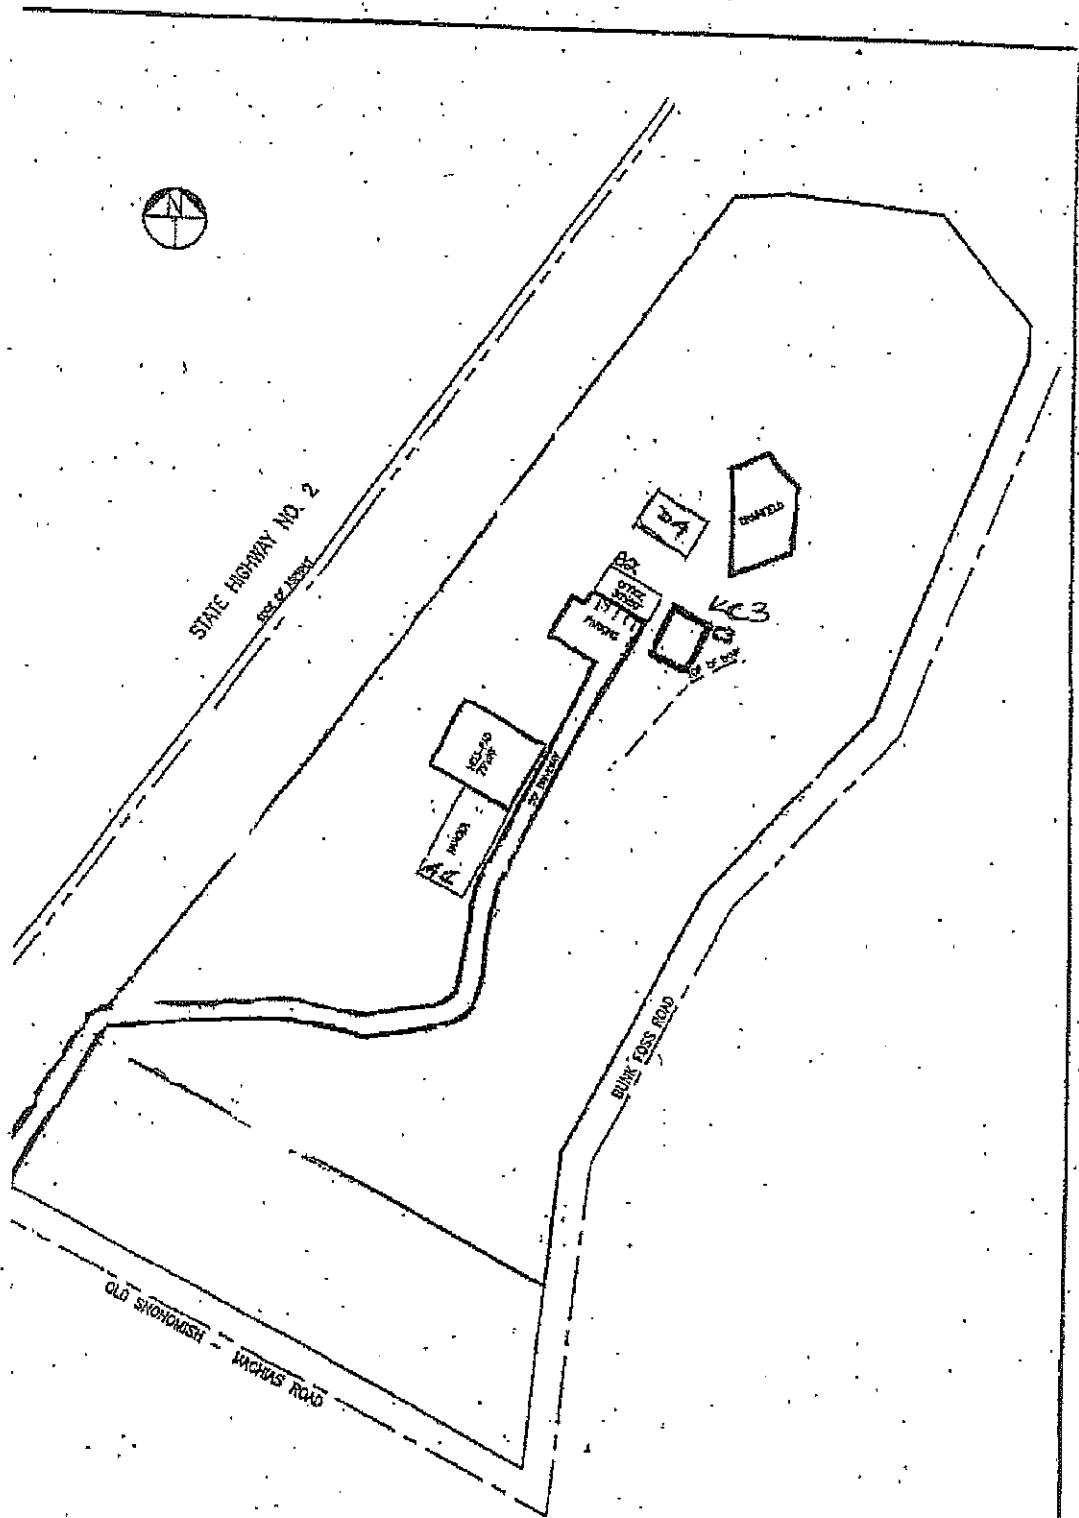

ESPELAND,
AIRPORT SUPPORT
SUPR & DEPUTY
BLDG C3

QUISTORF, CHI
EF PILOT &
DEPUTY BLDG
A1 & B2

KLETT
PILOT
PROV
DEPUTY
BLDG A1

SANDERS,
SRGT, SAR/DIVE/MARINE
BLDG B2


TESKE & DAGLEY
SAR DEPUTIES
BLDG B2

BUILDINGS		DESIGNED BY	ENGINEERING PROJECTS INC.	ORIGINAL
HELL - PRO		DRAWN BY	ENGINEERS, SURVEYORS,	SITE PLAN
PAVED AIRERS		CHECKED BY	CONSTRUCTION MANAGERS	FOR
DEBRIS FIELD		APPROVED BY		SNOHOMISH COUNTY
		DATE		VOLUNTEER
		SCALE		SEARCH & RESCUE
		NO. 100		P.O. BOX 253
		REVISED		SNOHOMISH, WA 98270

SHERIFF FAIRGROUNDS 2026

FORMER East Precinct
SHERIFF'S PRECINCT

1,904 sq

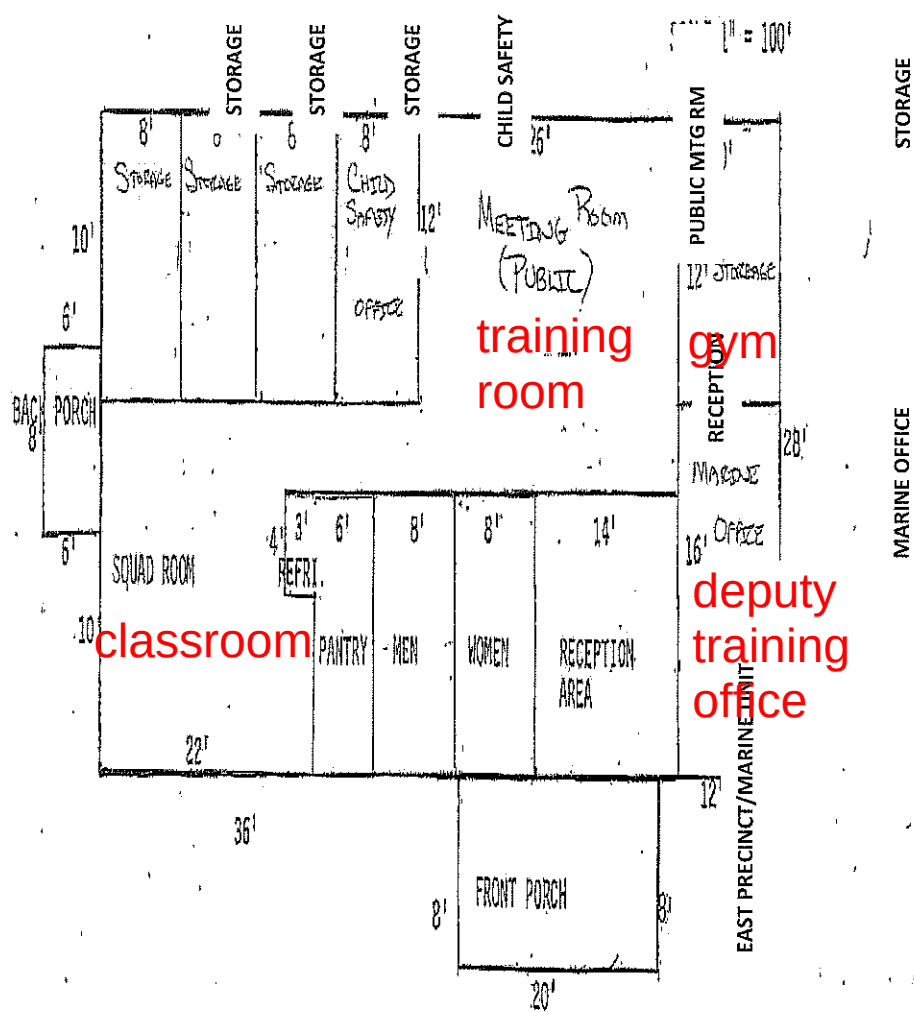


Mattson, Deputy
Whipple, Deputy

Training Center &
Deputy satellite bldg


DRAWING A3
WALL AND DOOR PLAN


- NOTES: in red only
- 1A) Reuse Existing 36" Door and jam
 - 1B) Reuse Existing 36" Door and jam
 - 1C) Install new 36" door and jam, match existing
 - 2) 5' Opening - No Door
 - 3) 42" High Swing Door
 - 4) 42" High Wall - 12" wide Wood Top
 - 5) Full Height Wall (Typical)
 - 6) Remove Door & Window from Wall & Frame to Match Existing. Reuse door, jam and trim at 1A.
 - 7) Core drill 2x 1" holes in concrete floor inside the wall cavity for communication conduit.
 - 8) install a 24"X32" 3/4 " mounting plate.

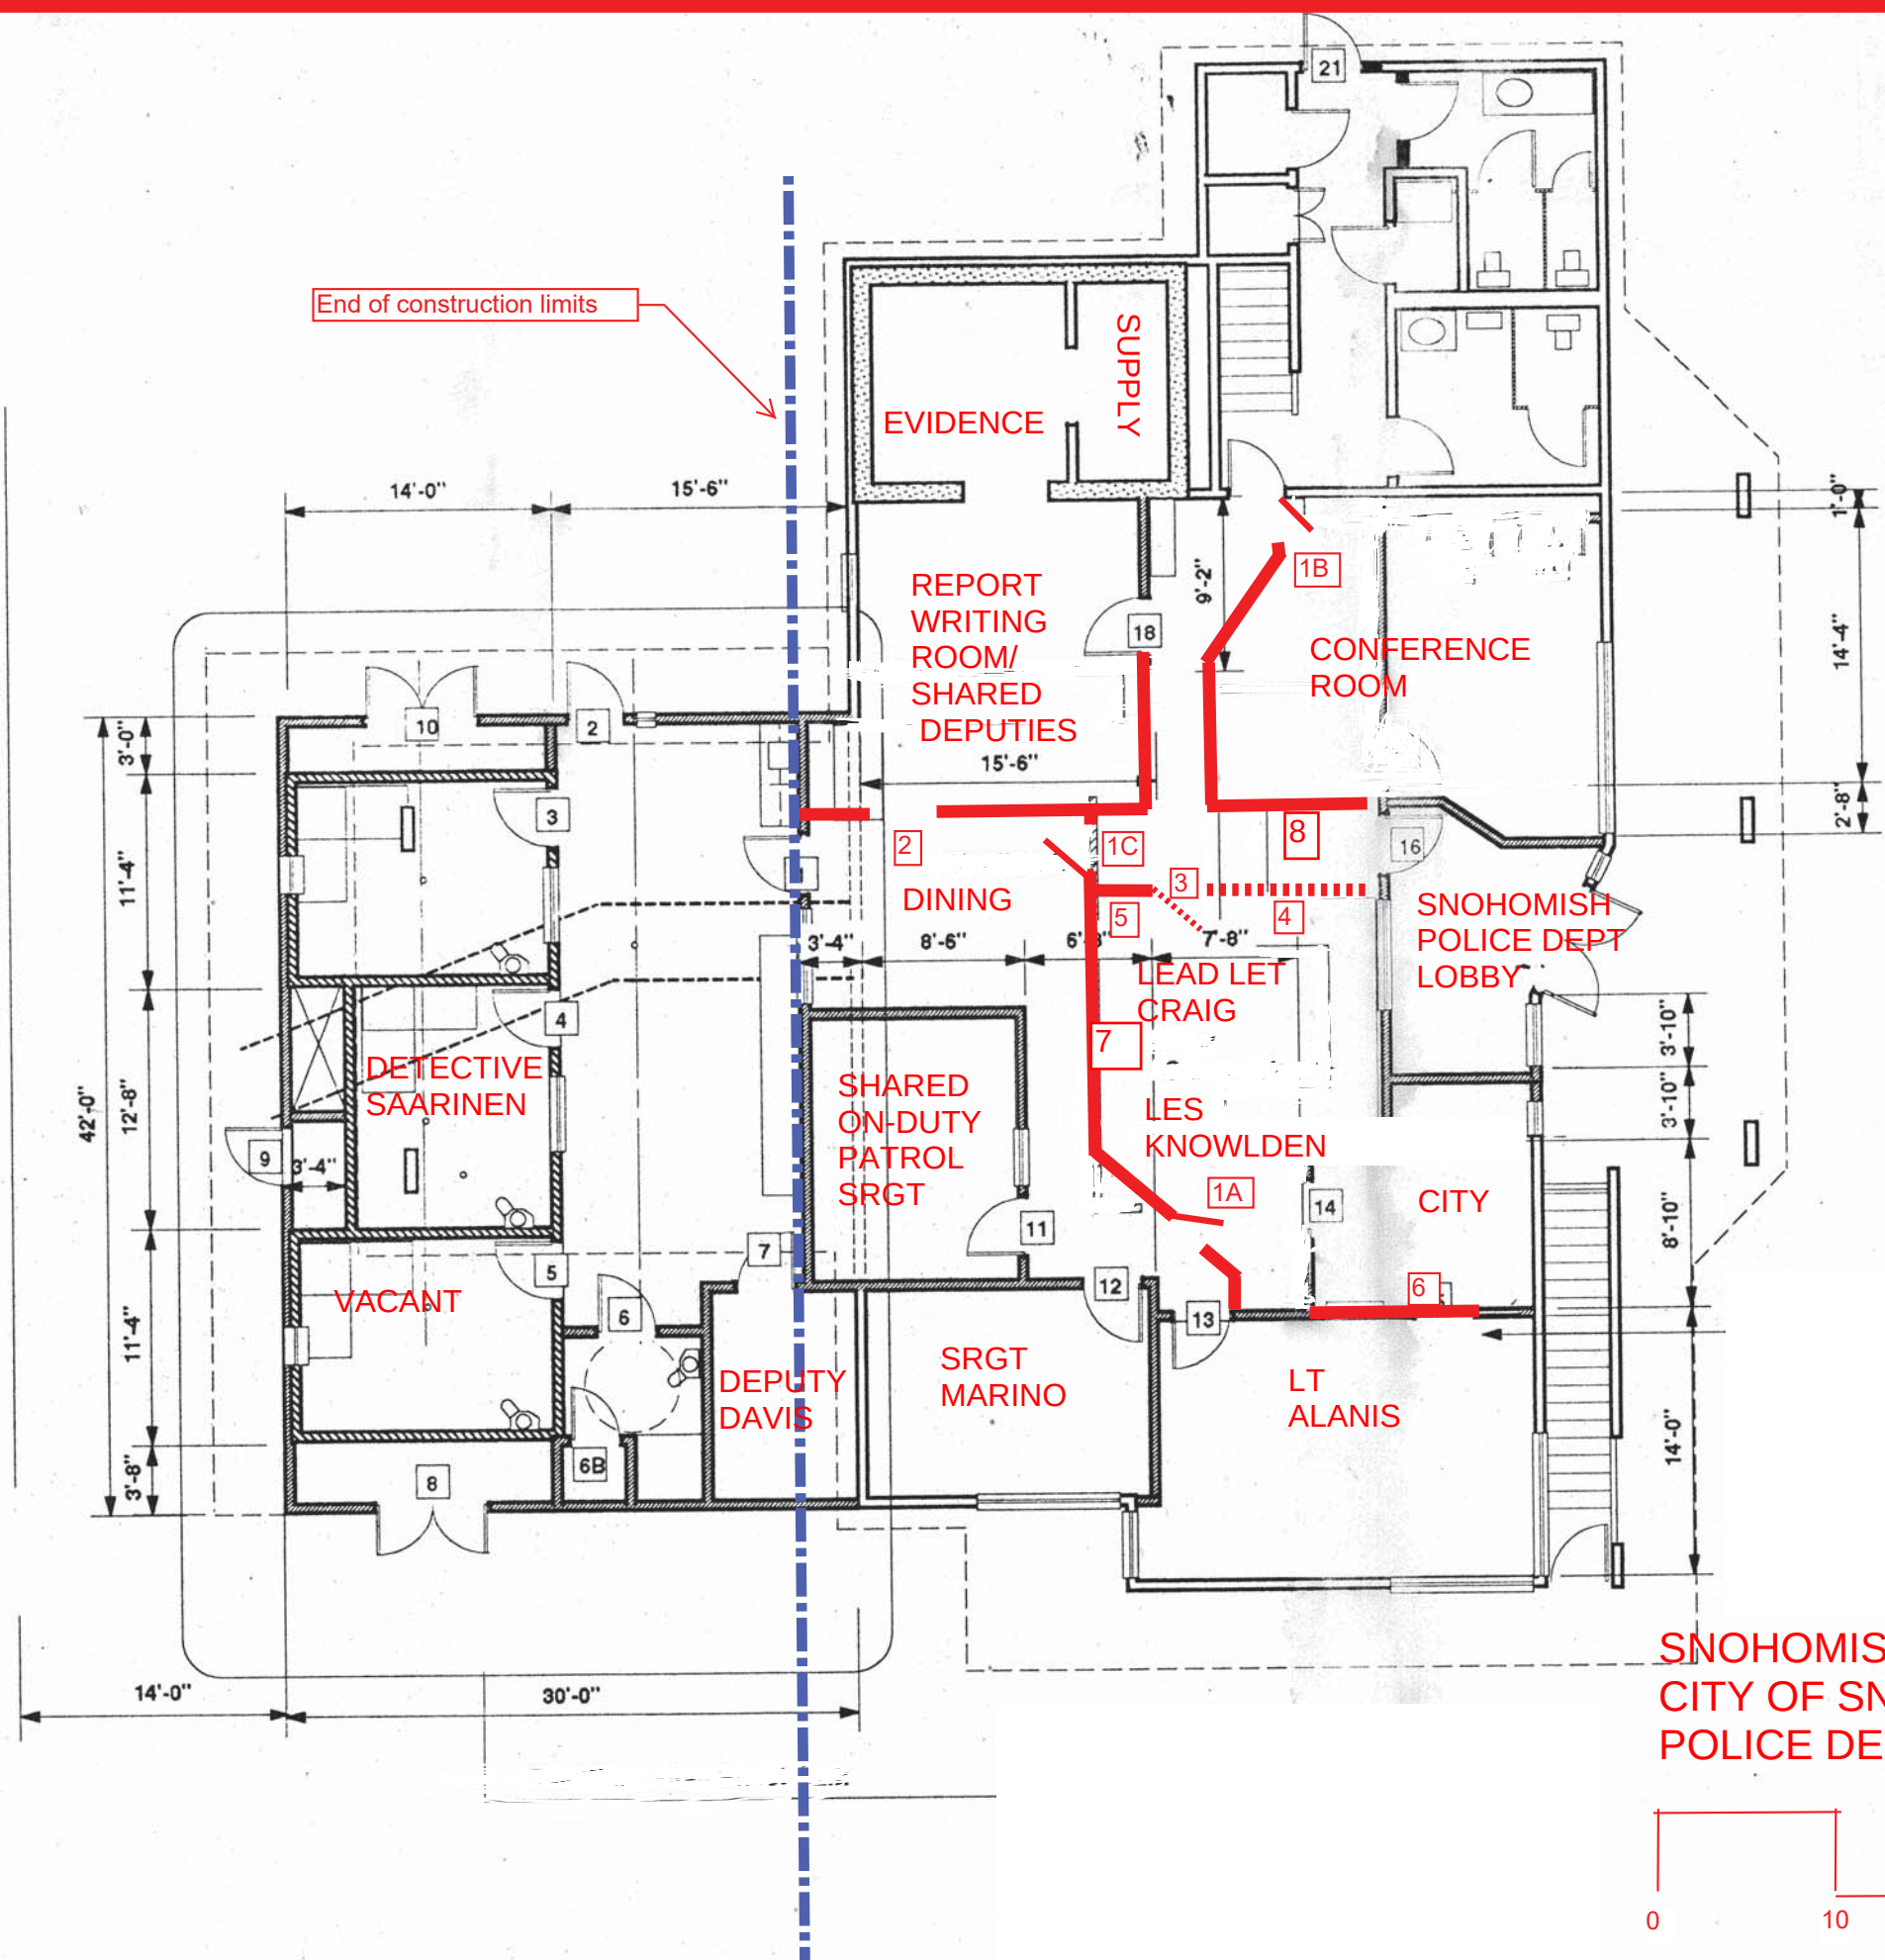

SNOHOMISH COUNTY SHERIFF &
CITY OF SNOHOMISH
POLICE DEPT 2026

REVISIONS		
#	Comments	Date
Date: March 10, 2016		
Project Title Snohomish Police Department		

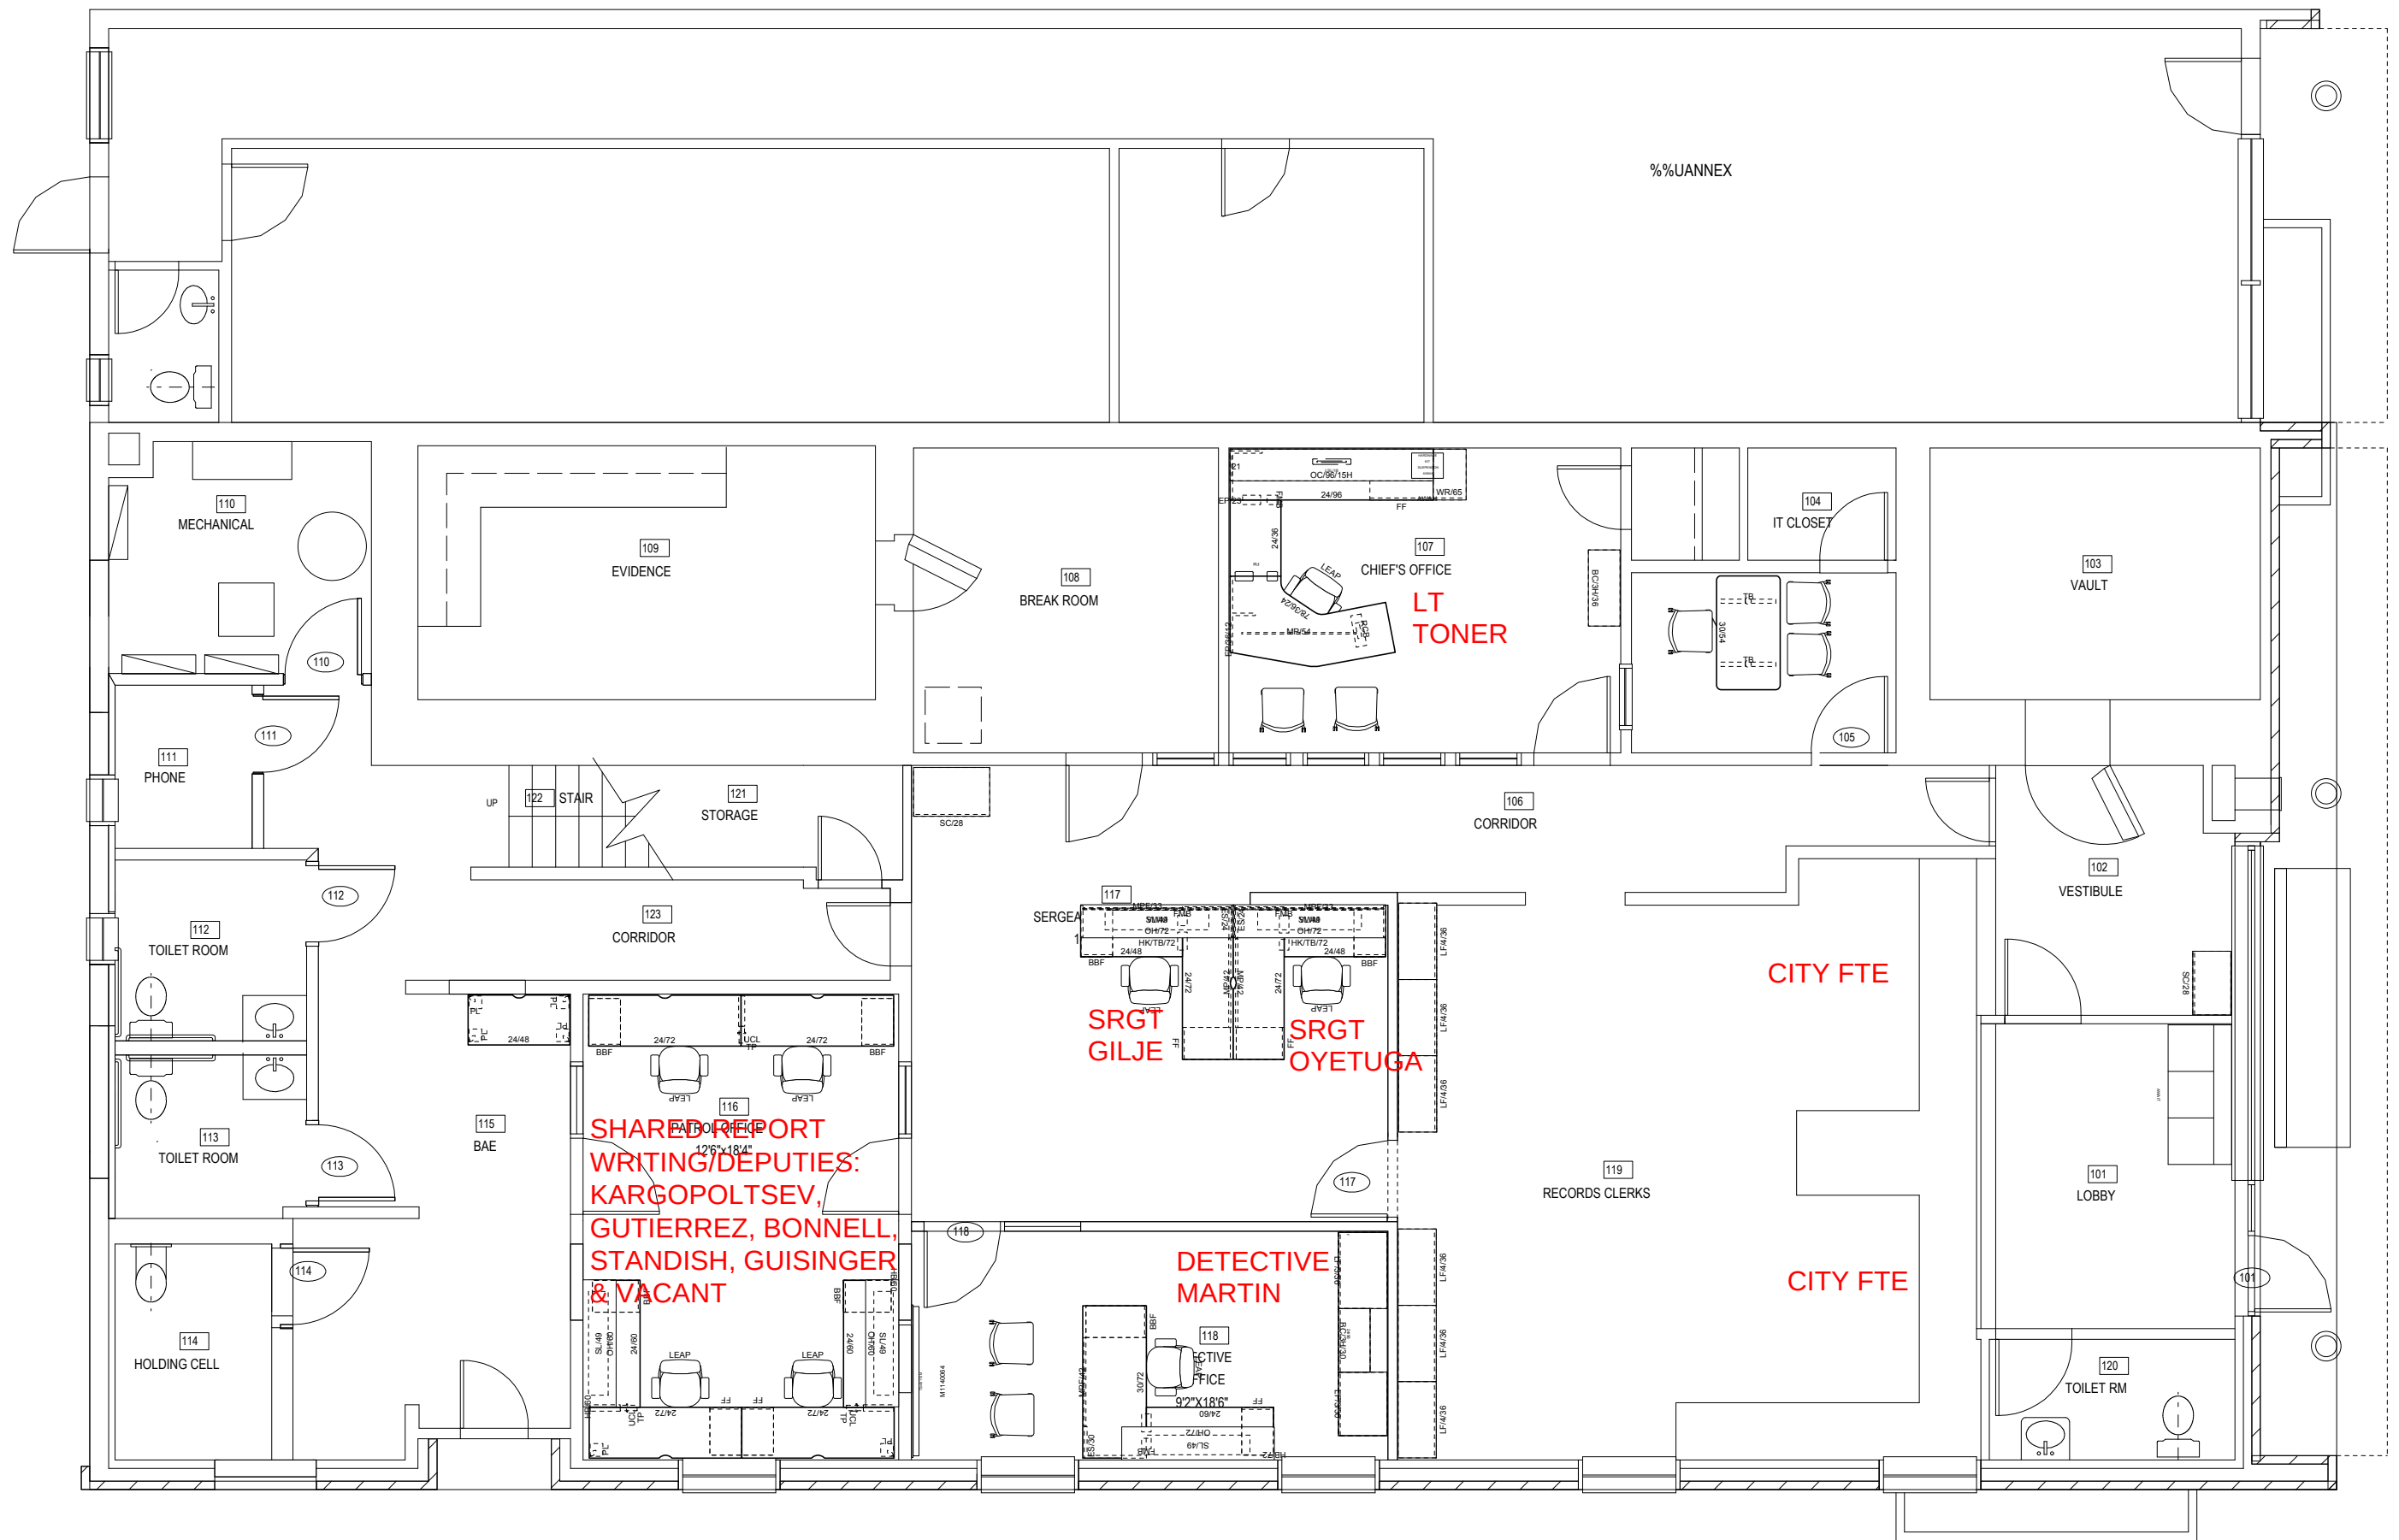

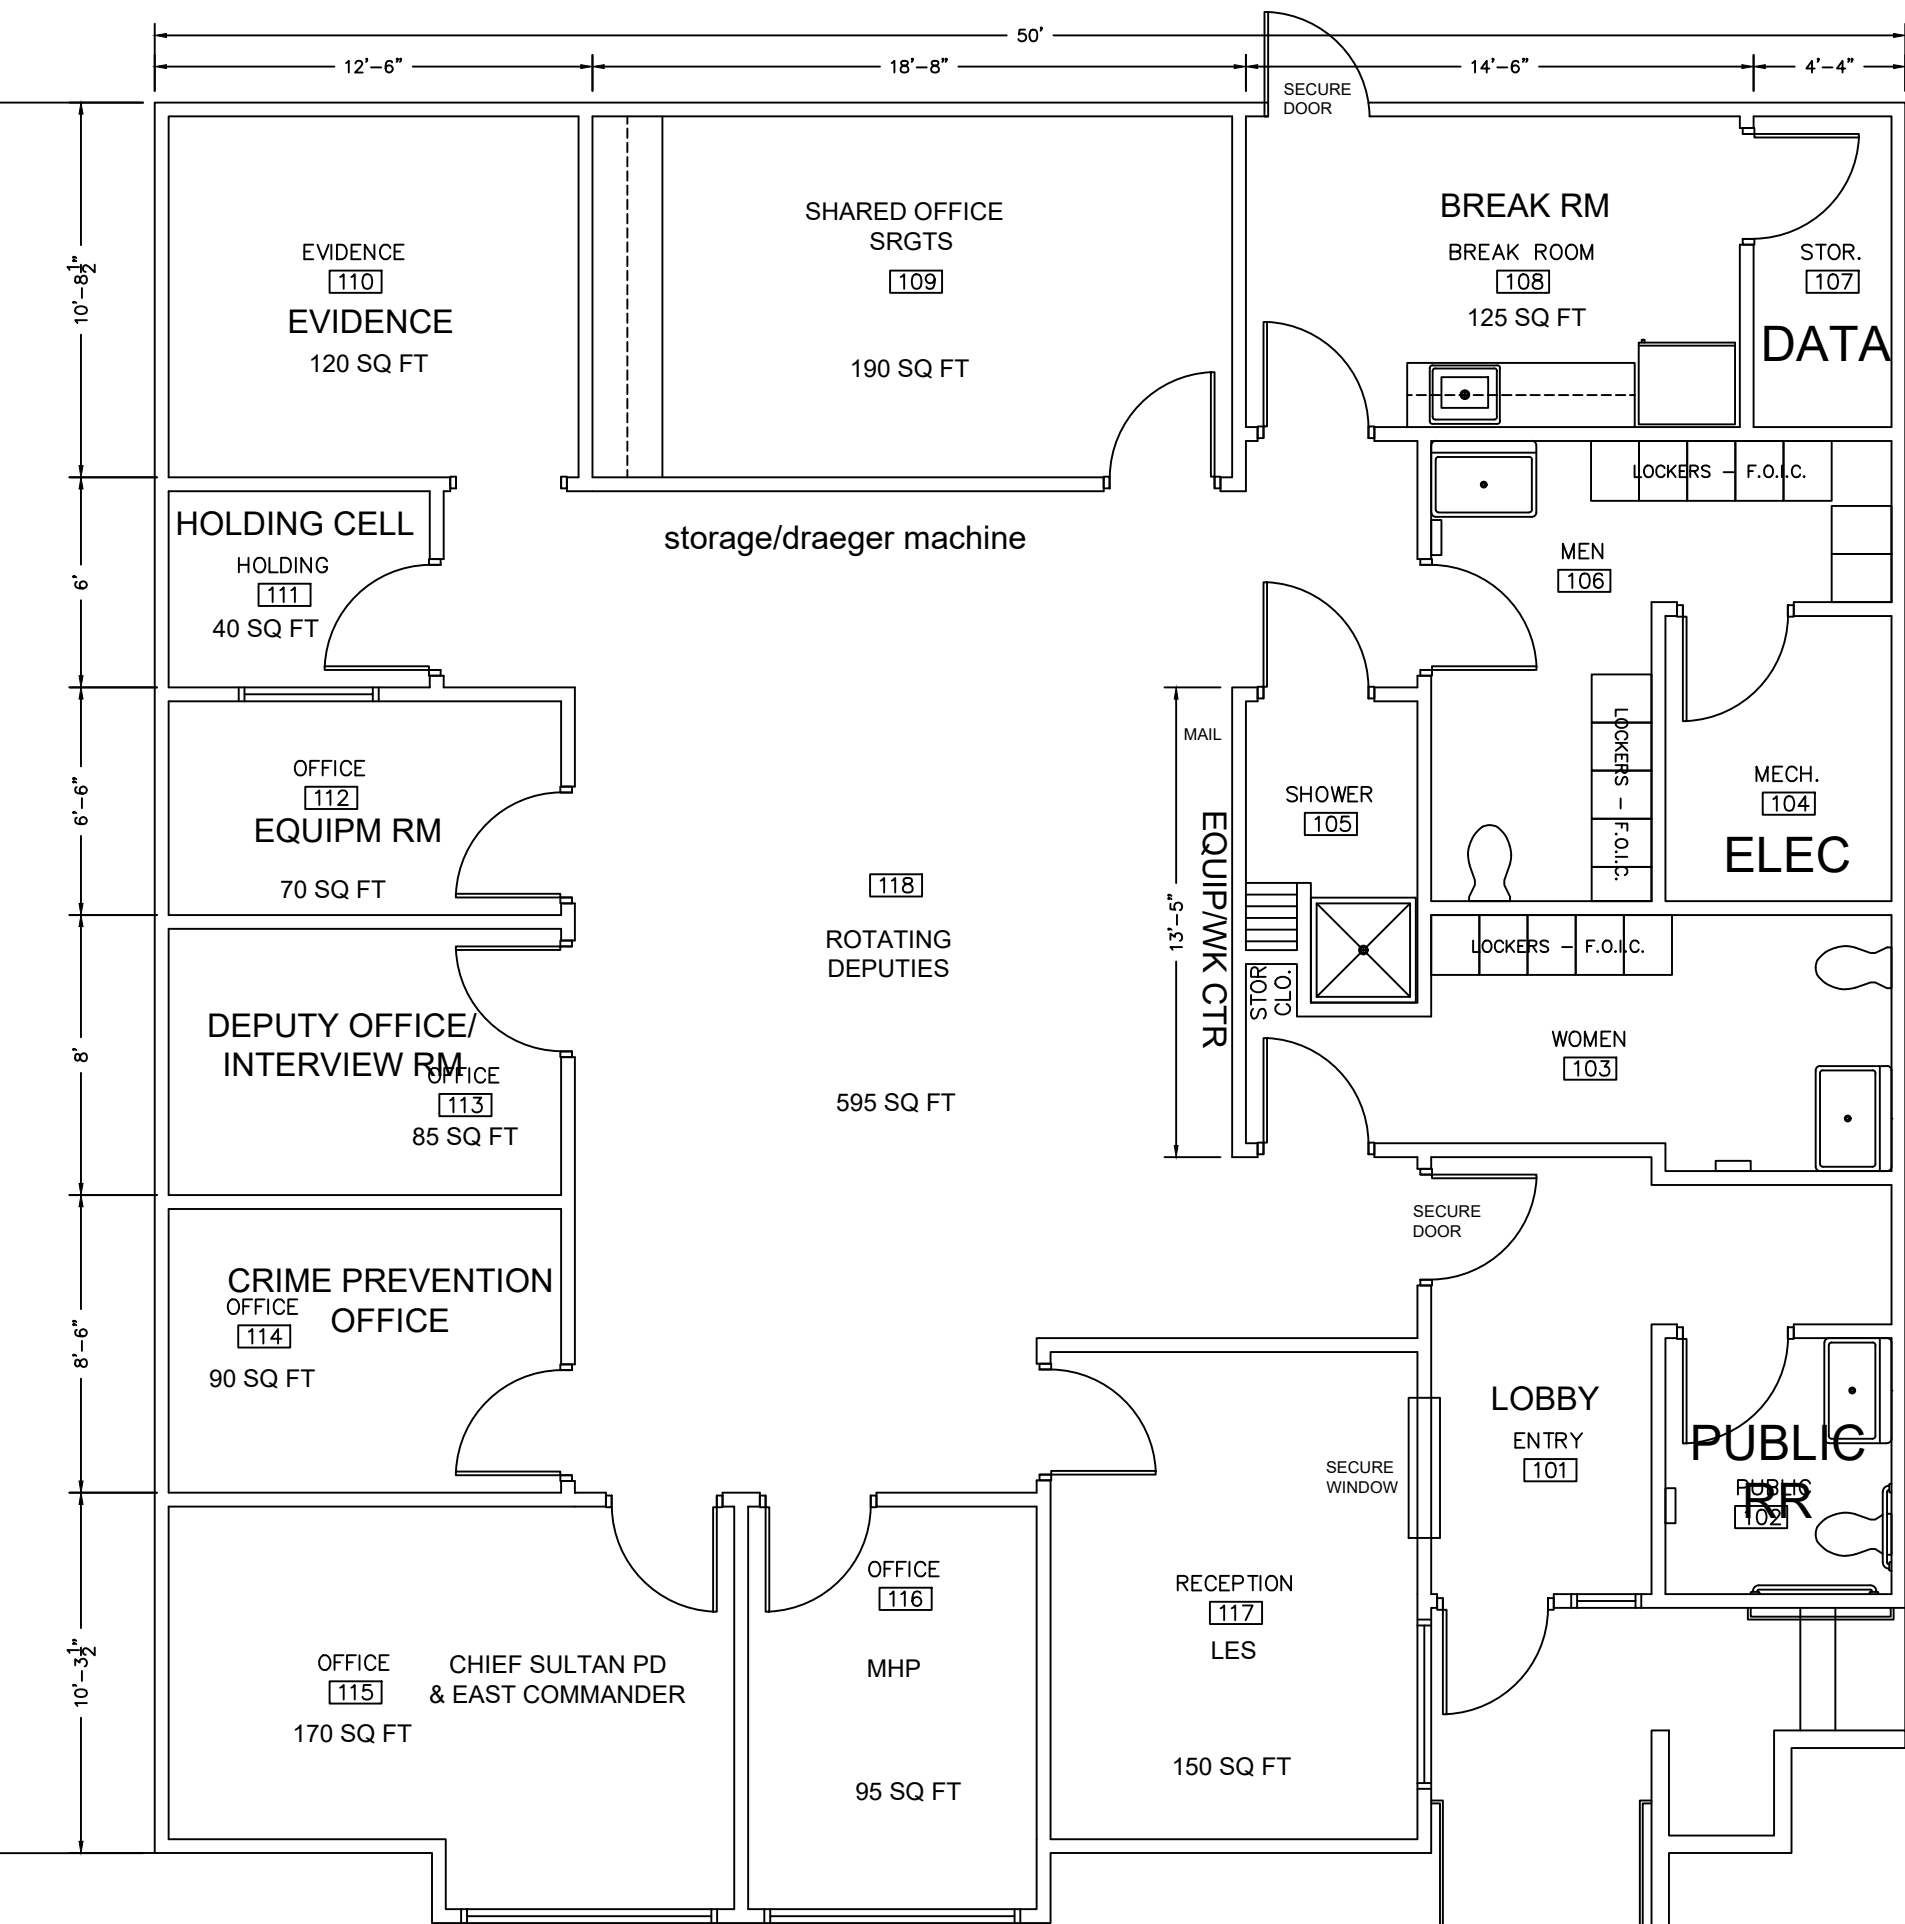

SCSO SULTAN PD/EAST PRECINCT 2026

FLOOR PLAN
1/4"=1'-0"


AIRPORT ROAD RECYCLING AND TRANSFER STATION (ARTS) SITE FACILITIES - PHASE 2

Roll-up
Doors

MIN 25'-28'


AIRPORT ROAD RECYCLING &
TRANSFER STATION (ARTS):
SUPR, JONES
OPERATORS, 2 FTE
LABORERS, 14 FTE
SITE ATTENDANTS, 8 FTE
2026

PROJECT No. SDC-5015

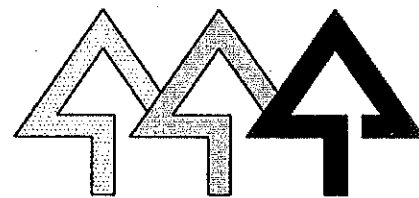

SNOHOMISH COUNTY PUBLIC WORKS SOLID WASTE MANAGEMENT DIVISION

G16
C71, 72, 73, 74
C111, 112
C115, 116
C117
S301
A101, 102, 103
A105, 106, 107
A112,
A201, 203, 205, 206
A302

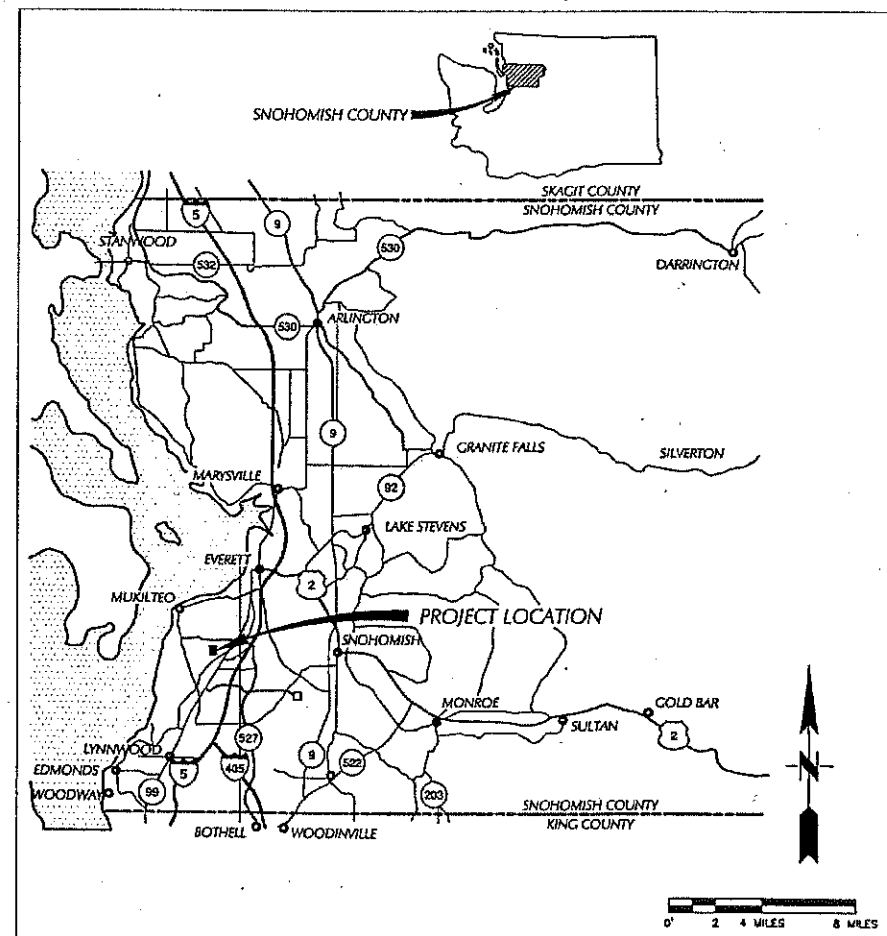

PROJECT VICINITY

SNOHOMISH COUNTY OFFICIALS DIRECTOR OF PUBLIC WORKS


Peter E. Hahn

COUNTY ENGINEER
Steven E. Thomsen, P.E.

EXECUTIVE
Robert J. Drewel

COUNCIL MEMBERS
John Koster - DIST. 1
Kirke Seivers - DIST. 2
Gary Nelson - DIST. 3
Dave Gosset - DIST. 4
Jeff Sax - DIST. 5

JANUARY 2002

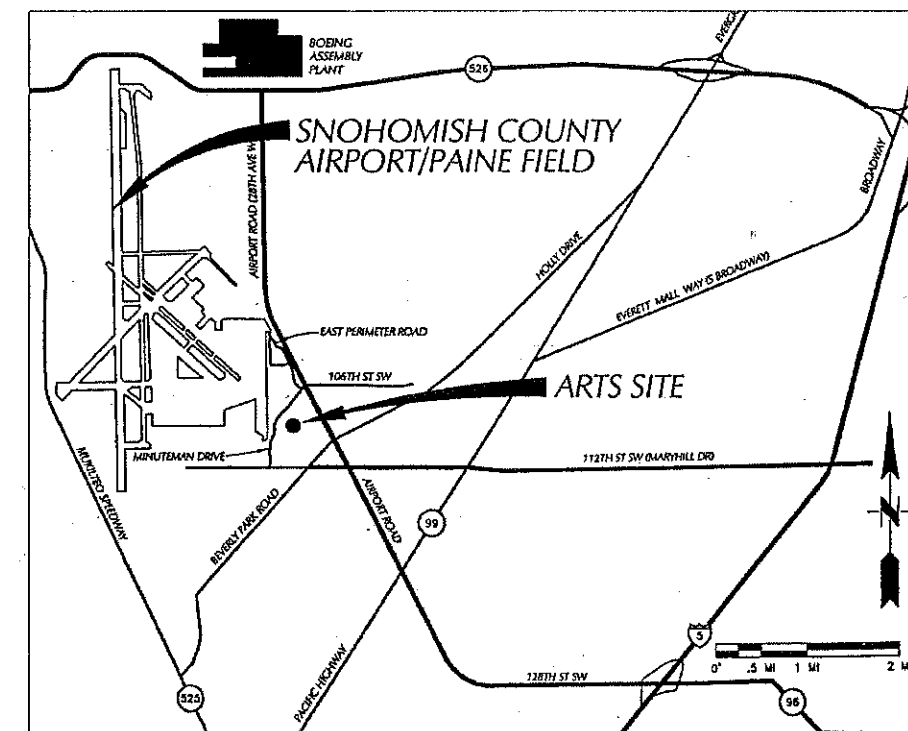

PROJECT LOCATION

10700 MINUTEMAN DRIVE
EVERETT, WA 98204


OWNER/OPERATOR: SNOHOMISH COUNTY PUBLIC WORKS
SOLID WASTE MANAGEMENT DIVISION
2830 WETMORE AVENUE, SUITE 101
EVERETT, WA 98201-4044


CONTACT: MARK WESTENSKOW, PROJECT MANAGER
425-388-6484


CONTRACTOR: TO BE DETERMINED

R-W BECK

KPG Architects
Engineers
Landscape Architects

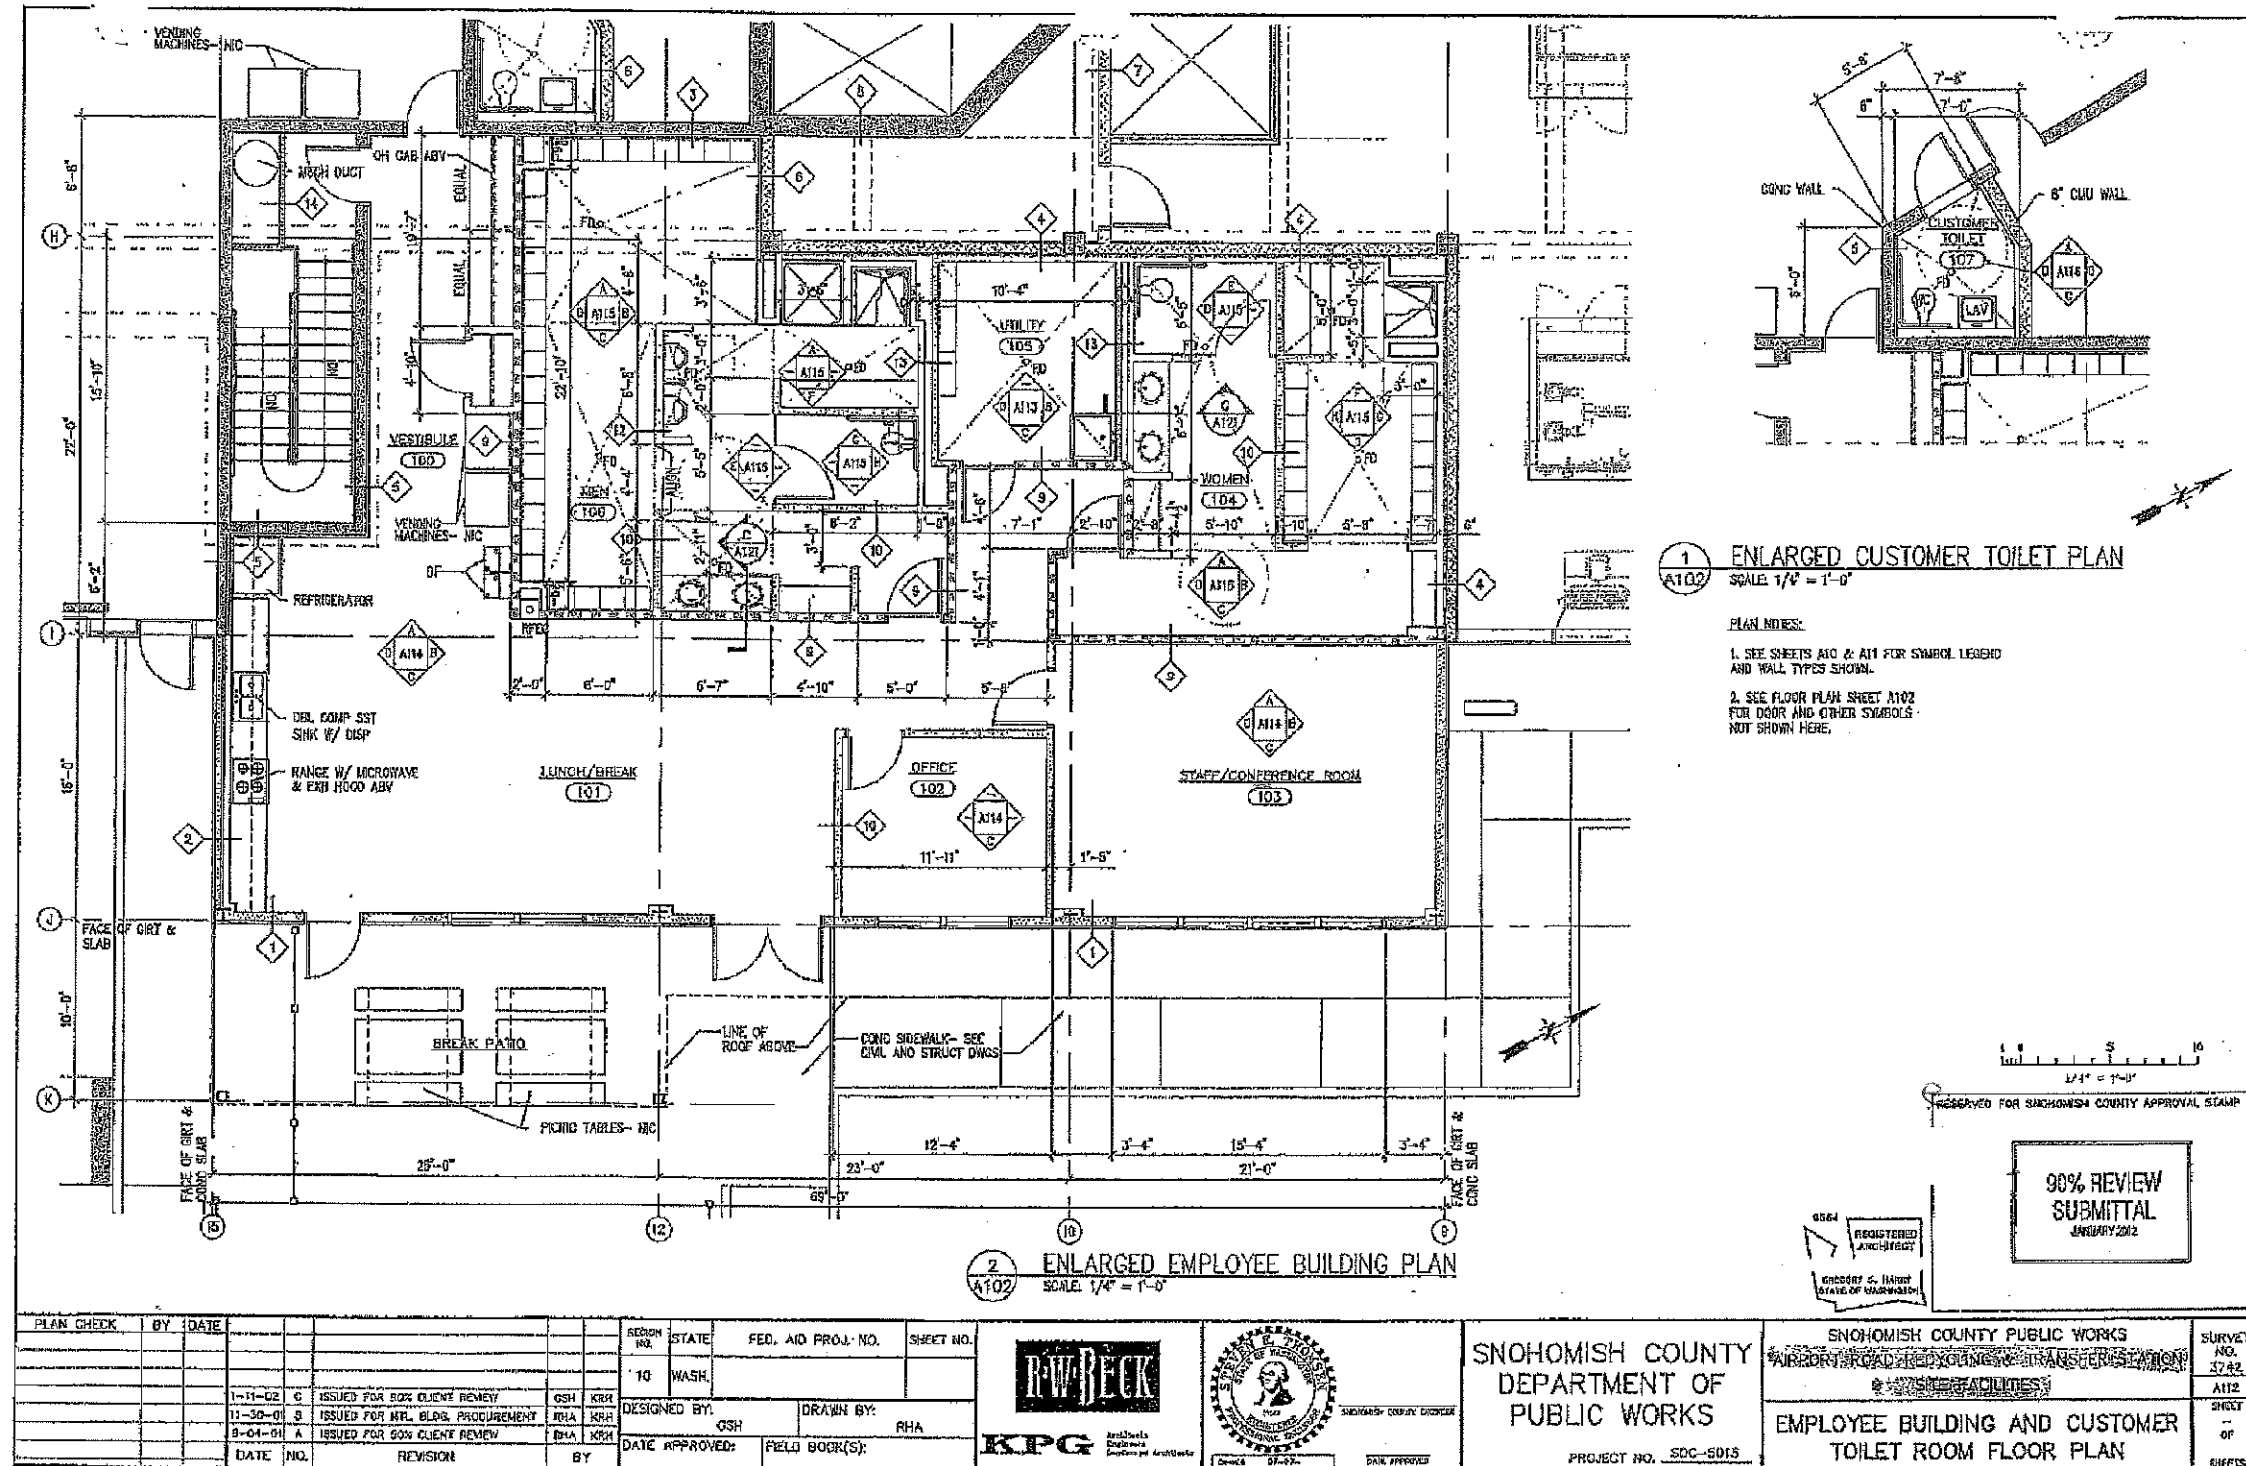

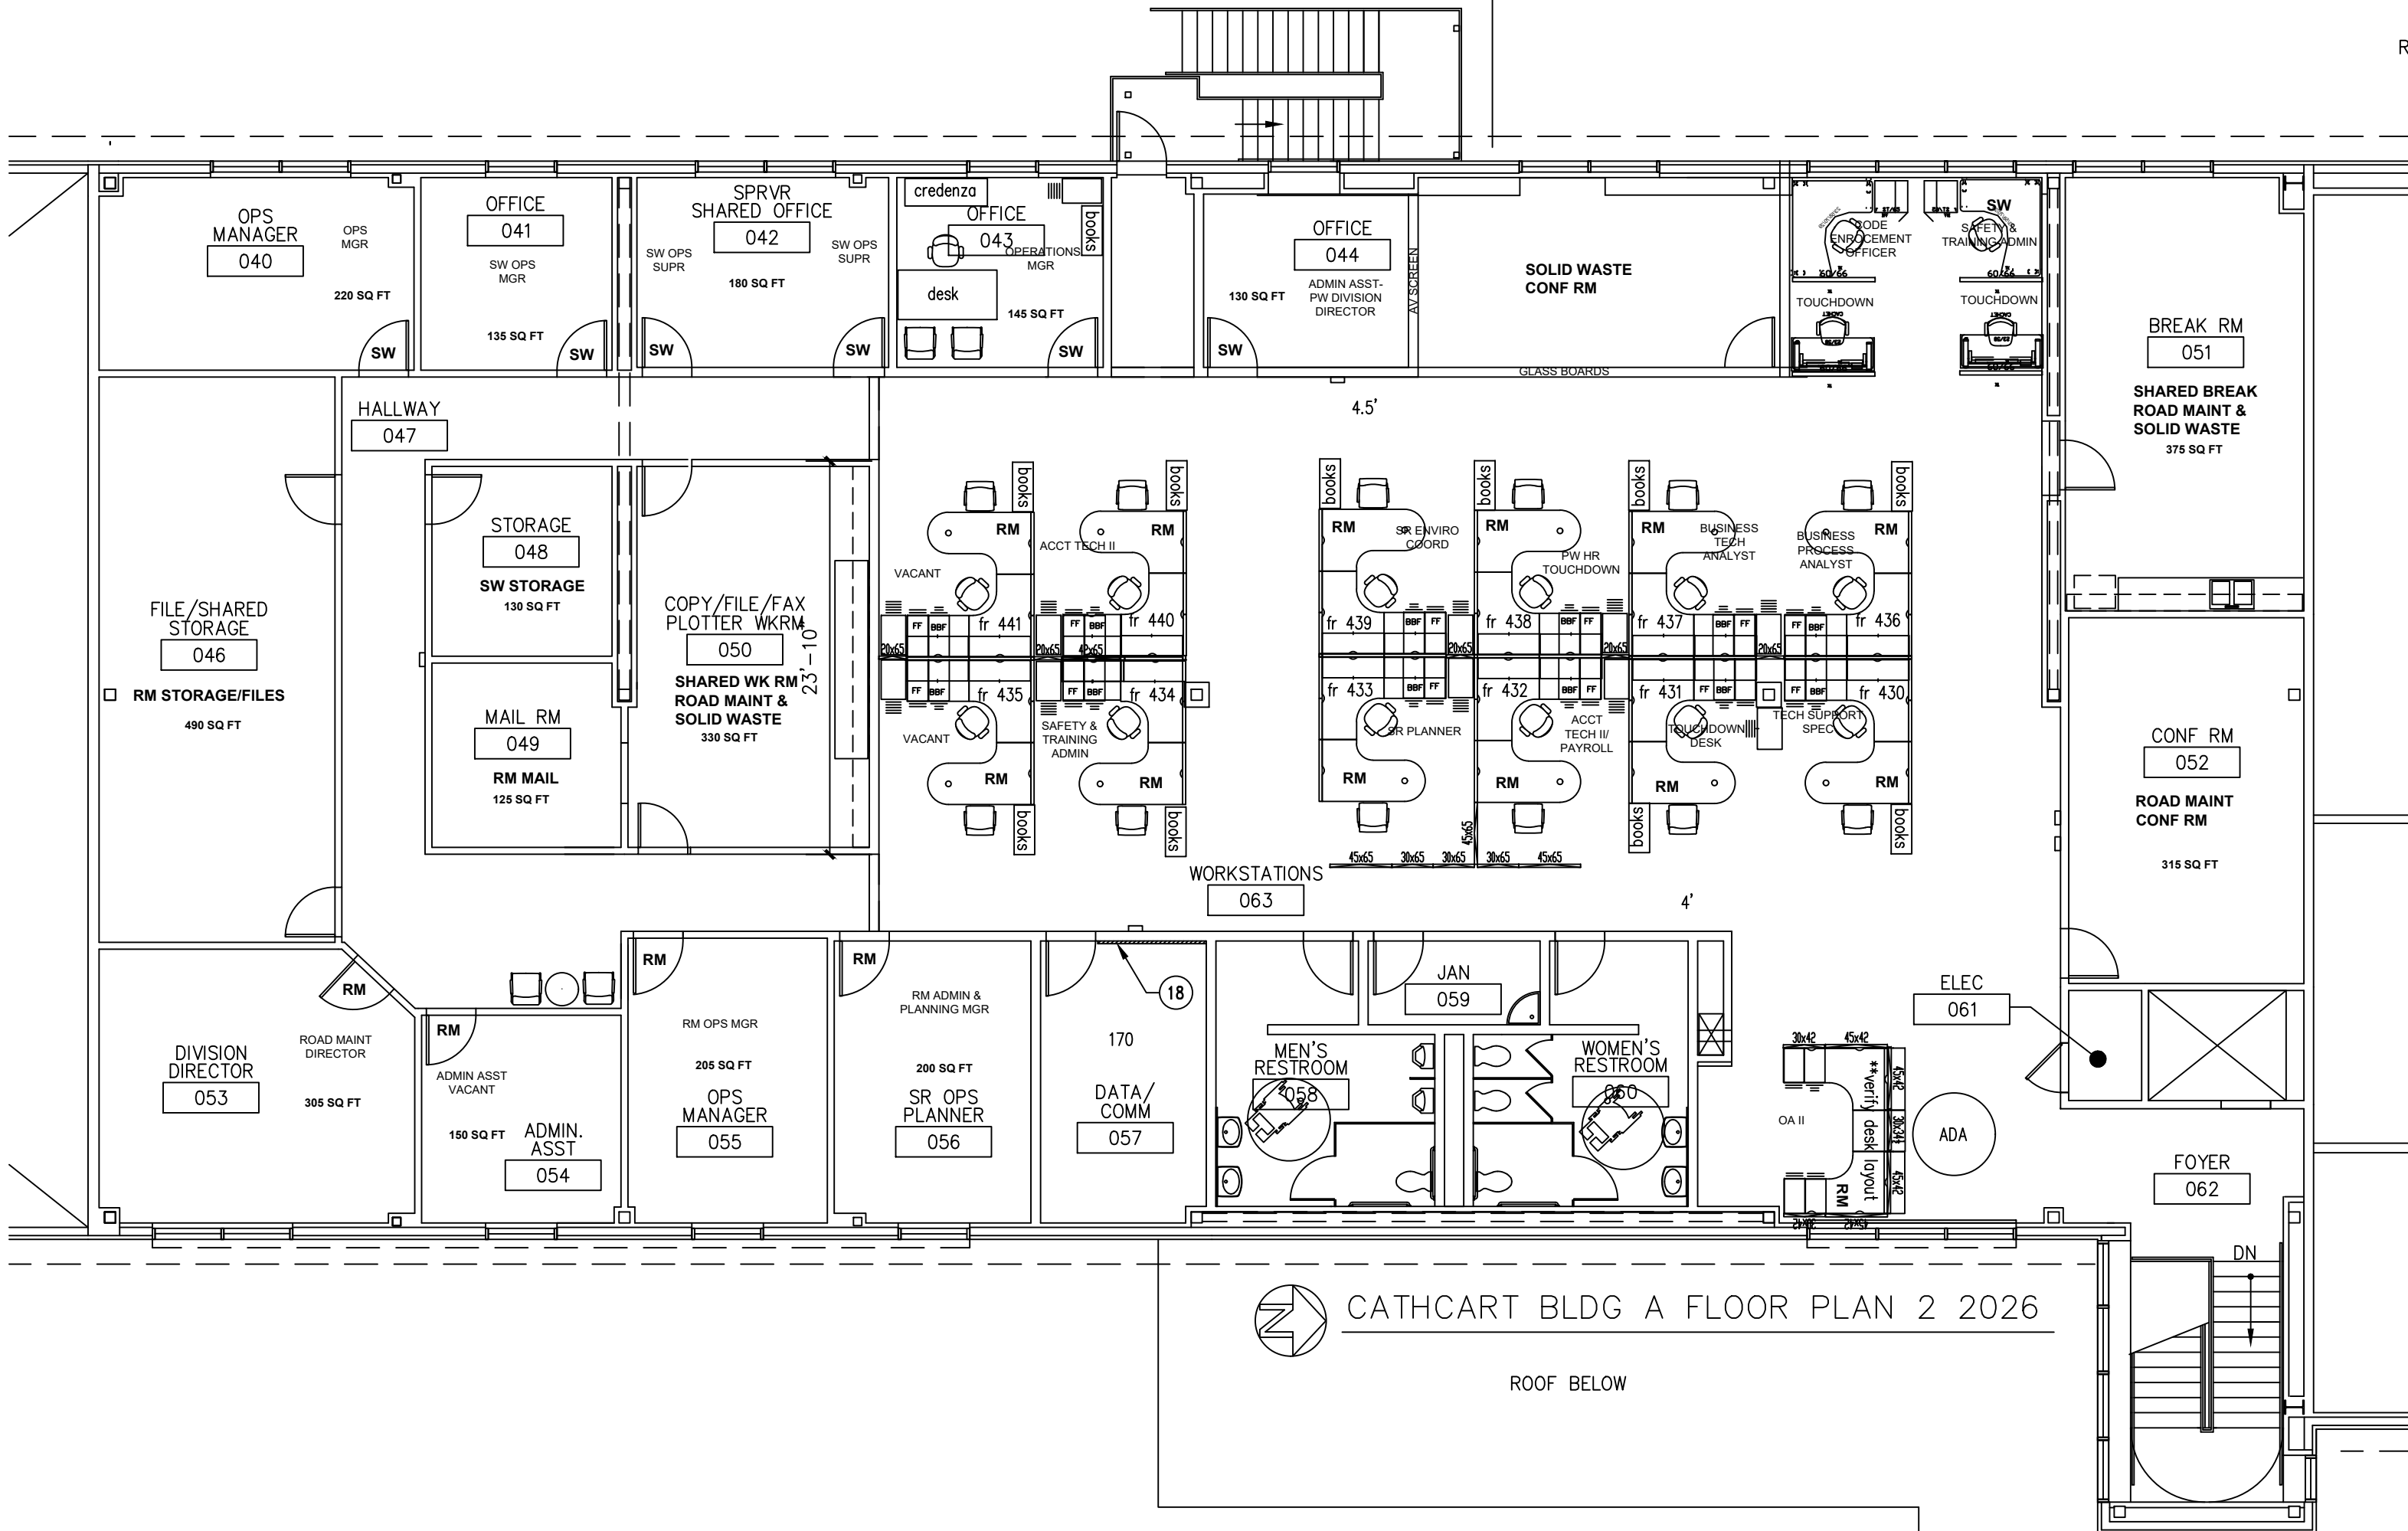


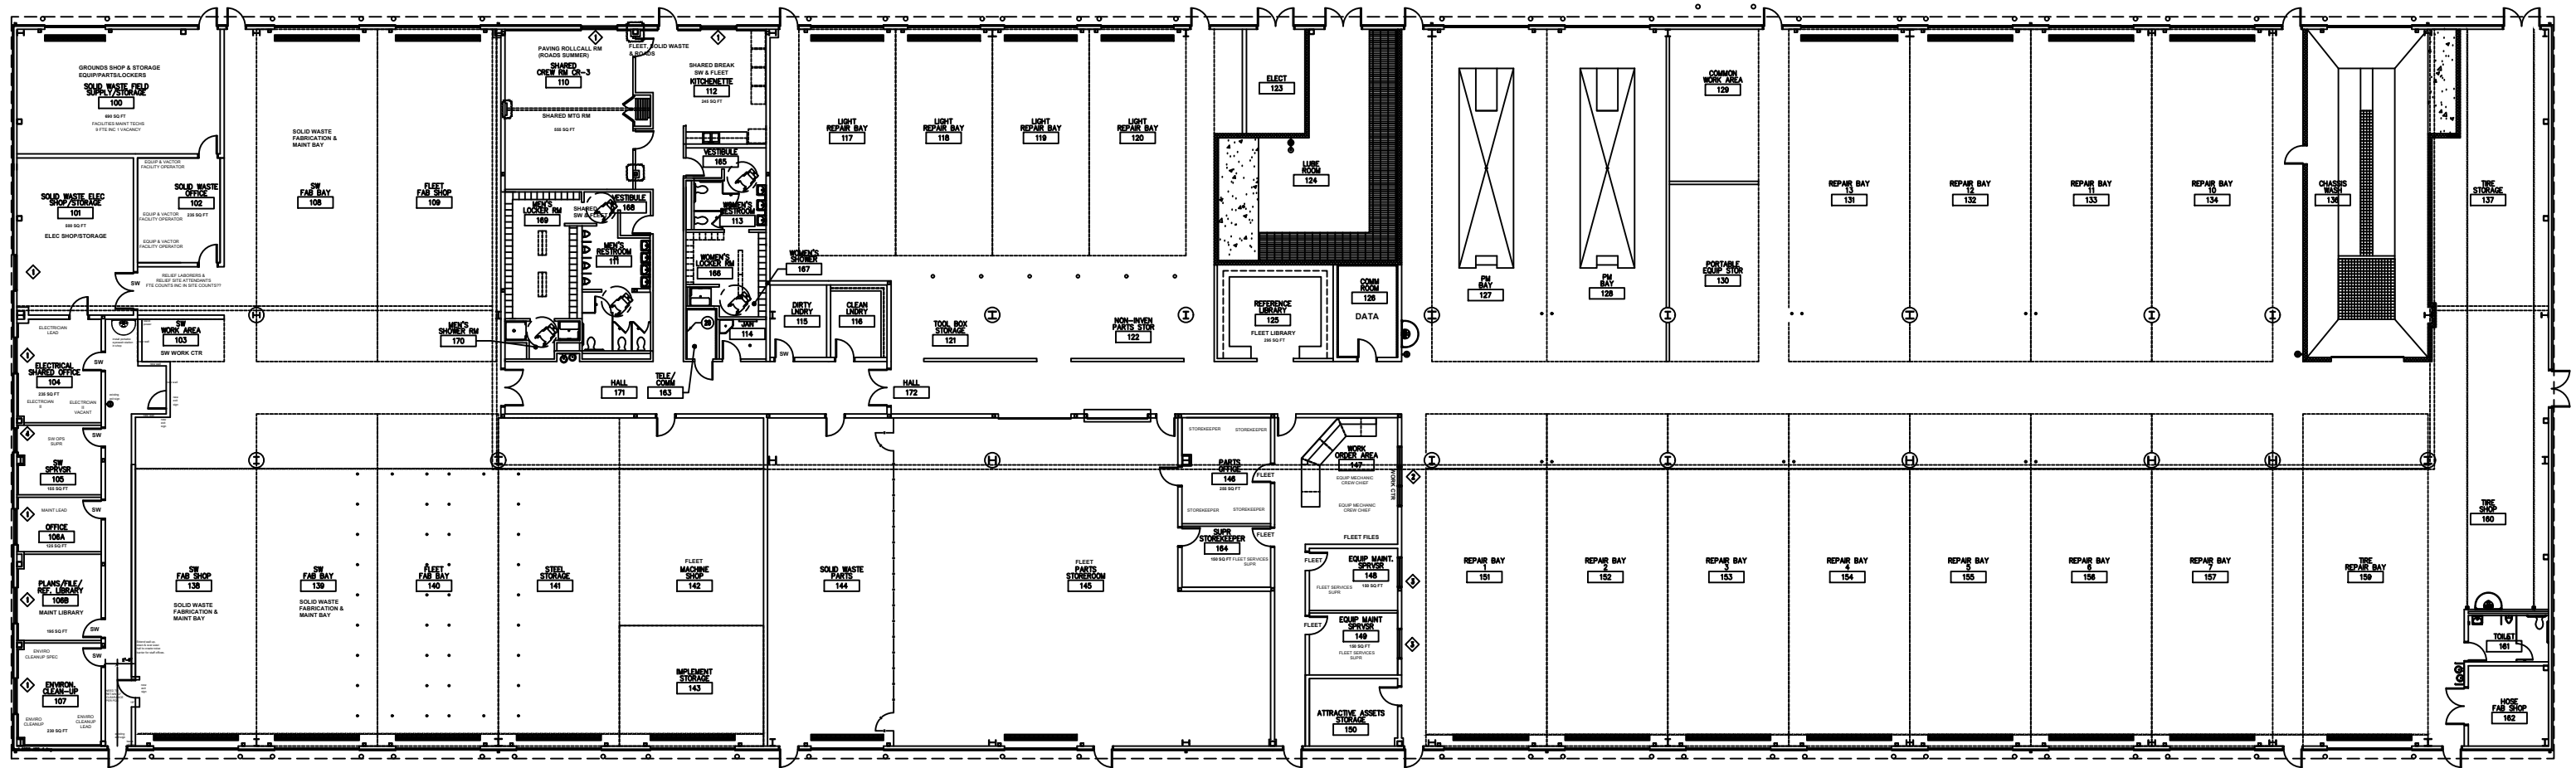

CATHCART BLDG B FLOOR PLAN 2026



CATHCART BLDG B FLOOR PLAN 2026

ENVIRO MONITORING SUPR, SALIH
HYDRO-GEOLOGIST, EYTCHESON
SCADA SYSTEMS ADMIN, DOTSON
ENVIRO SPEC SR, LAWLESS
ENVIRO SPEC IV, ARNOLD
ENVIRO SPEC I, BLOCK

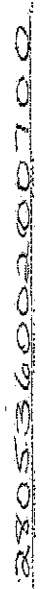


CATHCART SOLID WASTE BUILDING M

2026

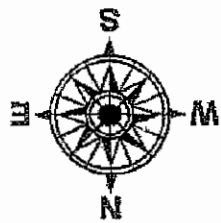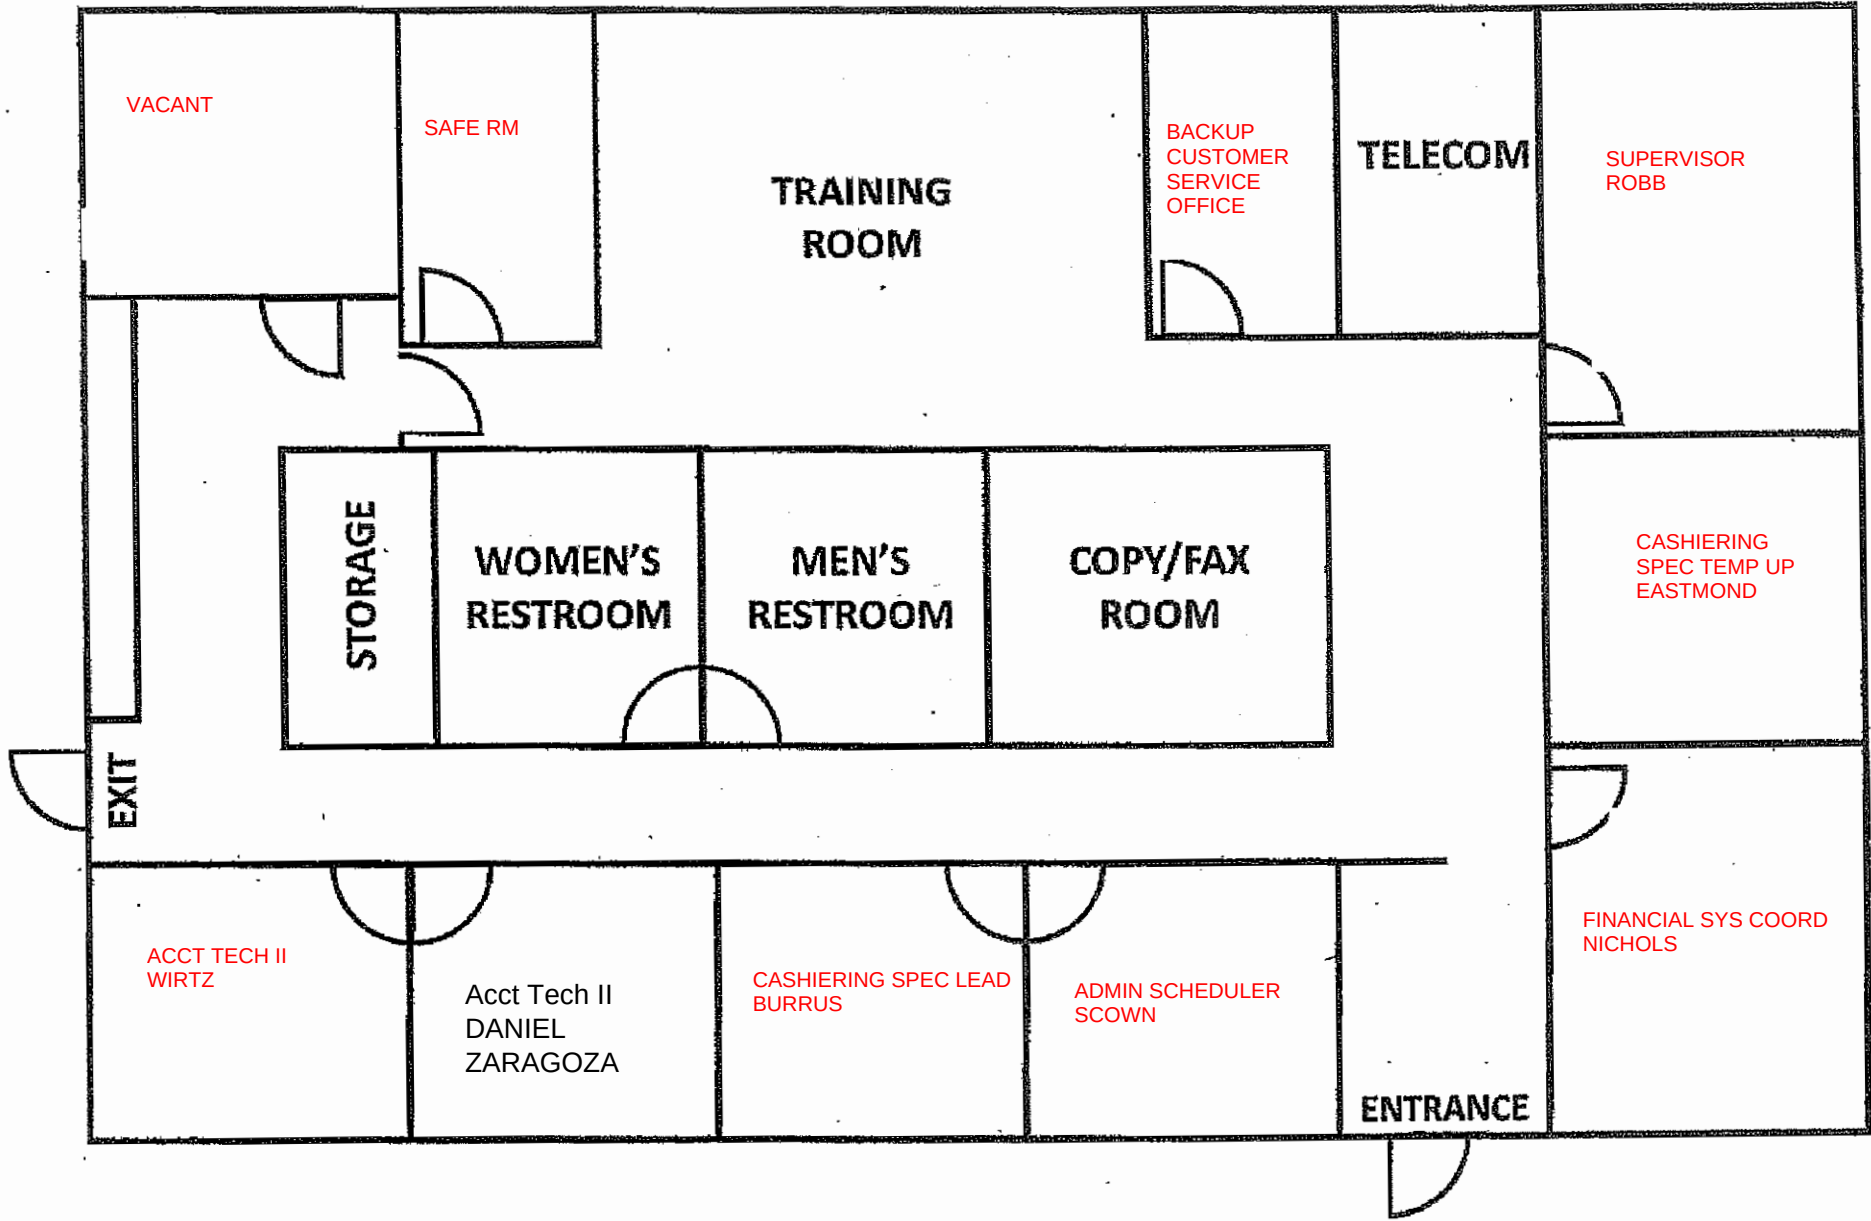

CATHCART SITE CATHCART WAY RECYCLING AND TRANSFER STATION

PROJECT No. SDC 5012

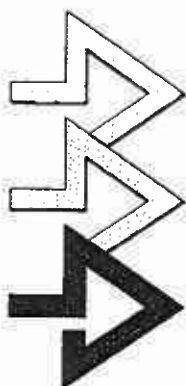

CATHCART WAY RECYCLING &
TRANSFER STATION:
SUPR, MILLER
OPERATOR, ASPLUND
LABORERS, 3 FTE
SITE ATTENDANTS, 1 FTE
2026

SNOHOMISH COUNTY PUBLIC WORKS SOLID WASTE MANAGEMENT DIVISION

SNOHOMISH COUNTY OFFICIALS

DIRECTOR OF PUBLIC WORKS

Peter E. Hahn

COUNTY ENGINEER

Loren J. Sand, P.E.

EXECUTIVE

Robert J. Drewel

COUNCIL MEMBERS

Rick Larsen - DIST. 1

Kirke Seivers - DIST. 2

Gary Nelson - DIST. 3


Barbara Cothorn - DIST. 4

Dave Somers - DIST. 5

OCTOBER 1999



CALL 48 HOURS
BEFORE YOU DIG
1-800-424-5555

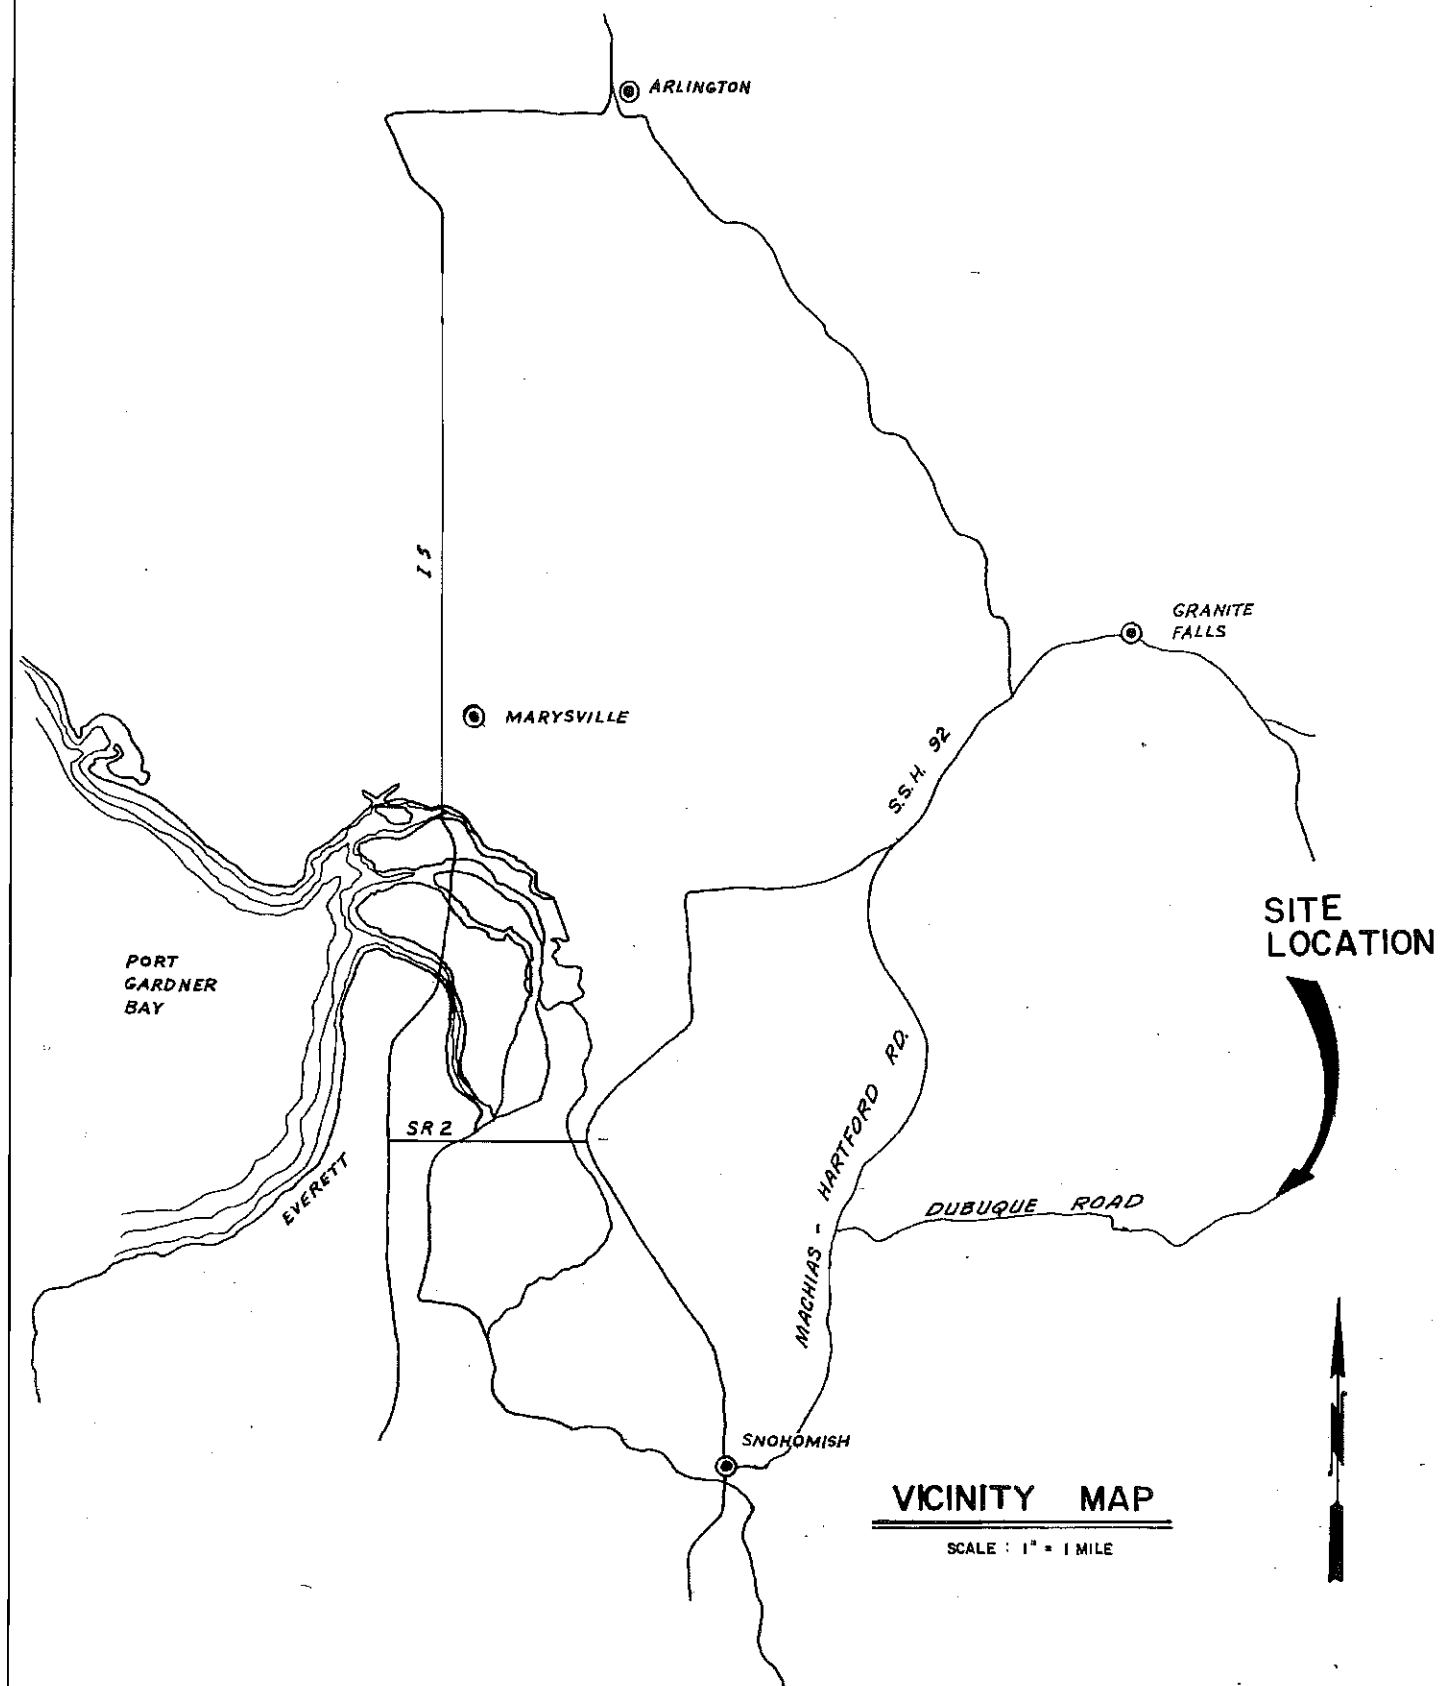

LAKE ROESIGER

DROP BOX

TRANSFER STATION

DUBUQUE DROP BOX:
SUPR, HANSEN
SITE ATTENDANTS, 3 FTE
2026

DEPARTMENT OF PUBLIC WORKS SOLID WASTE DIVISION

 
R. G. HANSEN
DIRECTOR, SOLID WASTE DIVISION

HARRY D. MARTIN, P.E.
DIRECTOR, DEPARTMENT OF PUBLIC WORKS

CHARLES HILL
CHAIRMAN, BOARD OF COUNTY COMMISSIONERS

C. EARL TORGESON
COMMISSIONER, DISTRICT 1


N. RICHARD FORSGREN
COMMISSIONER, DISTRICT 2




- DESCRIPTION OF WORK**

THE WORK CONTAINED HEREIN CONSISTS OF, BUT MAY NOT BE LIMITED TO, THE RELOCATION OF AN EXISTING STRUCTURE AND THE CONSTRUCTION OF A NEW STRUCTURE AT SIX SITES IN SNOHOMISH COUNTY. THE NEW STRUCTURE IS A 10'-0" BY 12'-0" WOOD FRAME BUILDING WITH A STANDING SEAM METAL ROOF, T1-11 SIDING, AND A PRECAST CONCRETE PIER FOUNDATION.

 INTERIOR SPACES INCLUDE A TOILET AREA WITH A DAY CHEMICAL TOILET AND AN EXTERNALLY PUMPED HONGING TANK, AN EXTERIALLY-ACCESSED STORAGE AREA, AND THE MAIN OFFICE/WORK AREA. THE SPACE IS HEATED BY ELECTRIC BASEBOARD HEAT, CONTROLLED BY A WALL-MOUNTED THERMOSTAT. CASEWORK INCLUDES A SMALL STORAGE SHELF AND A SPLIT-HIGHT WORK SURFACE WITH A THREE-DRAWER END UNIT. THE SPACE IS INSULATED BY R-30 BATT INSULATION ABOVE THE CEILING, R-11 BATT IN THE WALLS, AND R-19 BATT IN THE FLOOR.



20 0 20
SCALE IN FEET

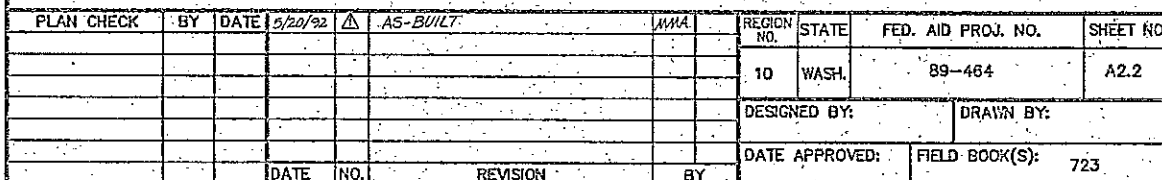

David E. Alach
SNOHOMISH COUNTY ENGINEER

SNOHOMISH COUNTY
DEPARTMENT OF
PUBLIC WORKS

PROJECT NO. 89-464

AS-BUILT
SNOHOMISH COUNTY
SOLID WASTE DROP BOX SITES
LAKE ROESSIGER, WASHINGTON
SITE PLAN AND TOPOGRAPHY

SURVEY NO. 3221
SHEET A23 OF 12 SHEETS

filmed 8/5/91

SNOHOMISH COUNTY, WASHINGTON
DEPARTMENT OF PUBLIC WORKS

ADDITIONS TO
SOLID WASTE DROP BOX FACILITIES
EMPLOYEE BUILDINGS

CRP-89-464

SNOHOMISH COUNTY OFFICIALS

DIRECTOR OF PUBLIC WORKS

GERALD E. WEED, P.E.

EXECUTIVE

WILLIS TUCKER

COUNCIL MEMBERS

ROSS KANE
ELIZABETH McLAUGHLIN
BILL BRUBAKER
BRIAN CORCORAN
PETER HURLEY


GOLD BAR
LAKE ROESIGER
OSO

GRANITE FALLS
MONROE
SULTAN

PLAN CHECK	BY	DATE				REGION NO.	STATE	FED. AID PROJ. NO.	SHEET NO.	 <i>Gerald E. Weed</i> SNOHOMISH COUNTY ENGINEER	SNOHOMISH COUNTY DEPARTMENT OF PUBLIC WORKS PROJECT NO. 89-464	AS-BUILT	SURVEY NO.	
						10	WASH.							
						DESIGNED BY:		DRAWN BY:						
						DATE APPROVED:		FIELD BOOK(S):						
			DATE	NO.	REVISION	BY							SHEET 11.1 OF 12 SHEETS	

42-13 8/5/91

DROP BOXES

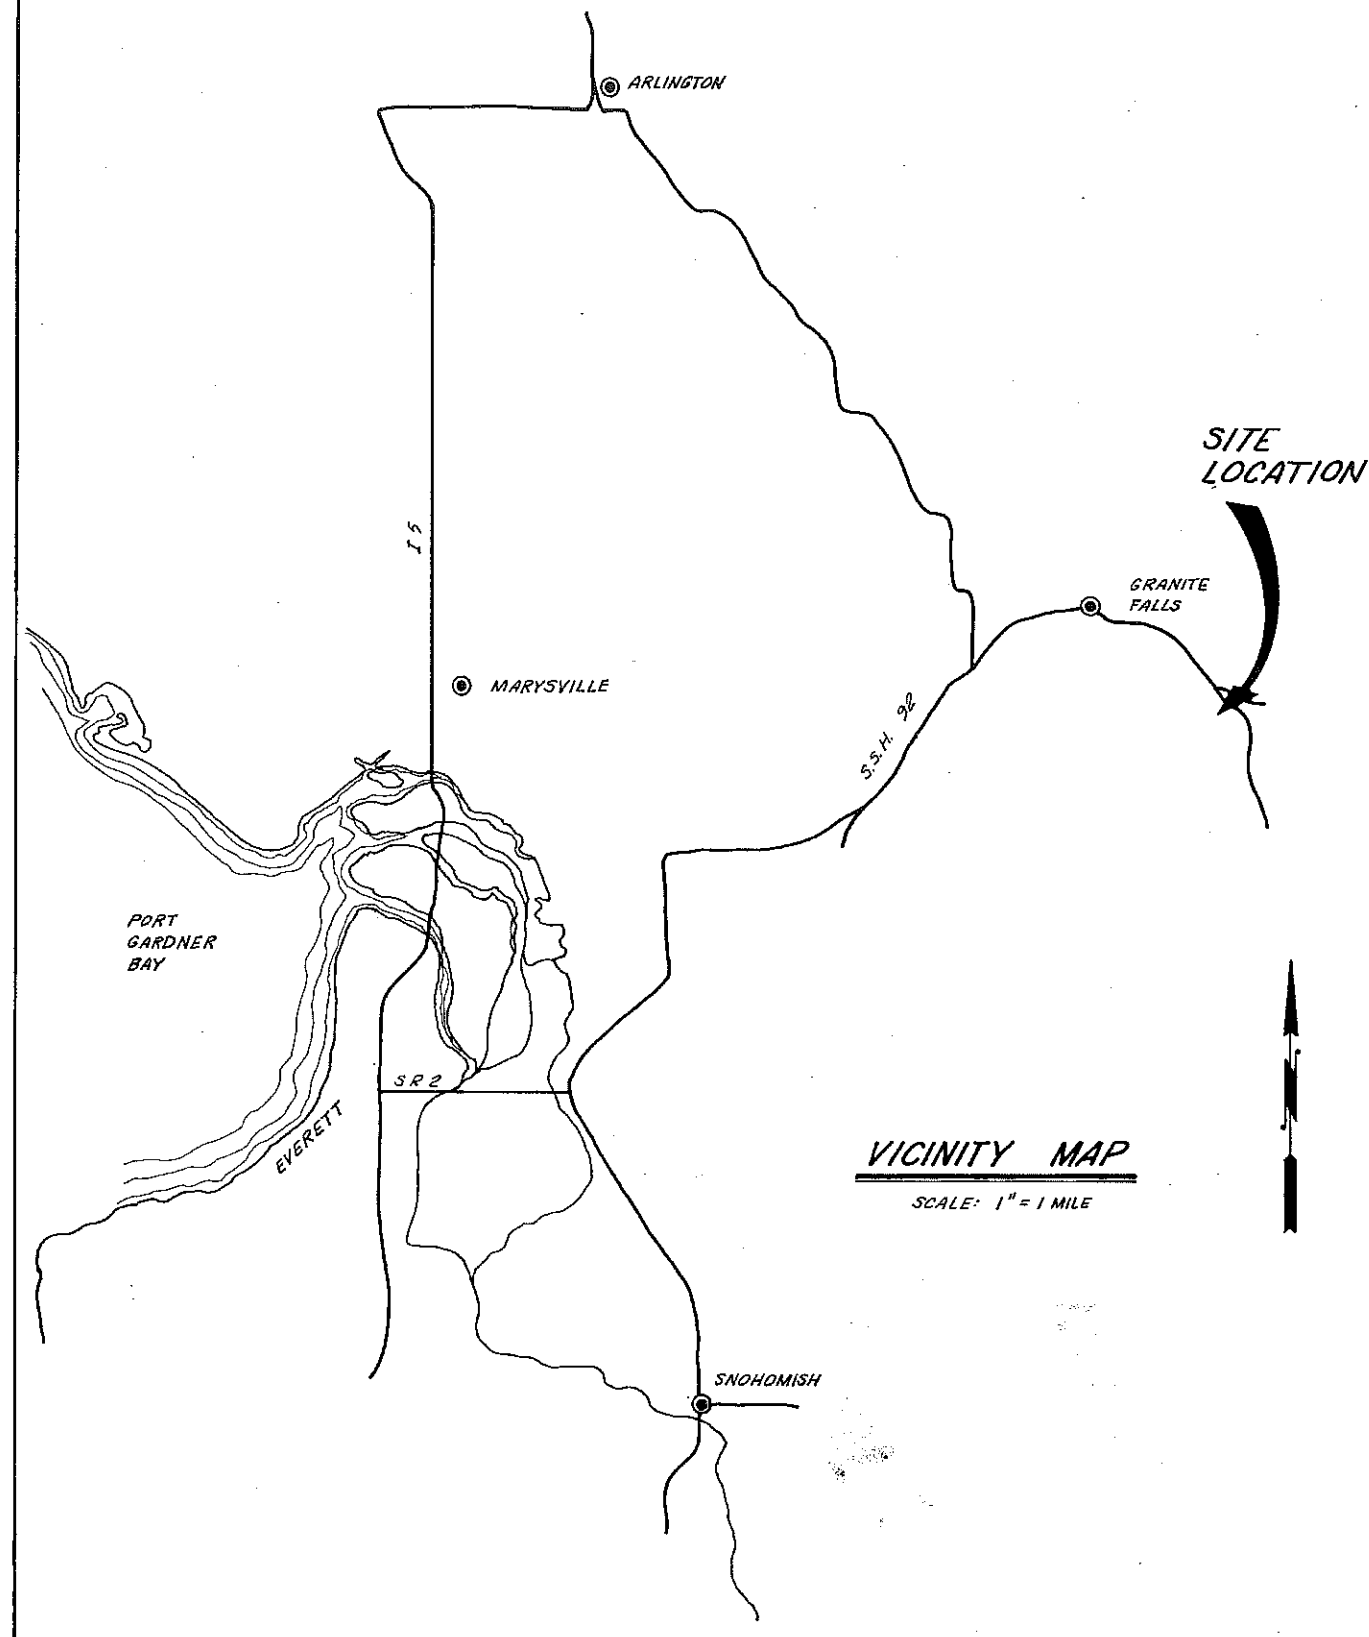

GRANITE FALLS DROP BOX TRANSFER STATION

GRANITE FALLS DROP BOX:
SUPR, HANSEN
SITE ATTENDANTS, 2 FTE
2026

DEPARTMENT OF PUBLIC WORKS
SOLID WASTE DIVISION

R. G. HANSEN
DIRECTOR, SOLID WASTE DIVISION

HARRY D. MARTIN, P.E.
DIRECTOR, DEPARTMENT OF PUBLIC WORKS

CHARLES HILL
CHAIRMAN, BOARD OF COUNTY COMMISSIONERS

C. EARL TORGESON
COMMISSIONER, DISTRICT 1



N. RICHARD FORSGREN
COMMISSIONER, DISTRICT 2



1. THE CONTRACTOR SHALL COORDINATE ALL WORK WITH THE APPROPRIATE CITY OR COUNTY OFFICIALS PRIOR TO THE START OF ANY DEMOLITION OR CONSTRUCTION. THIS IS AN OPERATING FACILITY WHICH WILL REMAIN IN OPERATION DURING THE TERM OF THIS CONTRACT. WHERE THE FACILITY OPERATIONS CONFLICT WITH THOSE OF THE CONTRACTOR, THE FACILITY OPERATIONS WILL TAKE PRECEDENCE OVER THOSE OF THE CONTRACTOR. IT SHALL BE THE SOLE RESPONSIBILITY OF THE CONTRACTOR TO SCHEDULE AND COORDINATE HIS ACTIVITIES WITH THOSE OF THE FACILITY TO ASSURE MINIMUM DISRUPTION TO THE FACILITY OPERATIONS.
2. THE CONTRACTOR SHALL COORDINATE AND ARRANGE WITH THE PROPER UTILITY COMPANIES FOR THE DISCONNECTION AND RECONNECTION OF ALL POWER AND TELEPHONE LINES. THIS IS TO HAPPEN PRIOR TO THE RELOCATION OF THE EXISTING FACILITIES AND AT THE TIME OF SWITCHING TO THE NEW FACILITIES.
3. THE CONTRACTOR IS TO RELOCATE THE EXISTING FACILITY AS SHOWN ON THE PLANS IN TACT WITH THE TOILET HOLDING TANK. THE CONTRACTOR SHALL MAINTAIN THE CORRECT OPERATION OF ALL UTILITIES AFTER THE RELOCATION OF THE FACILITY.
4. THE CONTRACTOR SHALL EXCAVATE THAT LOCATION OF THE NEW BUILDING FOR THE PLACEMENT OF THE PRECAST CONCRETE PIERS. THE PRECAST PIERS ARE TO BE PLACED ON UNDISTURBED SOIL OR STRUCTURAL FILL COMPACTED TO 95% DENSITY. BACKFILL AROUND THE PIERS WITH STRUCTURAL FILL AND COMPACT TO 95%.
5. THE CONTRACTOR IS TO CONSTRUCT THE NEW ATTENDANT BUILDING PER THE DRAWINGS AS SHOWN ON SHEETS A3.1 AND A3.2 AND IN ACCORDANCE WITH THE SPECIFICATIONS AS SHOWN ON SHEETS A4.1 AND A4.2.

THE WORK CONTAINED HEREIN CONSISTS OF, BUT MAY NOT BE LIMITED TO, THE RELOCATION OF AN EXISTING STRUCTURE AND THE CONSTRUCTION OF A NEW STRUCTURE AT SIX SITES IN SHOHOHISH COUNTY. THE NEW STRUCTURE IS A 10'-0" BY 12'-0" WOOD FRAME BUILDING WITH A STANDING SEAM METAL ROOF, T1-11 SIDING, AND A PRECAST CONCRETE PIER FOUNDATION.

INTERIOR SPACE INCLUDES A TOILET AREA WITH A DRY CHEMICAL TOILET AND AN EXTERNALLY PUMPED HOLDING TANK, AN EXTERNALLY ACCESSIBLE STORAGE AREA, AND THE MAIN OFFICE/WORK AREA. THE SPACE IS HEATED BY ELECTRIC BASEBOARD HEAT, CONTROLLED BY A WALL-MOUNTED THERMOSTAT. CASEWORK INCLUDES A SMALL STORAGE SHELF AND A SPLIT-HEIGHT WORK SURFACE WITH A THREE-DRAWER END UNIT. THE SPACE IS INSULATED BY R-30 BATT INSULATION ABOVE THE CEILING, R-11 BATT IN THE WALLS, AND R-19 BATT IN THE FLOOR.

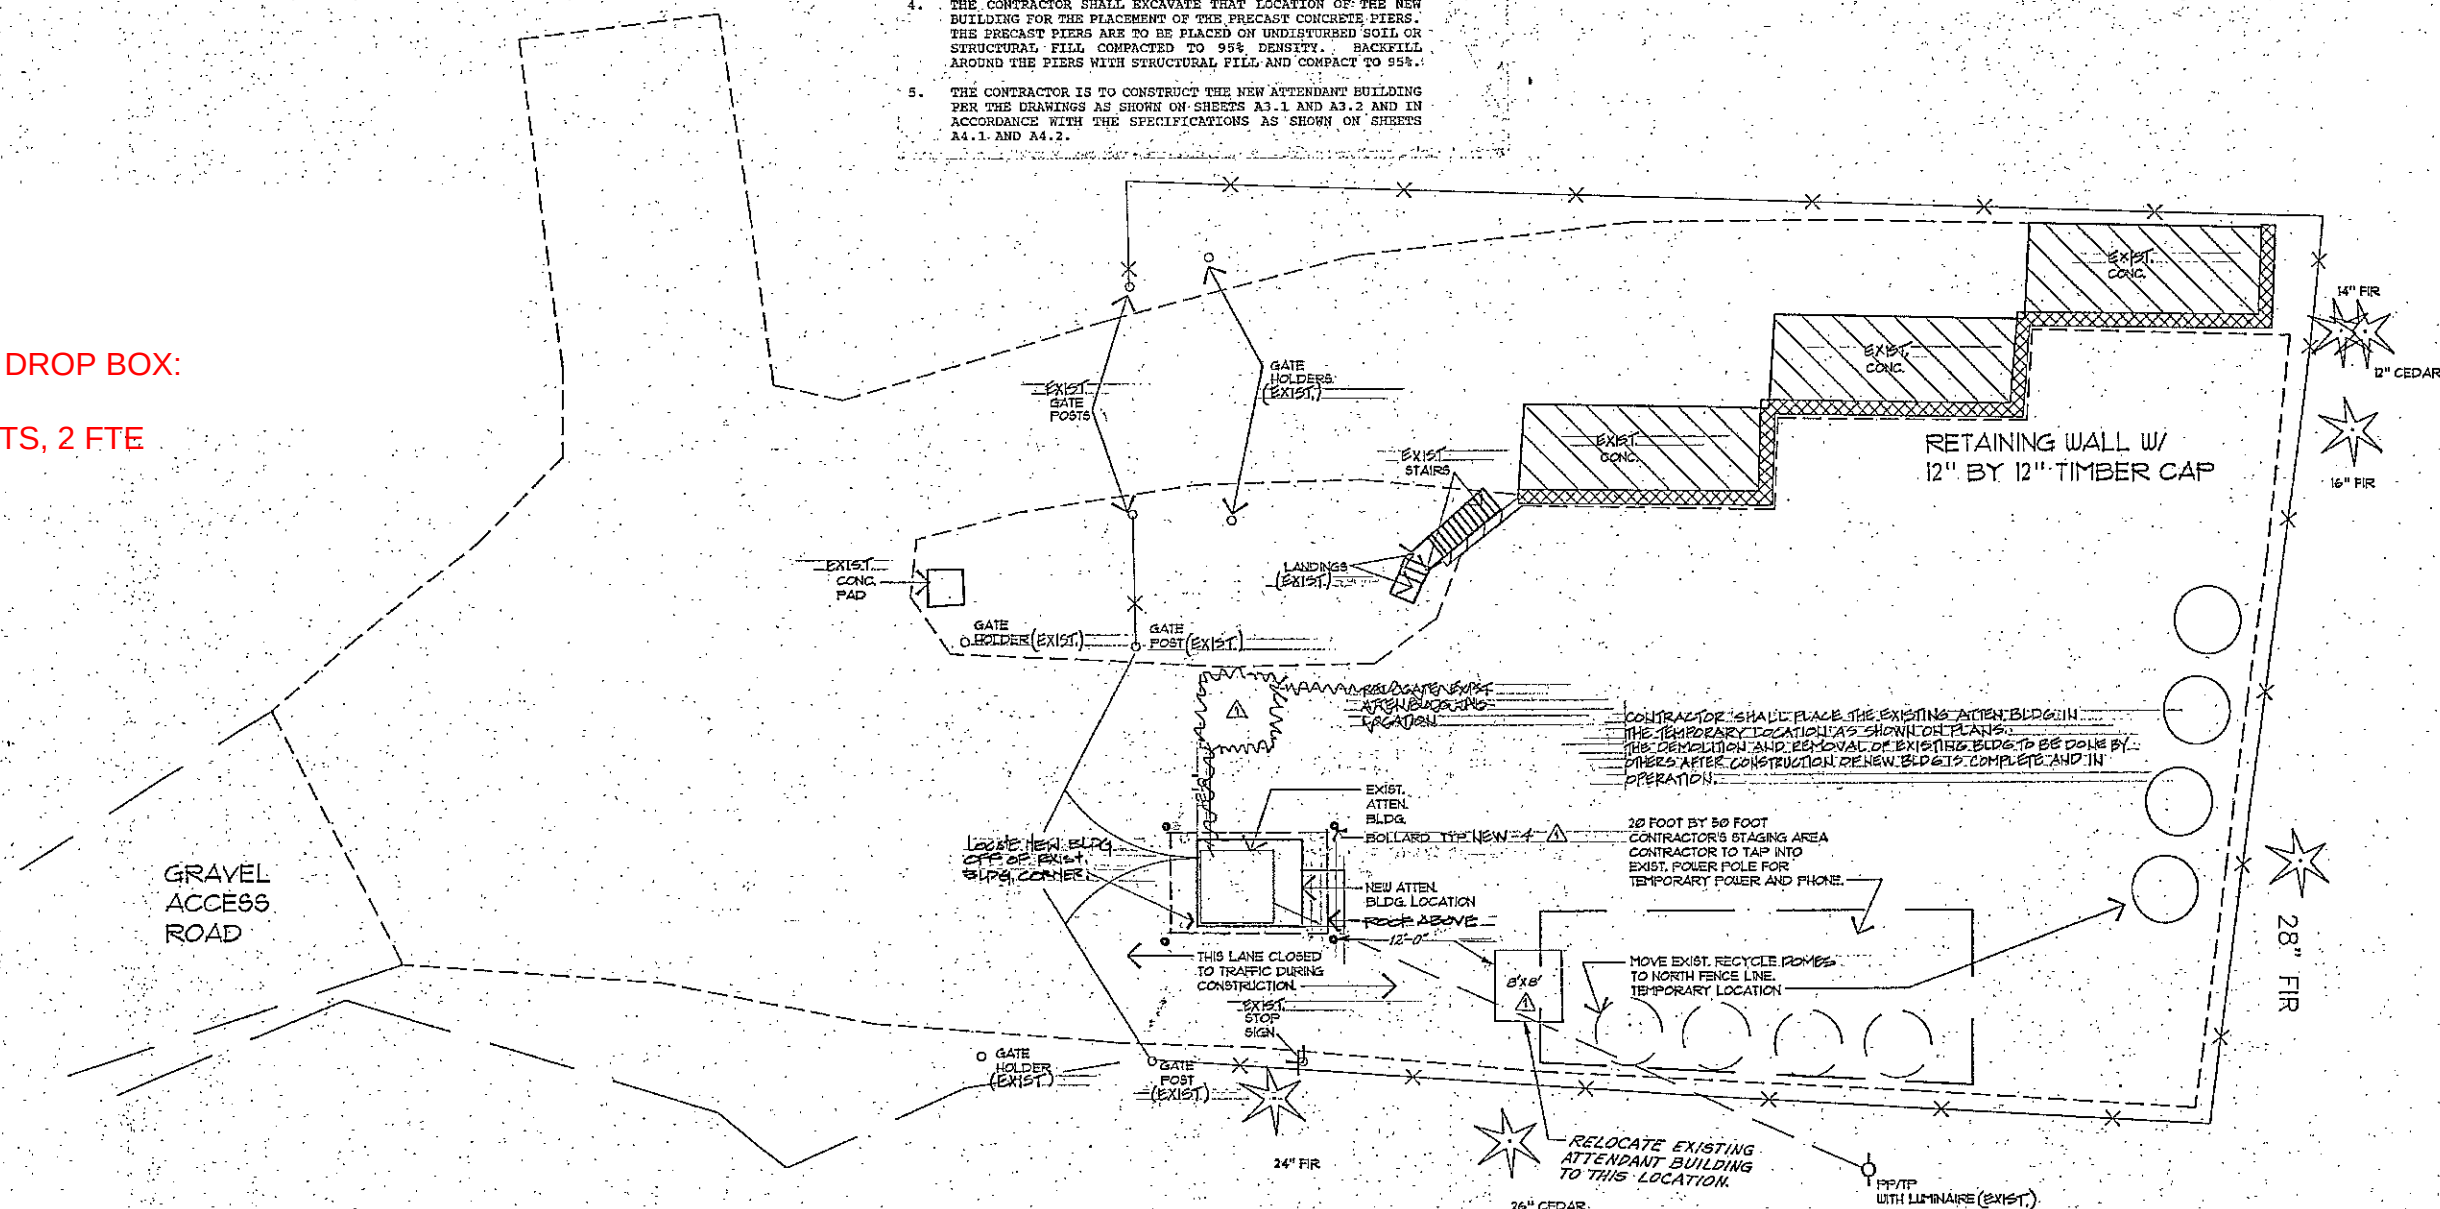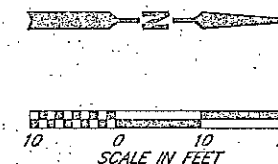

PLAN CHECK	BY	DATE	5/22/92	AS-BUILT	MMA	REGION NO.	STATE	FED. AID PROJ. NO.	SHEET NO.
						10.	WASH.	69-464	A2.2
						DESIGNED BY:		DRAWN BY:	
						DATE APPROVED:		FIELD BOOK(S): 723	
			DATE	NO.	REVISION	BY			



ALPHA ENGINEERS INC
CIVIL & STRUCTURAL ENGINEERING CONSULTANTS
16040 CHRISTENSEN ROAD SEATTLE, WA 98168

David E. Allen
SNOHOMISH COUNTY ENGINEER

SNOWHOMISH COUNTY
DEPARTMENT OF
PUBLIC WORKS

PROJECT NO. 89-464

AS-BUILT
SNOHOMISH COUNTY
SOLID WASTE DROP BOX SITES
GRANITE FALLS, WASHINGTON
SITE PLANS AND TOPOGRAPHY

SURVEY
NO.
3222

SHEET
A2.2

OF
12
SHEETS

SNOHOMISH COUNTY, WASHINGTON
DEPARTMENT OF PUBLIC WORKS

ADDITIONS TO
SOLID WASTE DROP BOX FACILITIES
EMPLOYEE BUILDINGS

CRP-89-464

SNOHOMISH COUNTY OFFICIALS

DIRECTOR OF PUBLIC WORKS

GERALD E. WEED, P.E.

EXECUTIVE

WILLIS TUCKER

COUNCIL MEMBERS

ROSS KANE
ELIZABETH McLAUGHLIN
BILL BRUBAKER
BRIAN CORCORAN
PETER HURLEY

GOLD BAR
LAKE ROESIGER
OSO

GRANITE FALLS
MONROE
SULTAN

PLAN CHECK	BY	DATE				REGION NO.	STATE	FED. AID PROJ. NO.	SHEET NO.	 <i>Gerald E. Weed</i> SNOHOMISH COUNTY ENGINEER	SNOHOMISH COUNTY DEPARTMENT OF PUBLIC WORKS PROJECT NO. 89-464	AS-BUILT	SURVEY NO.
					10	WASH.							
					DESIGNED BY:	DRAWN BY:							
					DATE APPROVED:	FIELD BOOK(S):							
			DATE	NO.	REVISION	BY							SHEET 11.1 OF 12 SHEETS

8/5/91


DROP BOXES

INTERMODAL YARD:
SUPR GRUBER
TRUCK DRIVERS, 24 FTE
2026


EXHIBIT "A"
ATTACHED TO CONTRACT BETWEEN
BNSF RAILWAY COMPANY
AND
SNOHOMISH COUNTY

SCALE: 1 IN. = 200 FT.
NORTHWEST DIV.
BELLINGHAM SUBDIV. L.S. 0408
DATE 10/10/2012


SECTION: 16
TOWNSHIP: 29N
RANGE: 05E
MERIDIAN: WILLM

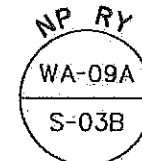


TRIM LINE

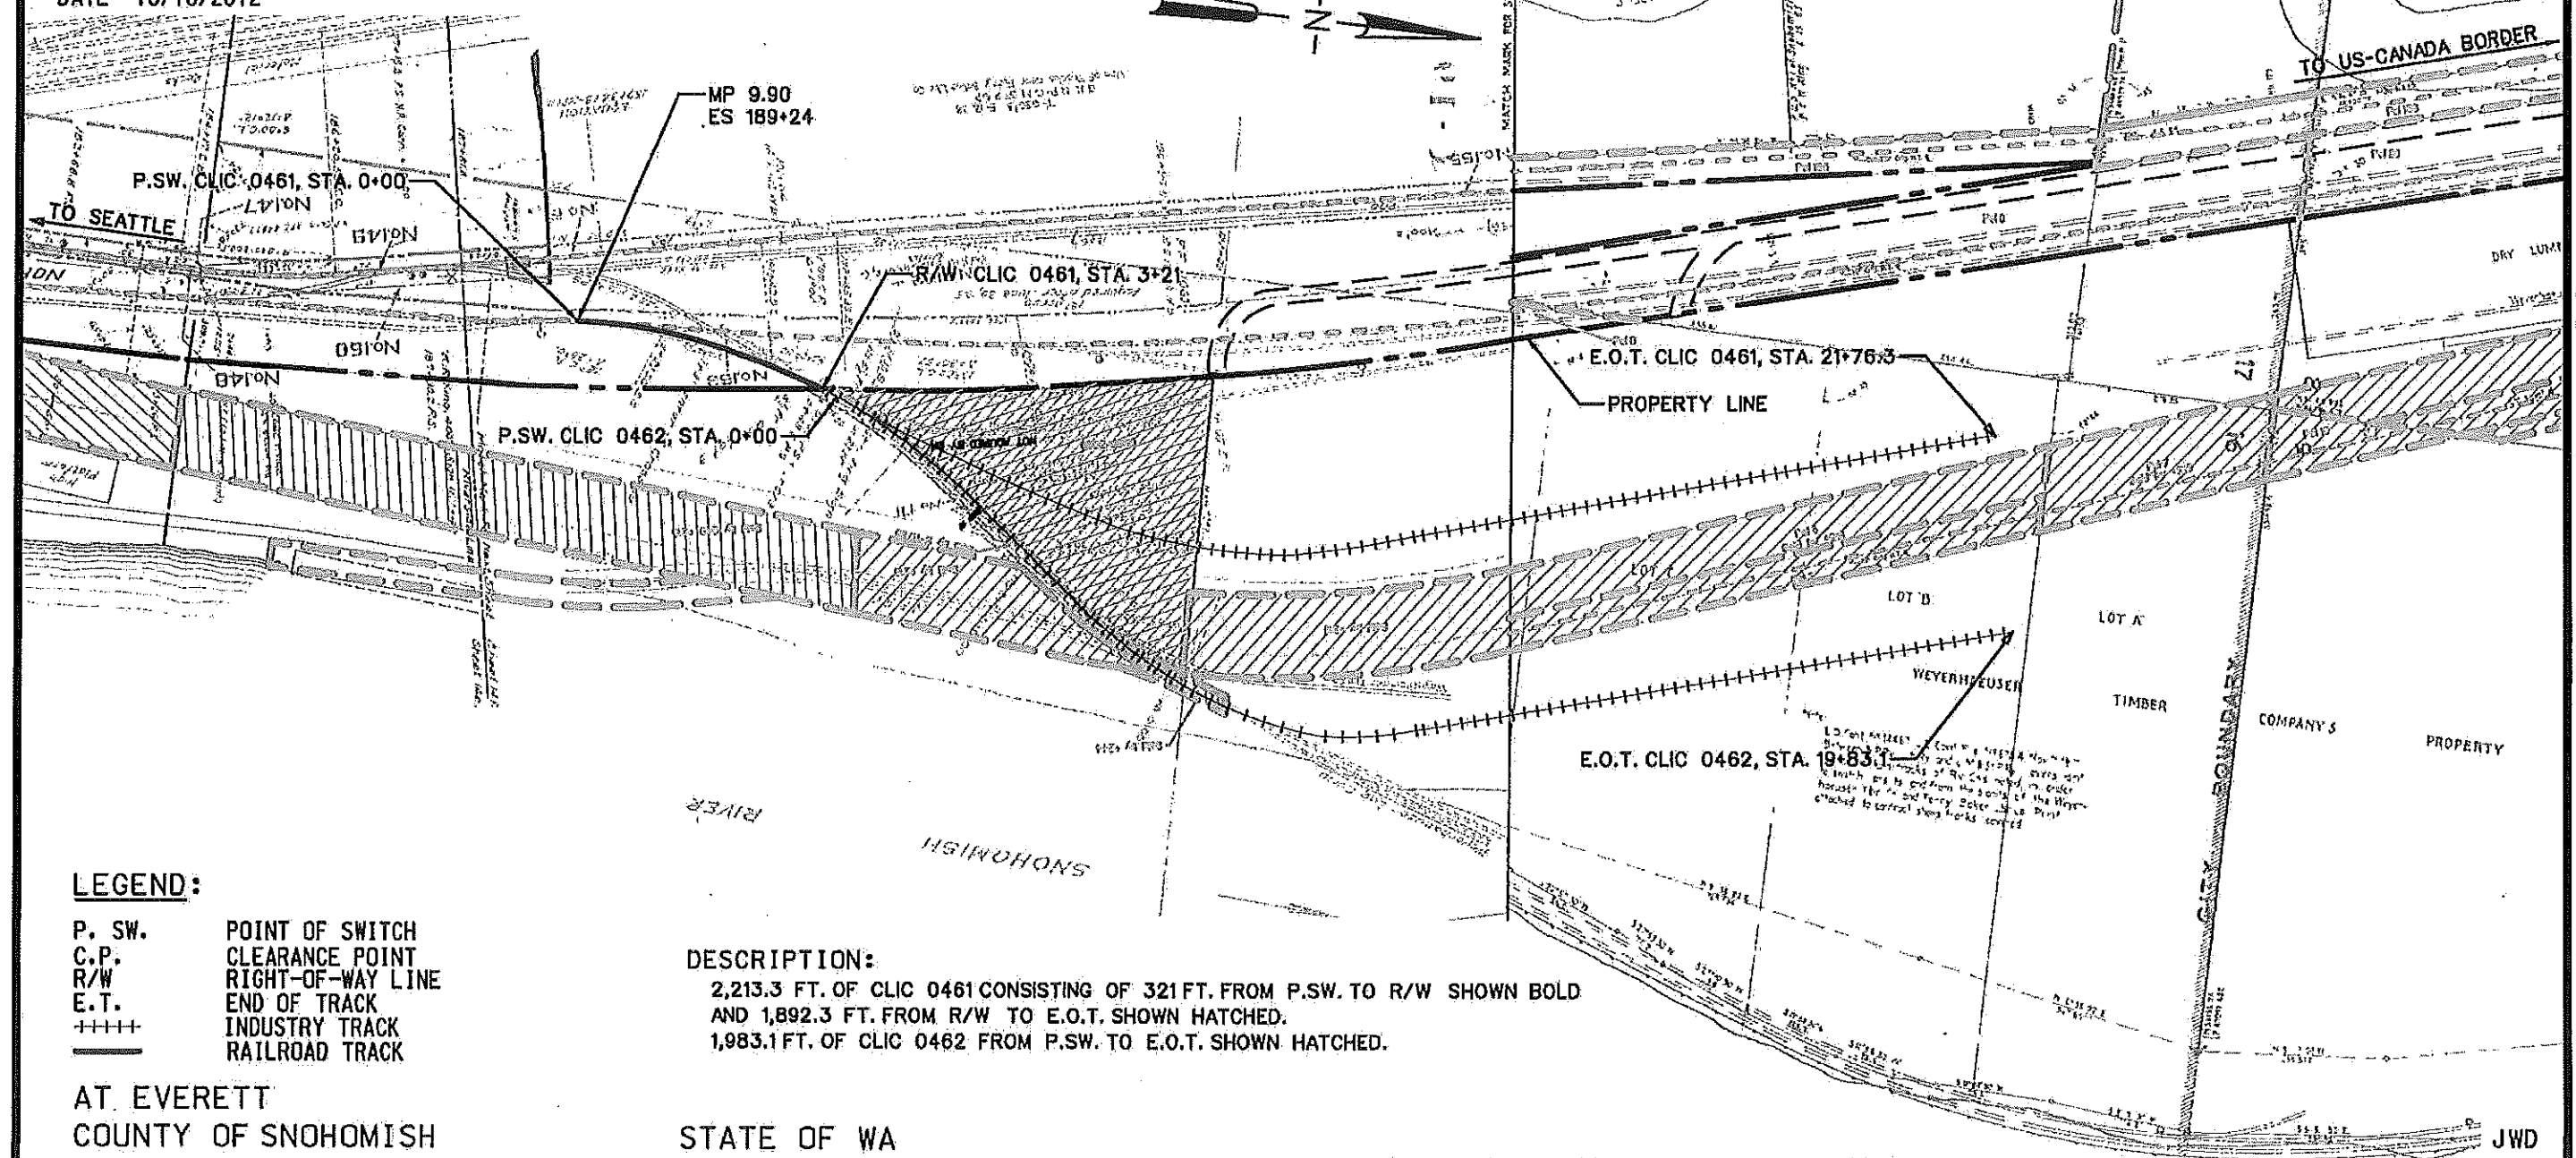

MAP REF. S52013.S52017

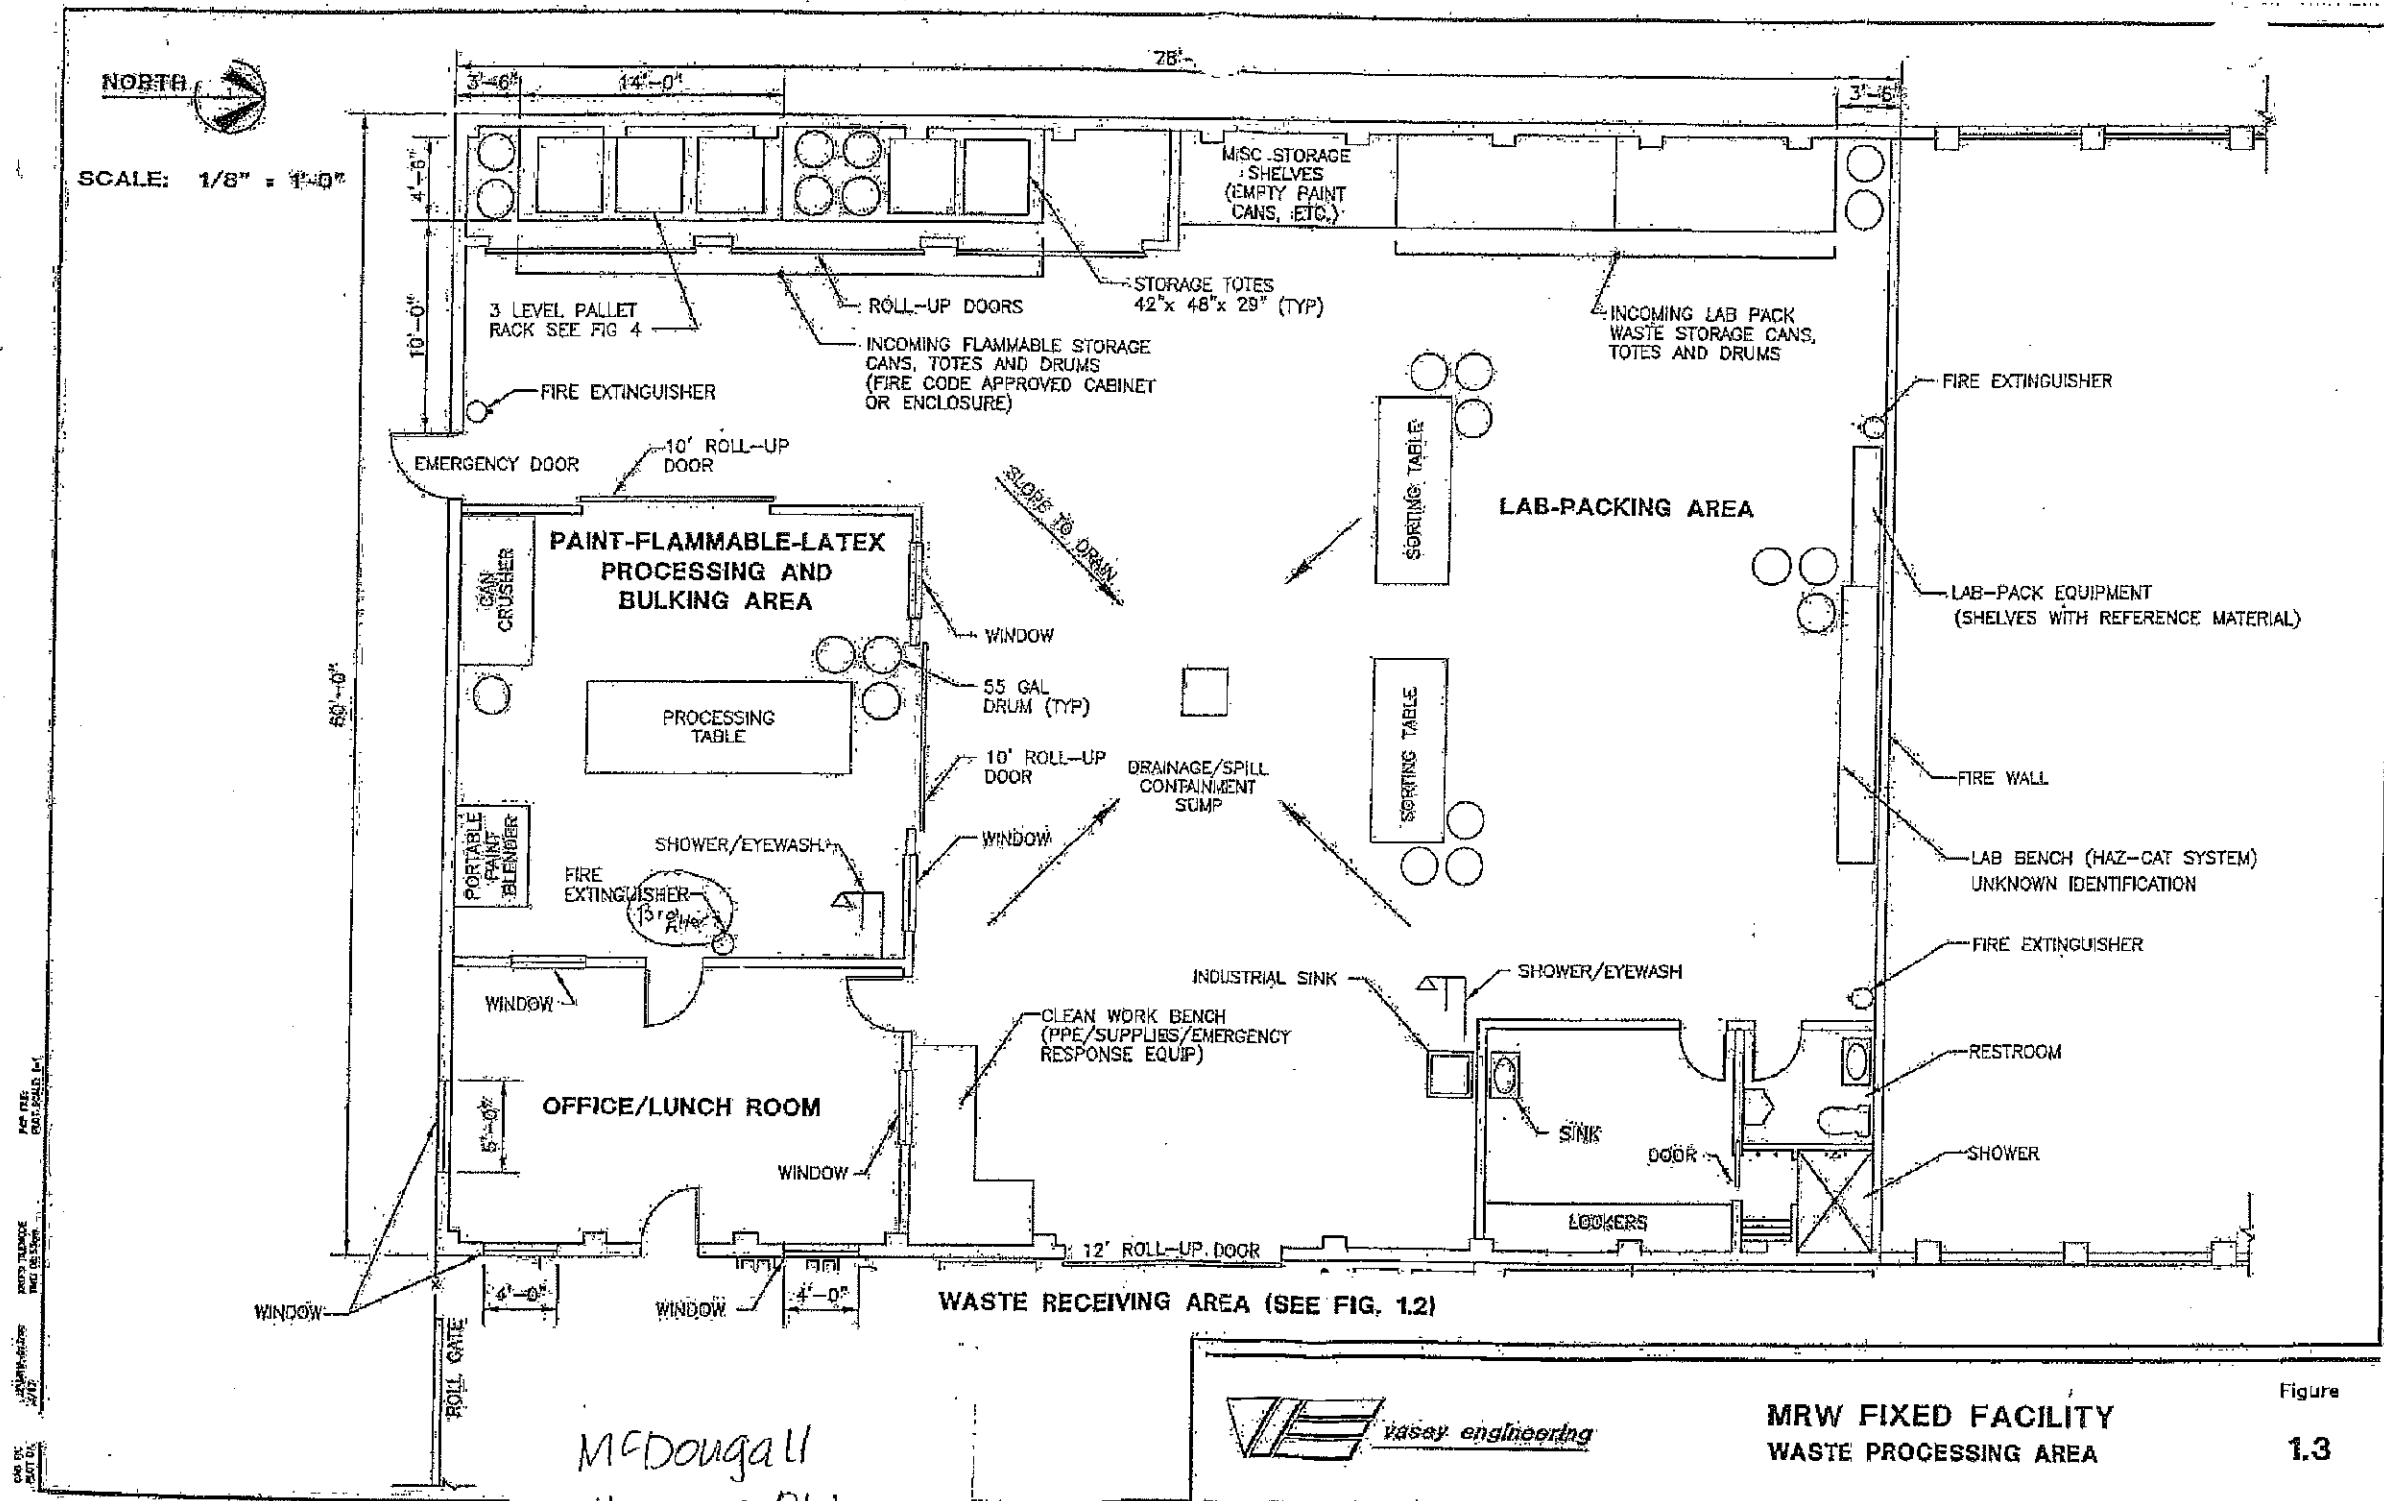

McDougal
Haz Mat Bldg.

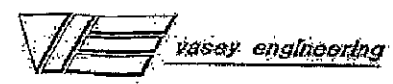

MRW FIXED FACILITY
WASTE PROCESSING AREA

Figure
1.3

HAZARDOUS WASTE/MODERATE
RISK WASTE FACILITY (HHW/MRW):
MGR GRENINGER
MRW SUPR, SWINT
MRW TECH III TEMP, JOHNSON
MRW TECH II, KAYSER
MRW TECH II, MOLITER
MRW TECH II, CARTER
2026


NORTH SNOHOMISH COUNTY SOLID WASTE RECYCLING AND TRANSFER STATION MODIFICATIONS

[illegible]

SURVEY
NO.


SHEET
G-1
OF

SHEETS

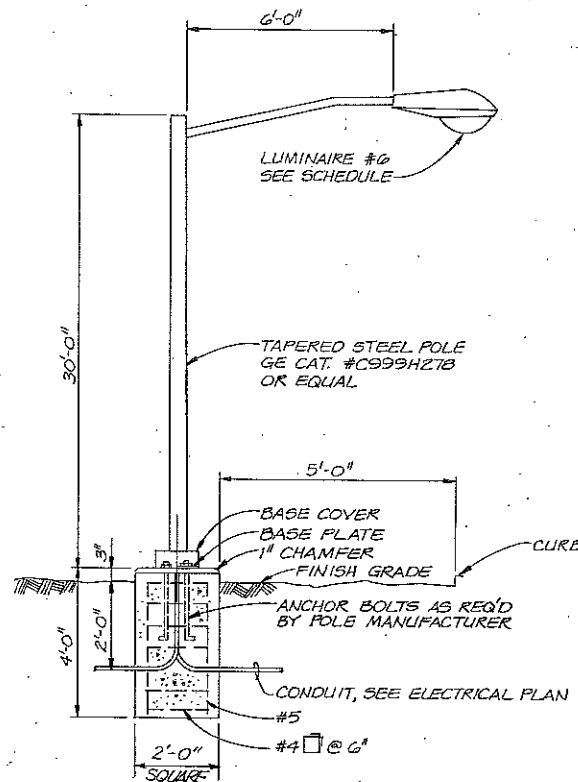

STREET LUMINAIRE POLE DETAIL (1)



NTS

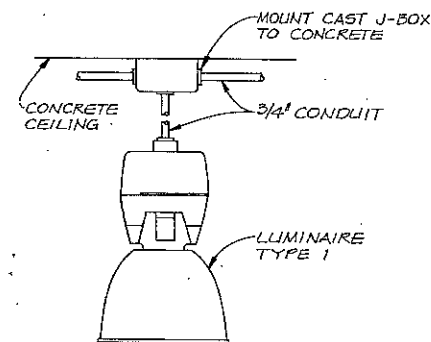


PENDANT MOUNT HID (2)

NTS


NORTH COUNTY RECYCLING & TRANSFER STATION (NCRTS):
OPERATIONS SUPR, COTE
OPERATORS, 2 FTE
LABORERS, 9 FTE
SITE ATTENDANTS, 5 FTE
2026

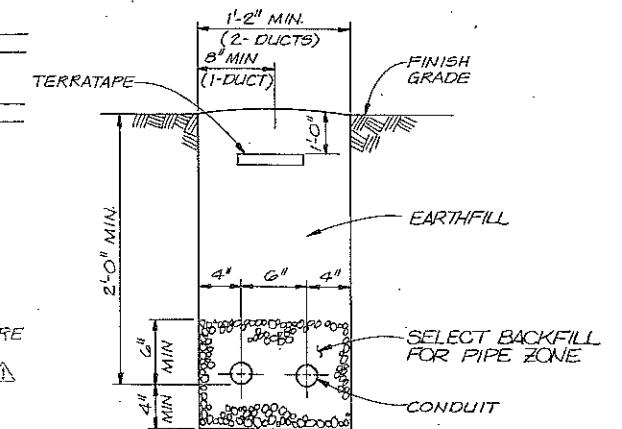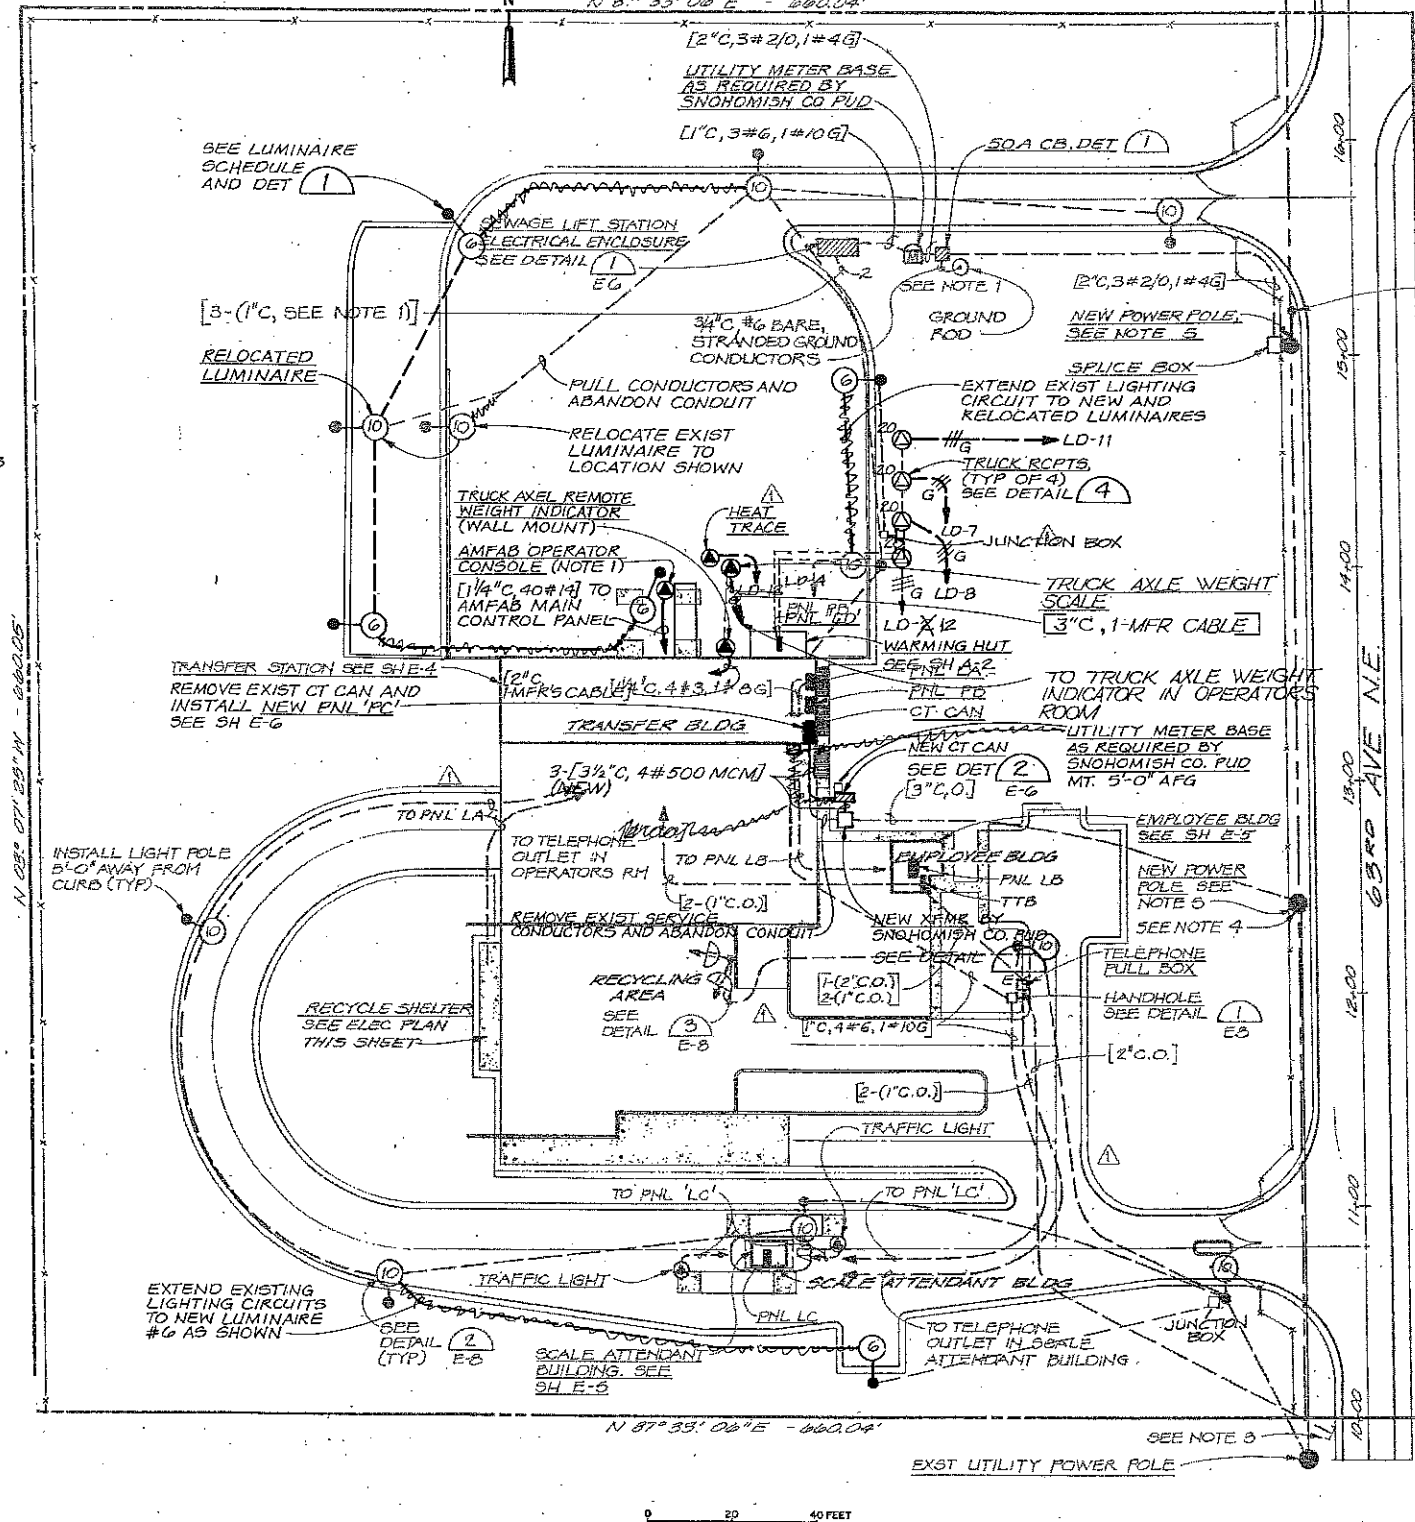

TYP TRENCH AND CONDUIT PLACEMENT (3)

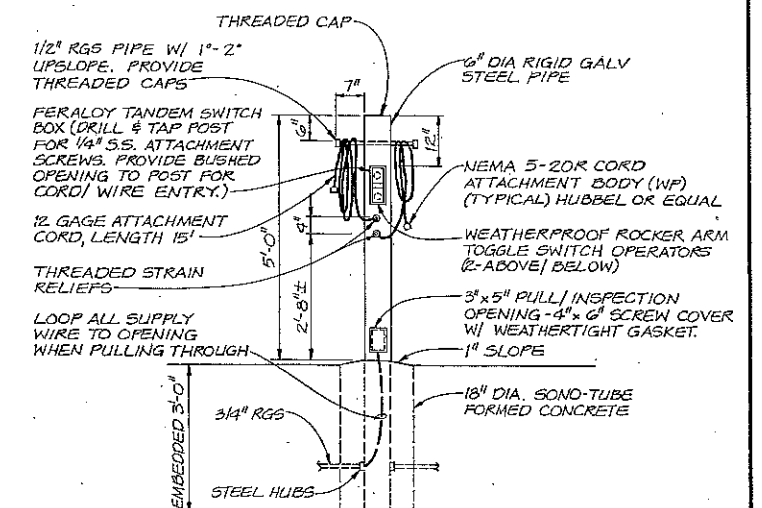

BLOCK HEATER RCPT MOUNTING DETAIL (4)

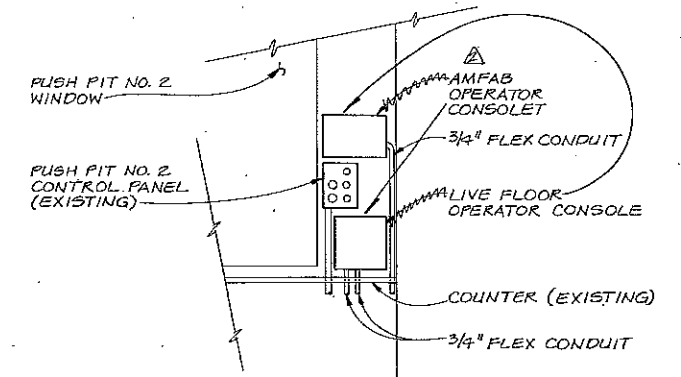

CONTROL STATION INSTALLATION DETAILS (5)

E-4

OVERLAY IDENTIFICATION
 COMPOSITE E-2.1 E-2.0
 OVERLAY E-2.1 E-2.0
 SCREEN E-2.1 E-2.0
 CONTRACT E-2.1 E-2.0

PLAN CHECK	BY	DATE	REGION NO.	STATE	FED. AID PROJ. NO.	SHEET NO.
B. TOOLE		1/90	10	WASH.		
J. BLACK		1/90				
2-12-91	REVISOR	AS NOTED	MFH/JDM	DESIGNED BY:	T. JOYCE/S. BAKER	DRAWN BY:
JAN 24 1991	EXISTING FEATURES 1/2 TYPED.			DATE APPROVED:	JAN. 1990	FIELD BOOK(S):
DATE	NO.	REVISION	BY			



Gerald E. Weed
 SNOHOMISH COUNTY ENGINEER

SNOHOMISH COUNTY
DEPARTMENT OF
PUBLIC WORKS

PROJECT NO. 89-423

"AS-BUILT"
 ELECTRICAL:
 SITE PLAN AND DETAILS

SURVEY NO.
 SHEET
 E-2
 OF
 SHEETS

SOUTHWEST RECYCLING AND TRANSFER STATION (SWRTS) EXPANSION 61ST PLACE WEST

SW RECYCLING & TRANSFER
STATION (SWRTS):
SUPR, MIDDLETON
OPERATORS, 2 FTE
LABORERS, 10 FTE
SITE ATTENDANTS, 7 FTE
2026

PROJECT NO. SDC-5029

Contract Drawings

Bid Number 02-02



June, 2002

Volume 4 of 4

JIM WILSON
PUBLIC WORKS
WALL ST 5TH FL
SOLID WASTE,




Snohomish County Public Works
Solid Waste Management Division

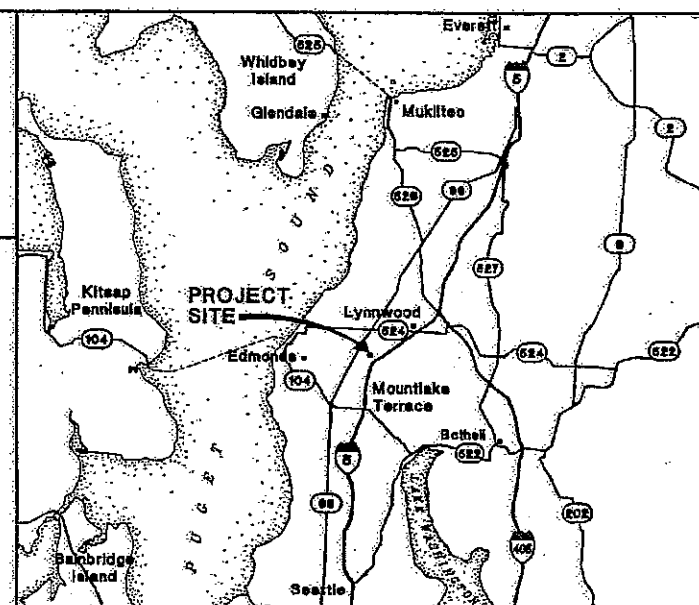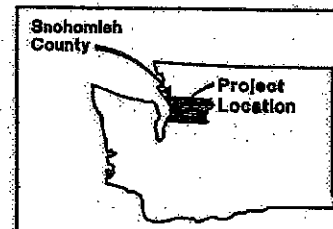

PROJECT VICINITY

NTS

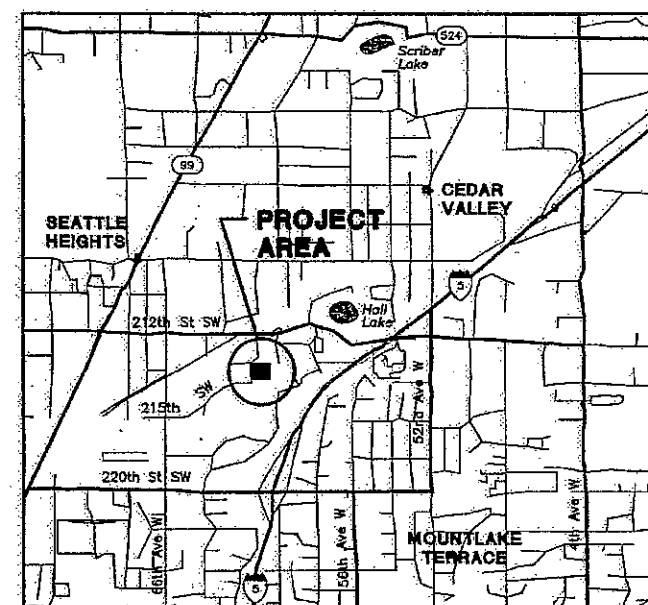

PROJECT SITE LOCATION

NTS

DIRECTOR OF PUBLIC WORKS

PETER E. HAHN

COUNTY ENGINEER

STEVEN E. THOMSEN, P.E.

EXECUTIVE

ROBERT J. DREWEL

COUNCIL MEMBERS


JOHN KOSTER - DIST. 1
KIRKE SIEVERS - DIST. 2
GARY NELSON - DIST. 3
DAVE GOSSETT - DIST. 4
JEFF SAX - DIST. 5

Berryman
Henigar

• CH2MHILL • Dragonfly • Enviromech • Herrera Environmental Consultants • Miller Consulting • HDR

CDR FILE: S:\024421\024421-05.dwg XREFS: 21421-P1, 21421-B1, 21421-P2
PLOT DATE: 06/19/02 TIME: 14:01:42
PLOT SCALE: 1"=1'

**SW RECYCLING & TRANSFER
STATION (SWRTS):
SUPR, MIDDLETON
OPERATORS, 2 FTE
LABORERS, 10 FTE
SITE ATTENDANTS, 7 FTE
2026**

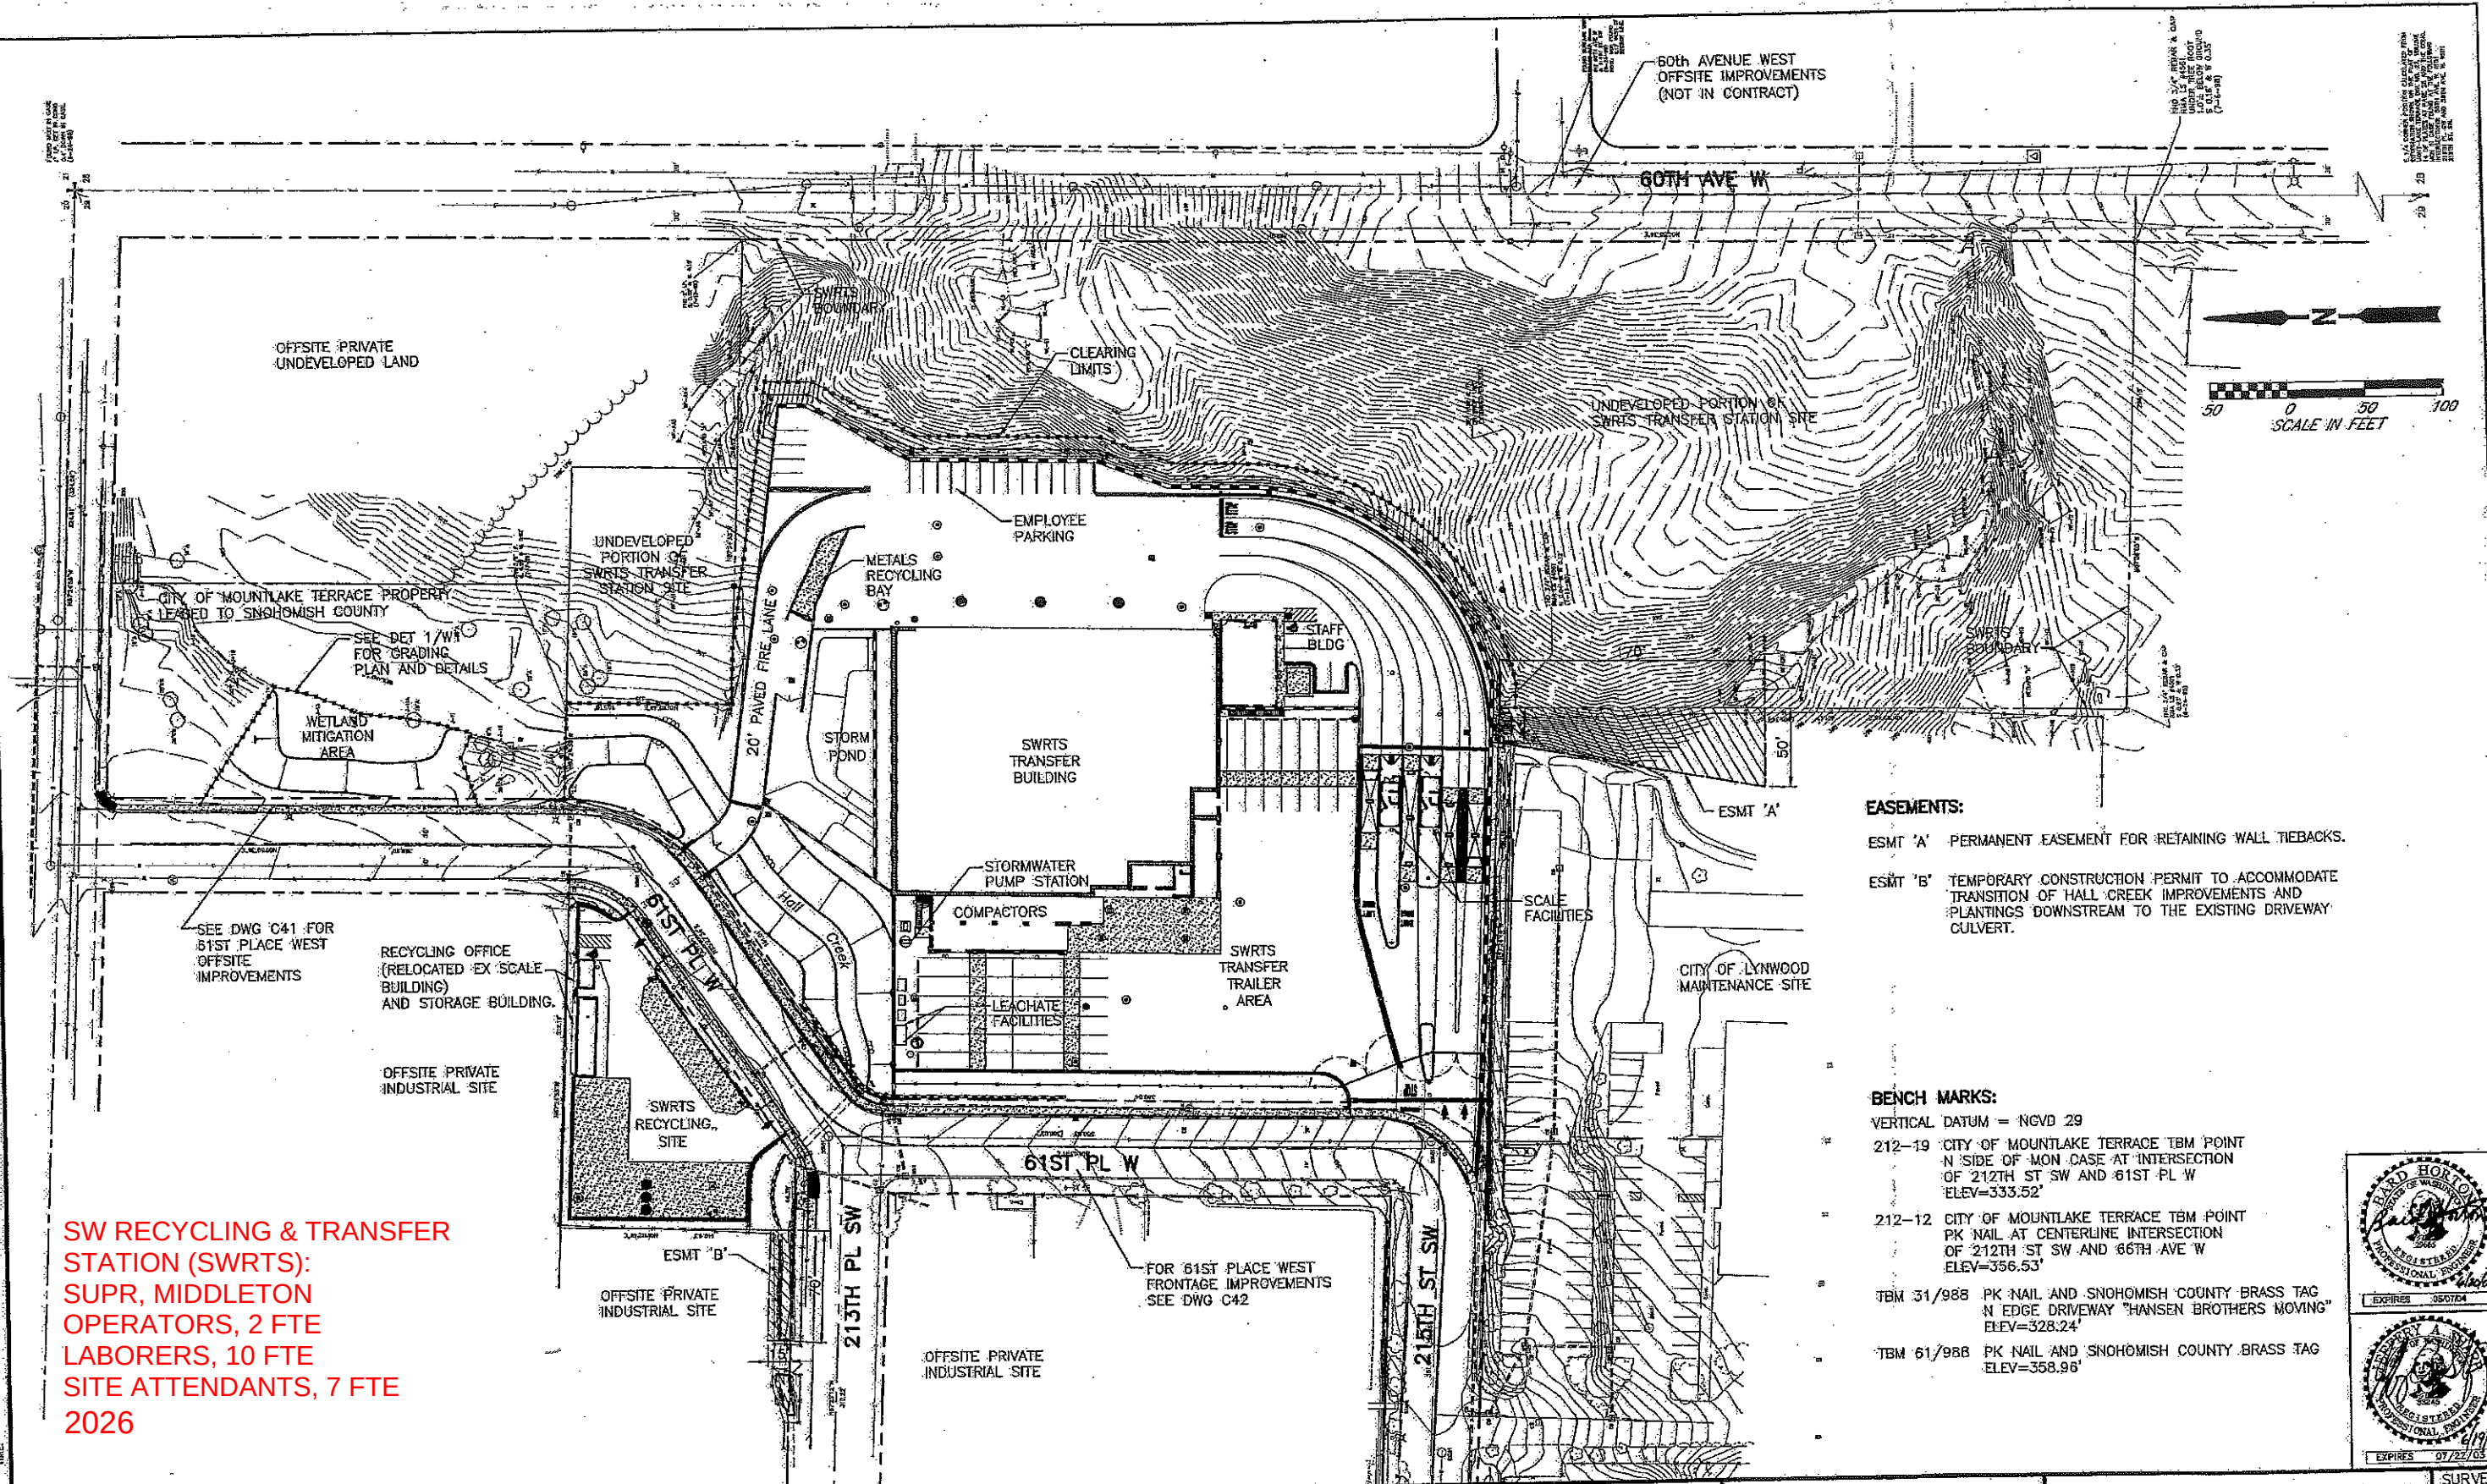

EASEMENTS:

ESMT 'A' PERMANENT EASEMENT FOR RETAINING WALL TIEBACKS.

ESMT 'B' TEMPORARY CONSTRUCTION PERMIT TO ACCOMMODATE TRANSITION OF HALL CREEK IMPROVEMENTS AND PLANTINGS DOWNSTREAM TO THE EXISTING DRIVEWAY CULVERT.

BENCH MARKS:

VERTICAL DATUM = NGVD 29

212-19 CITY OF MOUNTLAKE TERRACE TBM POINT N SIDE OF MON CASE AT INTERSECTION OF 212TH ST SW AND 61ST PL W ELEV=333.52'

212-12 CITY OF MOUNTLAKE TERRACE TBM POINT PK NAIL AT CENTERLINE INTERSECTION OF 212TH ST SW AND 66TH AVE W ELEV=356.53'

TBM 31/988 PK NAIL AND SNOHOMISH COUNTY BRASS TAG N EDGE DRIVEWAY "HANSEN BROTHERS MOVING" ELEV=328.24'

TBM 61/988 PK NAIL AND SNOHOMISH COUNTY BRASS TAG ELEV=358.96'



PLAN CHECK	BY	DATE	REGION NO.	STATE	FED. AID PROJ. NO.	SHEET NO.
			10	WASH.		
			DESIGNED BY:	DRAWN BY:		
			J. SHARP	CAD TEAM		
			FIELD BOOK(S):	BAR IS ONE INCH ON ORIGINAL DRAWING		
			1045	IF NOT ONE INCH SCALE ACCORDINGLY		
DATE	NO.	REVISION	BY			

720 3rd Avenue, Ste 1200
Seattle, Washington 98104
206.525.3400
Fax 206.255.3406

EXPIRES 07/07/03 DATE APPROVED

**SNOHOMISH COUNTY
DEPARTMENT OF
PUBLIC WORKS**


PROJECT NO. SDC-5029

**SOLID WASTE MANAGEMENT DIVISION
SWRTS EXPANSION
SITE PLAN**

SURVEY NO. 3578
65
SHEET 5 OF 187 SHEETS

SULTAN DROP BOX TRANSFER STATION


SULTAN DROP BOX:
SUPR, HANSEN
SITE ATTENDANTS, 4 FTE
2026

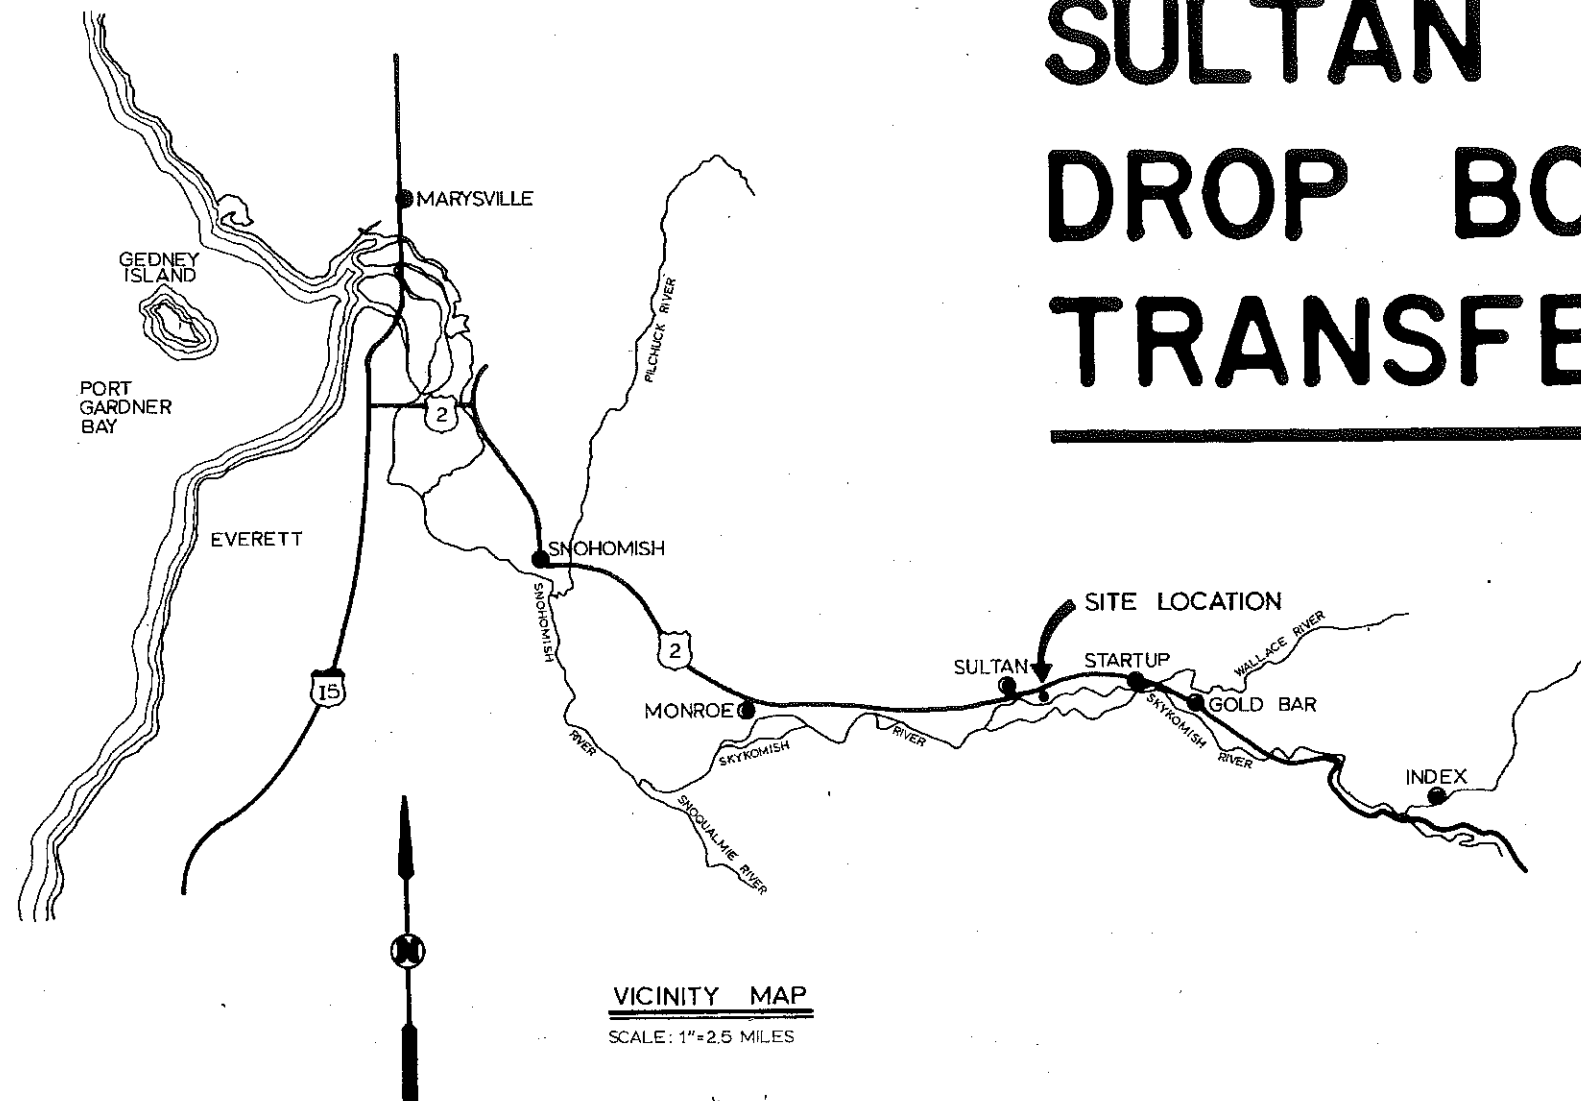

DEPARTMENT OF PUBLIC WORKS
SOLID WASTE DIVISION

GERALD E. WEED P.E.
DIRECTOR, DEPARTMENT OF PUBLIC WORKS

CHARLES HILL
CHAIRMAN, BOARD OF COUNTY COMMISSIONERS

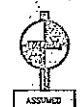

SECTION 33
T.28 N.
R.8 E. W.1.


DESCRIPTION OF WORK

THE WORK CONTAINED HEREIN CONSISTS OF, BUT MAY NOT BE LIMITED TO, THE RELOCATION OF AN EXISTING STRUCTURE AND THE CONSTRUCTION OF A NEW STRUCTURE AT SIX SITES IN SNOHOMISH COUNTY. THE NEW STRUCTURE IS A 10'-0" BY 12'-0" WOOD FRAME BUILDING WITH A STANDING SEAM METAL ROOF, T1-11 SIDING, AND A PRECAST CONCRETE PIER FOUNDATION.

INTERIOR SPACES INCLUDE A TOILET AREA WITH A DRY CHEMICAL TOILET AND AN EXTERNALLY PUMPED HOLDING TANK, AN EXTERNALLY ACCESSED STORAGE AREA, AND THE MAIN OFFICE/WORK AREA. THE SPACE IS HEATED BY ELECTRIC BASEBOARD HEAT, CONTROLLED BY A WALL-MOUNTED THERMOSTAT. CASEWORK INCLUDES A SMALL STORAGE SHELF AND A SPLIT-HEIGHT WORK SURFACE WITH A THREE-DRAWER END UNIT. THE SPACE IS INSULATED BY R-30 BATT INSULATION ABOVE THE CEILING, R-11 BATT IN THE WALLS, AND R-19 BATT IN THE FLOOR.

GENERAL NOTES

1. CONTRACTOR SHALL COORDINATE ALL WORK WITH THE APPROPRIATE CITY OR COUNTY OFFICIALS PRIOR TO THE START OF ANY DEMOLITION OR CONSTRUCTION. THIS IS AN OPERATING FACILITY WHICH WILL REMAIN IN OPERATION DURING THE TERM OF THIS CONTRACT. WHERE THE FACILITY OPERATIONS CONFLICT WITH THOSE OF THE CONTRACTOR, THE FACILITY OPERATIONS WILL TAKE PRECEDENCE OVER THOSE OF THE CONTRACTOR. IT SHALL BE THE SOLE RESPONSIBILITY OF THE CONTRACTOR TO SCHEDULE AND COORDINATE HIS ACTIVITIES WITH THOSE OF THE FACILITY TO ASSURE MINIMUM DISRUPTION TO THE FACILITY OPERATIONS.
2. THE CONTRACTOR SHALL COORDINATE AND ARRANGE WITH THE PROPER UTILITY COMPANIES FOR THE DISCONNECTION AND RECONNECTION OF ALL POWER AND TELEPHONE LINES. THIS IS TO HAPPEN PRIOR TO THE RELOCATION OF THE EXISTING FACILITIES AND AT THE TIME OF SWITCHING TO THE NEW FACILITIES.
3. THE CONTRACTOR IS TO RELOCATE THE EXISTING FACILITY AS SHOWN ON THE PLANS INTACT WITH THE TOILET HOLDING TANK. THE CONTRACTOR SHALL MAINTAIN THE CORRECT OPERATION OF ALL UTILITIES AFTER THE RELOCATION OF THE FACILITY.
4. THE CONTRACTOR SHALL EXCAVATE THAT LOCATION OF THE NEW BUILDING FOR THE PLACEMENT OF THE PRECAST CONCRETE PIERS. THE PRECAST PIERS ARE TO BE PLACED ON UNDISTURBED SOIL OR STRUCTURAL FILL COMPACTED TO 95% DENSITY. BACKFILL AROUND THE PIERS WITH STRUCTURAL FILL AND COMPACT TO 95%.
5. THE CONTRACTOR IS TO CONSTRUCT THE NEW ATTENDANT BUILDING PER THE DRAWINGS AS SHOWN ON SHEETS A3.1 AND A3.2 AND IN ACCORDANCE WITH THE SPECIFICATIONS AS SHOWN ON SHEETS A4.1 AND A4.2.

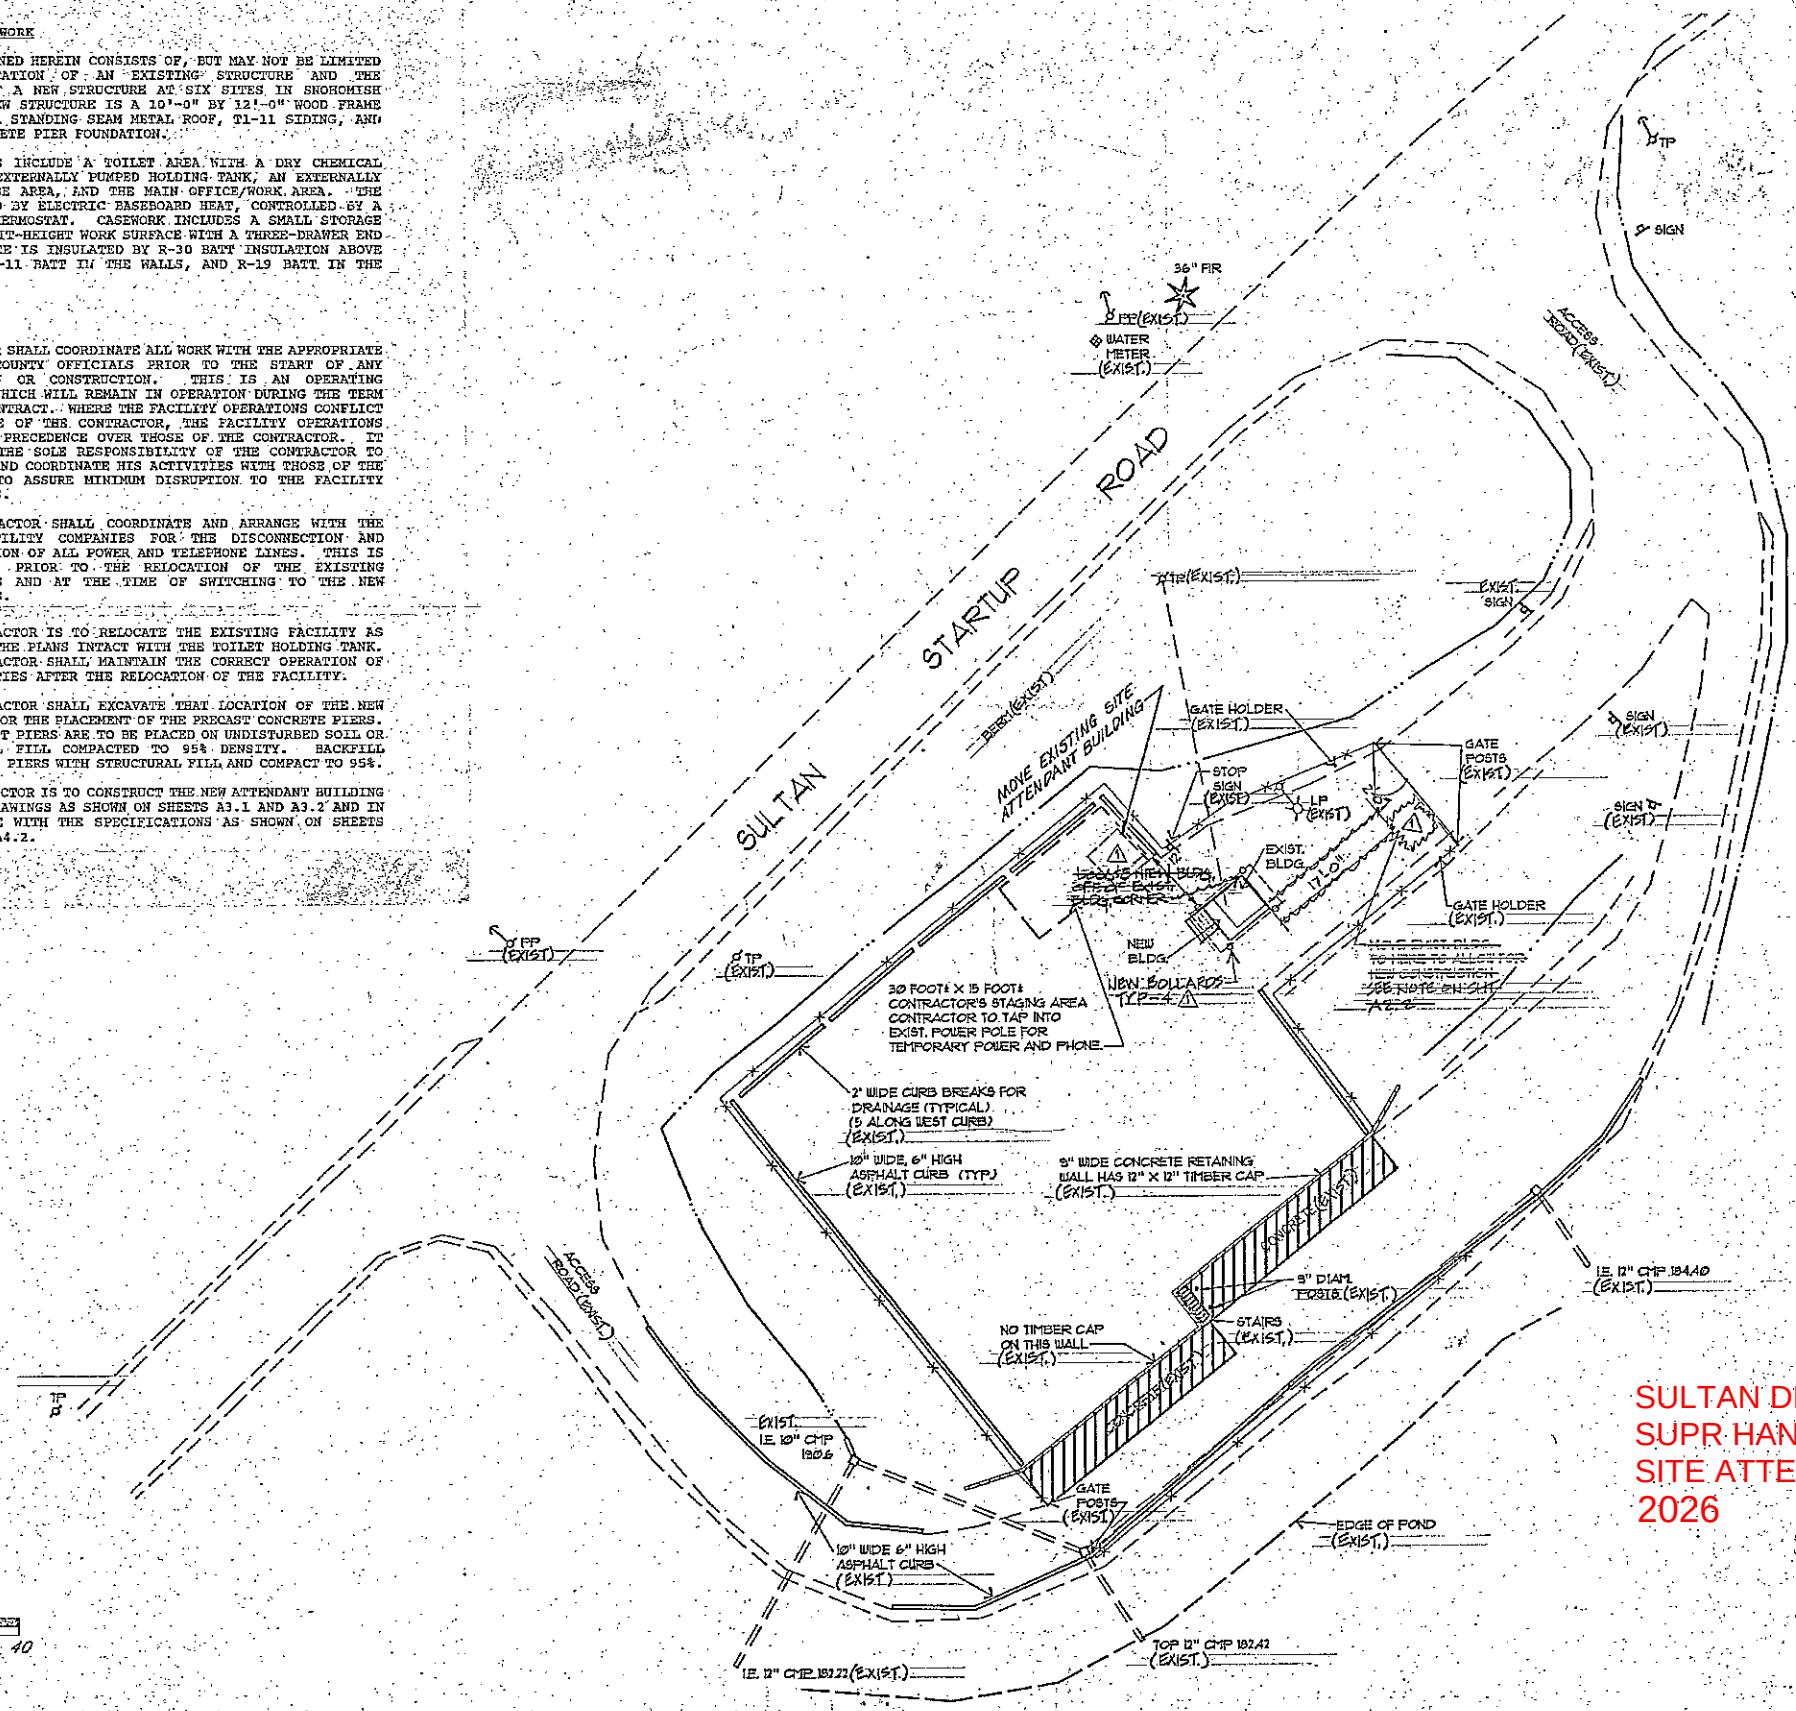

0 20 40
SCALE IN FEET

PLAN CHECK	BY	DATE	DATE	NO.	REVISION	BY	REGION NO.	STATE	FED. AID PROJ. NO.	SHEET NO.
							10	WASH.	89-484	A2.5
DESIGNED BY:							DRAWN BY:			
DATE APPROVED:							FIELD BOOK(S):			
							723			



ALPHA ENGINEERS INC.
CIVIL & STRUCTURAL ENGINEERING CONSULTANTS
1000 CHRISTENSEN ROAD, SEATTLE, WA 98108
Gerald E. Weed
SNOHOMISH COUNTY ENGINEER

SNOHOMISH COUNTY
DEPARTMENT OF
PUBLIC WORKS
PROJECT NO. 89-484

A6-BUILT
SNOHOMISH COUNTY
SOLID WASTE DROP BOX SITES
SULTAN, WASHINGTON
SITE PLAN AND TOPOGRAPHY

SURVEY NO.
3224
SHEET
A2-5
OF
10
SHEETS



SNOHOMISH COUNTY, WASHINGTON
DEPARTMENT OF PUBLIC WORKS

ADDITIONS TO
SOLID WASTE DROP BOX FACILITIES
EMPLOYEE BUILDINGS

CRP-89-464

SNOHOMISH COUNTY OFFICIALS

DIRECTOR OF PUBLIC WORKS

GERALD E. WEED, P.E.

EXECUTIVE

WILLIS TUCKER

COUNCIL MEMBERS

ROSS KANE
ELIZABETH McLAUGHLIN
BILL BRUBAKER
BRIAN CORCORAN
PETER HURLEY

GOLD BAR
LAKE ROESIGER
OSO

GRANITE FALLS
MONROE
SULTAN

PLAN CHECK	BY	DATE				REGION NO.	STATE	FED. AID PROJ. NO.	SHEET NO.	 <i>Gerald E. Weed</i> SNOHOMISH COUNTY ENGINEER	SNOHOMISH COUNTY DEPARTMENT OF PUBLIC WORKS PROJECT NO. 89-464	AS-BUILT	SURVEY NO. SHEET 11.1 OF 12 SHEETS
					10	WASH.							
					DESIGNED BY:	DRAWN BY:							
					DATE APPROVED:	FIELD BOOK(S):							
					DATE	NO.	REVISION	BY					

