444

CHANGE ORDER

Construction for New Start Center of Everett 1602 SE Everett Mall Way Everett, WA 98208 Contract # PW-24-027SB CO Number: 05
Dated: November 2024 Date: 6 June 2025

Contractor:

Marpac Construction LLC 1225 S. Weller Street; Suite 500 Seattle, WA 98144

The Contract is changed as follows:

Pursuant to part 17 of the General Conditions the contractor shall:

The South County Fire Department Official is requiring the system to be addressable to have low volume horns, and associated upgrades as is the official's right to require such per the Fire Code. This is a condition that could not have been know at the time of the bid.

Material	Contract Sum Adjustment	Contract Schedule Adjustment
Fire Alarm Upgrades	\$200,329.05	0 days
Total	\$200,329.05	0 days

Original Contract Sum		\$4,040,000.00
Change to Contract Sum by Previous Change Orders to date	\$107,817.59	\$107 <mark>(7</mark> 17.59
Change to Contract Sum by this Change Order		\$200,329.05
New Contract Sum	\$4,348,146.64	\$4,348,046.64

WD

WD

All Contract Sums are exclusive of sale tax.

The Contract Completion Time shall be unchanged.

The Change Order shall not be valid until signed by the Owner and Contractor.

Contractor:DocuSigned	Consultant:	Owner:
By: Wilson (Diaton By:	By:
Wilson Deaton Projec	t Manager _{Dan} Murray Pri	ncipal in the Firm
Printed Name, Tile 6/10/202		Printed Name, Title
Printed Name, Tile 6/10/202		Printed Name, Title Date:



PCO #003

Project: 24-09 – New Start Everett 6201 SE Everett Mall Way Everett, Washington 98208

Marpac Construction LLC 1225 S. Weller St., Suite 500 Seattle, Washington 98144 Phone: (206) 329-4992

Prime Contract Potential Change Order #003: Fire Alarm Addition

TO: Snohomish County FROM: Marpac Construction

 3000 Rockefeller Ave, MS 507
 1225 S Weller Street Suite 500

 Everett, Washington 98201
 Seattle, Washington 98144

 PCO NUMBER/REVISION:
 003 / 3
 CONTRACT:
 New Start Everett

 STATUS:
 Pending – In Preview
 CREATED DATE:
 4/21/2025

SCHEDULE IMPACT: 10 Days EXECUTED: No

POTENTIAL CHANGE ORDER TITLE: Fire Alarm Addition

CHANGE REASON: Existing Condition

POTENTIAL CHANGE ORDER DESCRIPTION: (The Contract Is Changed As Follows)

Cost to add full fire alarm system to project. Both buildings. Includes demolition and drywall repair. Hazmat Abatement to be compelted T&M per PCO #2.

#	Budget Code	9	Description	Qty	Units	Unit Cost		Subtotal	
1	26 10 00		Fire Alarm System	1	Ea	\$ 143,799.69		\$	143,799.69
2	09 29 00		GWB Demo	80	Hrs	\$ 123.18		\$	9,854.40
3	09 29 00		GWB Repair	160	Hrs	\$ 121.15		\$	19,384.00
								\$	-
							Subtotal	\$	173,038.09
						OH&P: 15%		\$	25,955.71
						B&O Tax: .671%		\$	1,335.25
							Grand Total	\$	200,329.05



Please add days to contract

SYSTEM SOLUTIONS OF WASHINGTO PO BOX LYNNWOOD, WA §

> OFFICE: 425.249 FAX: 425.249 Systemsolutionsw

COP Subcontractor Breakdown Summary

PROJECT NAME:				SSW COP No.		2
-			Arc	chitects Tracking number :		0/00/05
Project No:				<u>Date:</u>	_	<u>2/26/25</u>
Company Name: System Solut	ions of Washington Ir	nc.		Rev: Revised:		
DESCRIPTION: From condu	it, wire, devices, sul	bmittals, sho	op drawings, permit	t. For a complete new FA sy		
	,	,		'		
EXCLUSIONS: Standard contr	act exclusions, CUT, PA	TCH, PAINT				
1. CRAFT LABOR COSTS	HRS	RATE				
a. Electrician	103.5	125.00 \$	12,937.50			
b. Lead electrician	103.5	150.00 \$	15,525.00			
c. Electrician OT	0.0	187.5 \$	-			
d. Lead Electrician OT		225.0 \$	-			
e. PM		150.00 \$	-			
f. site survey		150.00 \$	-			
Diversity of the same	DIRECT LABOR SU	BTOTAL \$	28,462.50			
Direct costs	0	0.07				
g. truck h. travel (if applicable, itemize a		8.37 \$				
ii. traver (ii applicable, itelilize a	ila provide backup)	Ψ		1. CRAFT LABOR COSTS:	\$	28,462.50
2. MATERIALS COSTS					<u> </u>	20, 102.00
a. material costs		\$	1,842.78			
b. Airfreight						
c. Quoted materials		\$	-			
d. Quoted materials		\$	-			
				2. MATERIAL COSTS:	\$	1,842.78
3. EQUIPMENT COSTS			450.00			
a. owned equipment	small tool	\$	150.00			
b. rental equipment	Lift	\$	<u>-</u>	3. EQUIPMENT COSTS:	œ	150.00
4. INSURANCE				3. EQUIPMENT COSTS.	\$	150.00
a. Insurance		\$	_			
a. mourance		<u> </u>		4. INSURANCE:	\$	_
5. PERMIT		\$	<u> </u>	5. PERMIT:	\$	-
6. FEE LABOR	15%			6. FEE	•	4,269.38
FEE MATERIALS	15%			6. FEE	<u>\$</u> \$	276.42
FEE EQUIPMENT	15%				\$	22.50
FEE INSURANCE & PERMIT	15%				\$	-
	.070				<u> </u>	
				Sub Total w/fee	\$	35,023.57
7. SUB-SUBCONTRACTORS						•
a. Electro Tech		\$	92,740.00			
•				7. SUB-SUBCONTRACTORS:	\$	92,740.00
8. FEE on Subcontractor	15%			8. FEE on Subcontractor	\$	13,911.00
9. Subtotal Sub				9. Sub contractor w/fee	\$	106,651.00
o. Gustotui Gus				o. oub contractor whee	Ť	100,001.00
10. Sub TOTAL				10. Sub TOTAL	\$	141,674.57
11. B&O				44 800	•	0.40=.4=
a. 1.5%				11. B&O	\$	2,125.12
12. TOTAL				12. TOTAL	\$	143,799.69
· 2 · · ·						, , , , , , , , ,
13. Time impact because of change	of scope as noted above	ve				

1.0 **DAYS**

Proposal for FIRE ALARM System

In Favor of:

System Solutions of Washington Inc.

Fred Wirtz /Dan Russell /Amber Campbell

425-249-2076

206-379-0630

17151 Sealawn Drive

Edmonds WA 98026

Date: April 7, 2025

Quotation Reference:

Project Name: Everett Hotel

Site Address 1602 SE Everett Mall Way

Site City/State/Zip Everett WA 98208

re are pleased to quote the following services for your project:
--

QTY.	ITEM	DESCRIPTION	PRICE
1	Main Control Panel	IPA 4000V	
10	Smoke Detector	PAD-300-PD	
1	Manual Pull Station	PAD-300-PULL	
46	Unit Smoke Detector	PAD-300-PD/CO	
56	Detector 6" Base	PAD-BAS-6	
8	Selectable Speaker Strobe	FASPRK-W	
10	Strobe	CS-24W	
40	Unit Speaker	FASPRKS-W	
14	Outdoor Speaker Strobe	FASPKR-WPW	
2	Aux Power Supply	PSF12C	
4	Dual Monitor Module Sprinkler Conn	ect PAD100-DIM	
4	Single Input Single Relay Module	PAD100-OROI	

196 Wire & Fittings per Device

Marerial Cost	\$ 47,707.50
Labor Cost	\$ 40,577.50
The Price of the following System is	\$ 88,285.00
Approximant cost for NICETT Engineering is	\$ 3,200.00
Approximant cost for Permits	\$ 1,255.00

Notes

This is a bid design proposal based on provided plans. Any changes in provided plans may change the quoted price

Engineering price is based on provided CADs. If CADs not available there is additional cost.

Conduit Installed by other were needed

Price is Based on a None sprinkled Building

Price is Based on a open Wired system


Lift Provided By pother if Needed


We will be utilizing Existing Wire.

Thank You Chris Davis

Electrical Technology Inc.


Prepared by Chris Davis

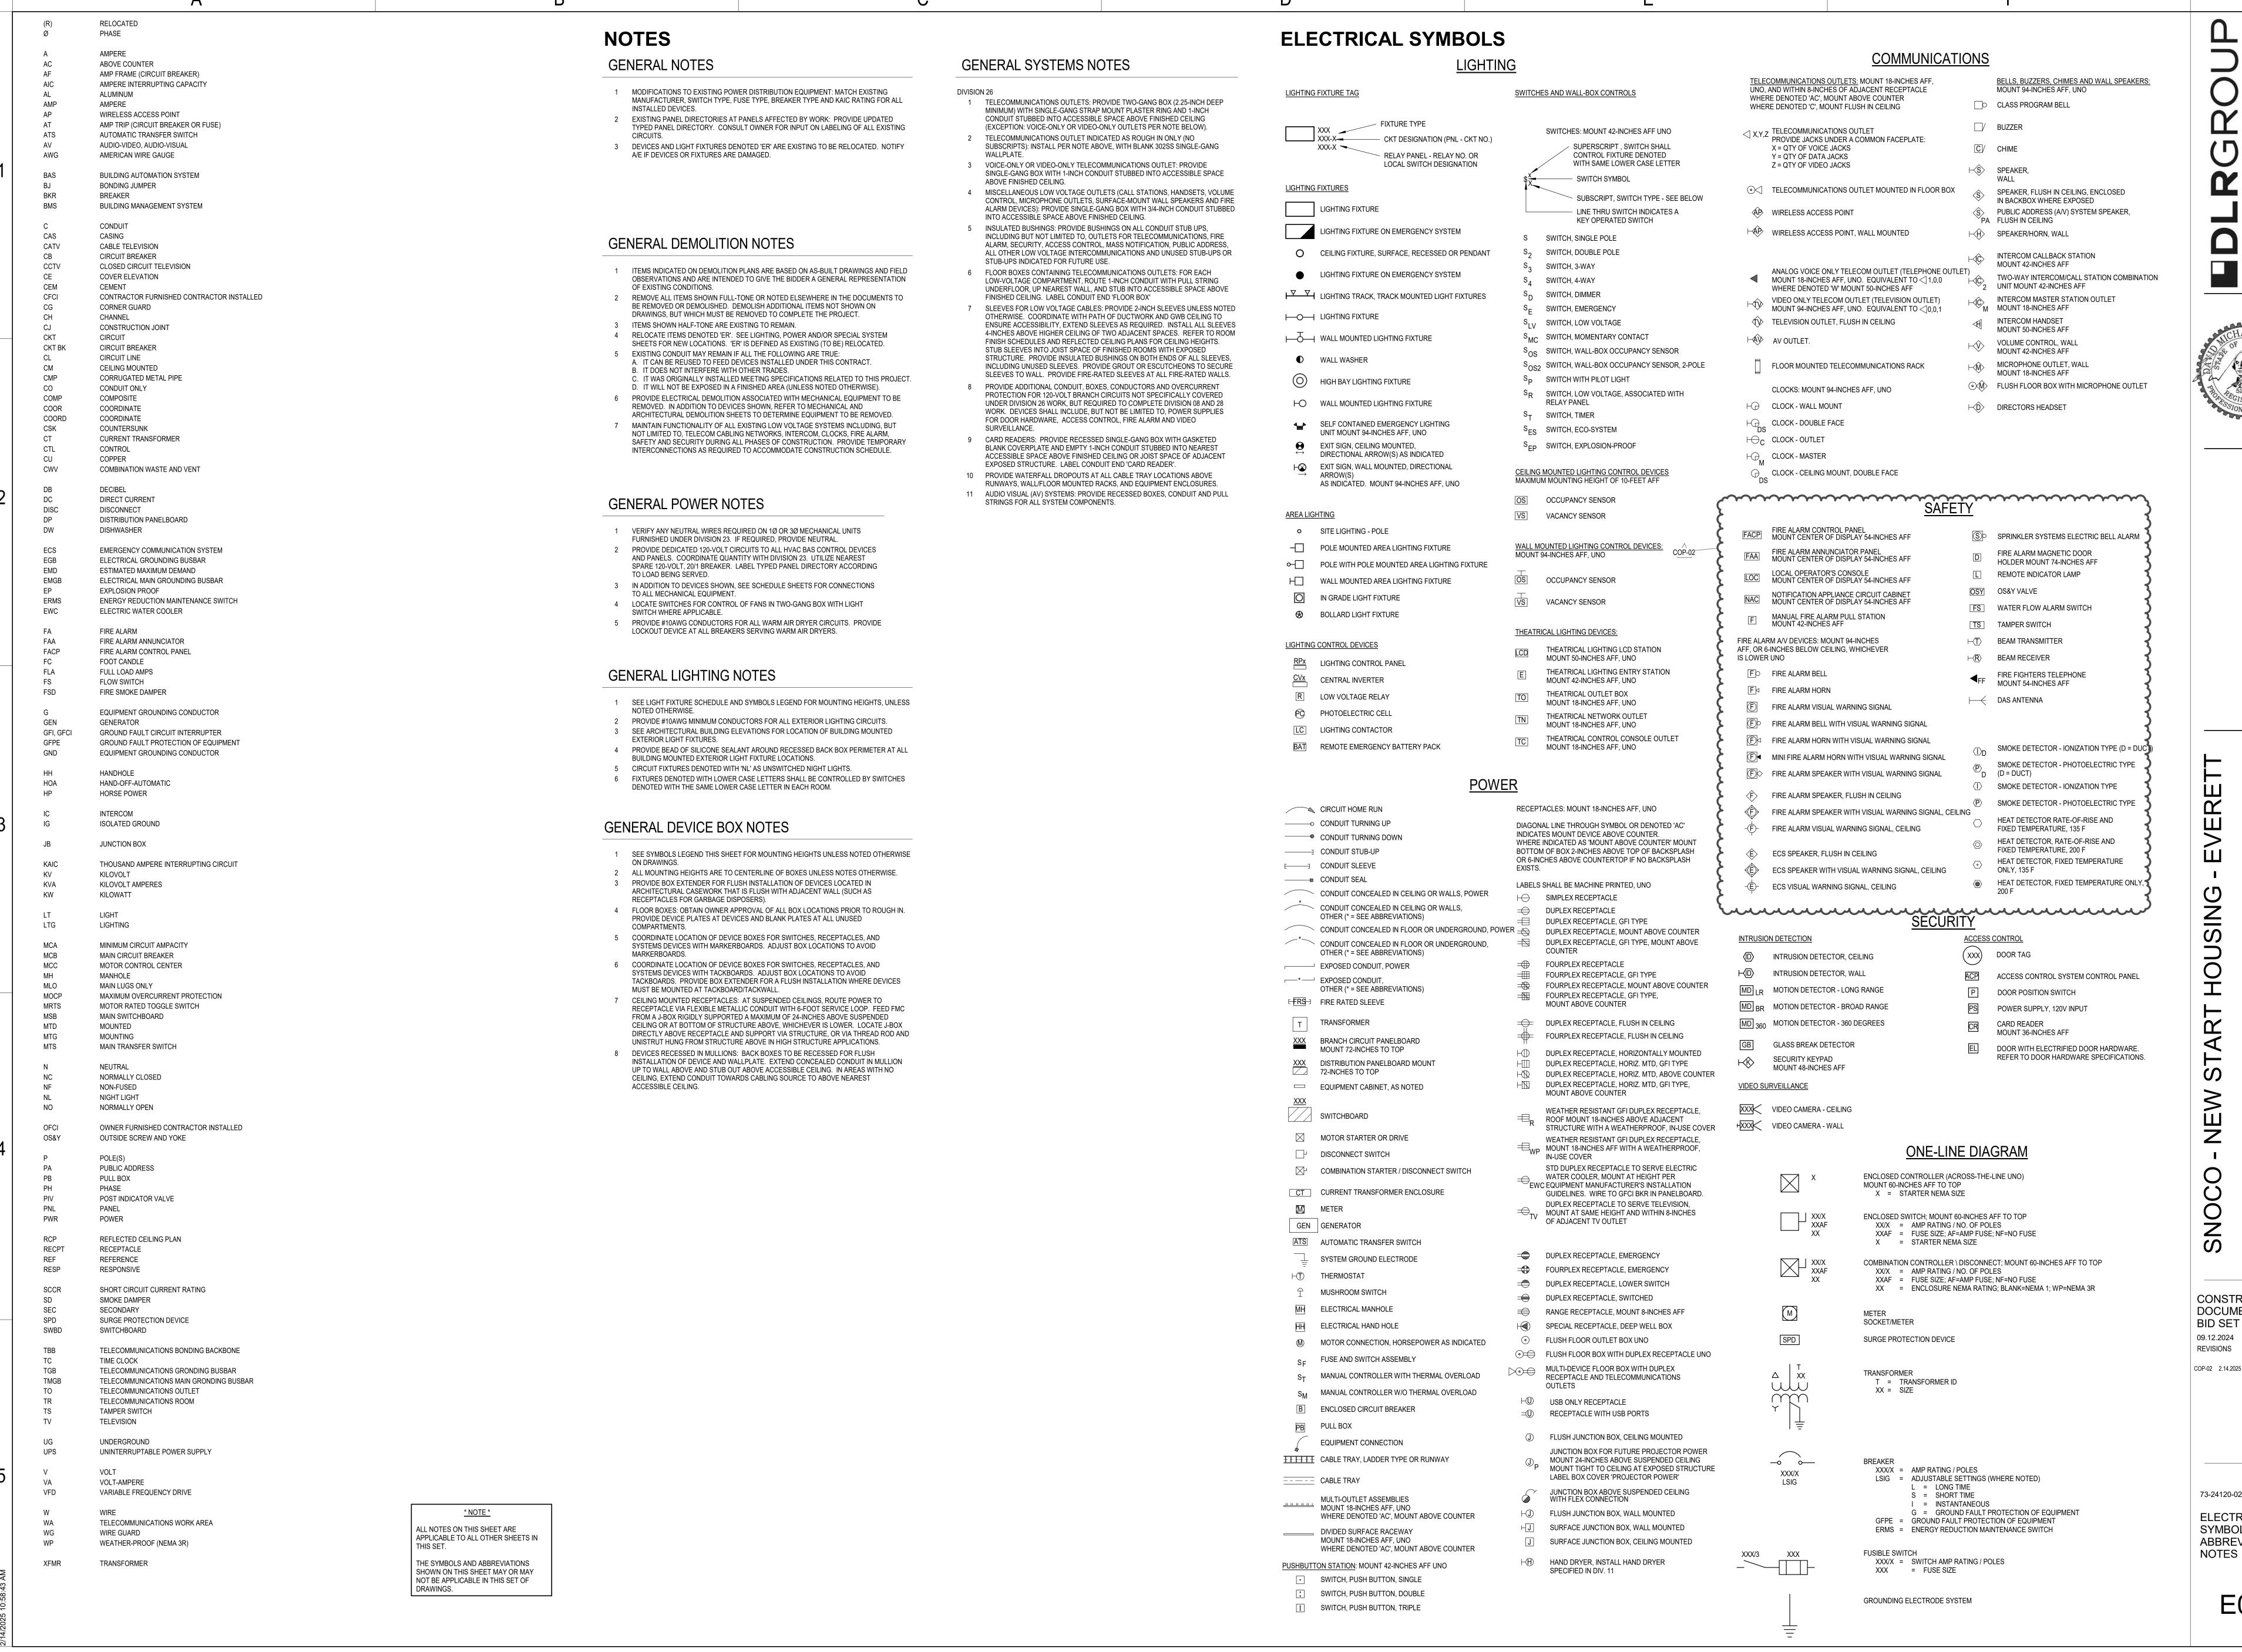

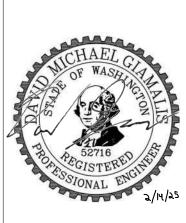

CONSTRUCTION DOCUMENTS -BID SET 09.12.2024 REVISIONS COP-02 2.14.2025

73-24120-02 **ELECTRICAL** SYMBOLS, ABBREVIATIONS &

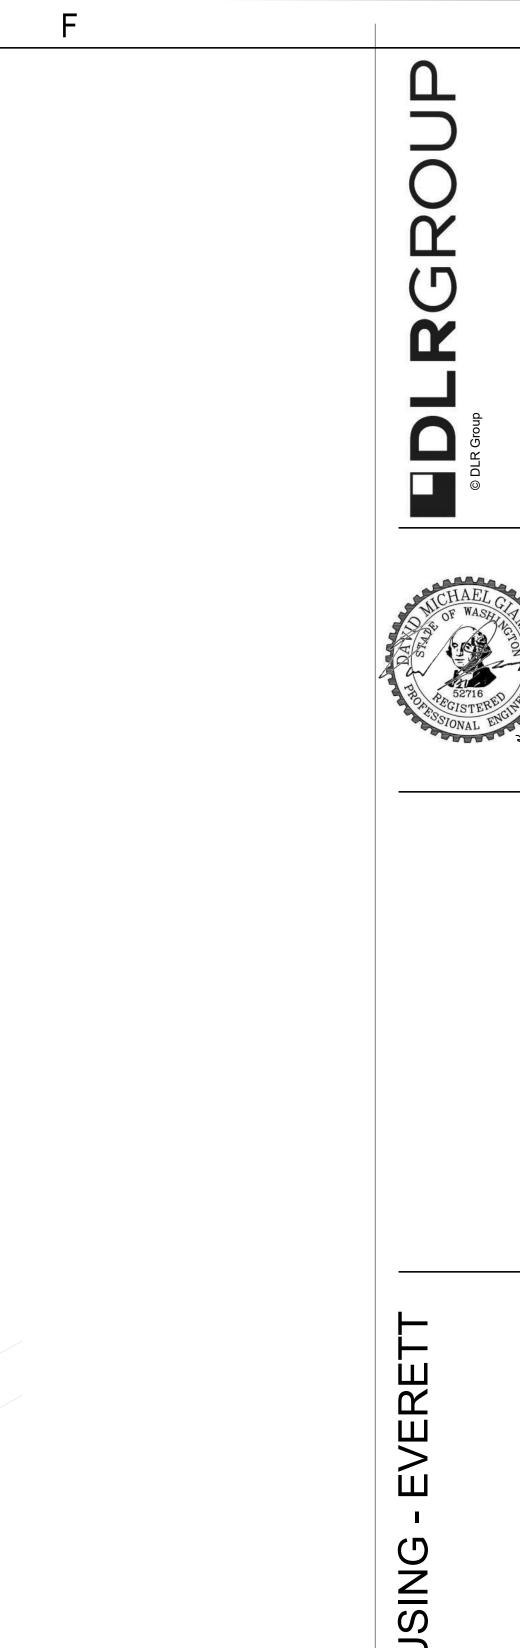

LEVEL 02 - POWER PLAN

SCALE: 1/8" = 1'-0"

MULTI-PURPOSE DINING 105 FRONT DESK

102

MULTI-PURPOSE
LOUNGE &
HELP CENTER

101

LEVEL 01 - POWER PLAN

SCALE: 1/8" = 1'-0"

SHEET NOTES

Docusign Envelope ID: 04C180C8-6B5D-4FA1-B53D-AB226BAC499E

- E1 PROVIDE CONNECTION BY REUSING FEEDER AND CIRCUIT FROM DEMO'D RECEPTACLE . SEE CORRESPONDING
 DEMO SHEET FOR LOCATION OF DEMO'D FIXTURE.
- CIRCUITS TO NEW PANELBOARD TO MATCH OLD PANELBOARD SCHEDULE. REFER TO SHEET E5.1 FOR PANEL VOLTAGE AND CURRENT RATING. E4 DEDICATED 120V RECEPTACLE FOR BED BUG TENT. E6 DEDICATED CIRCUIT FOR FOOD WARMING CABINET. PROVIDE NEMA 5-15P

E2 PROVIDE NEW PANELBOARD IN PLACE OF DEMO'D PANEL. FEED ALL EXISTING


- E7 EXISTING RECEPTACLE TO BE REMOVED FROM EXISTING CIRCUIT AND RE-WIRED TO BE A DEDICATED 120V CIRCUIT FOR MICROWAVE/FRIDGE COMBO. E8 EXISTING SECURITY RACK. E9 PROVIDE NEW SERVICE ENTRANCE DISTRIBUTION BOARD IN PLACE OF DEMO'D

SWITCHBOARD. FEED ALL EXISTING CIRCUITS TO NEW SWITCHBOARD. REFER TO SHEET E5.1 FOR SWITCHBOARD VOLTAGE AND CURRENT RATING.

INSTALLATION.

- E10 PROVIDE NEW PANELBOARD IN PLACE OF DEMO'D PANEL. FEED ALL EXISTING CIRCUITS TO NEW PANELBOARD TO MATCH OLD PANELBOARD SCHEDULE.
 REFER TO SHEET E5.1 FOR PANEL VOLTAGE AND CURRENT RATING. PROVIDE SURFACE MOUNT CONDUIT.
- E12 PROVIDE NEMA 6-20P FOR PTAC UNIT.
- E13 DEDICATED CIRCUIT FOR VENDING MACHINE.
- E16 PROVIDE DEDICATED CIRCUIT FOR MICROWAVE/FRIDGE COMBO. E18 PROVIDE EXTERIOR MOUNTED UTILITY METER SOCKET AND CT ENCLOSURE. CONFIRM ALL INSTALLATION REQUIREMENTS WITH PUD PRIOR TO

KEY PLAN

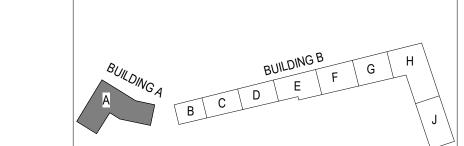


BLDG A - AREA A -POWER PLAN


CONSTRUCTION DOCUMENTS -BID SET


COP-01 1.29.2025 CO PROPOSAL-01 COP-02 2.14.2025

09.12.2024


E2.1

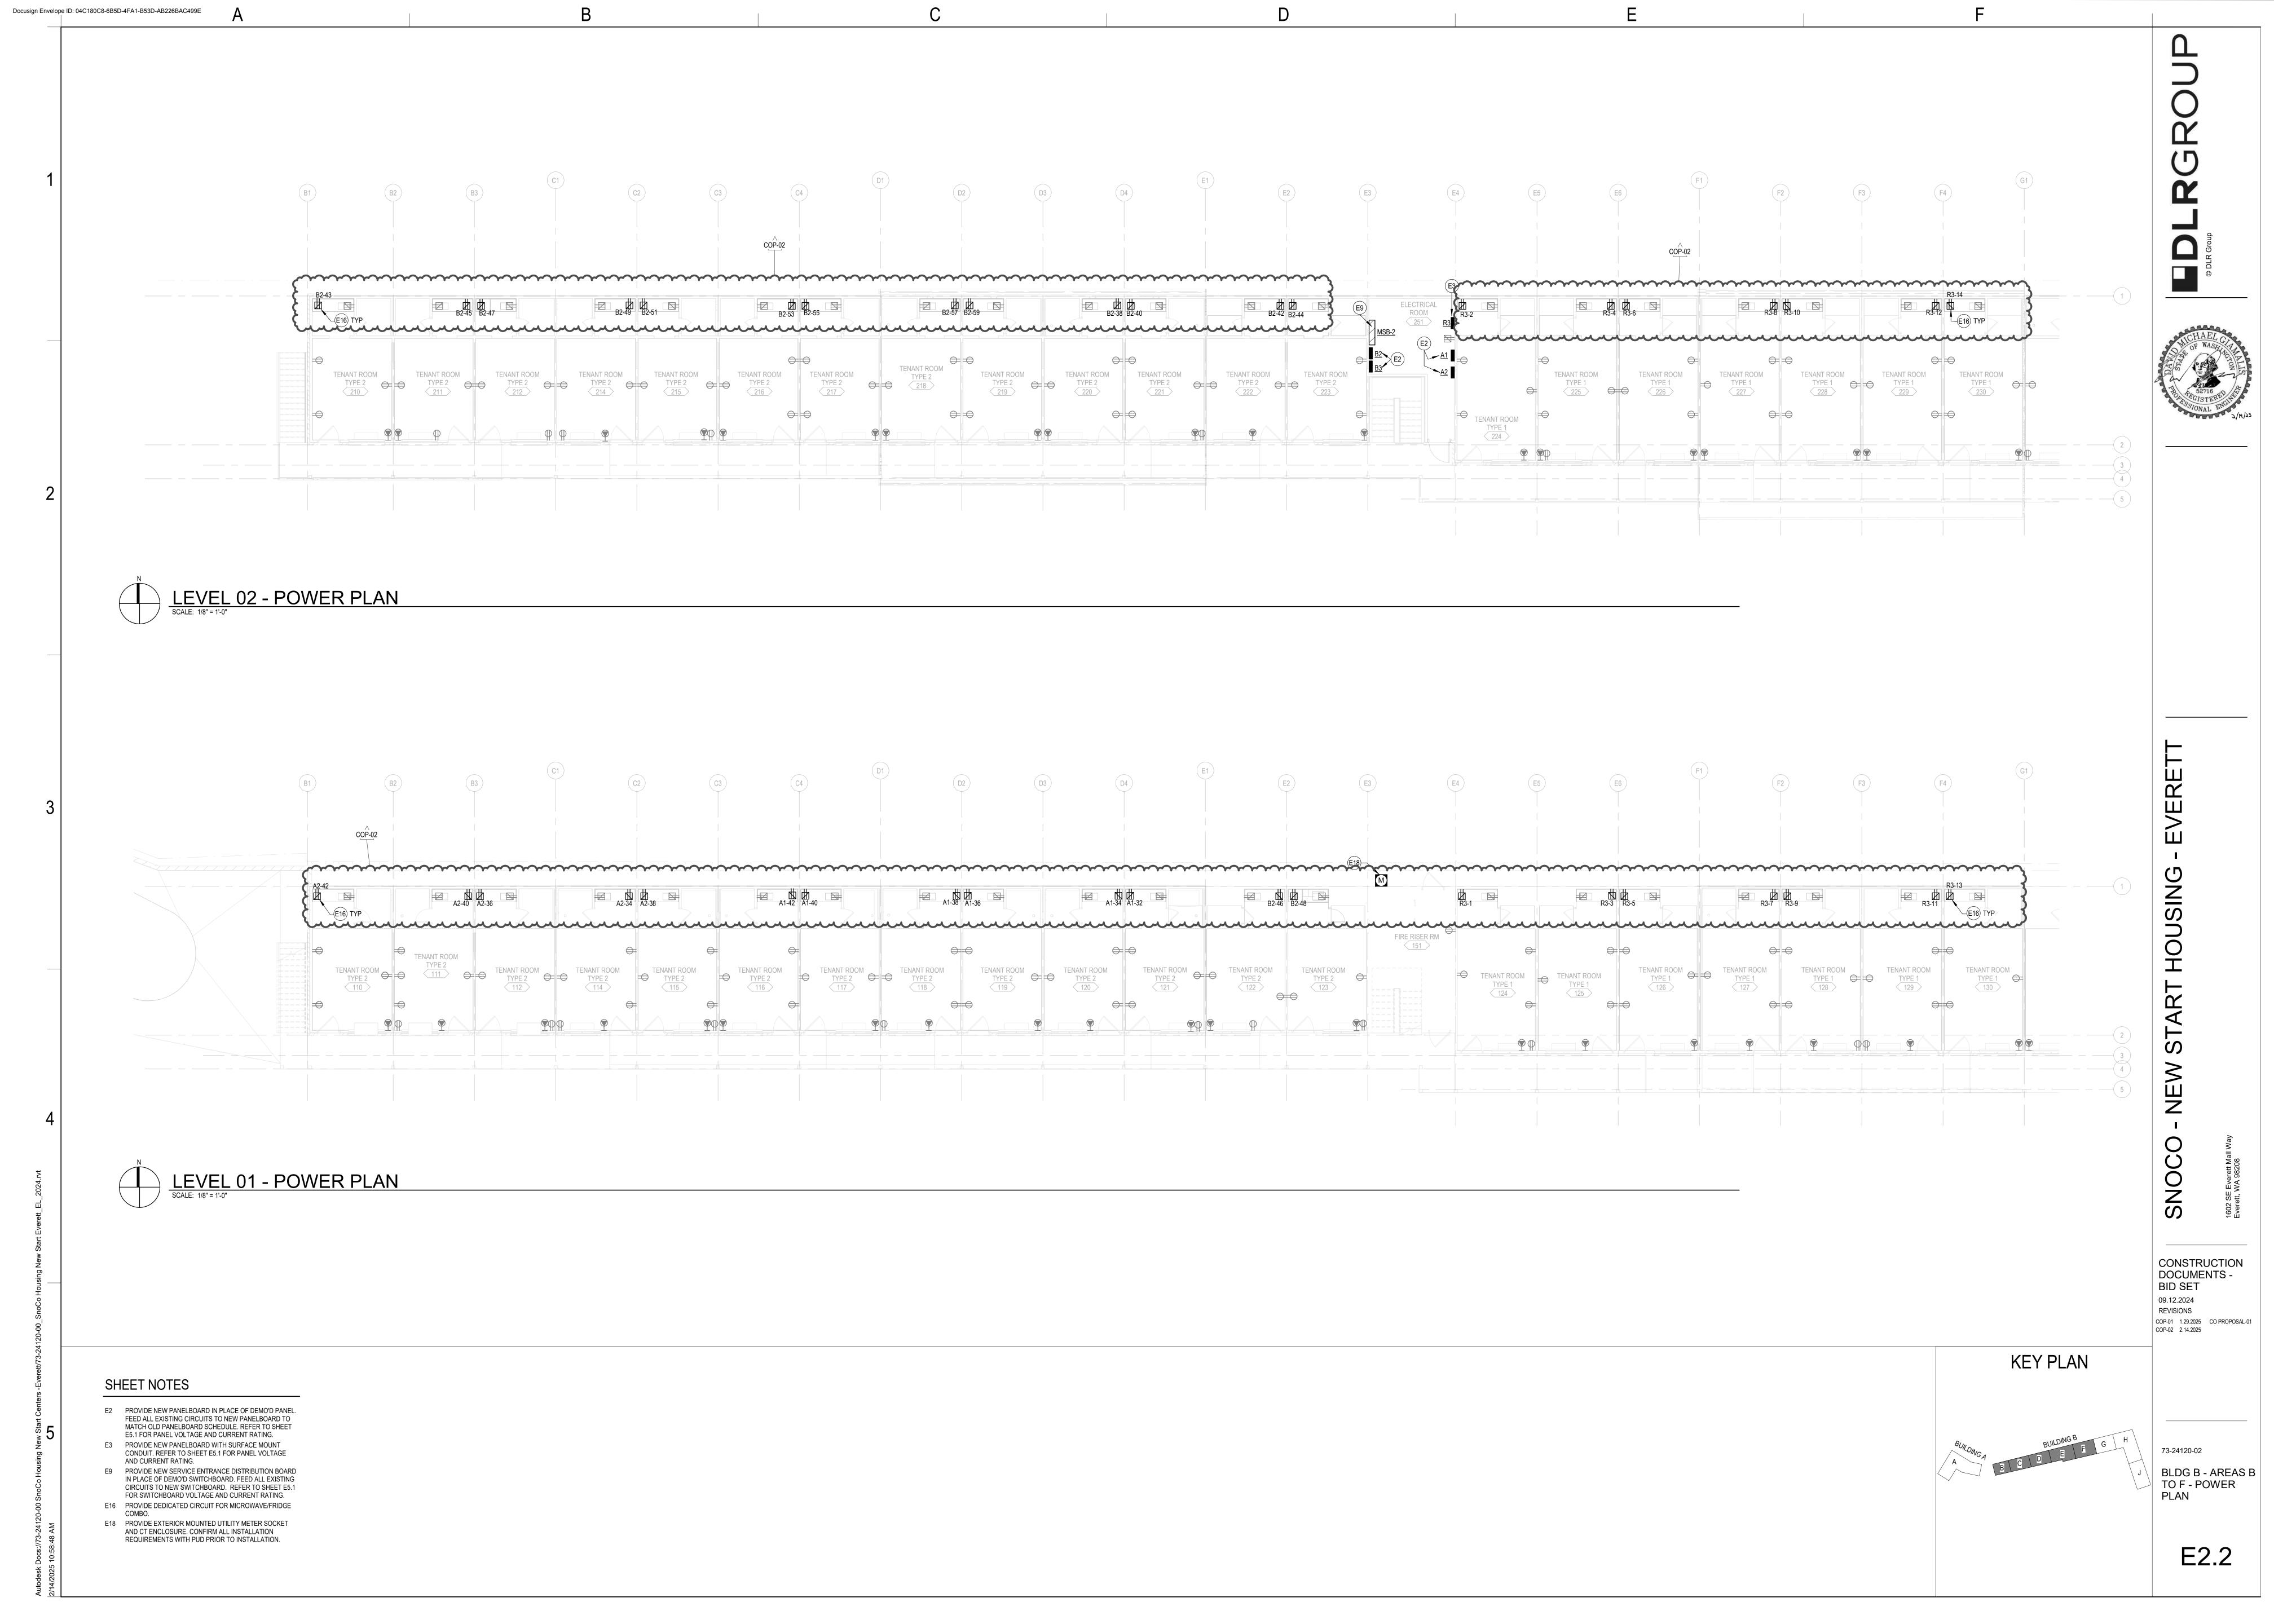


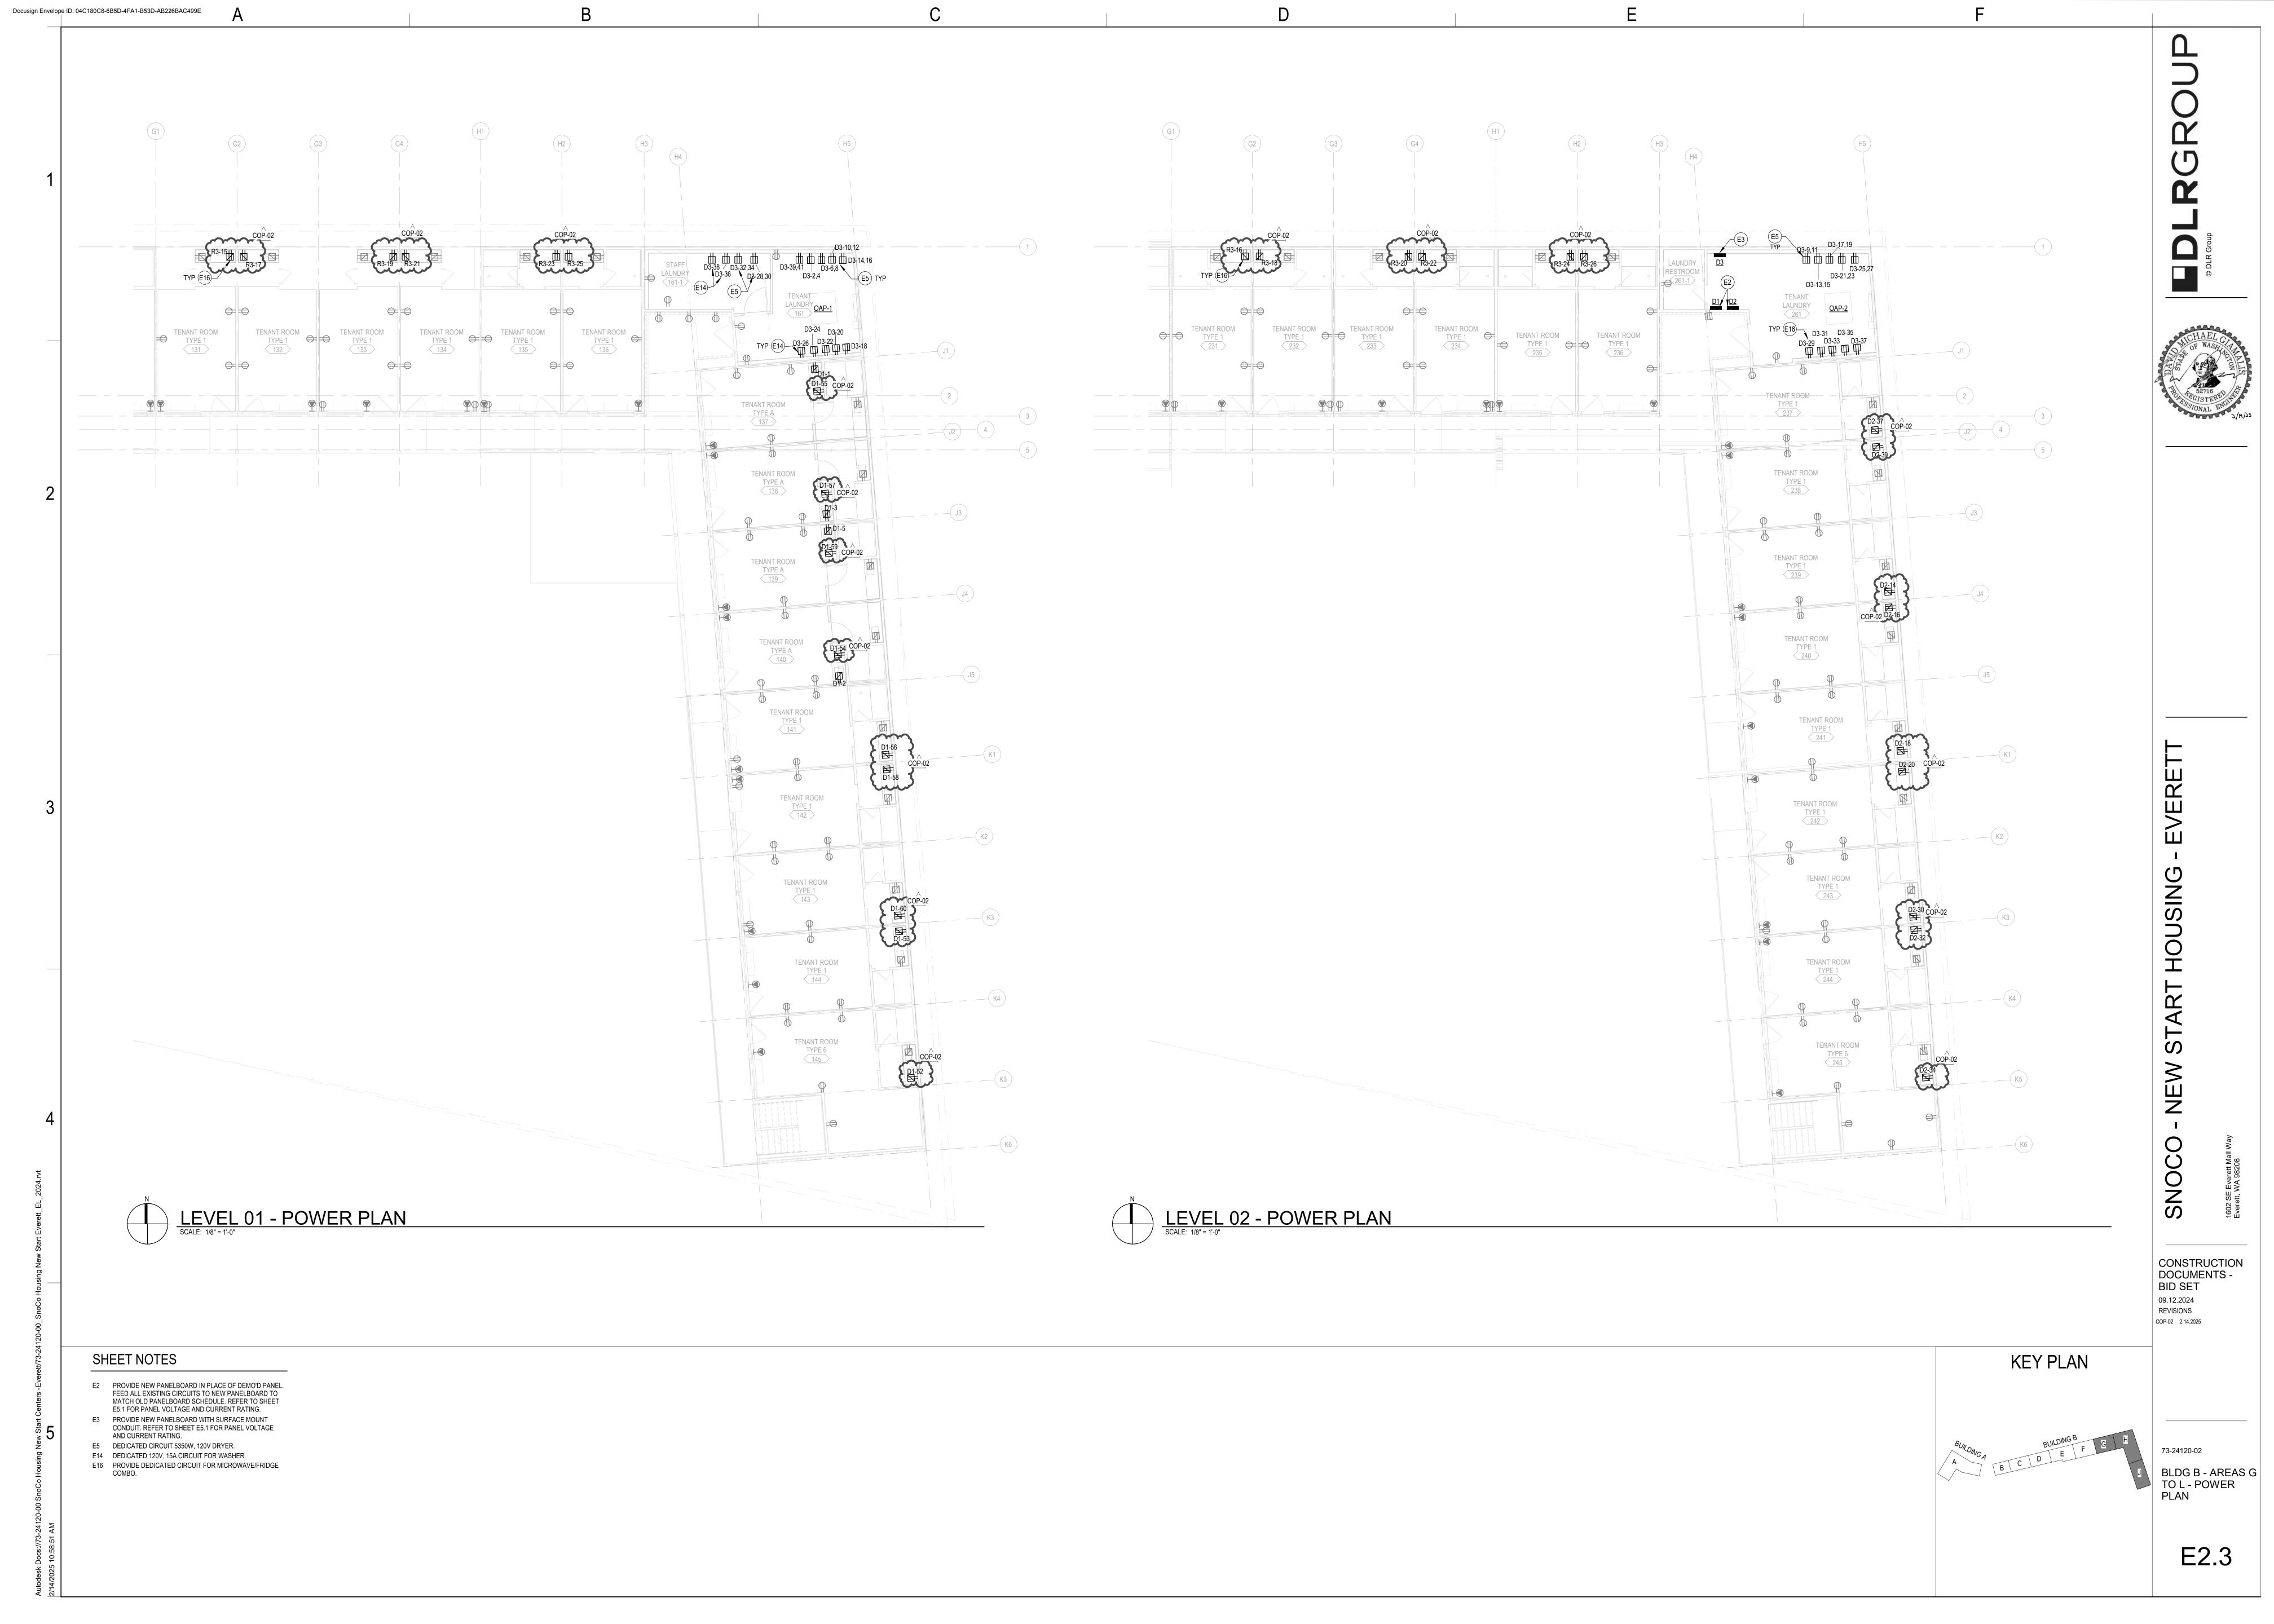


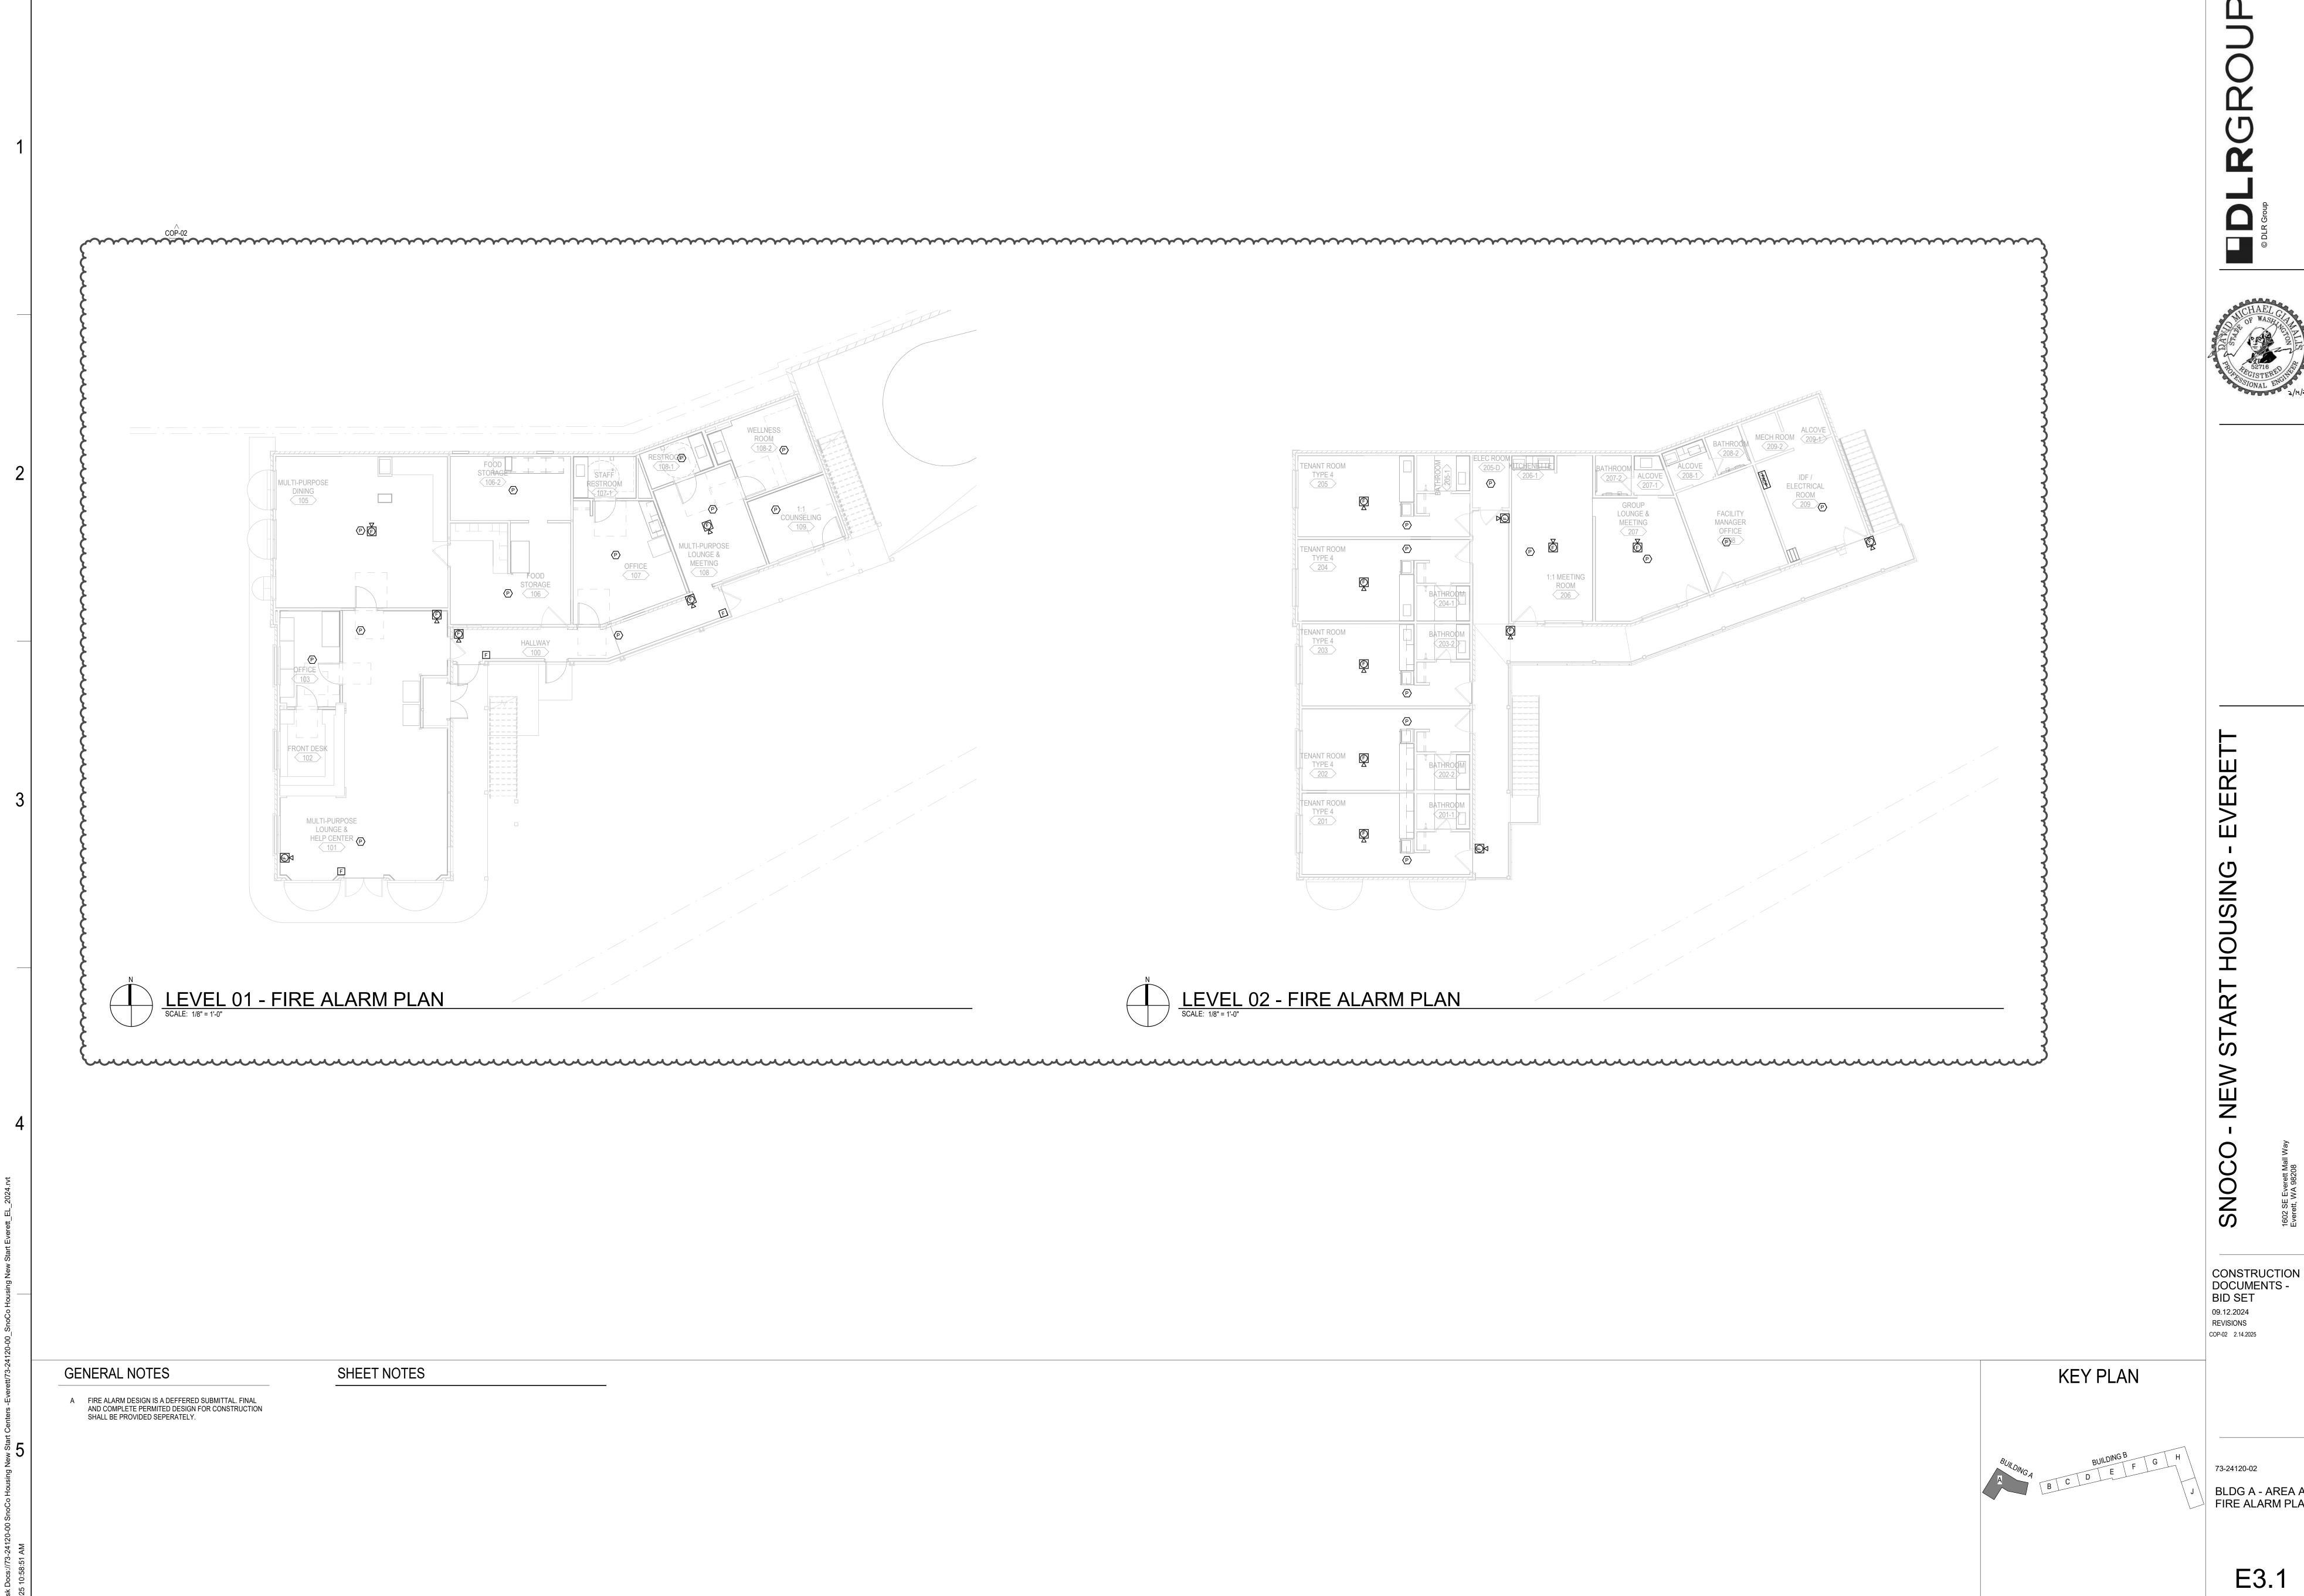

BLDG A - AREA A -FIRE ALARM PLAN

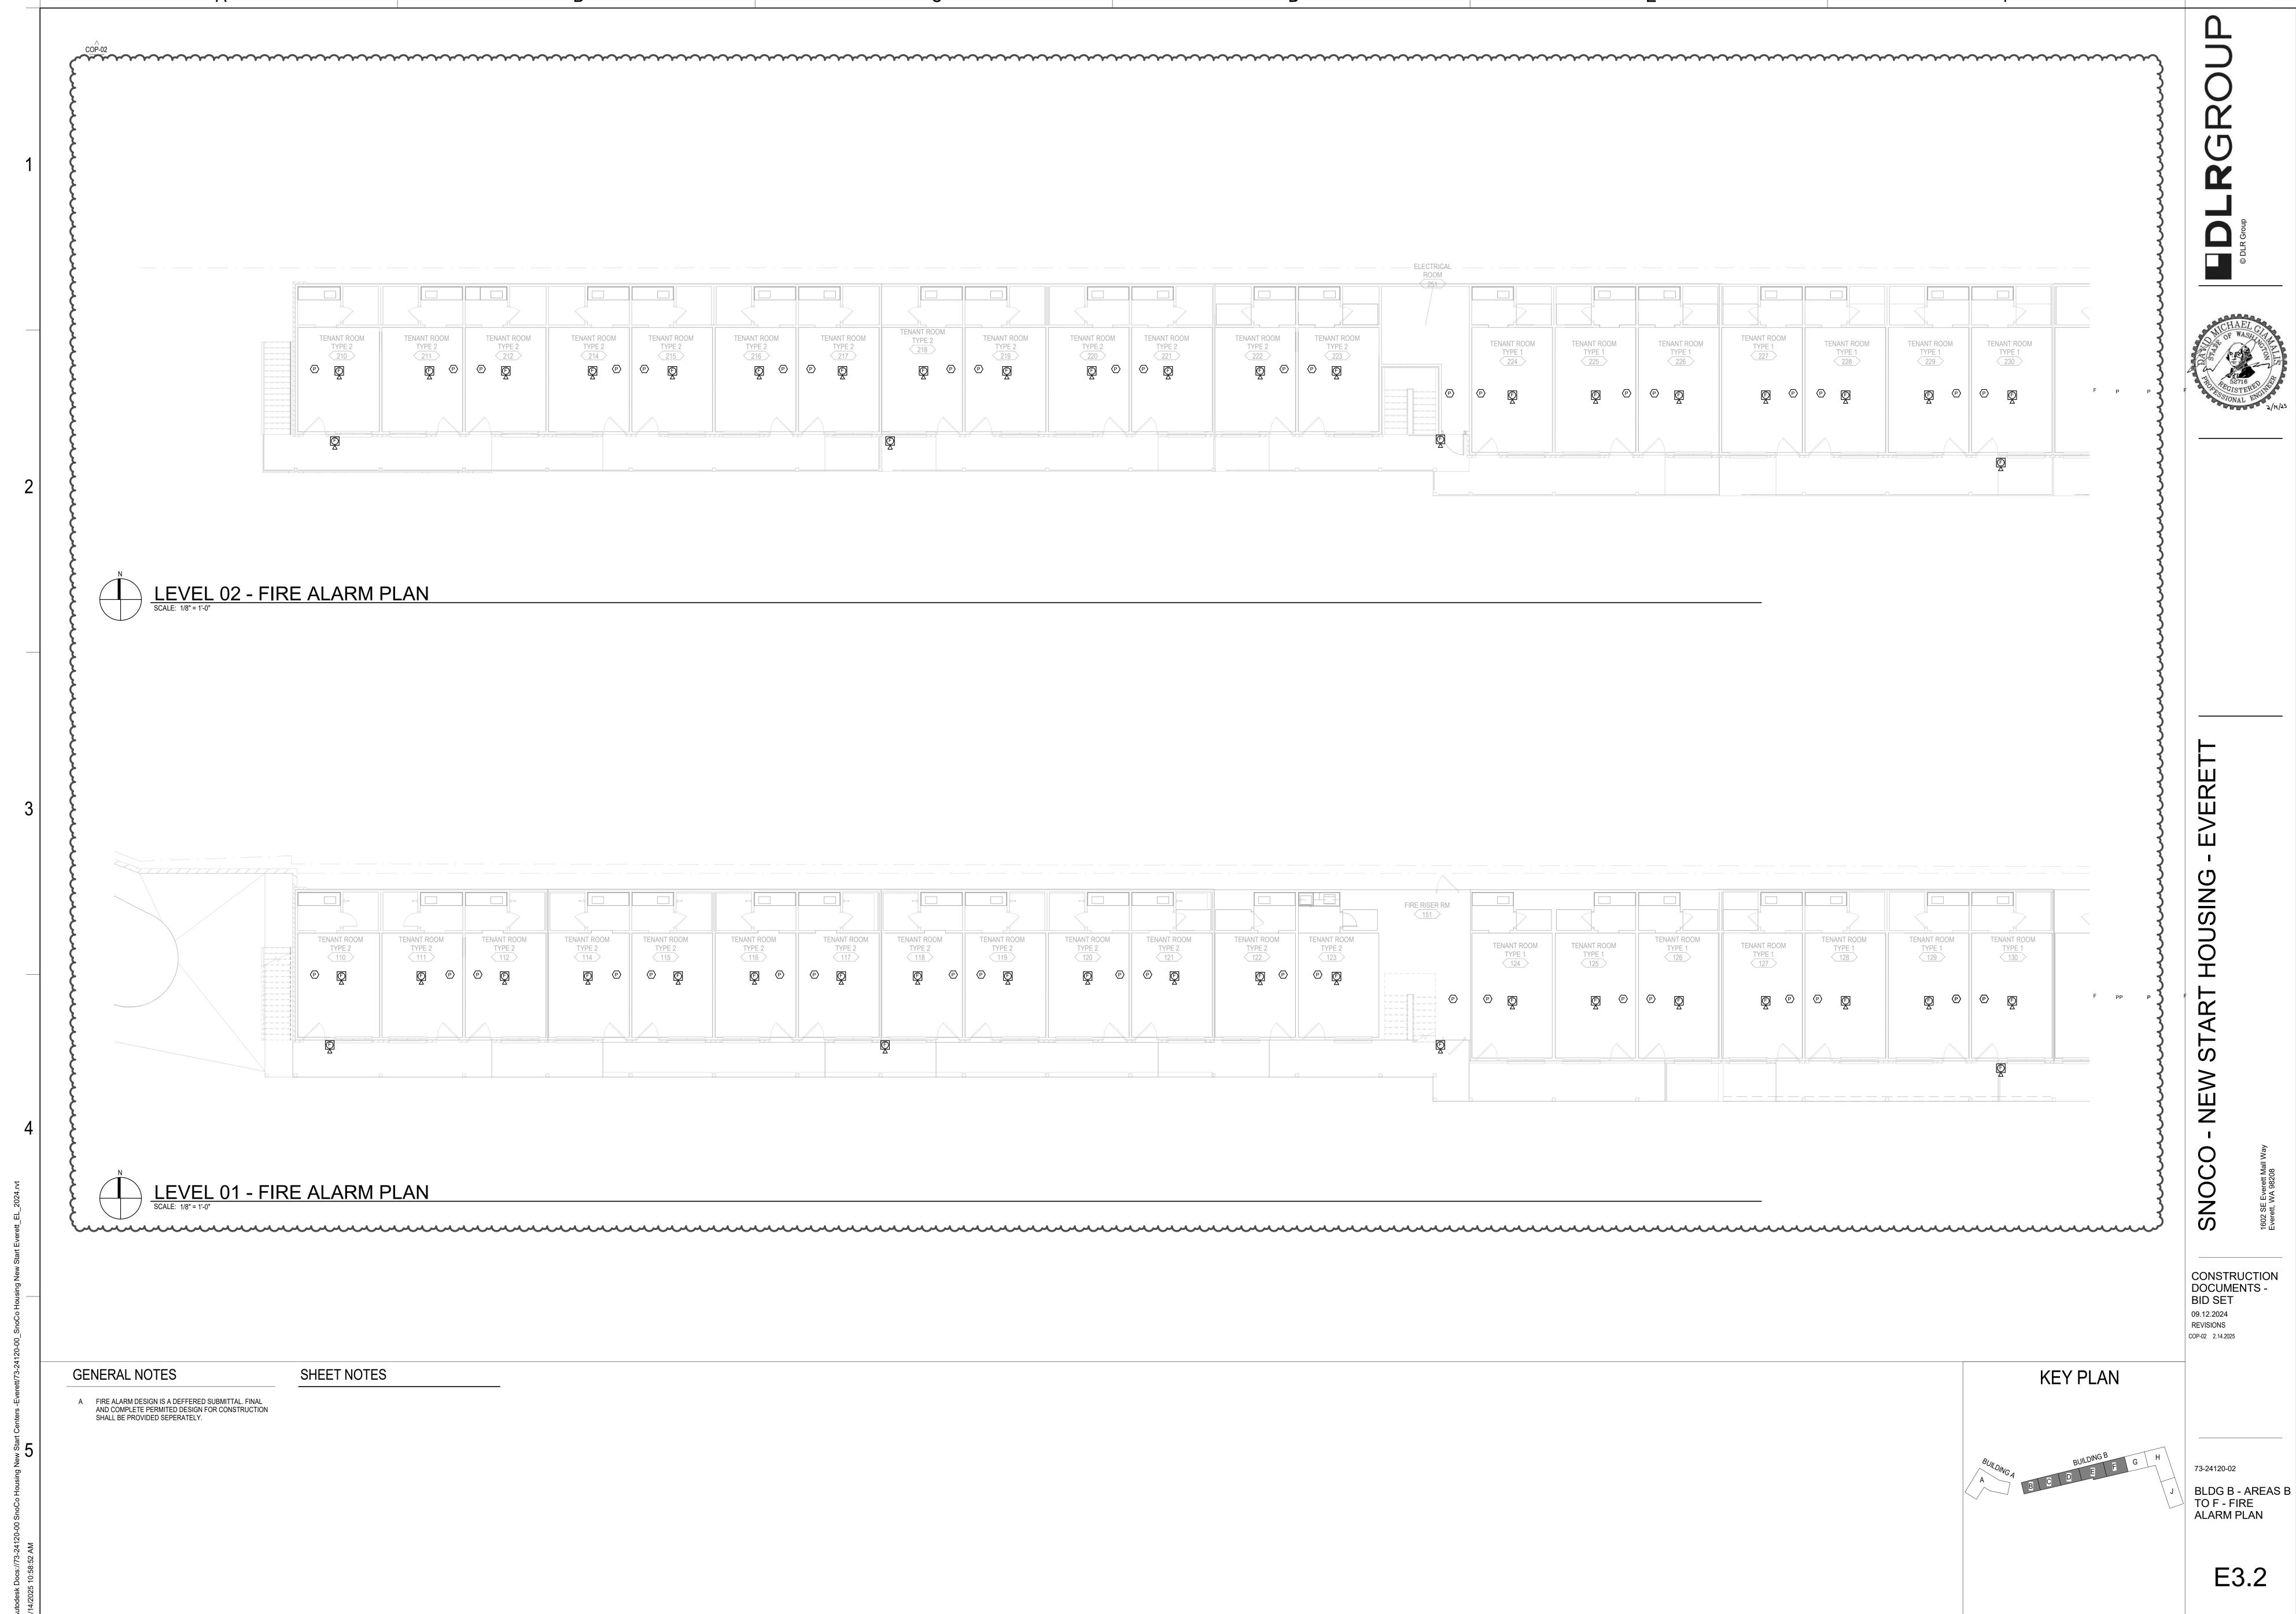

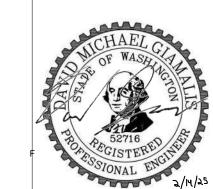

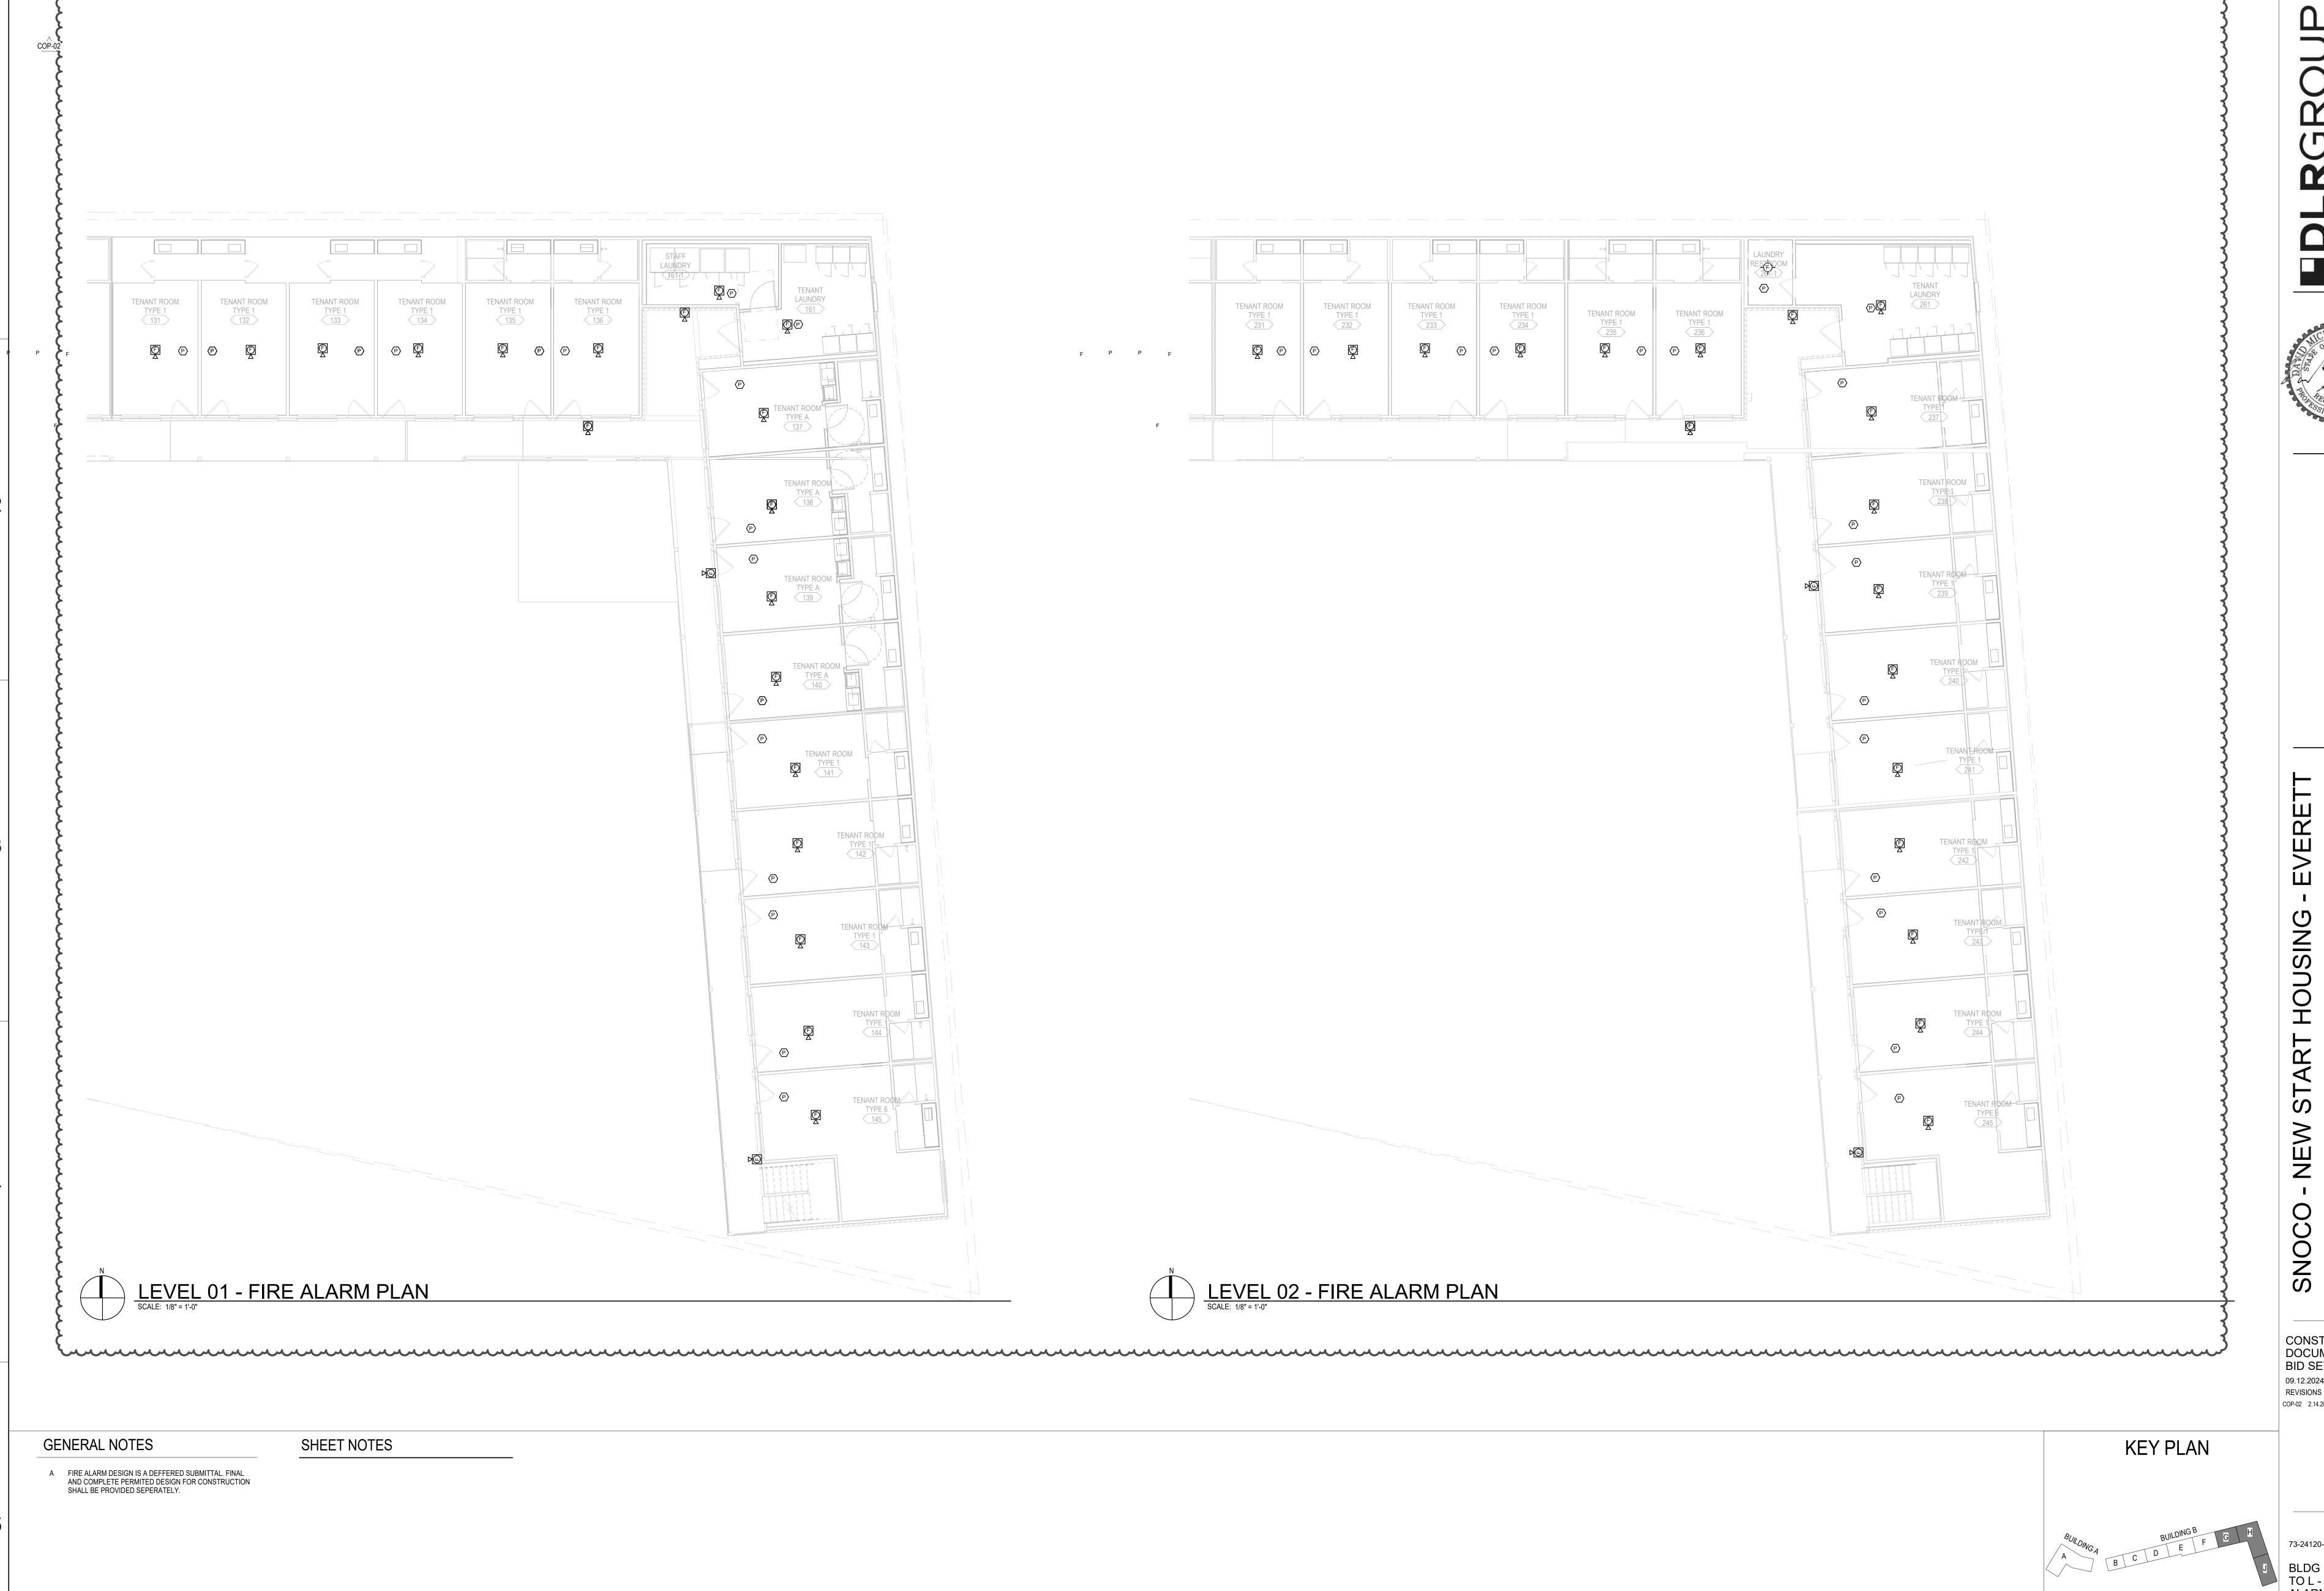


CONSTRUCTION DOCUMENTS -BID SET

09.12.2024 COP-02 2.14.2025

ALARM PLAN

E3.3

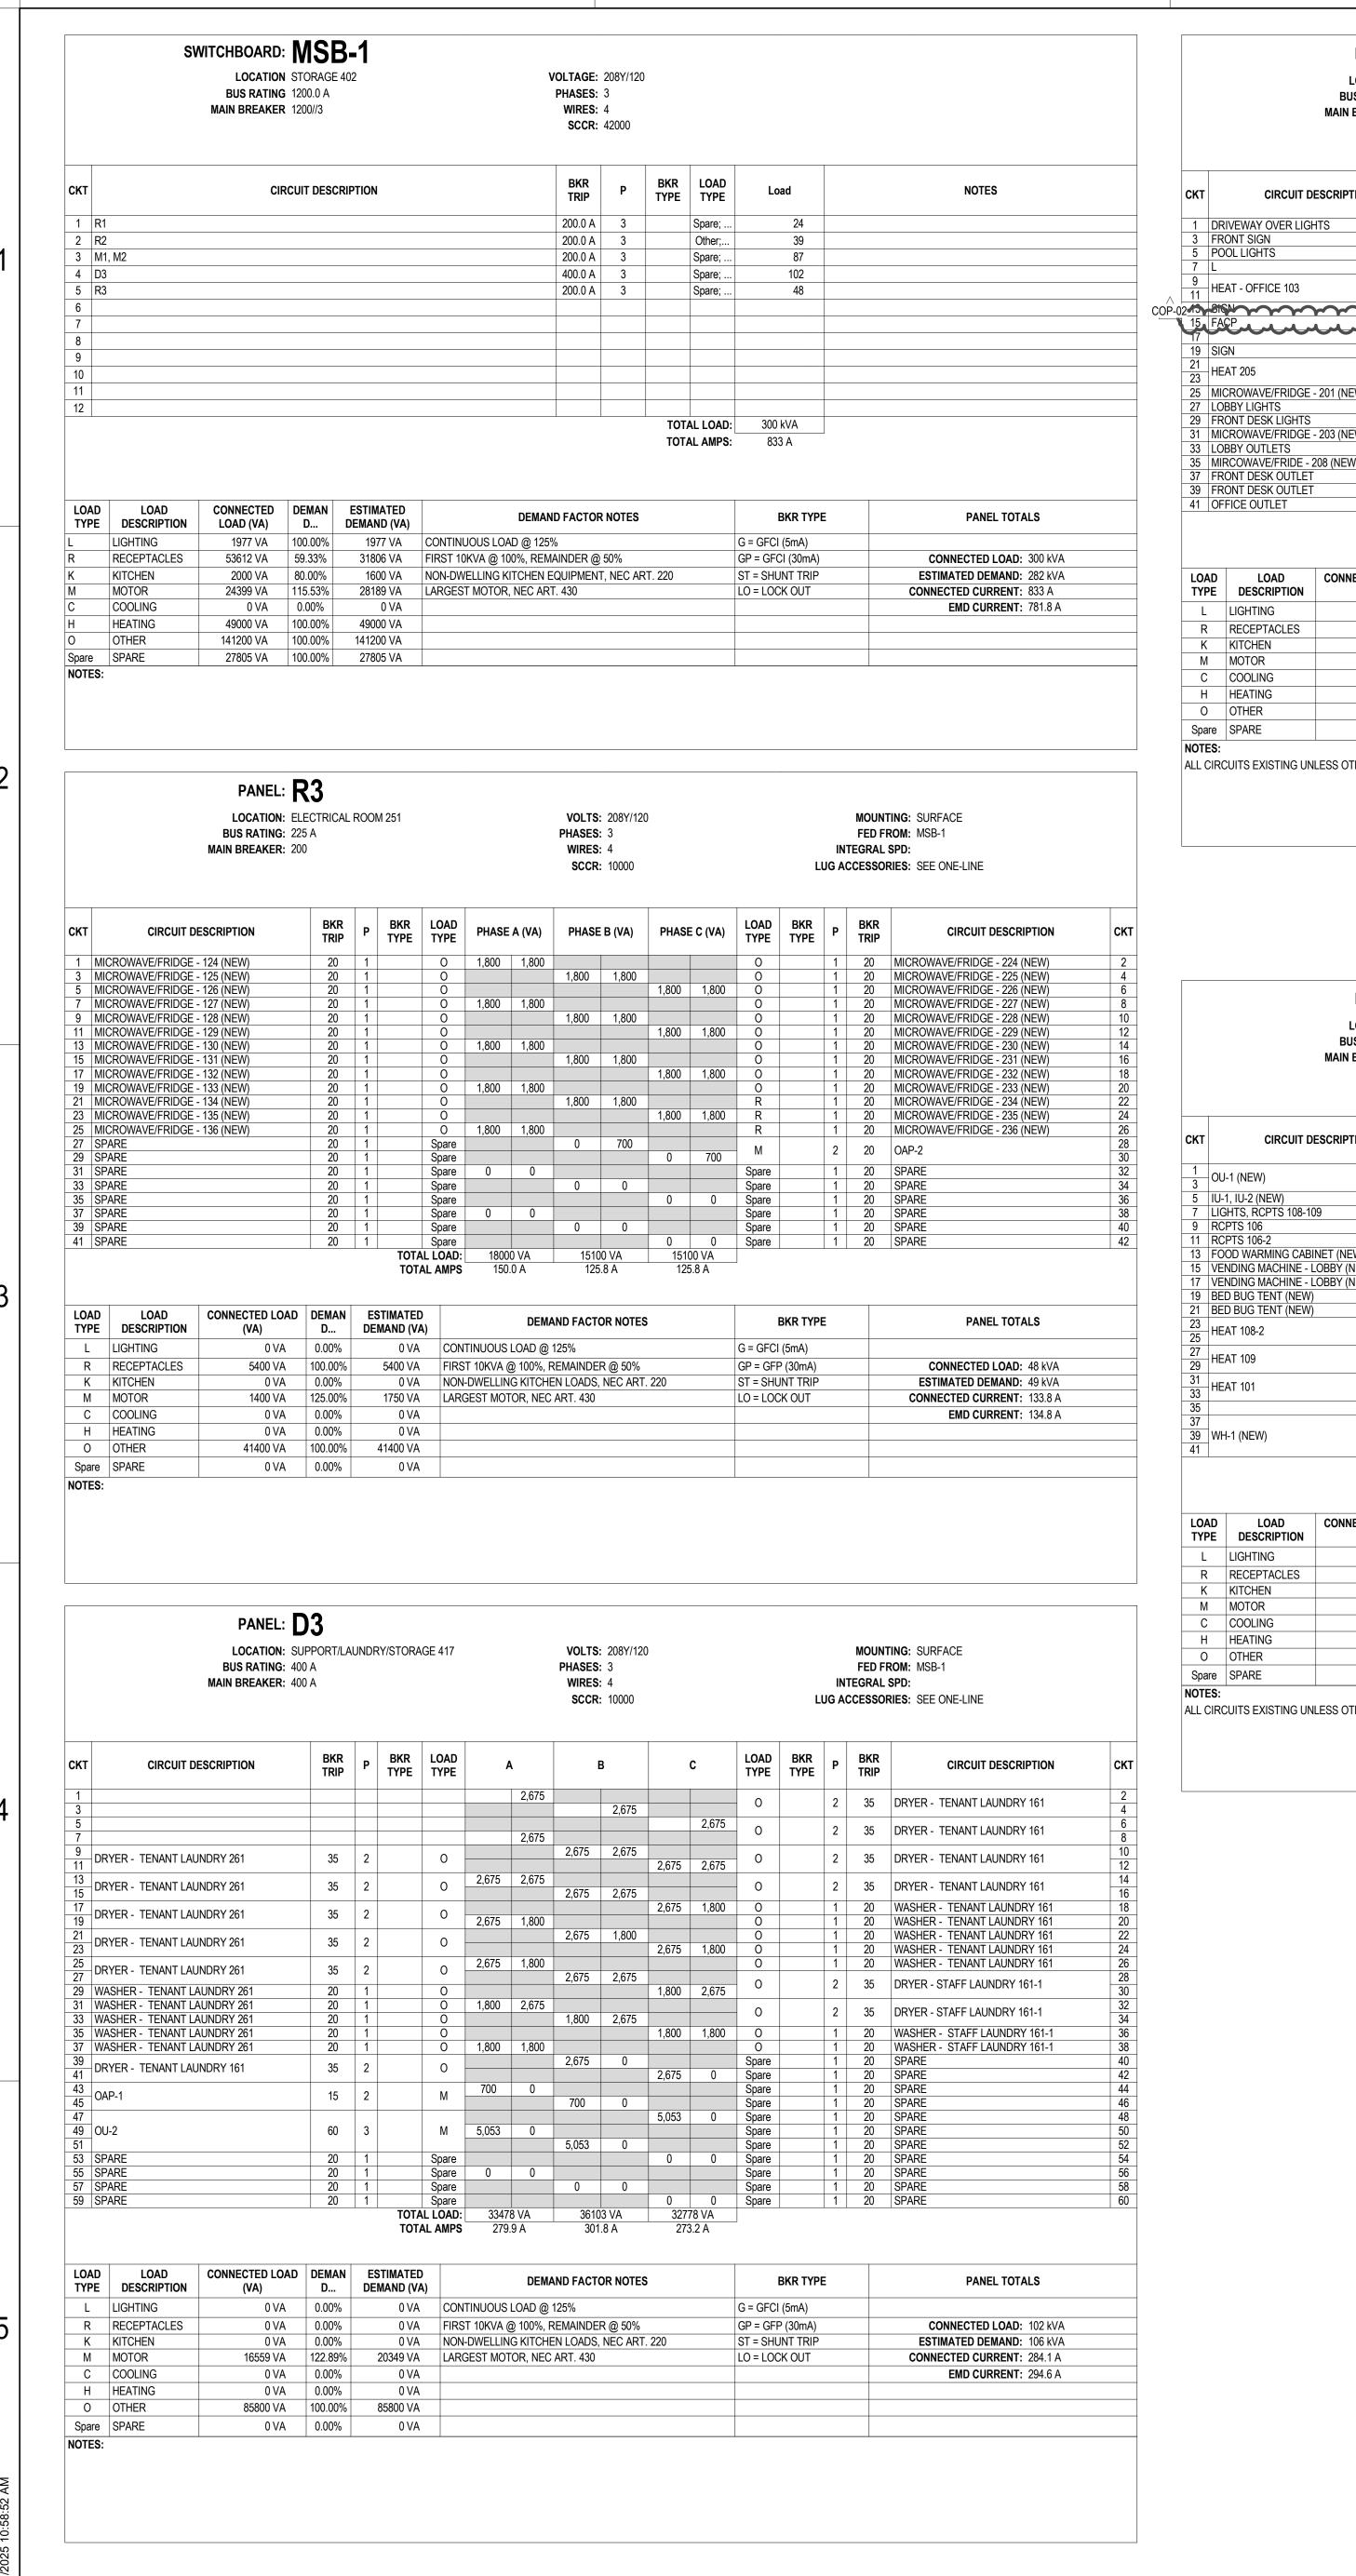

СКТ		PANEL: R1 LOCATION: UNIT TYPE B 209 BUS RATING: 225 A MAIN BREAKER: 200 A							WIRES: SCCR:	: 22000			MOUNTING: SURFACE FED FROM: MSB-1 INTEGRAL SPD: LUG ACCESSORIES: SEE ONE-LINE							
	CIRCUIT DI	ESCRIPTION	BKR TRIP	Р		OAD YPE	PHASE	A (VA)	PHASE	B (VA)	PHASE	C (VA)	LOAD TYPE	BKR TYPE	Р	BKR TRIP	CIRCUIT DESCRIPTION	С		
	EWAY OVER LIGH	ITS	20	1		L	600													
3 FRON			20	1		М			500	240			R		2	20	EUH-1 (NEW)			
	LIGHTS		20	1	S	pare	400	4.000			50	240					,			
7 L			20	1		L	108	1,800	1,750	1,800			O R		1	20	MICROWAVE/FRIDGE - 203 (NEW) MICROWAVE/FRIDGE - 205 (NEW)			
9 11 HEAT -	- OFFICE 103		20	2		Н			1,730	1,000	1,750	1,800	R		1	20 20	MICROWAVE/FRIDGE - 203 (NEW)			
13 SIGN	~~~	~~~~	20	1		L	10	1,800			1,730	1,000	0		1	20	MICROWAVE/FRIDGE - 206 (NEW)			
15 FACP			20	1		M		.,500	300							•	2 2 2 2 2 2 2 2 2 2 2 2 2 2 2 2 2 2 2 2			
17												0	L		1	20	SIGN			
19 SIGN			20	1		L	10													
21 HEAT	205		20	2		н			1,750											
23		004 (NIELAN					4.000				1,750									
	OWAVE/FRIDGE -	- 201 (NEW)	20	1		0	1,800		120											
	Y LIGHTS IT DESK LIGHTS		20 20	1		L			139		43									
	OWAVE/FRIDGE -	- 203 (NFW)	20	1		0	1,800				1 40									
	Y OUTLETS	200 (14211)	20	1		R	1,000		900											
	OWAVE/FRIDE - 2	208 (NEW)	20	1		0					1,800									
	IT DESK OUTLET		20	1		R	360				·									
	IT DESK OUTLET		20	1		R			540											
41 OFFIC	CE OUTLET		20	1		R					180									
LOAD	LOAD	CONNECTED LOAD	DEMAN	E	TOTAL L TOTAL A		8288 69.5	5 A	66.	9 VA 4 A	63	3 VA .4 A		OVE TVE			DANEL TOTAL O			
	DESCRIPTION	(VA)	D		MAND (VA)			DEMA	ND FACTO	OR NOTES	•		ŀ	BKR TYPE	•		PANEL TOTALS			
L LIC	IGHTING	910 VA	100.00%		910 VA	CONT	TINUOUS	LOAD @ 1	25%				G = GFCI	(5mA)						
R RE	ECEPTACLES	6060 VA	100.00%		6060 VA	FIRST	Γ 10KVA @	0 100%, R	EMAINDE	R @ 50%			GP = GFF	(30mA)			CONNECTED LOAD: 24 kVA			
K KI	ITCHEN	0 VA	0.00%		0 VA	NON-	DWELLIN	G KITCHE	N LOADS,	NEC ART.	. 220		ST = SHU	INT TRIP			ESTIMATED DEMAND: 24 kVA			
M MC	IOTOR	800 VA	115.63%		925 VA	LARG	EST MOT	OR, NEC	ART. 430				LO = LOC	K OUT			CONNECTED CURRENT: 66.1 A			
C CC	OOLING	0 VA	0.00%		0 VA												EMD CURRENT: 66.5 A			
	EATING	7000 VA	100.00%		7000 VA															
	THER	9000 VA	100.00%		9000 VA															
	PARE	50 VA	100.00%	+	50 VA															
NOTES:	FAIL	30 VA	100.0076		30 VA															

PANEL: M1 LOCATION: FOOD STORAGE A109 BUS RATING: 225 A MAIN BREAKER: 200 A								VOLTS: PHASES: WIRES: SCCR:	4)		MOUNTING: SURFACE FED FROM: MSB-1 INTEGRAL SPD: LUG ACCESSORIES: SEE ONE-LINE							
кт	CIRCUIT D	ESCRIPTION	BKR TRIP	P BKR TYPE	LOAD TYPE	PHASE	A (VA)	PHASE	B (VA)	PHASE	C (VA)	LOAD TYPE	BKR TYPE	Р	BKR TRIP	CIRCUIT DESCRIPTION	СК		
1 0	L 4 /NICIA/\		40	0		1,914	1,747					M		1	30	ERV-1 (NEW)	2		
)	U-1 (NEW)		40	2	М	·		1,914	827			L; R		1	20	LIGHTS, RCPTS 105	4		
	I-1, IU-2 (NEW)	20	15	1	M	4.000	4.750			66	1,750	Н		2	20	HEAT 105	6		
	GHTS, RCPTS 108-10 CPTS 106	J 9	20	1	L; R R	1,996	1,750	360									8		
	CPTS 106 CPTS 106-2		20	1	L; R			300		371							1:		
	OOD WARMING CABI	NET (NEW)	20	1	R	552				071							1		
5 VE	ENDING MACHINE - L	LOBBÝ (NEW)	20	1	0			1,000									1		
	ENDING MACHINE - L		20	1	0					1,000							1		
	ED BUG TENT (NEW)		20	1	0	1,500	4,923	4.500	4.000					_	00	NAME O (NIFIAD)	2		
2	ED BUG TENT (NEW)		20	1	0			1,500	4,923	1,750	4,923	R		3	60	WH-2 (NEW)	2		
5 HE	EAT 108-2		20	2	Н	1,750	500			1,730	4,323	K		1	20	CIRCUIT FOR KITCHEN EQUIPMENT	2		
7	TAT 400		20		11	1,7 00	000	1,750	0			Spare		1	20	SPARE	2		
9 7	EAT 109		20	2	Н					1,750	500	K		1	20	CIRCUIT FOR KITCHEN EQUIPMENT	30		
1 HF	EAT 101		20	2	Н	1,750	0					Spare		1	20	SPARE	32		
ა				_				1,750	500		0	K		1	20 20	CIRCUIT FOR KITCHEN EQUIPMENT SPARE	34		
5 7						4,923	500				0	Spare K		1	20	CIRCUIT FOR KITCHEN EQUIPMENT	38		
	H-1 (NEW)		60	3	R	1,020	000	4,923	0			Spare		1	20	SPARE	40		
1	,							,		4,923	0	Spare		1	20	SPARE	4:		
OAD YPE	LOAD DESCRIPTION	CONNECTED LOAD (VA)	DEMAN D				5 A	1944 165. AND FACTO	2 A	141	33 VA .9 A	ı	BKR TYPE			PANEL TOTALS			
L	LIGHTING	313 VA	100.00%	313 VA	CON	NTINUOUS	LOAD @	125%				G = GFCI	(5mA)						
R	RECEPTACLES	33332 VA	65.00%	21666 VA		ST 10KVA @			R @ 50%			GP = GFF	· · ·			CONNECTED LOAD: 60 kVA			
K	KITCHEN	2000 VA	80.00%	1600 VA		N-DWELLIN				220		ST = SHL	, ,			ESTIMATED DEMAND: 49 kVA			
М	MOTOR	5640 VA	116.96%	6597 VA		RGEST MOT						LO = LOC				CONNECTED CURRENT: 167.3 A			
С	COOLING	0 VA	0.00%	0 VA												EMD CURRENT: 136.5 A			
Н	HEATING	14000 VA	100.00%	14000 VA															
0	OTHER	5000 VA	100.00%	5000 VA															
	+	0 VA	0.00%	0 VA															
Spare		1		· · / ·	1							1							

		PANEL: N															
		LOCATION: FOO BUS RATING: 100 MAIN BREAKER: 100) A	AGE A	109				PHASES WIRES)				FED F NTEGRAL	ITING: FLUSH FROM: MSB-1 SPD: ORIES: SEE ONE-LINE	
СКТ	CIRCUIT D	ESCRIPTION	BKR TRIP	Р		LOAD TYPE	PHASE	A (VA)	PHASE	E B (VA)	PHASE	E C (VA)	LOAD TYPE	BKR TYPE P	BKR TRIP	CIRCUIT DESCRIPTION	СКТ
	EXISTING LOAD		20	1		Spare	1,920	1,920					Spare	1		EXISTING LOAD	2
	EXISTING LOAD		20	1		Spare			1,920	1,920	4.000	4.000	Spare	1		EXISTING LOAD	4
	EXISTING LOAD EXISTING LOAD		20	1		Spare Spare	1,920	1,920			1,920	1,920	Spare Spare	1		EXISTING LOAD EXISTING LOAD	6 8
	EXISTING LOAD		20	1		Spare	1,320	1,320	1,920	1,920			Spare	1		EXISTING LOAD EXISTING LOAD	10
11	EXISTING LOAD		20	1		Spare			,	.,	1,920	1,920	Spare	1	20	EXISTING LOAD	12
	EXISTING LOAD		20	1		Spare	1,920	0	4.000				Spare	1		SPARE	14
	EXISTING LOAD SPARE		20 20	1		Spare			1,920	0	0	0	Spare	1		SPARE SPARE	16 18
	SPARE SPARE		20	1		Spare Spare	0	0			U	U	Spare Spare	1		SPARE	20
21	SPARE		20	1		Spare			0	0			Spare	1	20	SPARE	22
23	SPARE		20	1		Spare					0	0	Spare	1		SPARE	24
	SPARE		20	1		Spare	0	0	0	0			Spare	1		SPARE	26 28
	SPARE SPARE		20	1		Spare Spare			U	0	0	0	Spare Spare	1		SPARE SPARE	30
	SPARE		20	1		Spare	0	0					Spare	1		SPARE	32
33	SPARE		20	1		Spare			0	0			Spare	1	20	SPARE	34
	SPARE		20	1		Spare	^	0			0	0	Spare	1		SPARE	36
	SPARE SPARE		20	1		Spare Spare	0	0	0	0			Spare Spare	1		SPARE SPARE	38 40
	SPARE		20	1		Spare					0	0	Spare	1		SPARE	42
					TOTAL TOTAL		9600 82.5			0 VA .5 A		0 VA .0 A					
LOA TYP		CONNECTED LOAD (VA)	DEMAN D		STIMATED MAND (VA)			DEMA	AND FACT	OR NOTES	;		I	BKR TYPE		PANEL TOTALS	
L	LIGHTING	0 VA	0.00%		0 VA		INUOUS						G = GFCI	* *			
R	RECEPTACLES	0 VA	0.00%		0 VA				REMAINDE				GP = GFF			CONNECTED LOAD: 27 kVA	
K	KITCHEN	0 VA	0.00%		0 VA	_			EN LOADS,	, NEC ART	220		ST = SHL			ESTIMATED DEMAND: 27 kVA	
М	MOTOR	0 VA	0.00%		0 VA	LARG	EST MOT	OR, NEC	ART. 430				LO = LOC	K OUT		CONNECTED CURRENT: 74.6 A	
С	COOLING	0 VA	0.00%		0 VA											EMD CURRENT: 74.6 A	
Н	HEATING	0 VA	0.00%		0 VA												
0	OTHER	0 VA	0.00%		0 VA												
		2000 ///	100 000/														

VOLTS: 208Y/120

SCCR: 35000

PHASE A (VA) PHASE B (VA) PHASE C (VA) LOAD BKR TYPE P BKR TRIP

PHASES: 3

WIRES: 4

DEMAND FACTOR NOTES

MOUNTING: SURFACE

FED FROM: MSB-1

LUG ACCESSORIES: SEE ONE-LINE

LIGHTS, RCPTS 206

LIGHTS, RCPTS 207

OUTSIDE LIGHTS

20 LIGHTS, RCPTS 107,107-

20 LIGHTS, RCPTS 209

20 LIGHTS, RCPTS 208

CIRCUIT DESCRIPTION

PANEL TOTALS

EMD CURRENT: 106.9 A

CONNECTED LOAD: 39 kVA

ESTIMATED DEMAND: 39 kVA

CONNECTED CURRENT: 106.9 A

LIGHTS, RCPTS MEETING LOUNGE 204-3

LIGHTS, RCPTS 204, 204-1, 204-2, 204-4

INTEGRAL SPD:

1 20 SPARE 1 20 SPARE

2 20 HEAT 108

2 20 HEAT 207

2 20 HEAT 203

2 20 HEAT 204

2 20 HEAT 205

BKR TYPE

G = GFCI (5mA)

GP = GFP (30mA)

ST = SHUNT TRIP

LO = LOCK OUT

PANEL: **R2**

BUS RATING: 225 A

MAIN BREAKER: 200 A

CIRCUIT DESCRIPTION

3 LIGHTS, RCPTS 202 5 LIGHTS, RCPTS 203

MAIN OFFICE HEAT

13 PHONE ROOM

HEAT 206

DRYER 208

HEAT 209

HEAT 202

HEAT 201

TYPE DESCRIPTION

LIGHTING

R RECEPTACLES

K KITCHEN

M MOTOR

C COOLING

H HEATING
O OTHER

Spare SPARE

Spare SPARE

NOTES:

15 SPARE

17 SPARE

LOCATION: STORAGE 402

CONNECTED LOAD | DEMAN | ESTIMATED

0 VA 0.00%

0 VA 0.00%

0.00%

ALL CIRCUITS EXISTING UNLESS OTHERWISE INDICATED BY (NEW)

28000 VA 100.00% 28000 VA

875 VA 100.00% 875 VA

26880 VA | 100.00% | 26880 VA

D... DEMAND (VA)

754 VA | 100.00% | 754 VA | CONTINUOUS LOAD @ 125%

0 VA

0 VA


8820 VA 100.00% 8820 VA FIRST 10KVA @ 100%, REMAINDER @ 50%

0 VA 0.00% 0 VA NON-DWELLING KITCHEN LOADS, NEC ART. 220

0 VA LARGEST MOTOR, NEC ART, 430

BKR LOAD TYPE TYPE



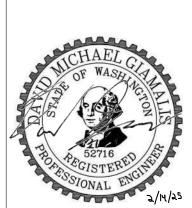

SNOCO - NEW START HOUSING - EVER

CONSTRUCTION
DOCUMENTS BID SET

09.12.2024
REVISIONS

COP-01 1.29.2025 CO PROPOSAL-01
COP-02 2.14.2025

73-24120-02

ELECTRICAL
SCHEDULES

E7.2