

CHANGE ORDER

<input checked="" type="checkbox"/> ORDERED BY ENGINEER UNDER SECTION 1-04.4 OF THE STANDARD SPECIFICATIONS. <input type="checkbox"/> CHANGE PROPOSED BY CONTRACTOR	PROJECT IDENTIFICATION PROJECT NAME: Southwest Recycling and Transfer Station (SWRTS) Tipping Floor Resurfacing PROJECT NUMBER: PW-23-006SB
CONTRACTOR ENDORSEMENT: <hr/> <p style="text-align: center;"><i>SIGNATURE</i> <i>DATE</i></p> <hr/> <p style="text-align: center;"><i>TITLE</i></p>	CONTRACTOR: Concrete Restoration, Inc. ADDRESS: 9587 8 th Ave South Seattle, WA 98108

In consideration of Section 1-04.4 of the Standard Specification, make the following revisions to the contract:

Description

This Change Order compensates the Contractor for additional Work to grind the existing concrete tipping floor as shown on the revised SWRTS TIPPING FLOOR RESURFACING Plan Sheet 3 OF 3.

Add new item #1 "Additional Grinding" in the amount of one (1) lump sum amount.

Measurement and Payment

Item #1, "Additional Grinding", shall be paid at the mutually agreed lump sum price of \$14,578.00 and shall be full compensation for all costs associated with the added Work including grinding, debris removal and disposal.

Contract Time

No working days will be added to the Contract Time because of this Change Order.

ORIGINAL CONTRACT AMOUNT	CURRENT CONTRACT AMOUNT	ESTIMATED NET CHANGE THIS ORDER	ESTIMATED CONTRACT TOTAL AFTER CHANGE
\$1,421,388.69	\$1,421,388.69	\$16,108.69	\$1,437,497.38
OTHER APPROVAL RECOMMENDED		OTHER APPROVAL RECOMMENDED	
<i>SIGNATURE / REPRESENTING</i>	<i>DATE</i>	<i>SIGNATURE / REPRESENTING</i>	<i>DATE</i>
APPROVAL RECOMMENDED		APPROVED	
<i>SOLID WASTE DIRECTOR</i>	<i>DATE</i>	<i>PUBLIC WORKS DIRECTOR OR COUNTY ENGINEER</i>	<i>DATE</i>

GENERAL NOTES:


- AREA 'A', SCARIFY TO 6" DEPTH BELOW FINISHED FLOOR SURFACE, OR TO TOP OF #8 REINFORCEMENT MAT, WHICHEVER IS LESS. PLACE #3 BARS @ 12" ON CENTER RUNNING EAST-WEST WITH 2" OF COVER FROM FINISHED FLOOR SURFACE.
- AREA 'A', REPAIR #8 REINFORCEMENT AS NECESSARY.

LEGEND:

 RESURFACING AREA




 AREA 'A'

CJ  EXISTING CONSTRUCTION JOINT

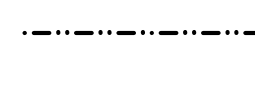 DOUBLE ROW DRILLED HEADED STUD ANCHORS

ABBREVIATION:

TYP TYPICAL

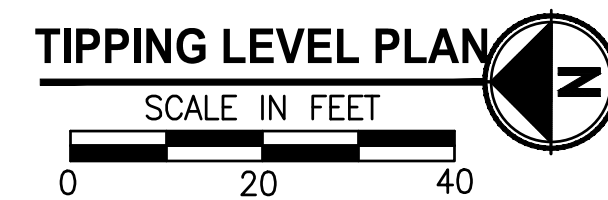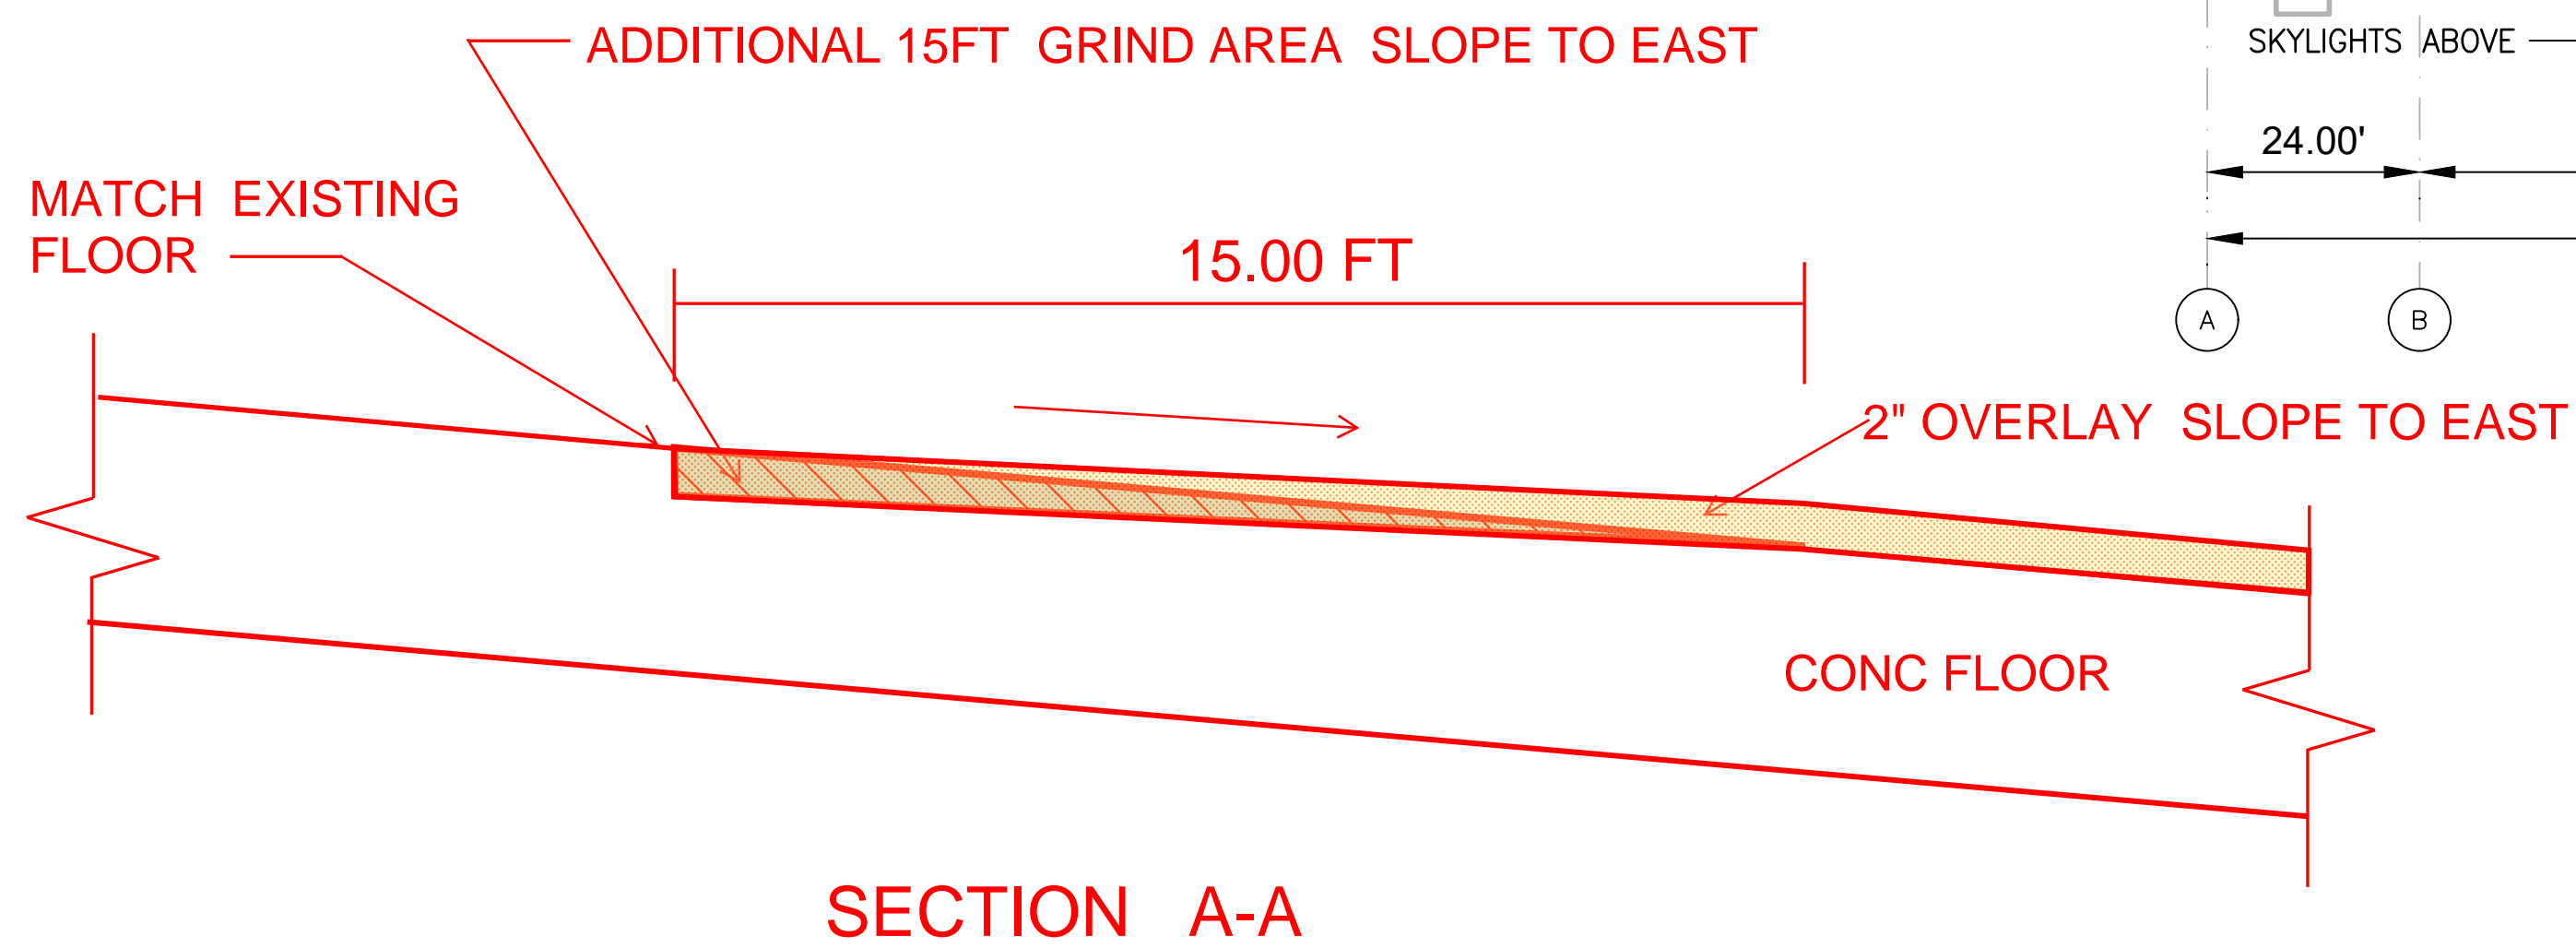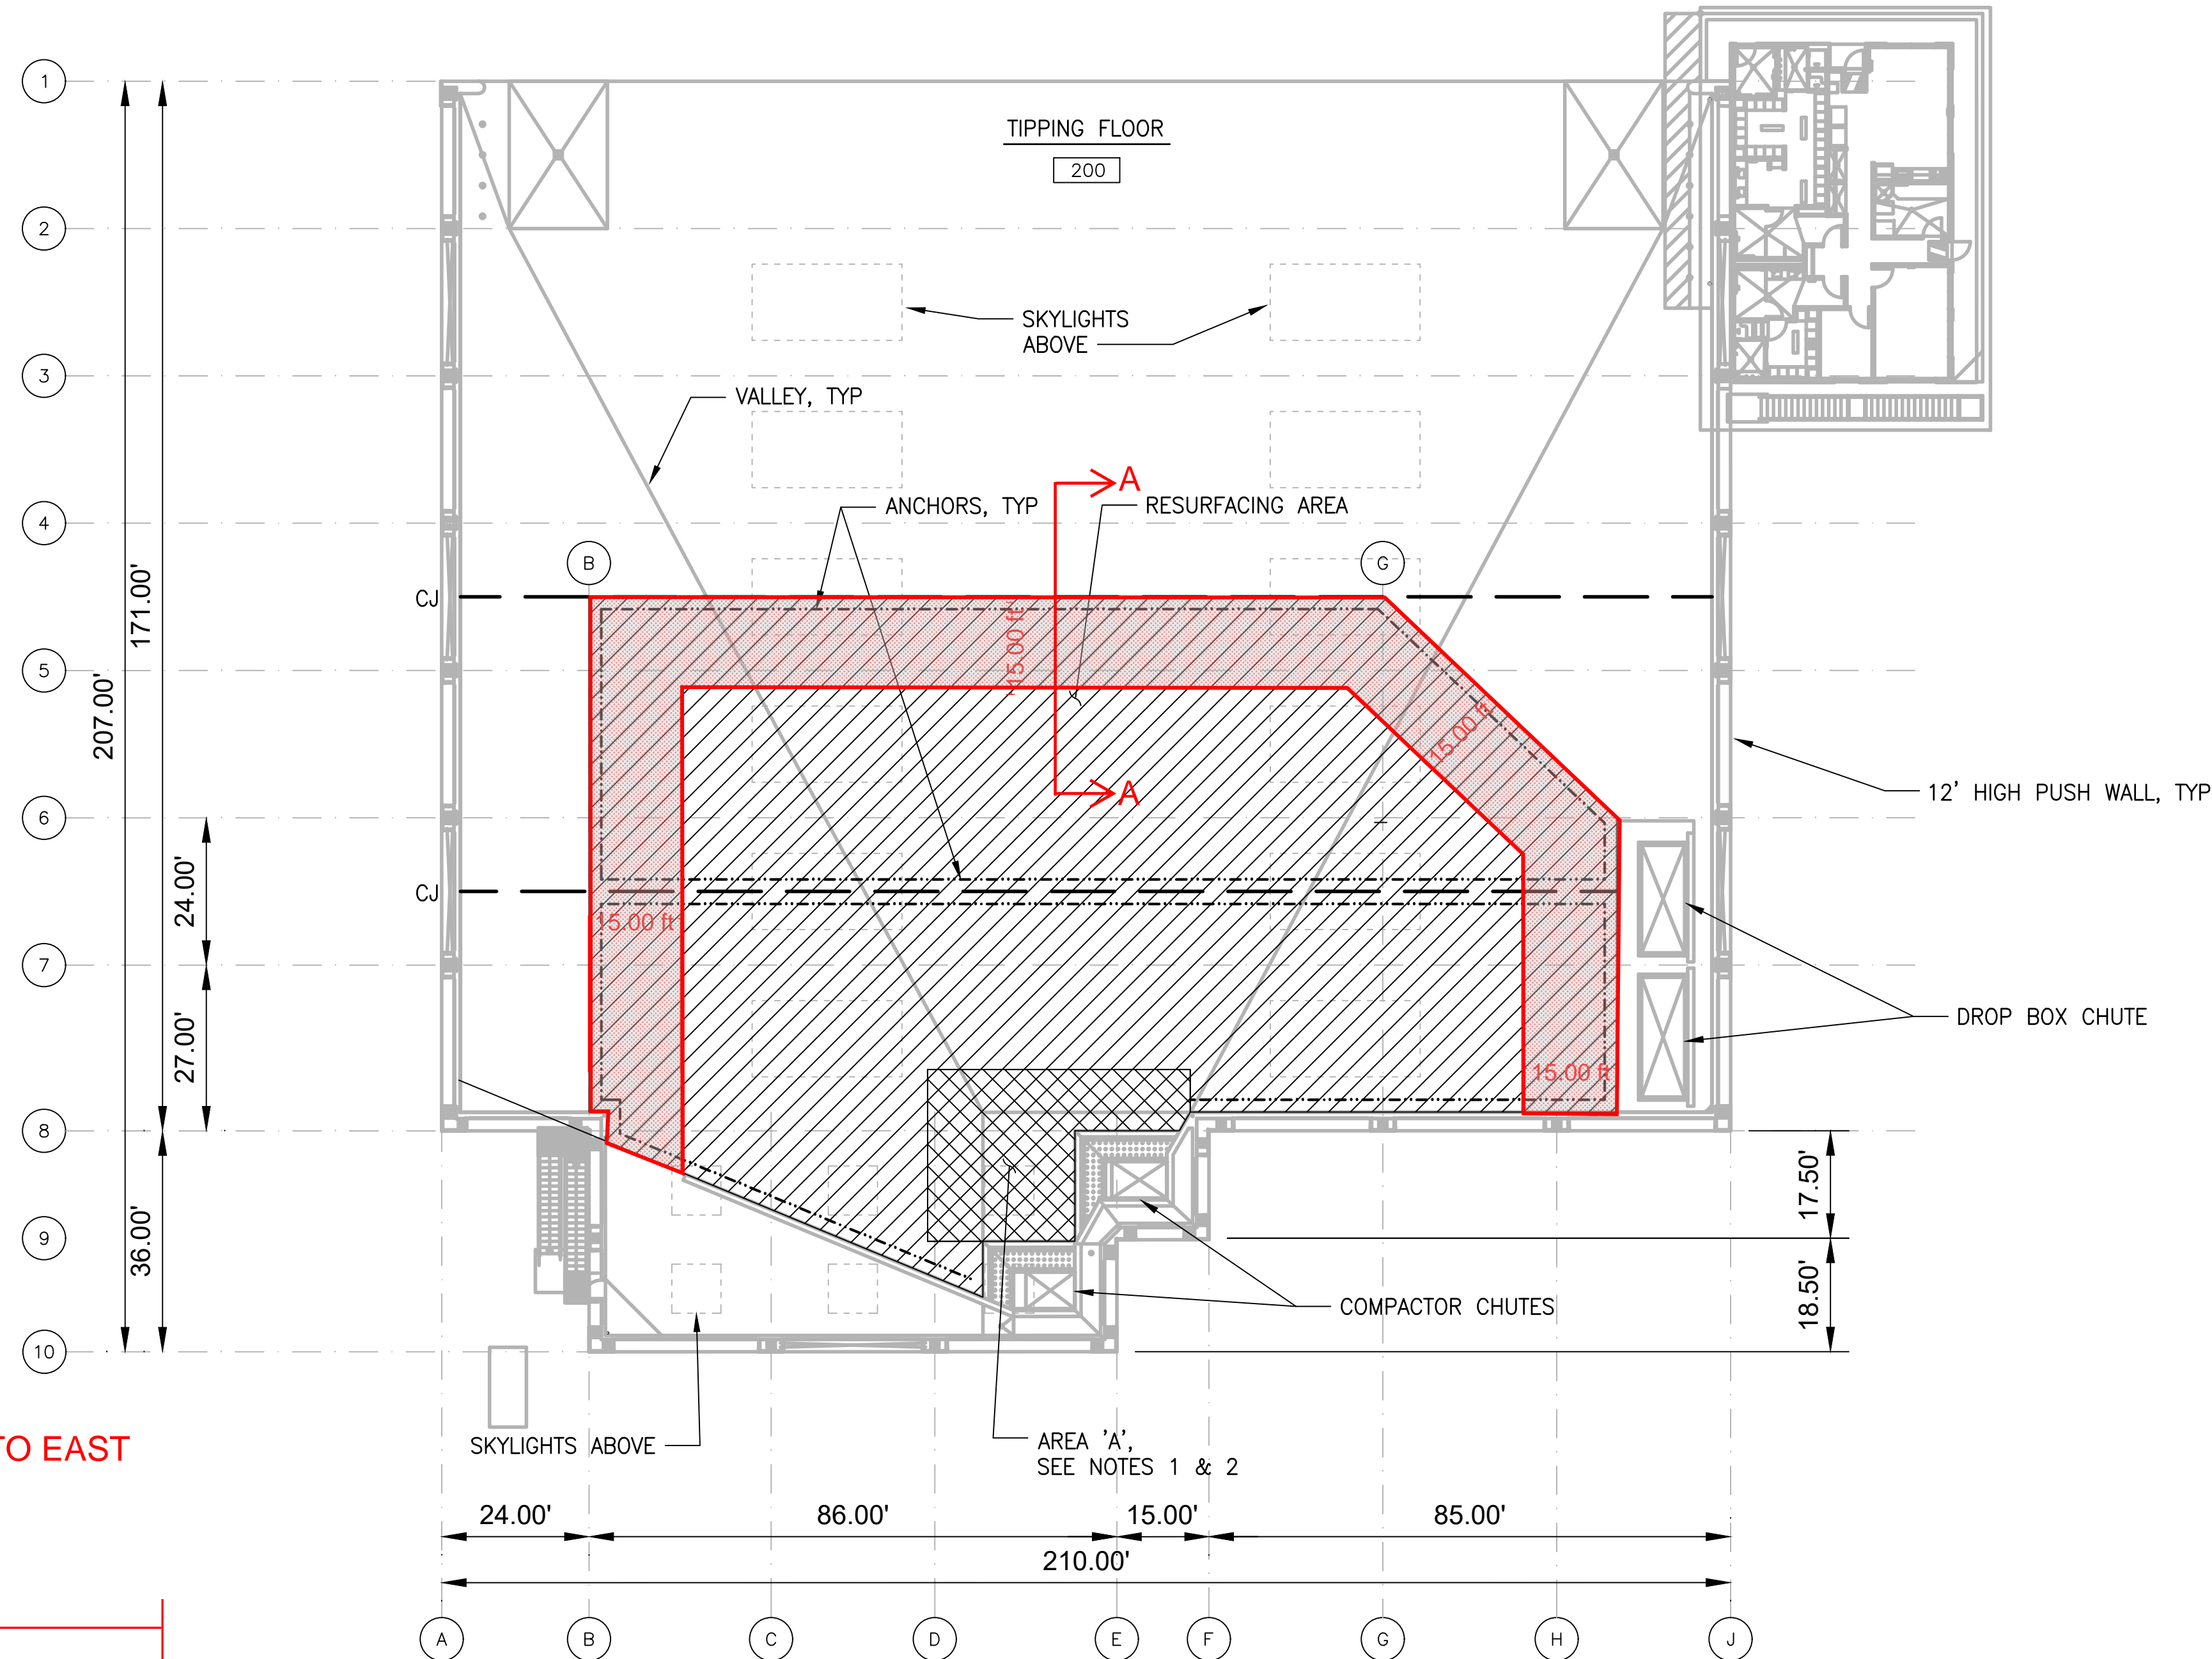

SWRTS TIPPING FLOOR
CO #1 ADDITIONAL GRINDING
G. HARRIS
AB PLAN

PLAN CHECK I. SUTTON	BY	DATE 12/13/22	1/6/23	0	ISSUED FOR BID	KH	CP	REGION NO. 10	STATE WASH.	FED. AID PROJ. NO. AID#	SHEET NO. AIDSHT#	 ENGINEERING . PLANNING . ENVIRONMENTAL SCIENCES 719 2ND AVENUE, SUITE 200 SEATTLE, WA 98104 P 206.394.3700 WWW.PARAMETRIX.COM	 K. HUFNAGEL STATE OF WASHINGTON 21895 REGISTERED PROFESSIONAL ENGINEER SNOHOMISH COUNTY ENGINEER	SNOHOMISH COUNTY DEPARTMENT OF PUBLIC WORKS PROJECT NO. _____	SOLID WASTE MANAGEMENT DIVISION SWRTS TIPPING FLOOR RESURFACING TRANSFER BUILDING TIPPING FLOOR RESURFACING PLAN	SURVEY NO. XXX G3 SHEET 3 OF 3 SHEETS
					Change Order #1 9/9/24 Page 2 of 2			DESIGNED BY: K. HUFNAGEL	DRAWN BY: C. PHANG	FIELD BOOK(S):		BAR IS ONE INCH ON ORIGINAL DRAWING 0 1" IF NOT ONE INCH SCALE ACCORDINGLY	DATE APPROVED:			
DATE	NO.	REVISION			BY											