
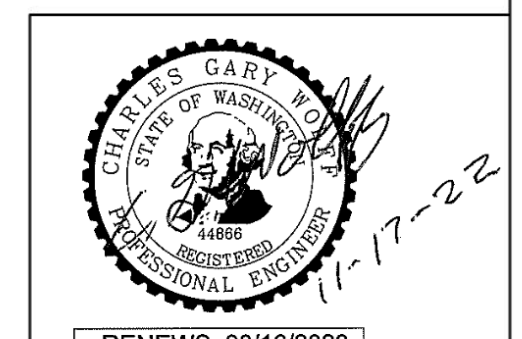
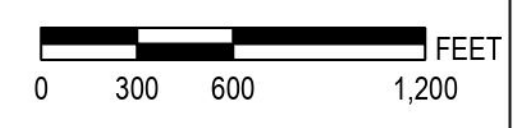


SMITH ISLAND FLOODPLAIN MAP REVISION
MAP 5 - AS-BUILT CONDITIONS

LEGEND

- FIRM Boundaries
- Taxlots
- Rivers & Streams
- Base Flood Elevation (As-Built)
- Project Boundary
- Density Fringe Area (As-Built)
- 1% Annual Chance Floodplain (As-Built)
- 0.2% Annual Chance Floodplain (As-Built)
- Levee (As-Built)
- Cross Sections (As-Built)
- Revision Boundaries (As-Built)
- ~ Base Flood Elevation (As-Built)
- 1% Annual Chance Floodplain (Effective FIS)
- 0.2% Annual Chance Floodplain (Effective FIS)
- Floodway (Effective FIS)
- Density Fringe Area (Effective FIS)
- Coastal Floodplain (Effective FIS)
- Combined Riverine and Coastal Flooding (Effective FIS)
- Levee (Effective)
- Cross Section (Effective)
- ~ Base Flood Elevation (Effective)

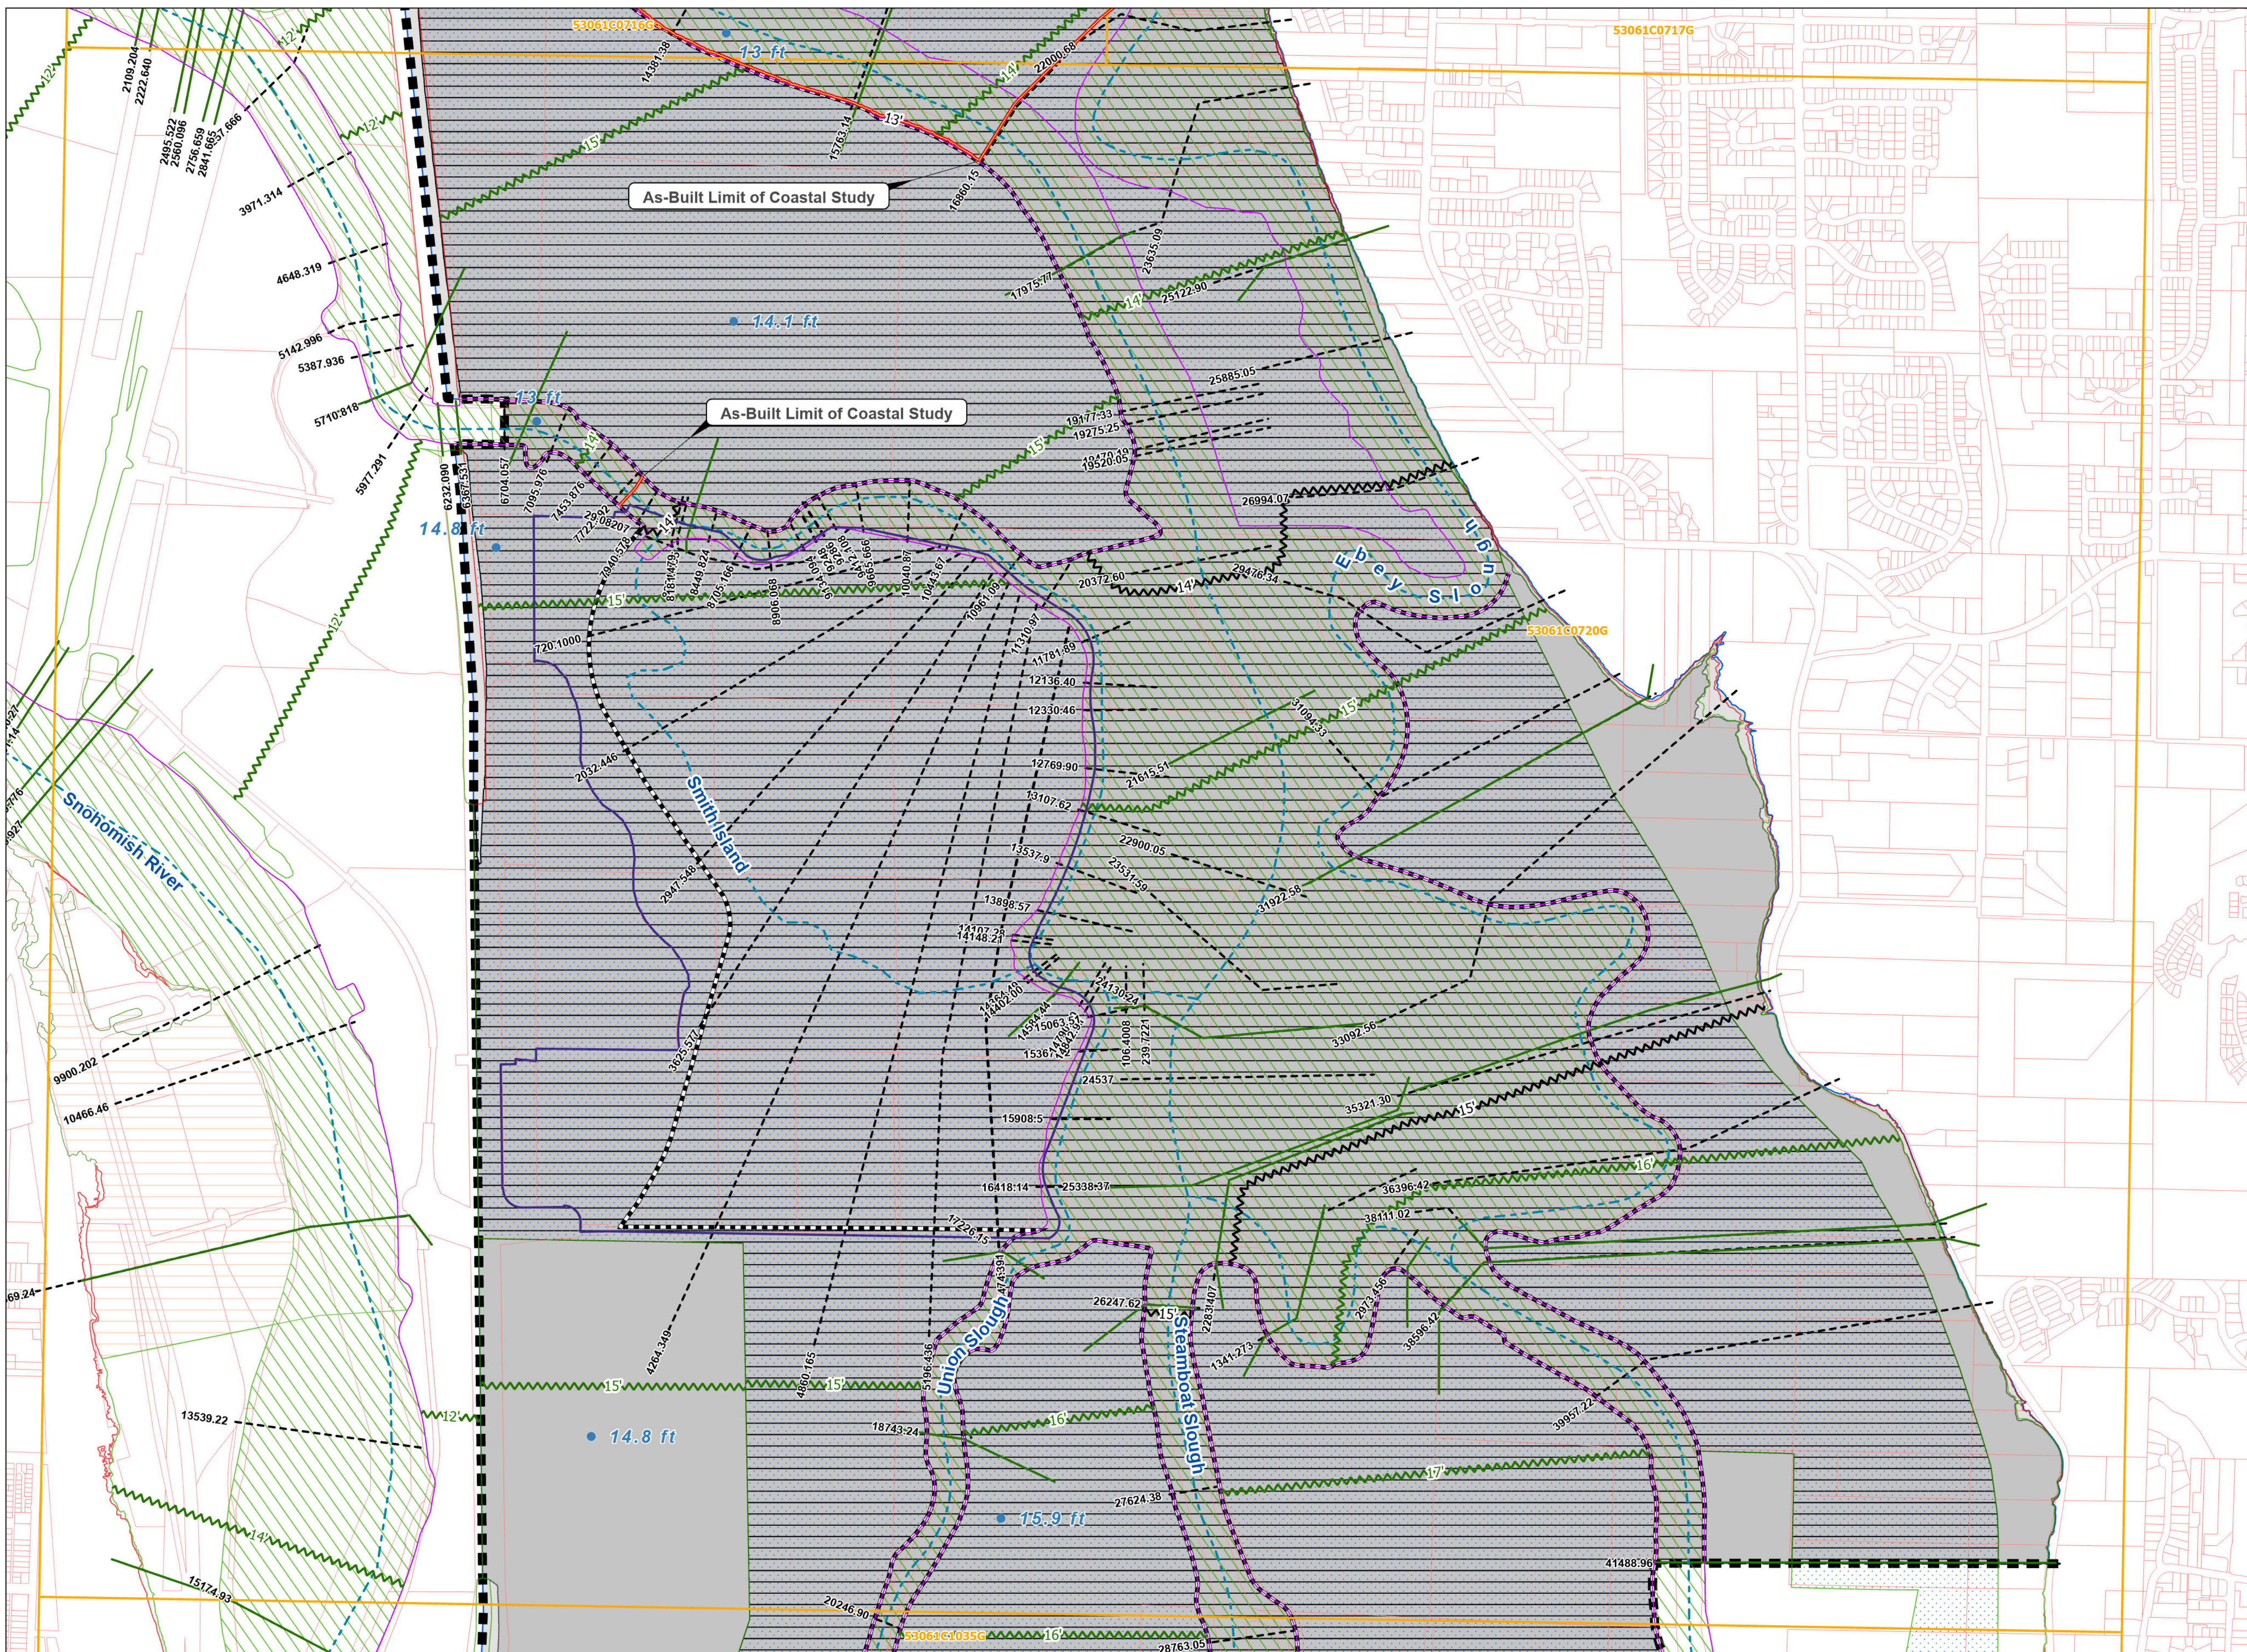

RENEWS 08/16/2023

Note:
 Vertical Datum is NAVD88
 Horizontal Datum is NAD83 (2011) Washington
 State Plane North (Intl ft)

