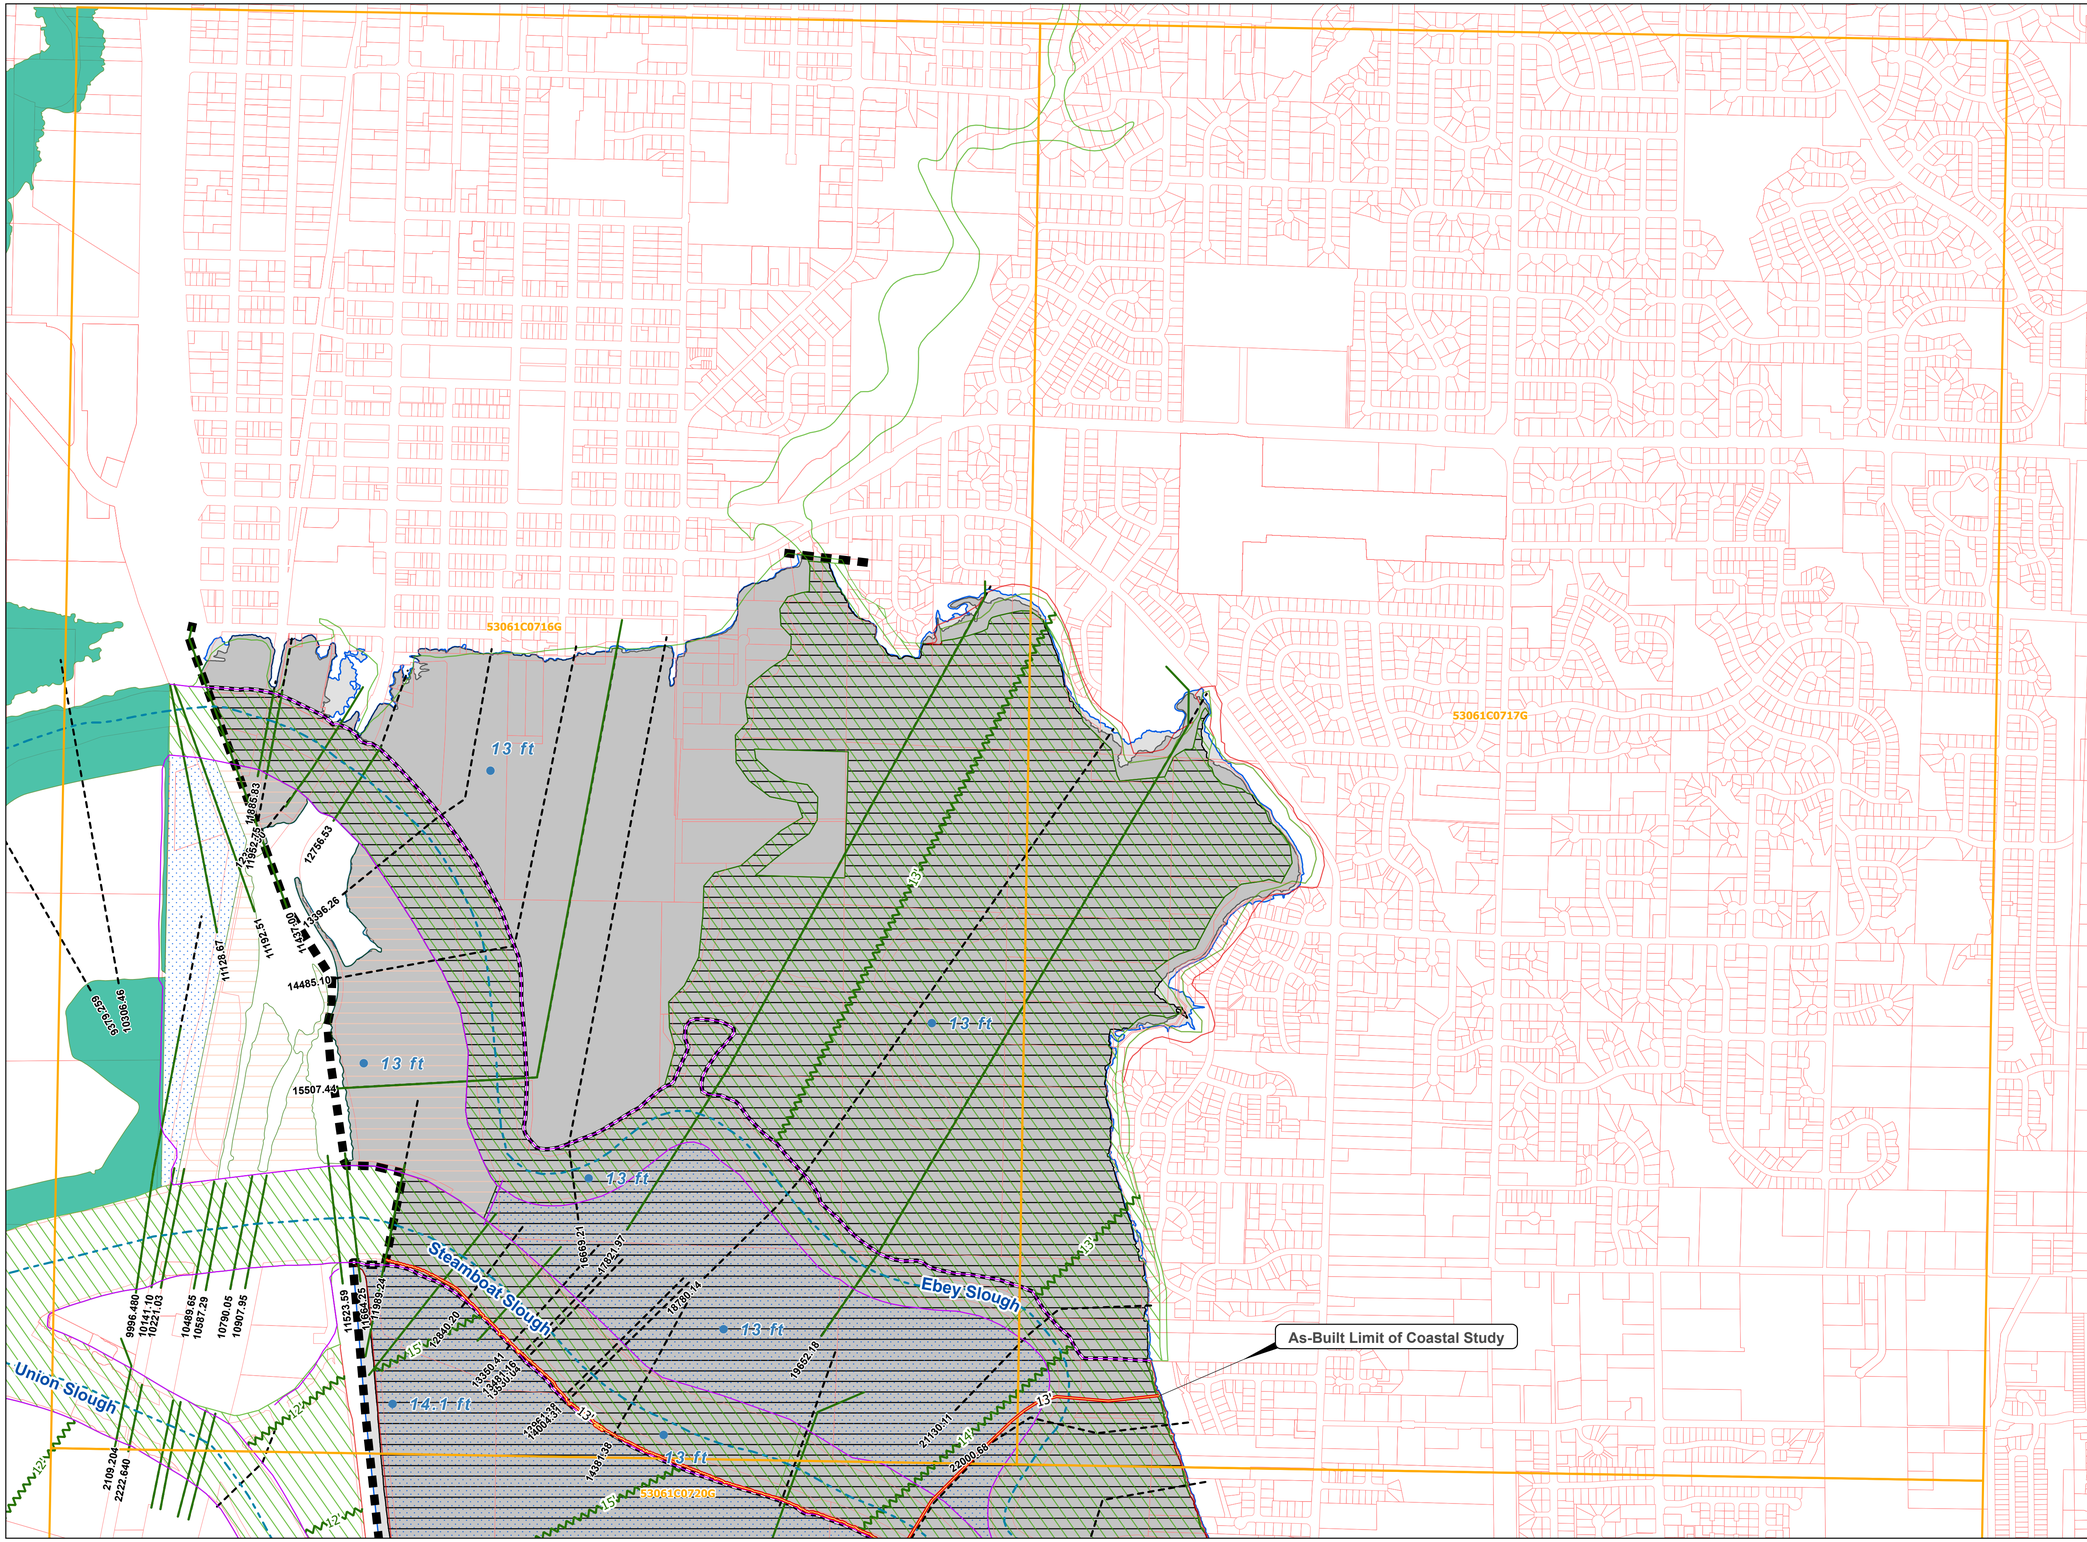

SMITH ISLAND FLOODPLAIN MAP REVISION

MAP 4 - AS-BUILT CONDITIONS

LEGEND

- FIRM Boundaries
- Taxlots
- Rivers & Streams
- Base Flood Elevation (As-Built)
- Project Boundary
- Density Fringe Area (As-Built)
- 1% Annual Chance Floodplain (As-Built)
- 0.2% Annual Chance Floodplain (As-Built)
- Levee (As-Built)
- Cross Sections (As-Built)
- Revision Boundaries (As-Built)
- Base Flood Elevation (As-Built)
- 1% Annual Chance Floodplain (Effective FIS)
- 0.2% Annual Chance Floodplain (Effective FIS)
- Floodway (Effective FIS)
- Density Fringe Area (Effective FIS)
- Coastal Floodplain (Effective FIS)
- Combined Riverine and Coastal Flooding (Effective FIS)
- Levee (Effective)
- Cross Section (Effective)
- Base Flood Elevation (Effective)

FEET
0 300 600 1,200

CHARLES GARY WOLF
STATE OF WASHINGTON
44866
REGISTERED PROFESSIONAL ENGINEER
11-17-22

RENEWS 08/16/2023

Charles Gary Wolf

Note:
Vertical Datum is NAVD88
Horizontal Datum is NAD83 (2011) Washington State Plane North (Intl ft)